




BM 131.27 R.R. Spike on N.S. of Power Pole on S.E. corner of Woodland (Armstrong) and 35th St. N.

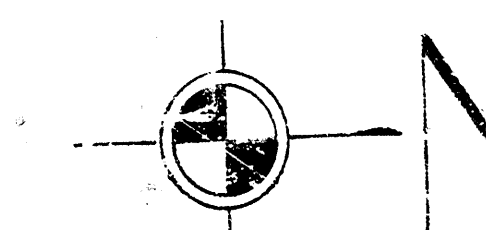

Plan Scale 1" = 40'
 Profile Scale 1" = 40' Horiz.
 1" = 5' Vert.

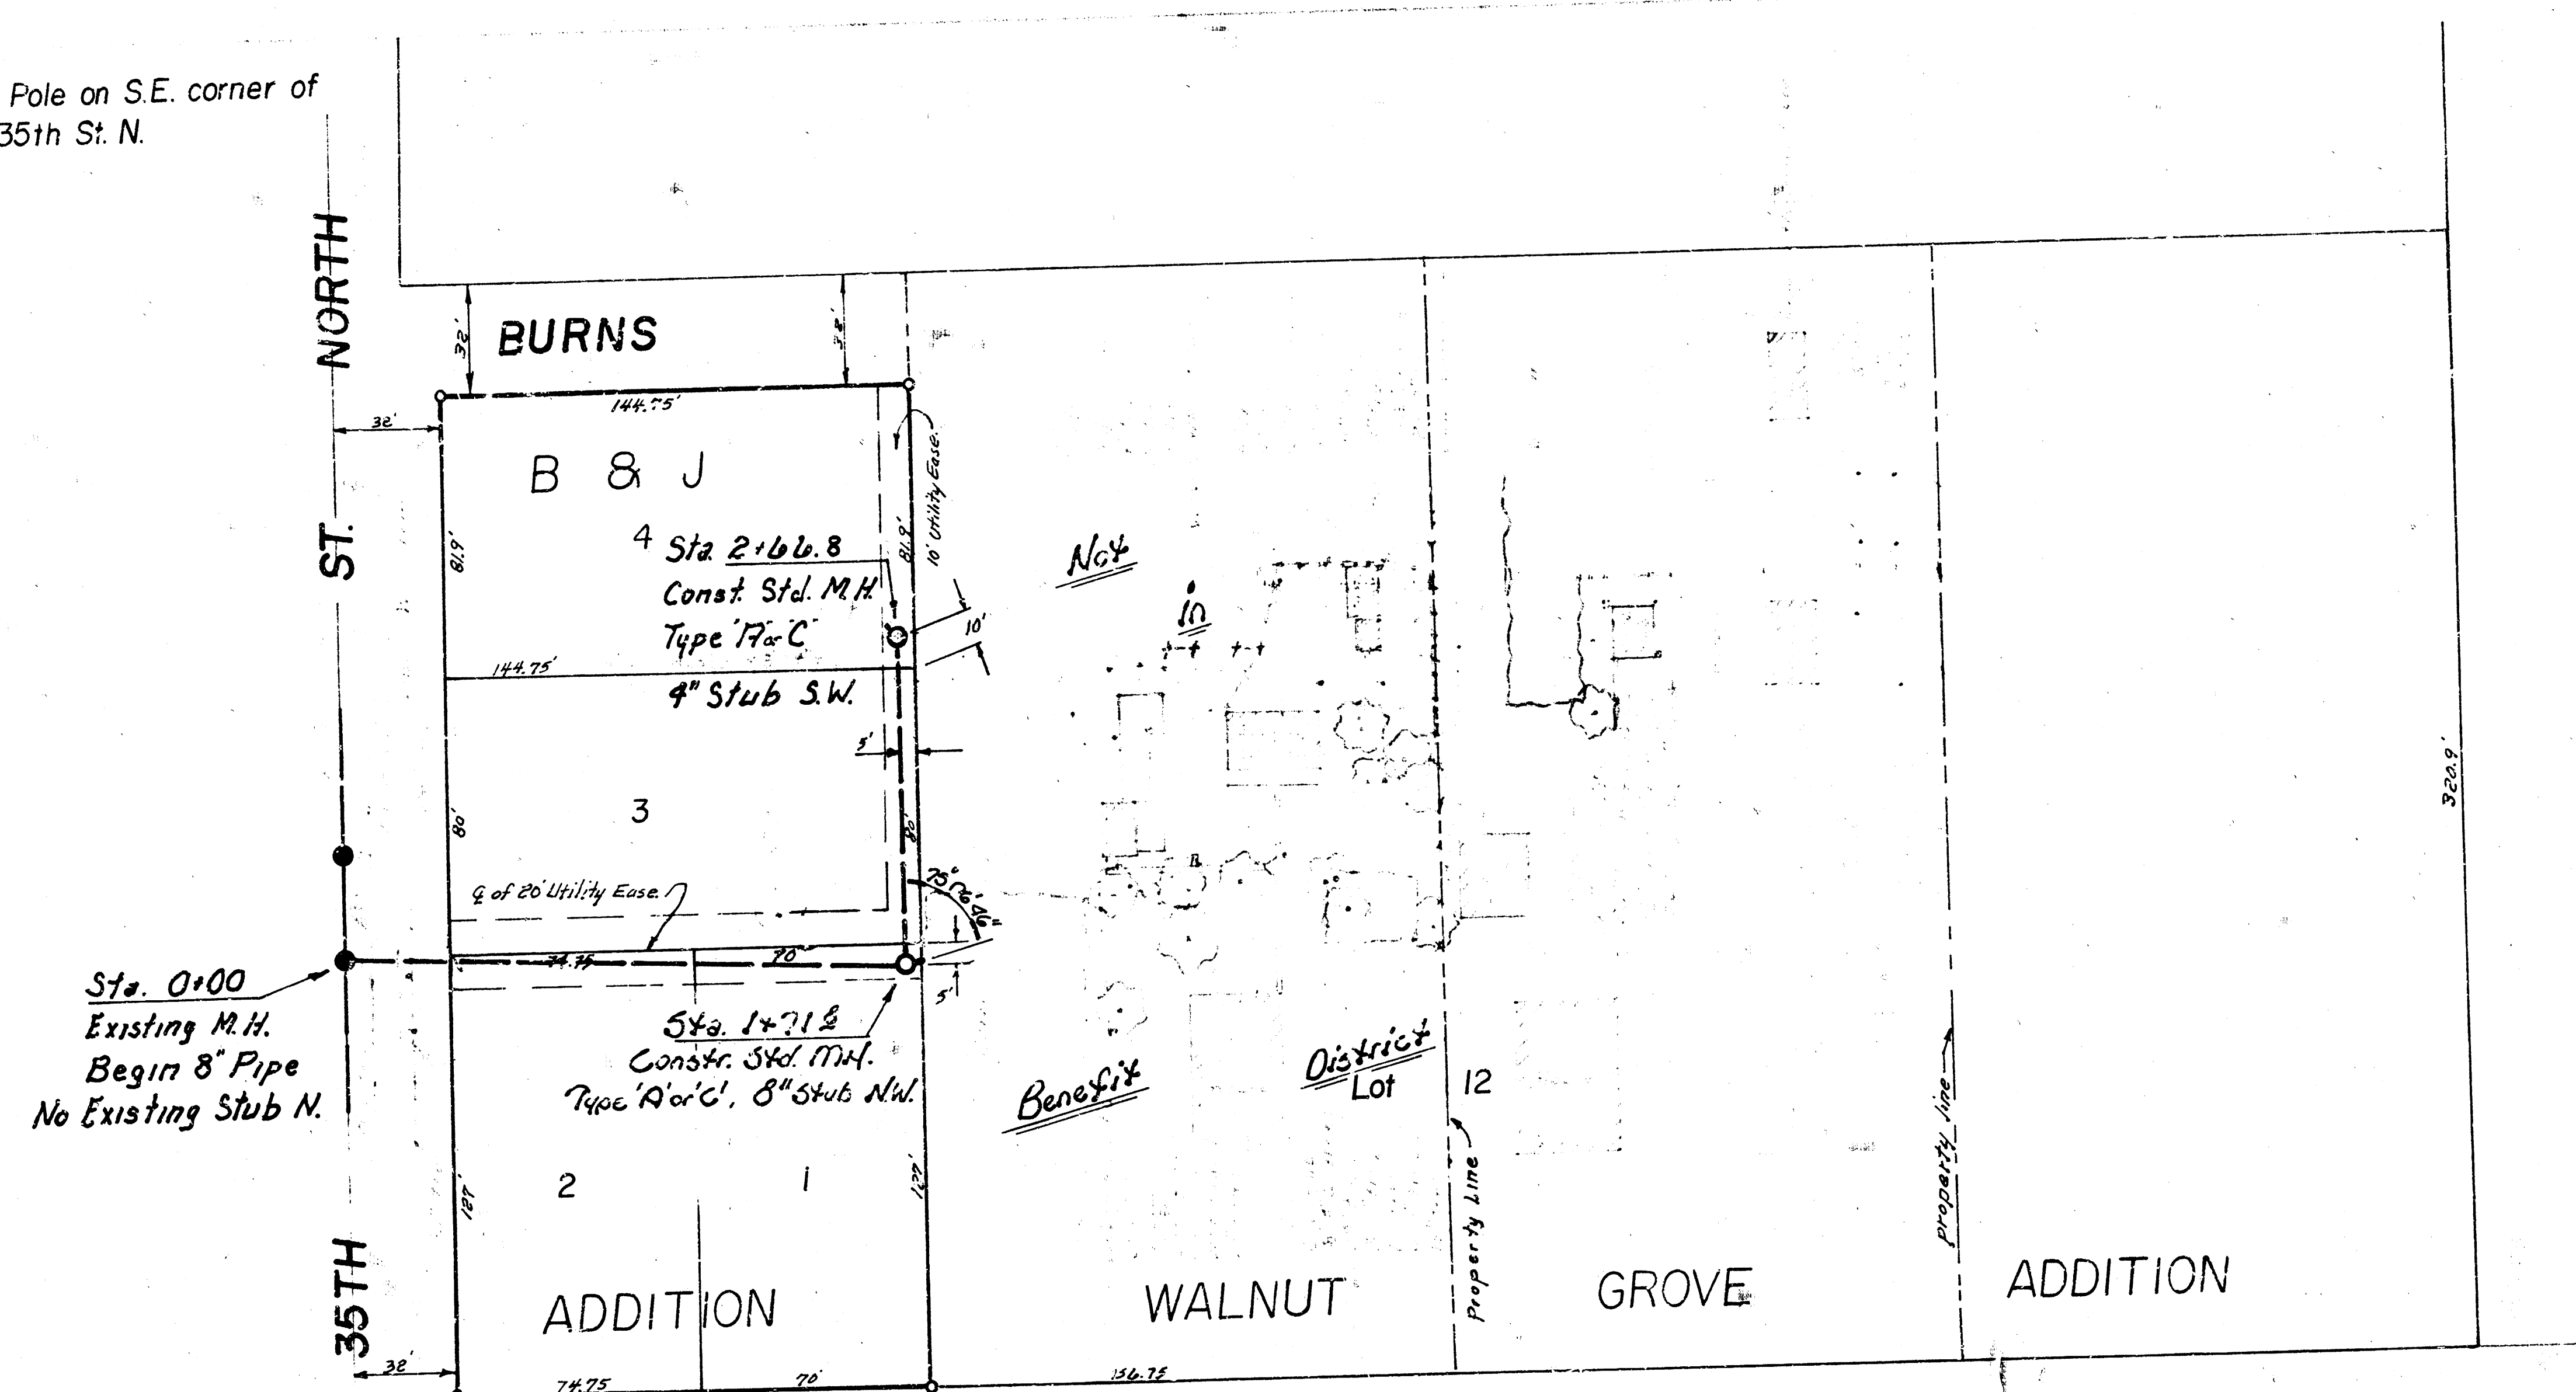

Sta. 0+00
 Existing M.H.
 Begin 8" Pipe
 No Existing Stub N.

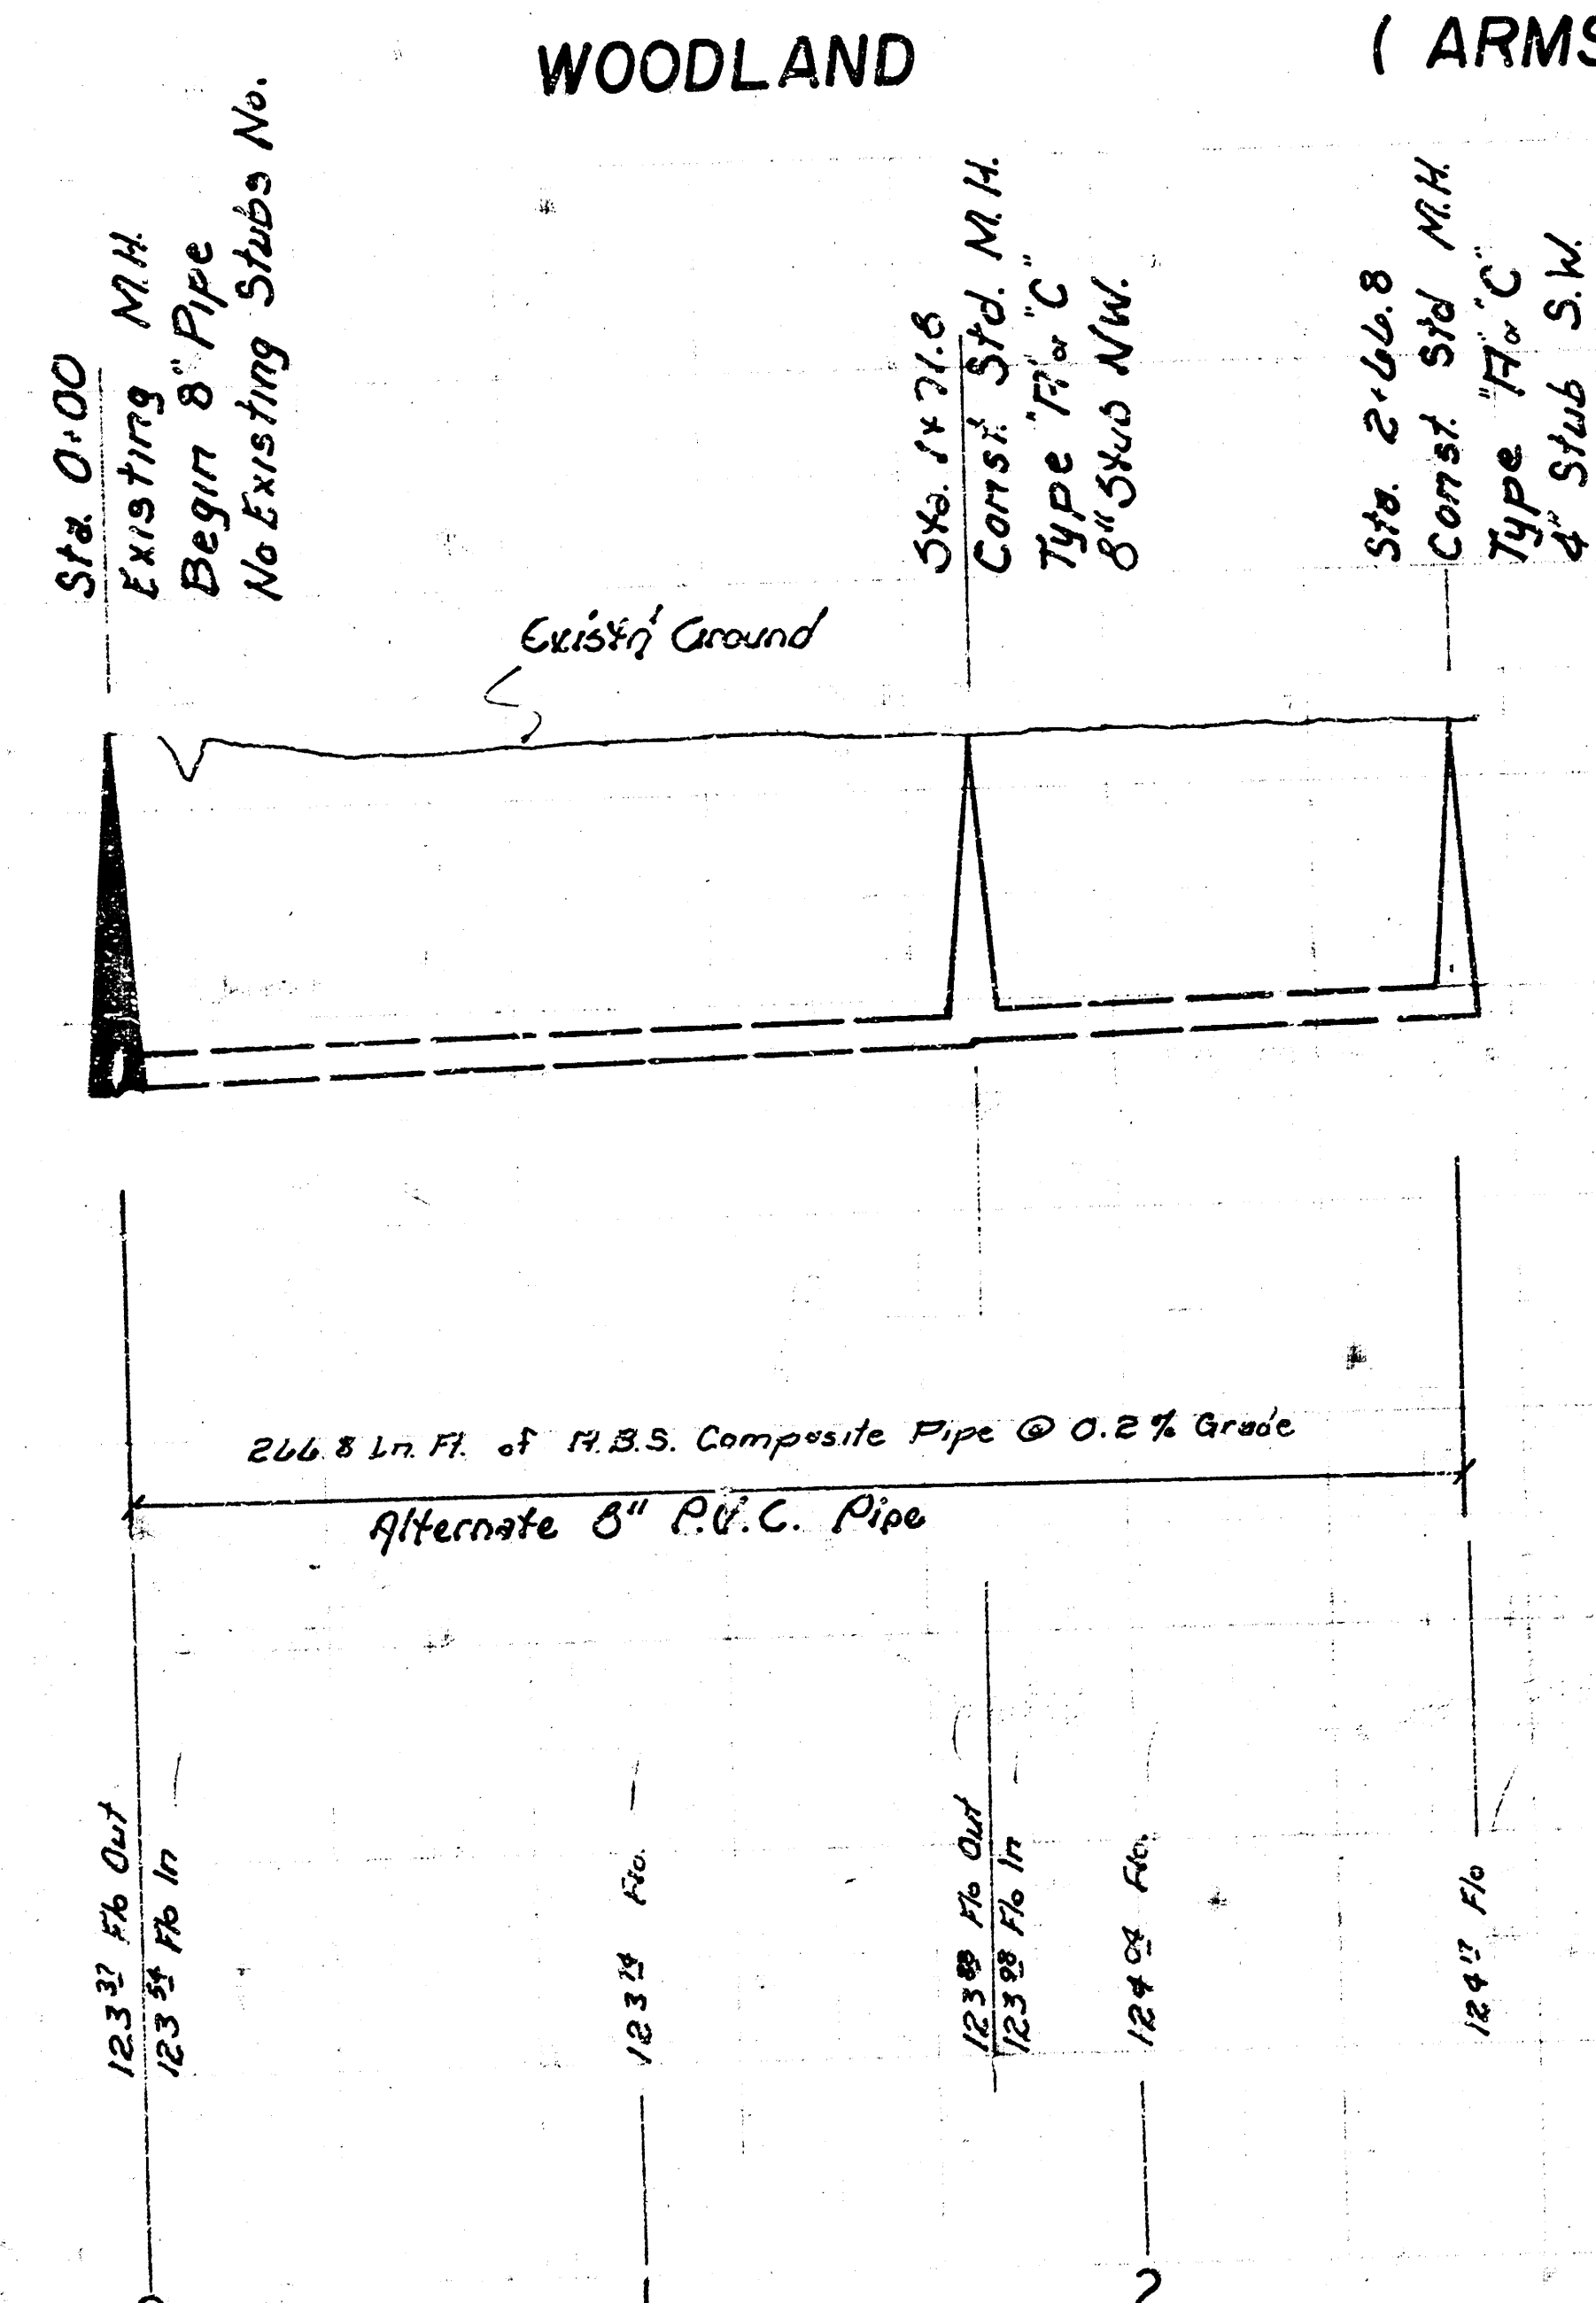

130
 125
 120
 115

As Built 7-15-10
 E 239

LAT 81 MAIN 4 S.S. 23
 CITY OF WICHITA
 R. W. Linn City Engineer
 Project No. 468 245 80115 000 000.001 1/1