


B.M. 127.21 SE Cor. Conc. M.H. Base Approx. 62' S. of N.W. 30<sup>th</sup> St. No. and 42' E. of E.L. MASLEY  
 B.M. 129.32 RR Spt. N. Face P.P. SW Cor. 30<sup>th</sup> St. No. and St. FRANCIS Being 1<sup>st</sup> P.P. S. of RR Tracks


5.14.18  
 5.14.18  
 5.14.18

SCALE  
 PLAN 1" = 40'  
 PROFILE 1" = 40'  
 Horiz 1" = 40'  
 Vert 1" = 5'

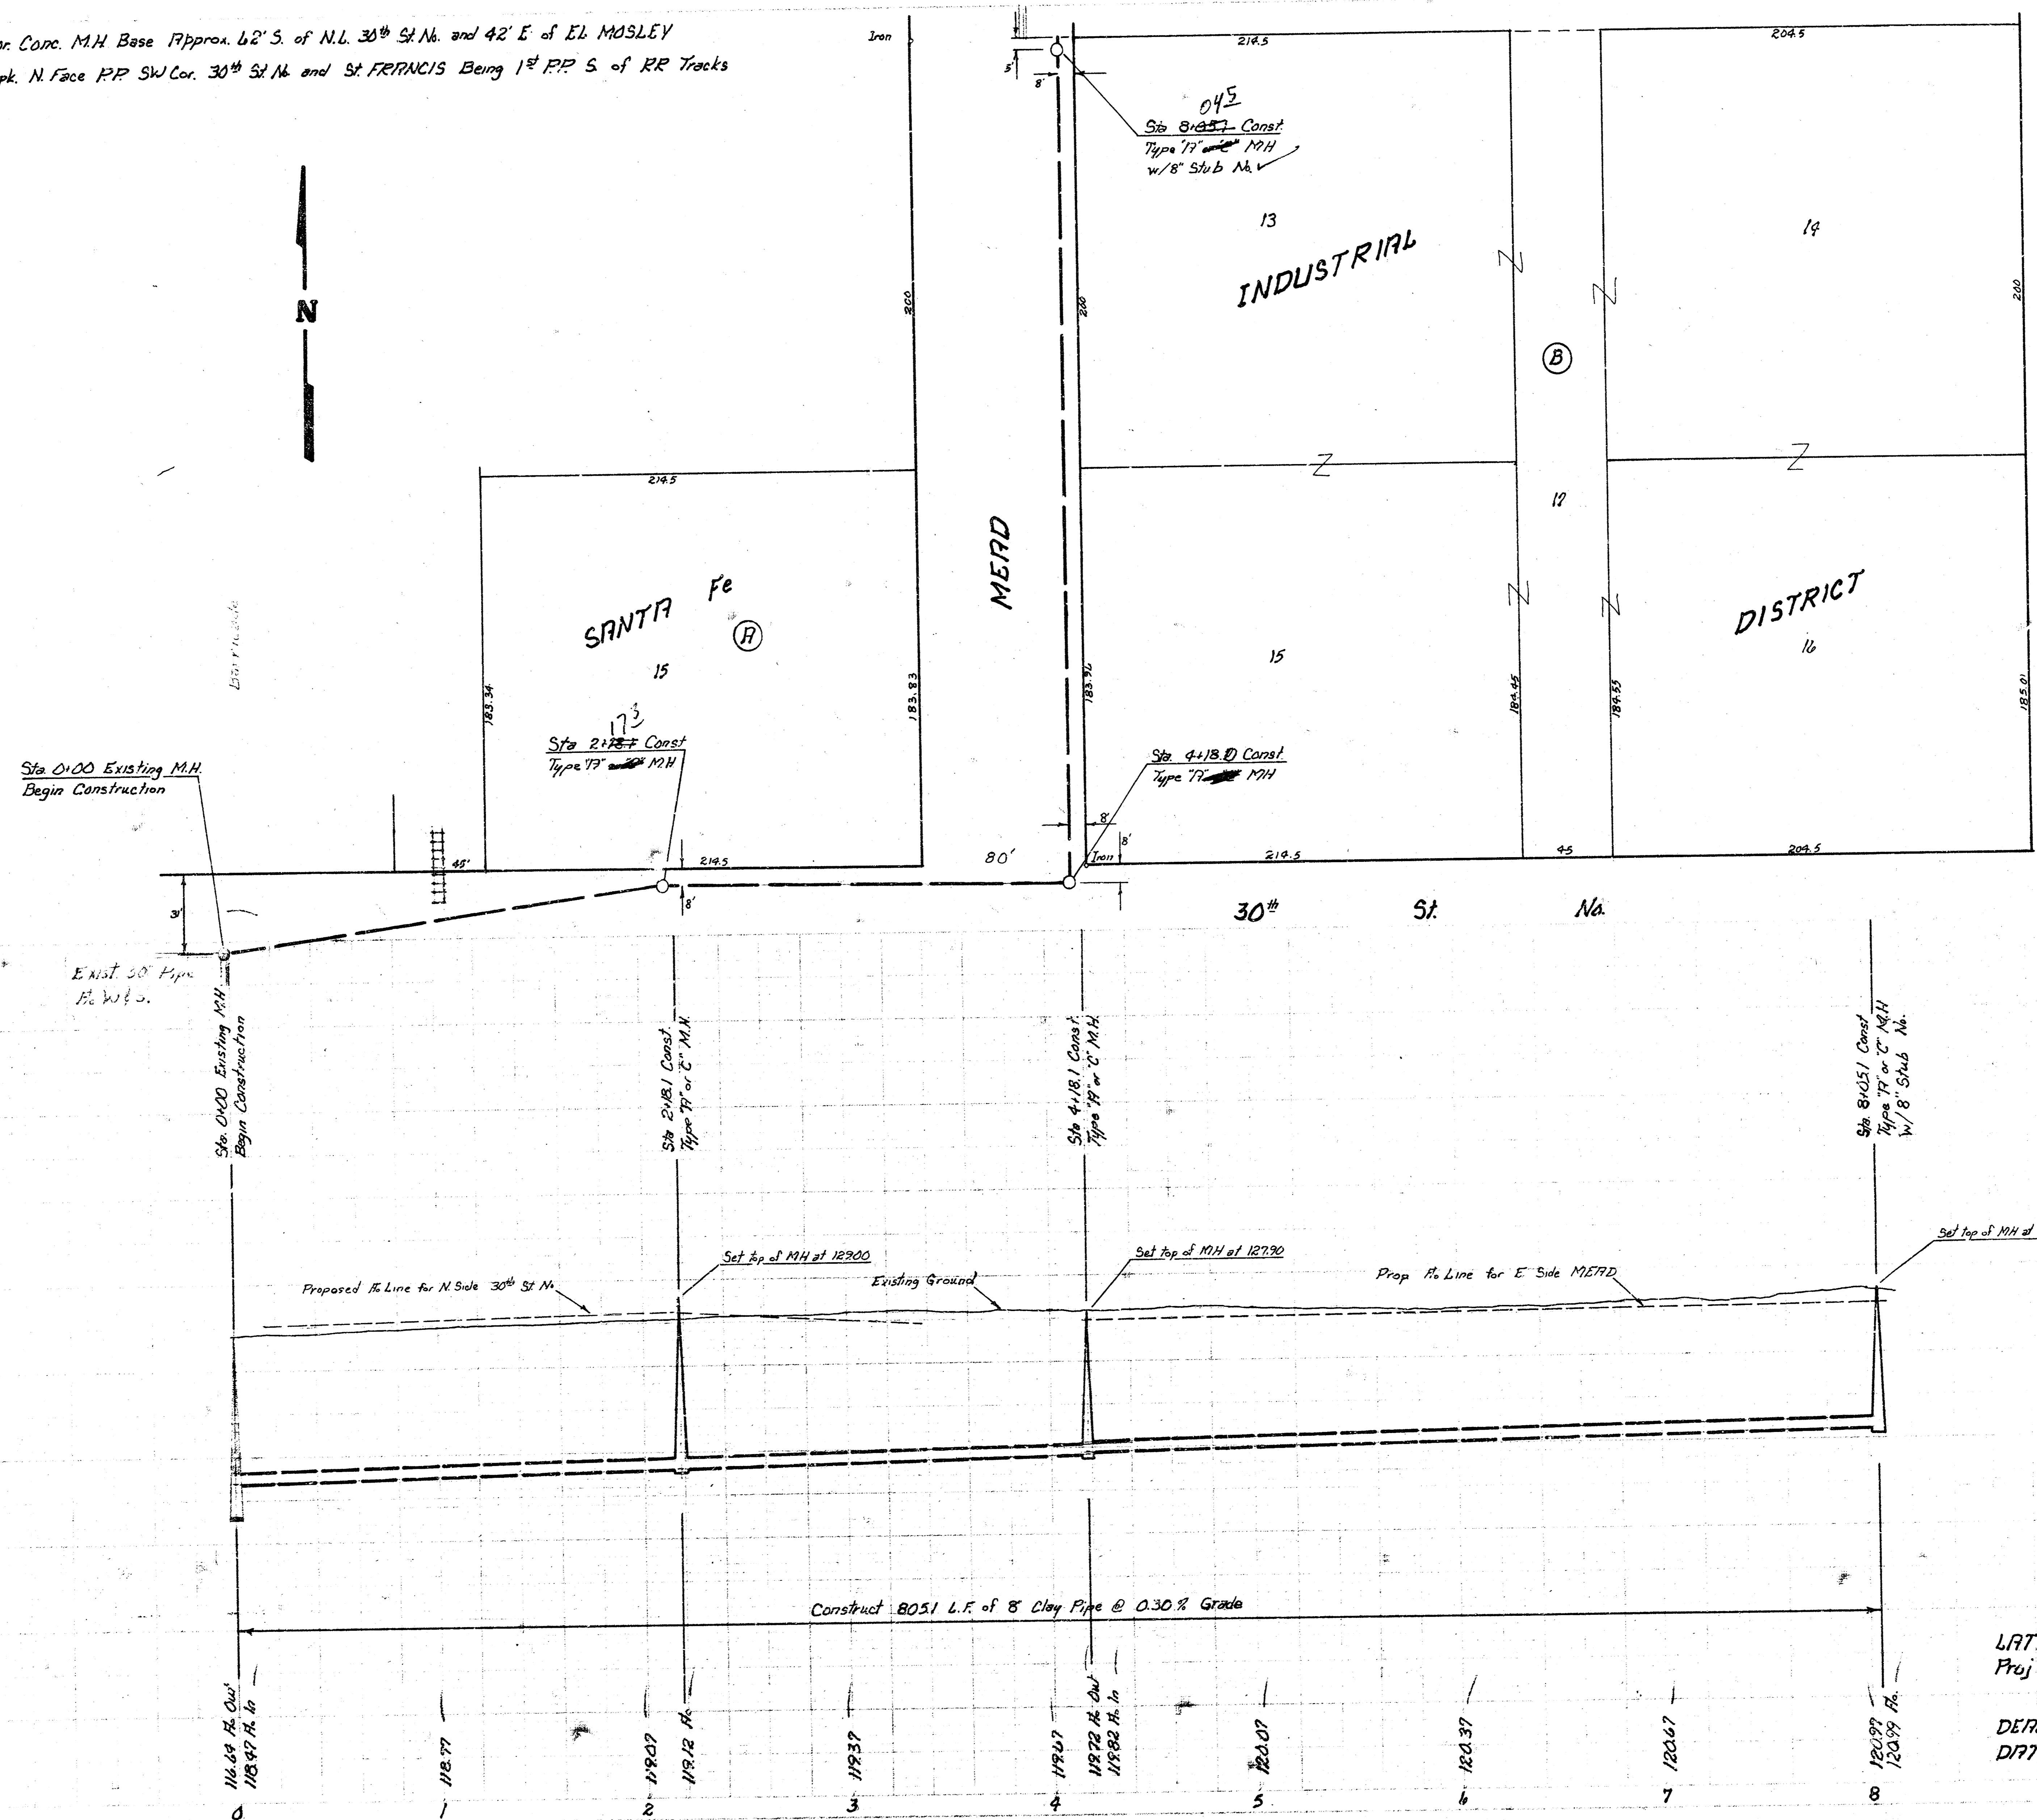

130  
 125  
 120  
 115

As Built  
 2-17-81  
 J.S.S.

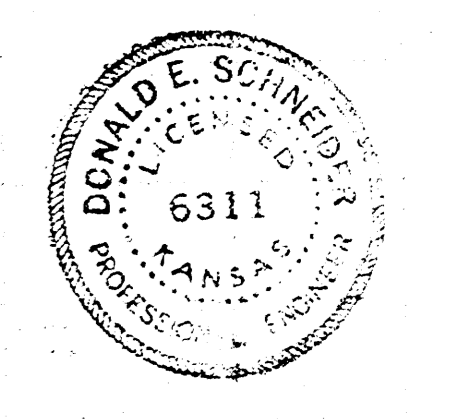

LATERAL 105, MAIN & SANITARY SEWER 23  
 Proj No: 468-76-245-80760-000-000-001  
 WICHITA, KANSAS  
 DEAN SELLERS - Acting CITY ENGINEER  
 DATE \_\_\_\_\_

17 8 3 2