
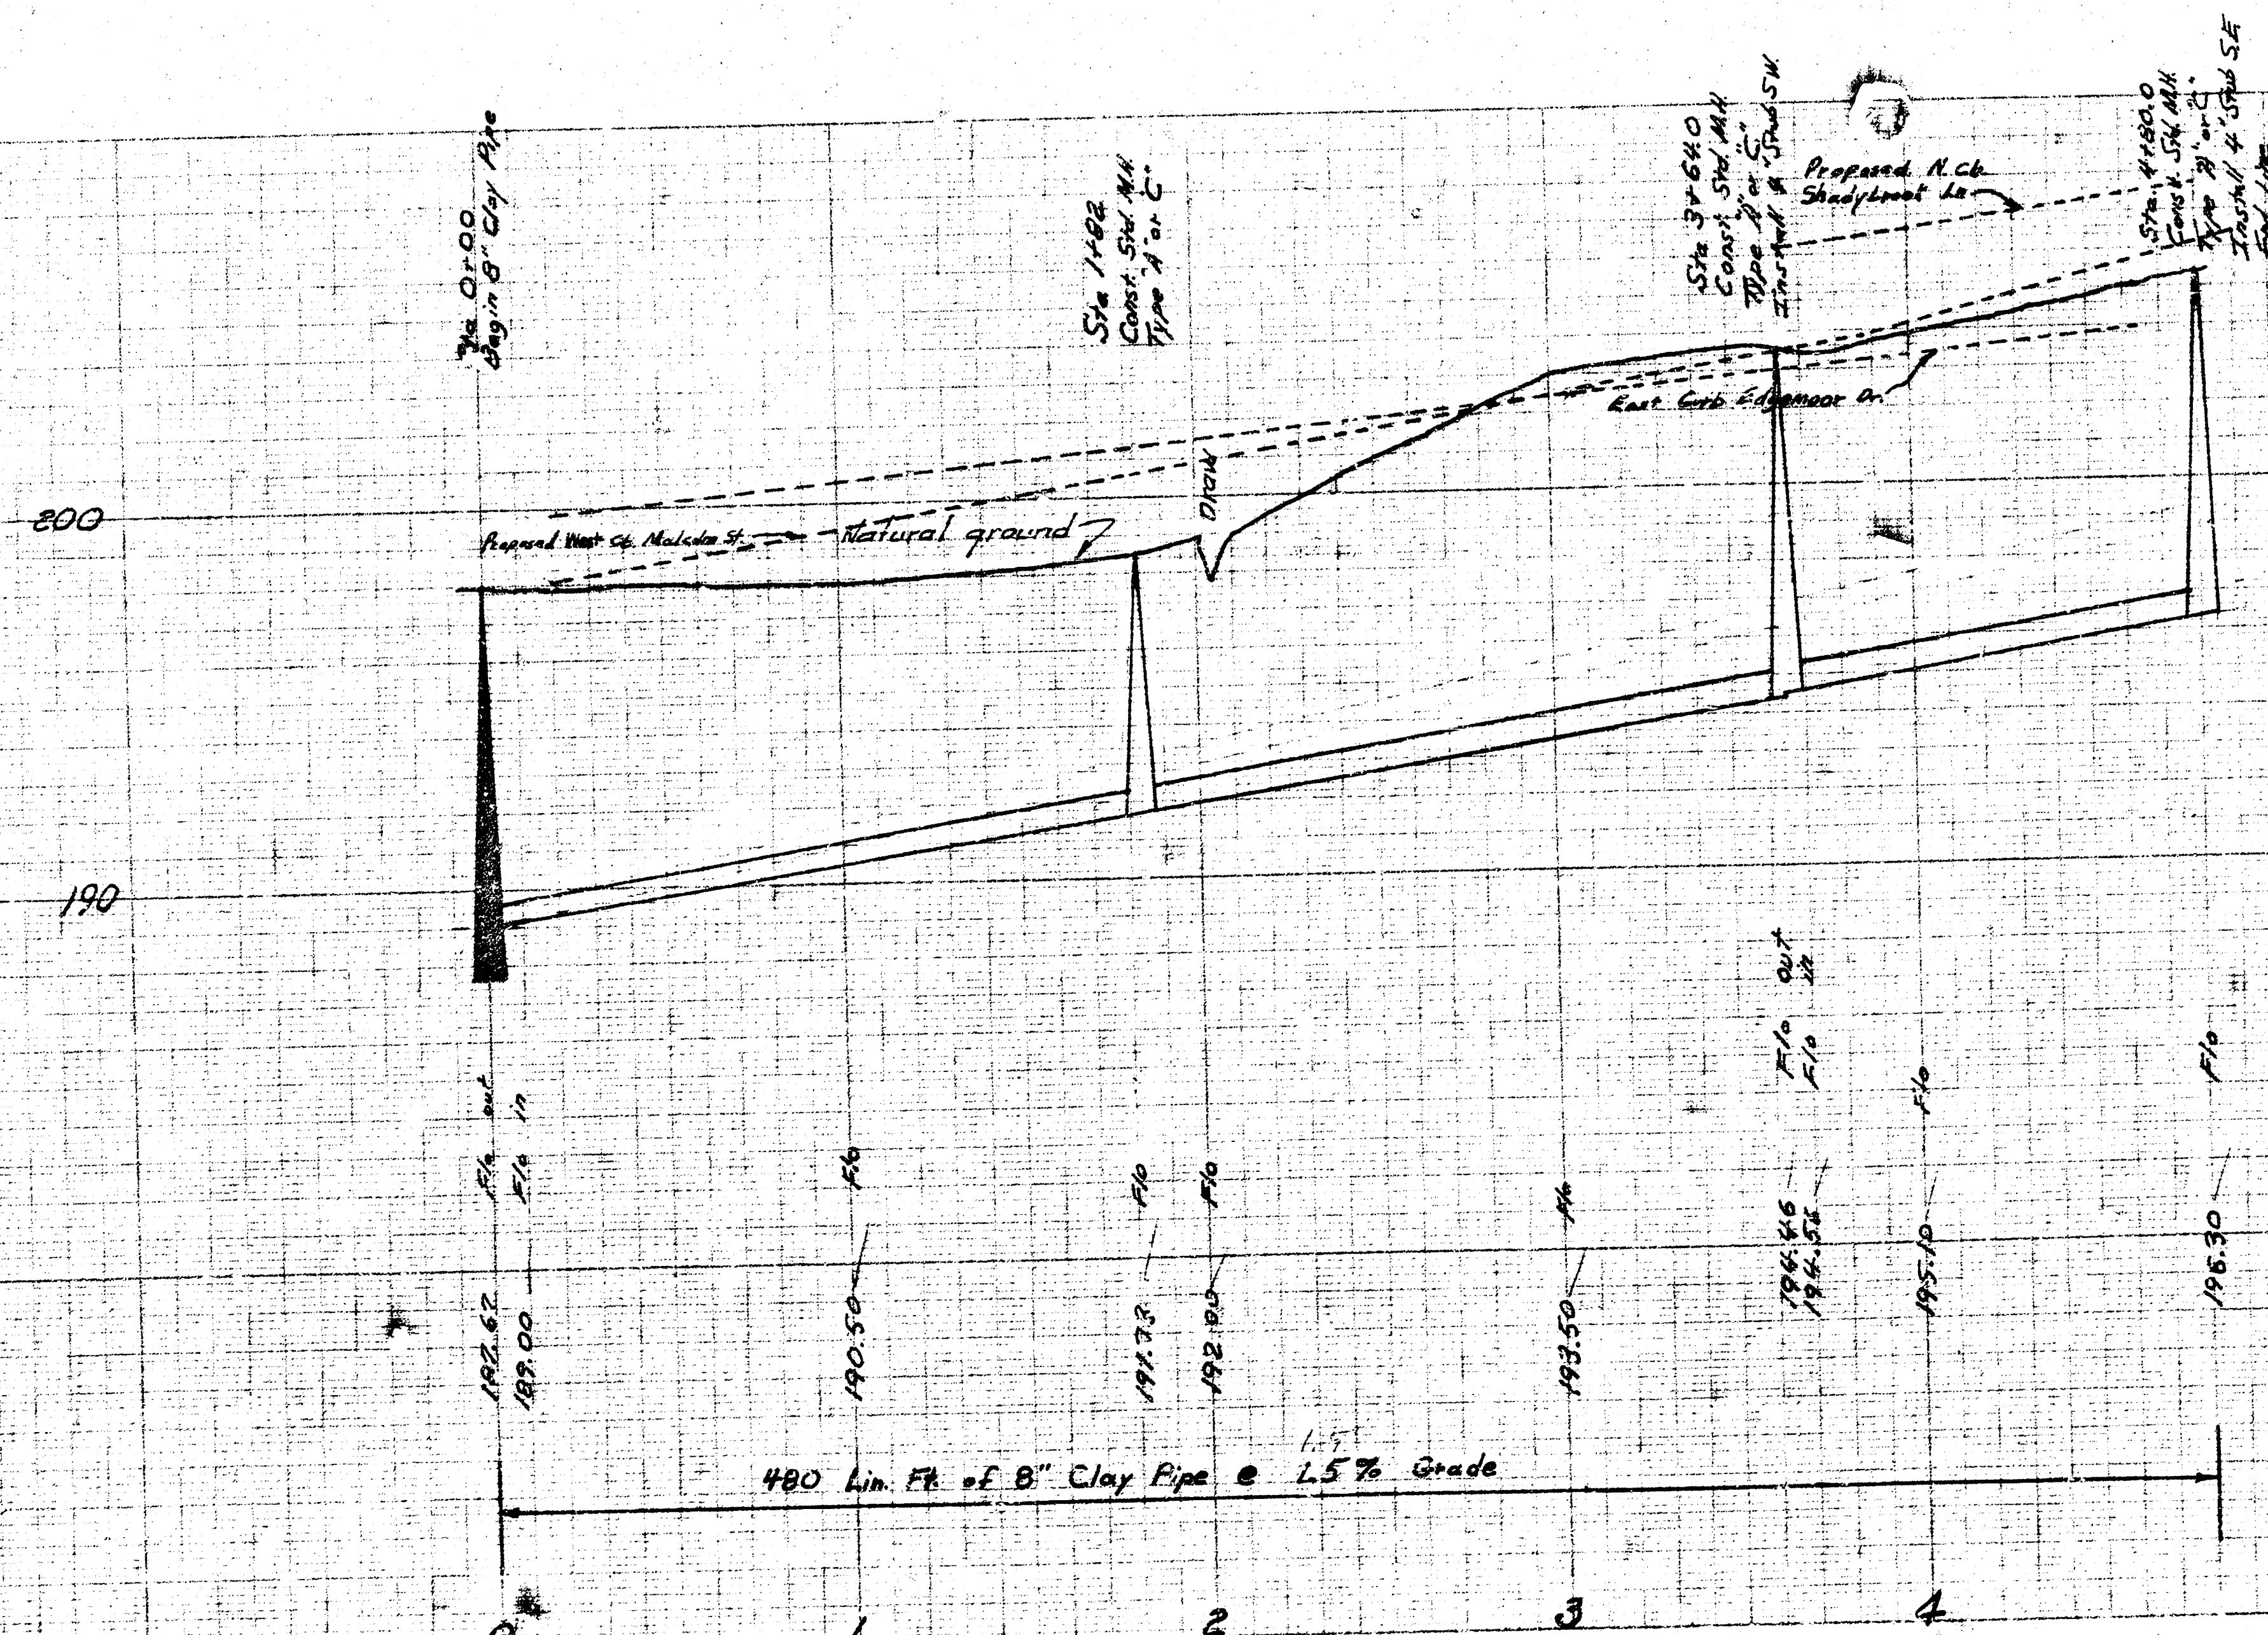


Survey by G. Y. Book No. 237-Y
Plan by J. W.
Checked by _____

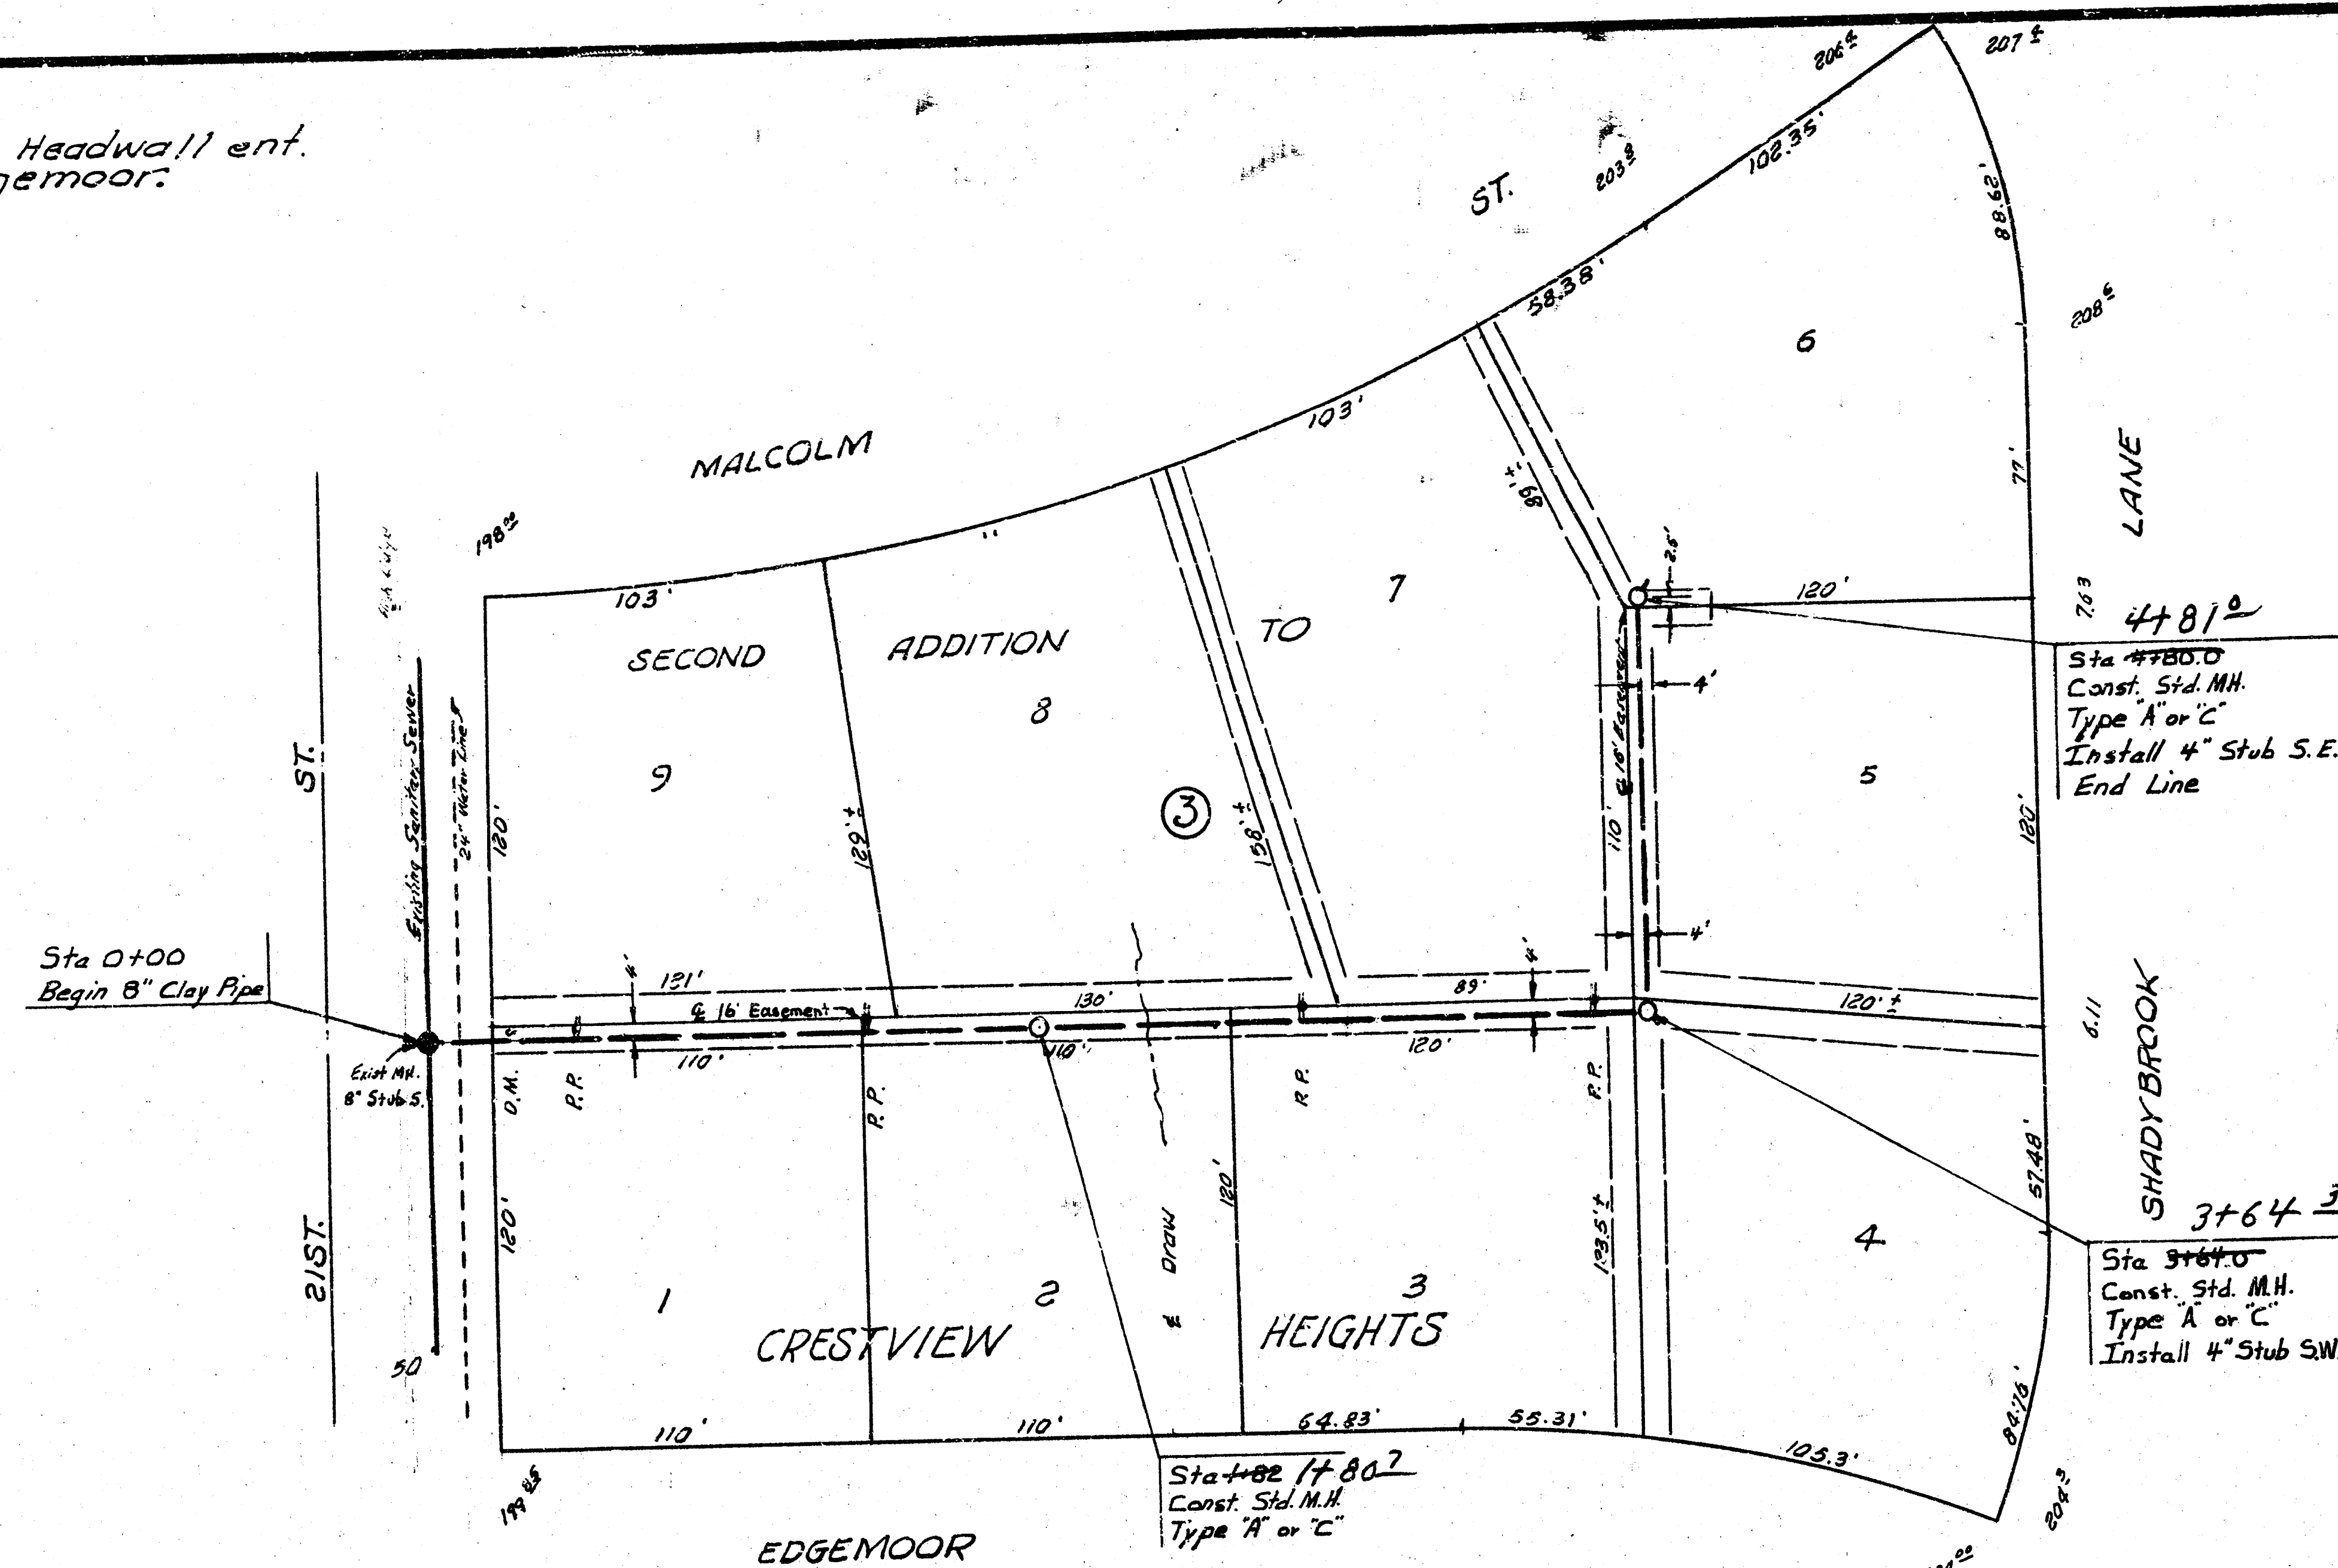

Plan Scale $1" = 40'$
Profile Scale $1" = 40'$ Horiz.
 $1" = 4'$ Vert.

As Built 3-11-76

LAT. II , SUBMAIN 5, S. S. NO. 23

CITY OF WICHITA, KANSAS

R. W. LINN

CITY ENGINEER

PROJECT DBKL566040