



B.M. 204.69 "A" Top N. end W. c/vt. Headwall
Ent. c/vt. N.S. 21st. 200' E. of Edgemoor.

T.B.M. 216.72 60" nail W.S. P.P.S.E. cor
lot 5 Block 12 Crestview Hqts. 1st.

Survey by G. X. Book 241-Y 231-Y
Checked by G. X. Book 241-Y 231-Y

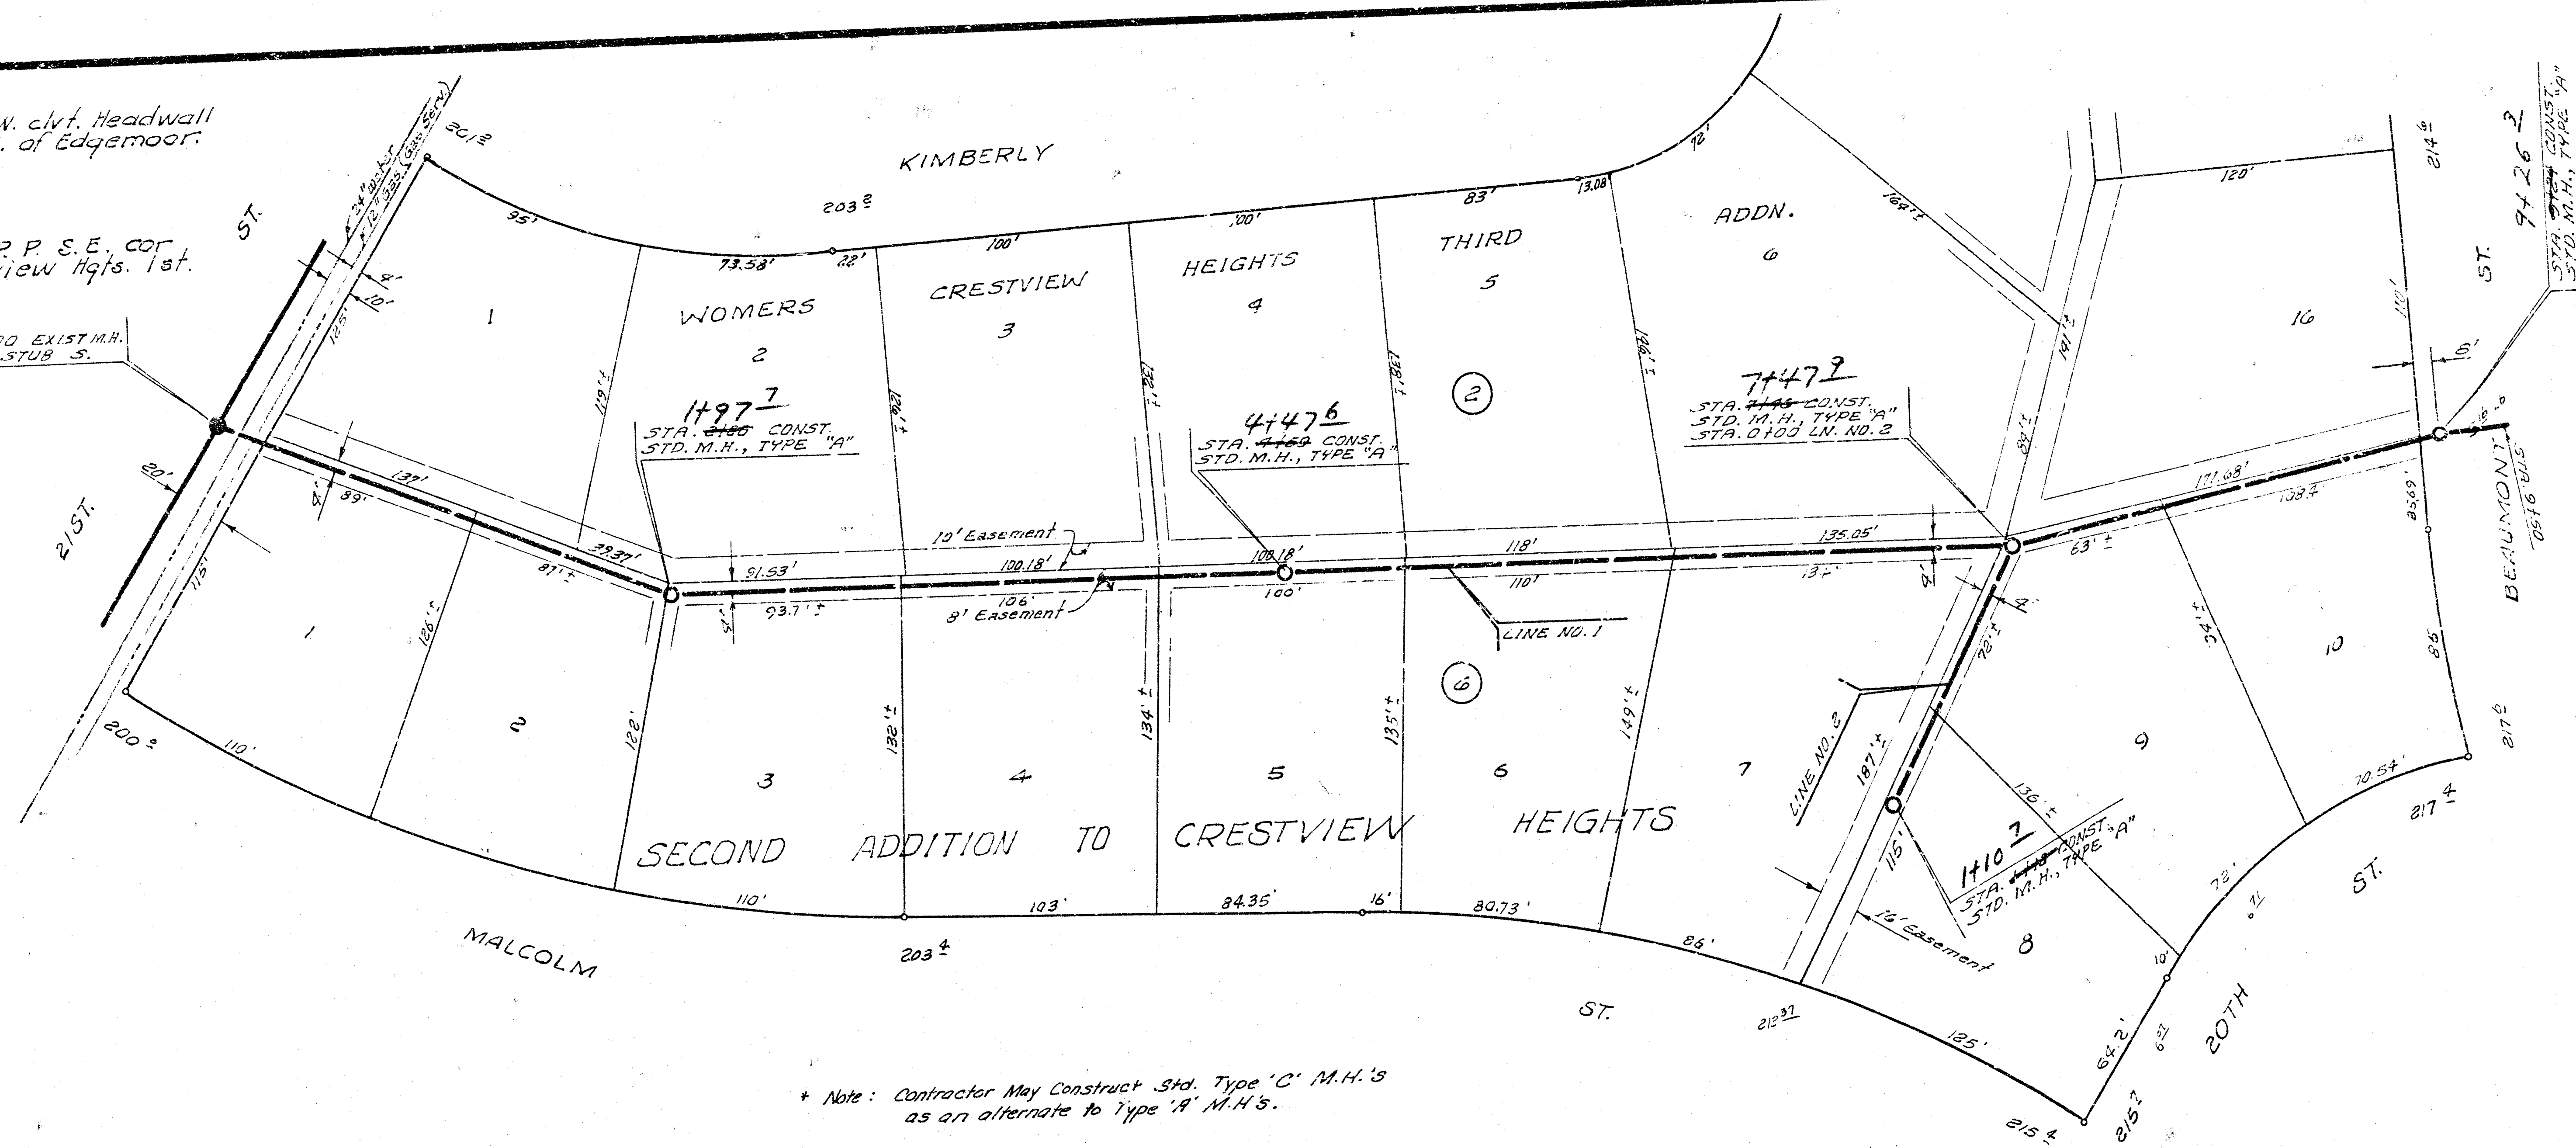

* Note: Contractor May Construct Std. Type 'C' M.H.'s
as an alternate to Type 'A' M.H.'s.

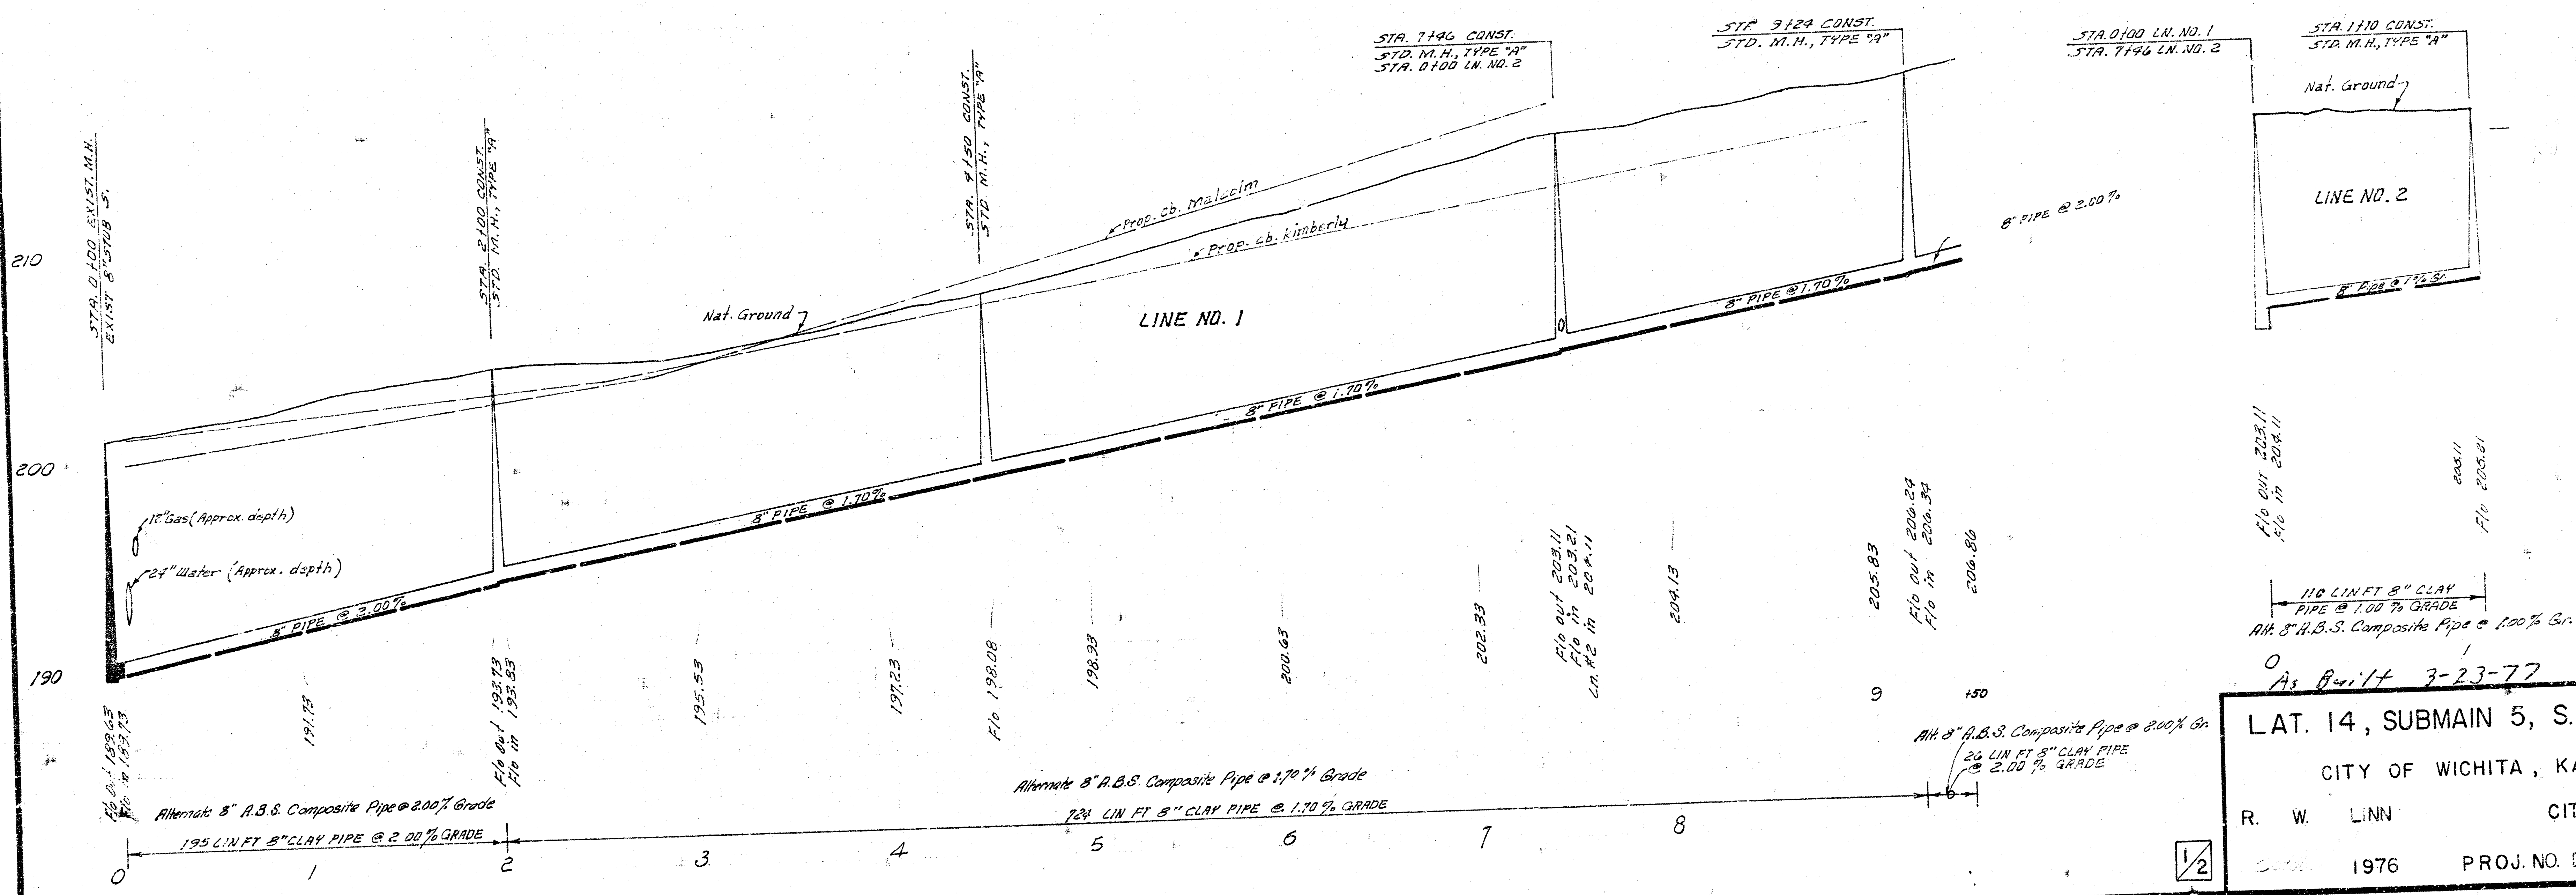

110 LIN. FT. 8\"/>

As Built 3-23-77


LAT. 14, SUBMAIN 5, S. S. NO. 23

CITY OF WICHITA, KANSAS

R. W. LINN CITY ENGINEER

1976 PROJ. NO. DBKL 566043

Bk. 237-Y

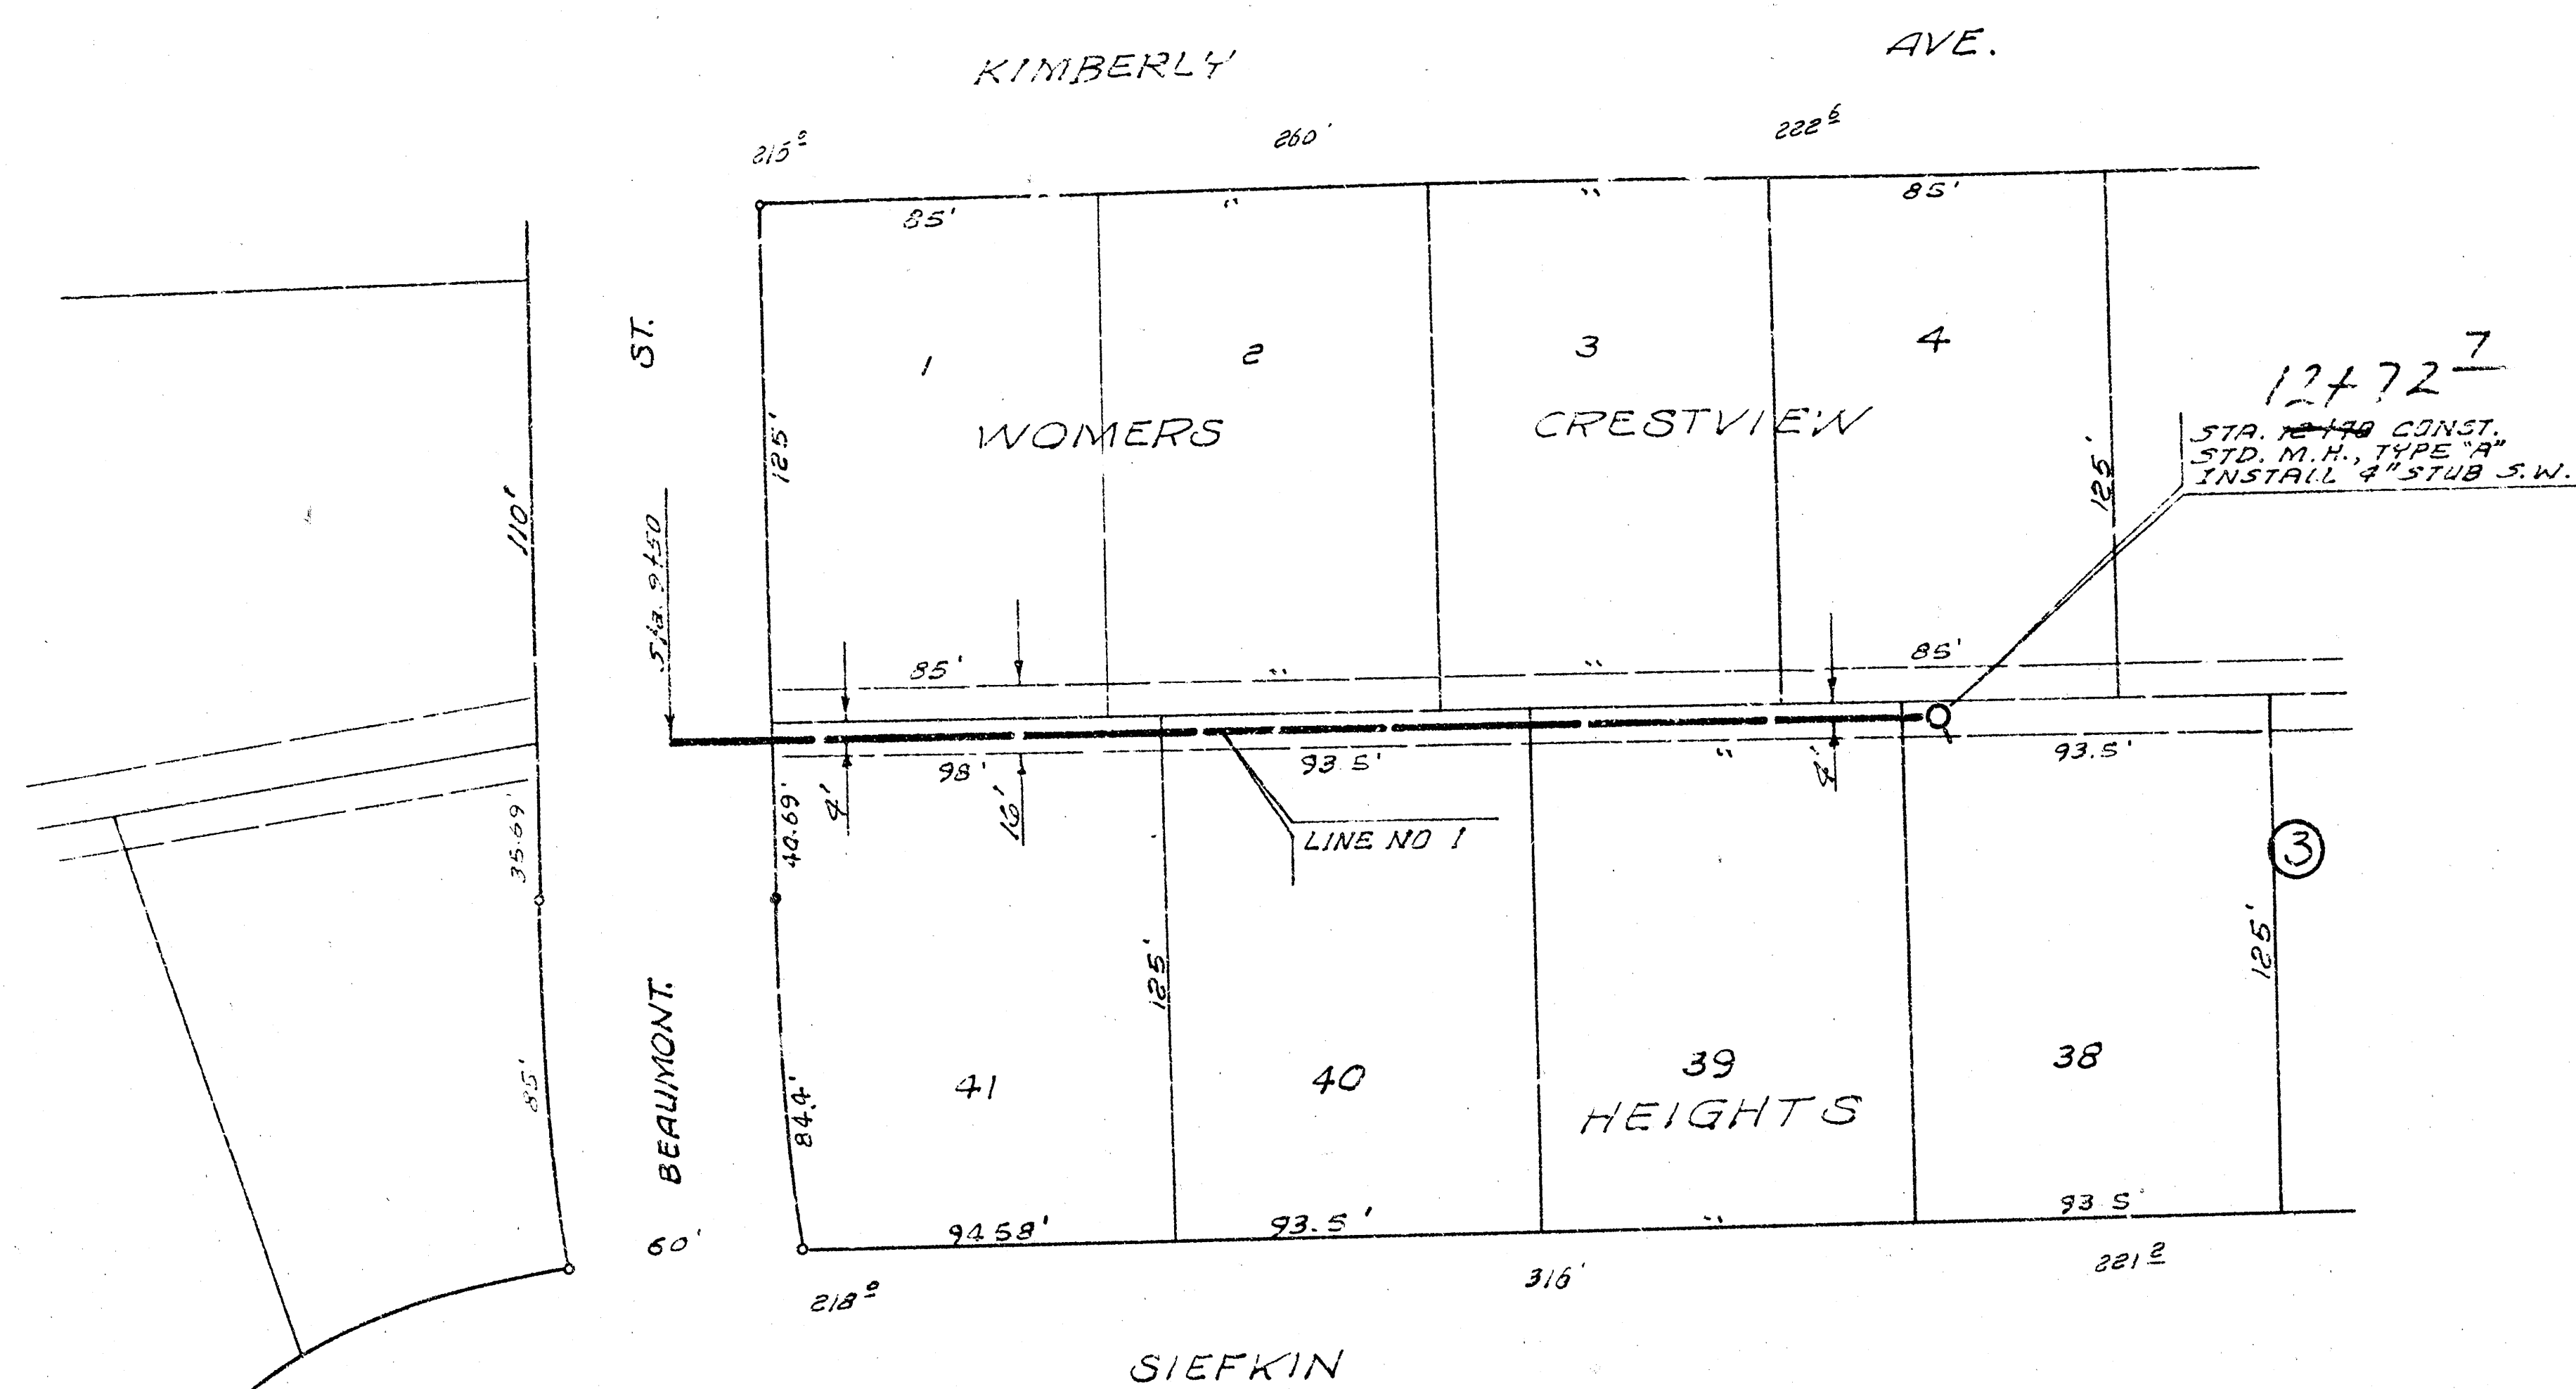


B.M. 217.94' top N. cb 19th
10' E. W. of Beaumont.

220

210

200

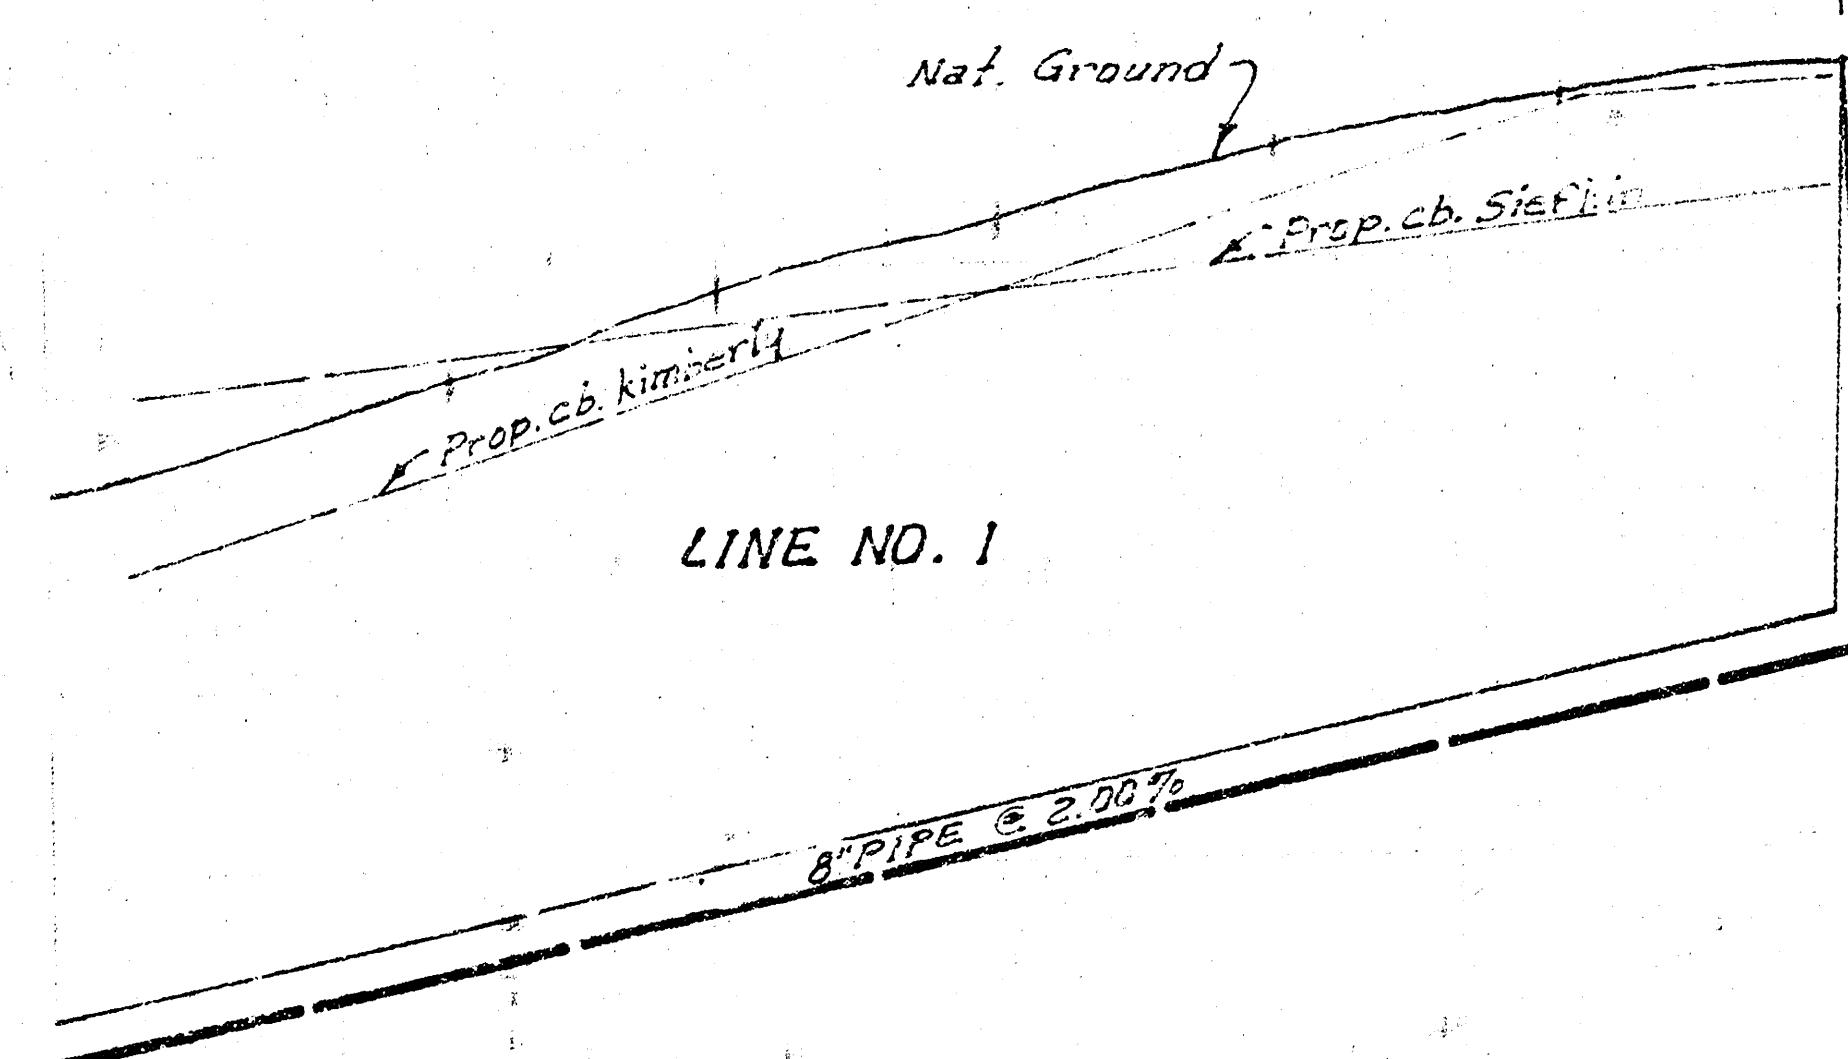

220

210

200

9 10 11 12

320 LIN. FT. 8" CLAY PIPE @ 2.00% GRADE
Alternate 8" A.B.S. Composite Pipe @ 2.00% Grade

2/2

L AT. 14, SUBMAIN 5, S. S. NO. 23
PROJECT NO. DBKL 564023