

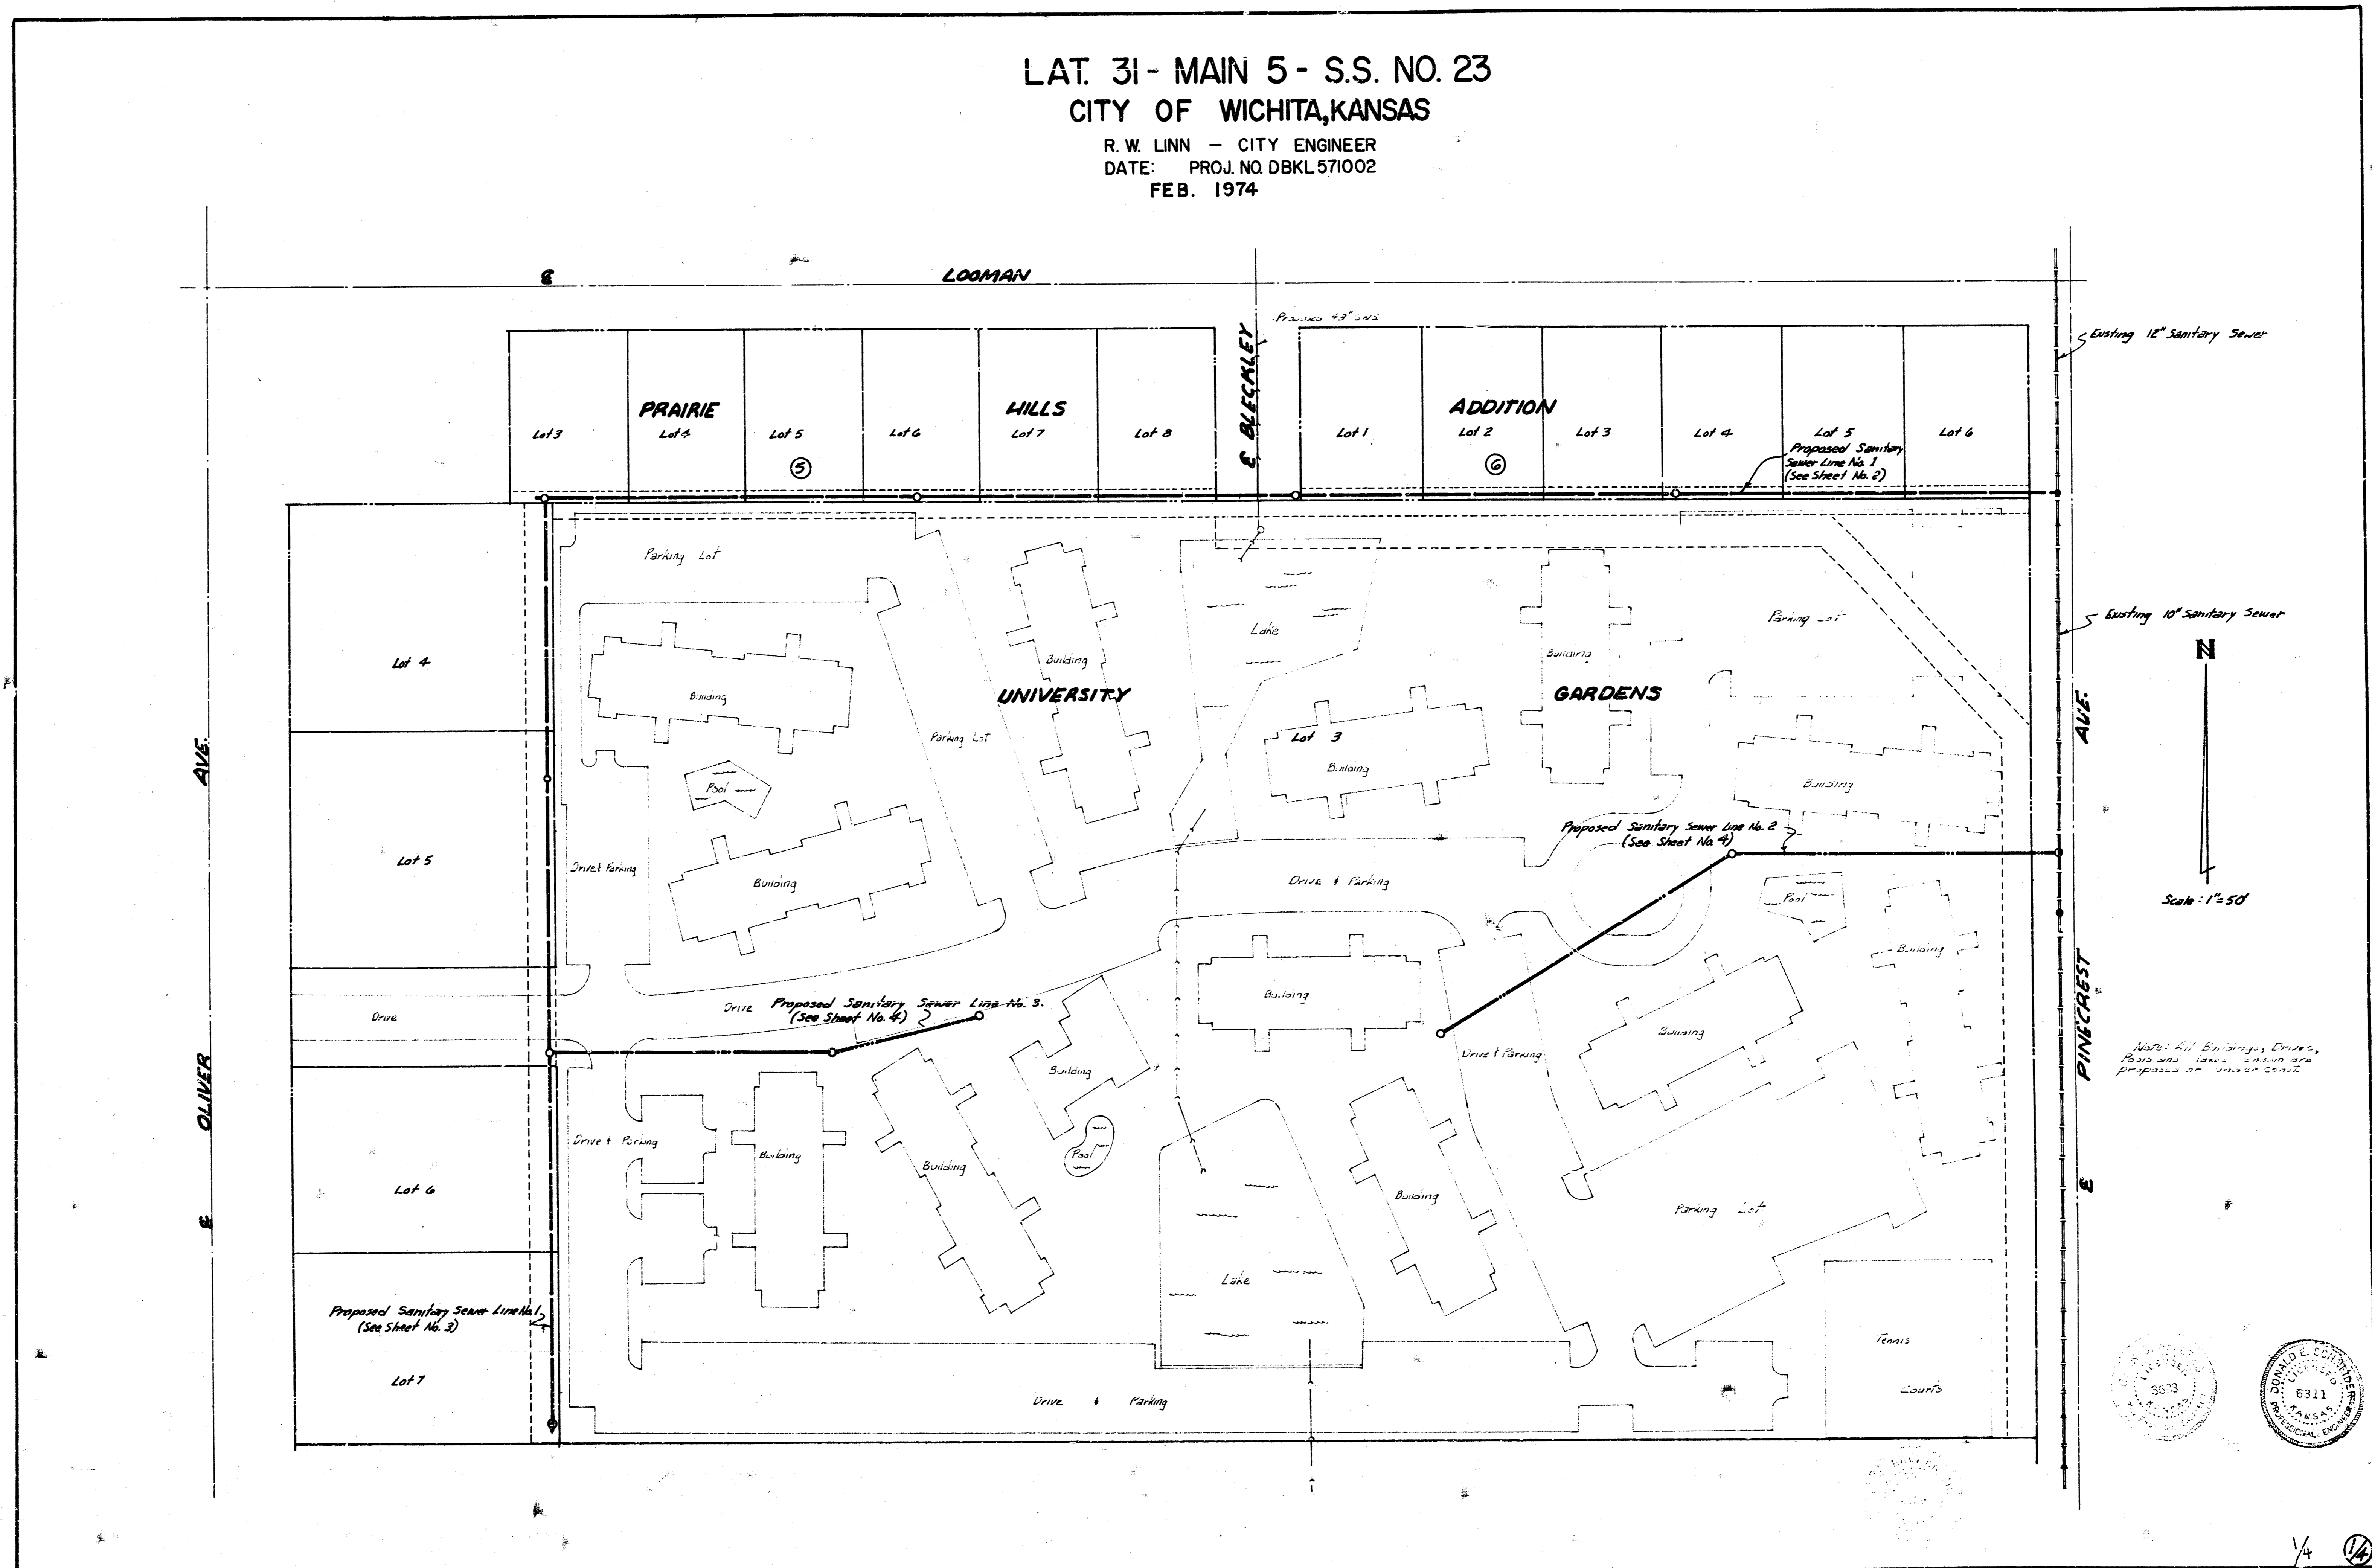


LAT. 31- MAIN 5 - S.S. NO. 23
 CITY OF WICHITA, KANSAS


R. W. LINN - CITY ENGINEER
 DATE: PROJ. NO. DBKL 571002
 FEB. 1974

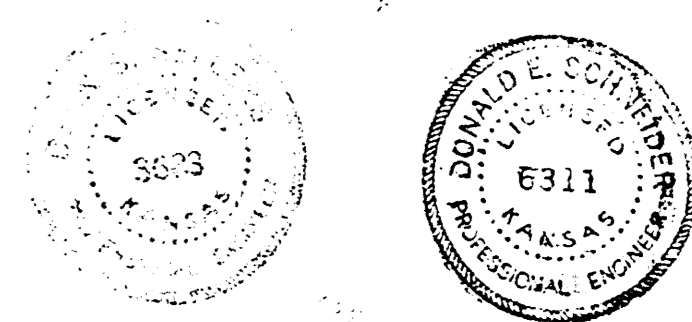

Note: All Buildings, Drives, Pools and Tennis Courts are proposed on other sheets.

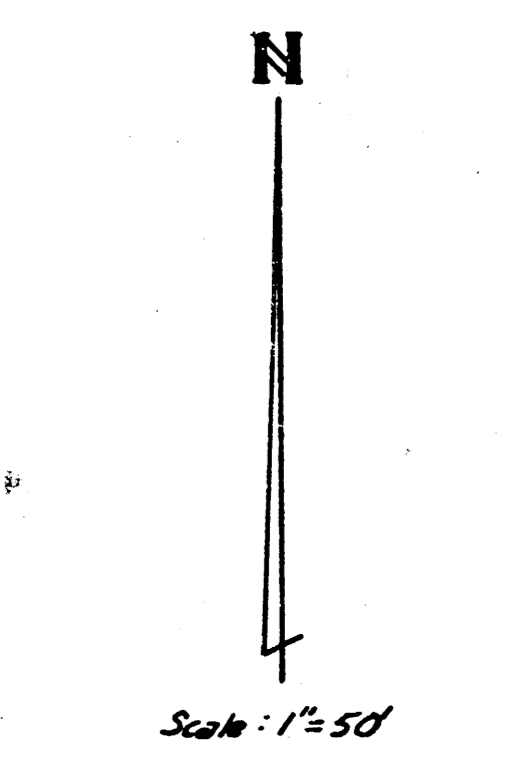

13 Lots Engr
 1 Set under

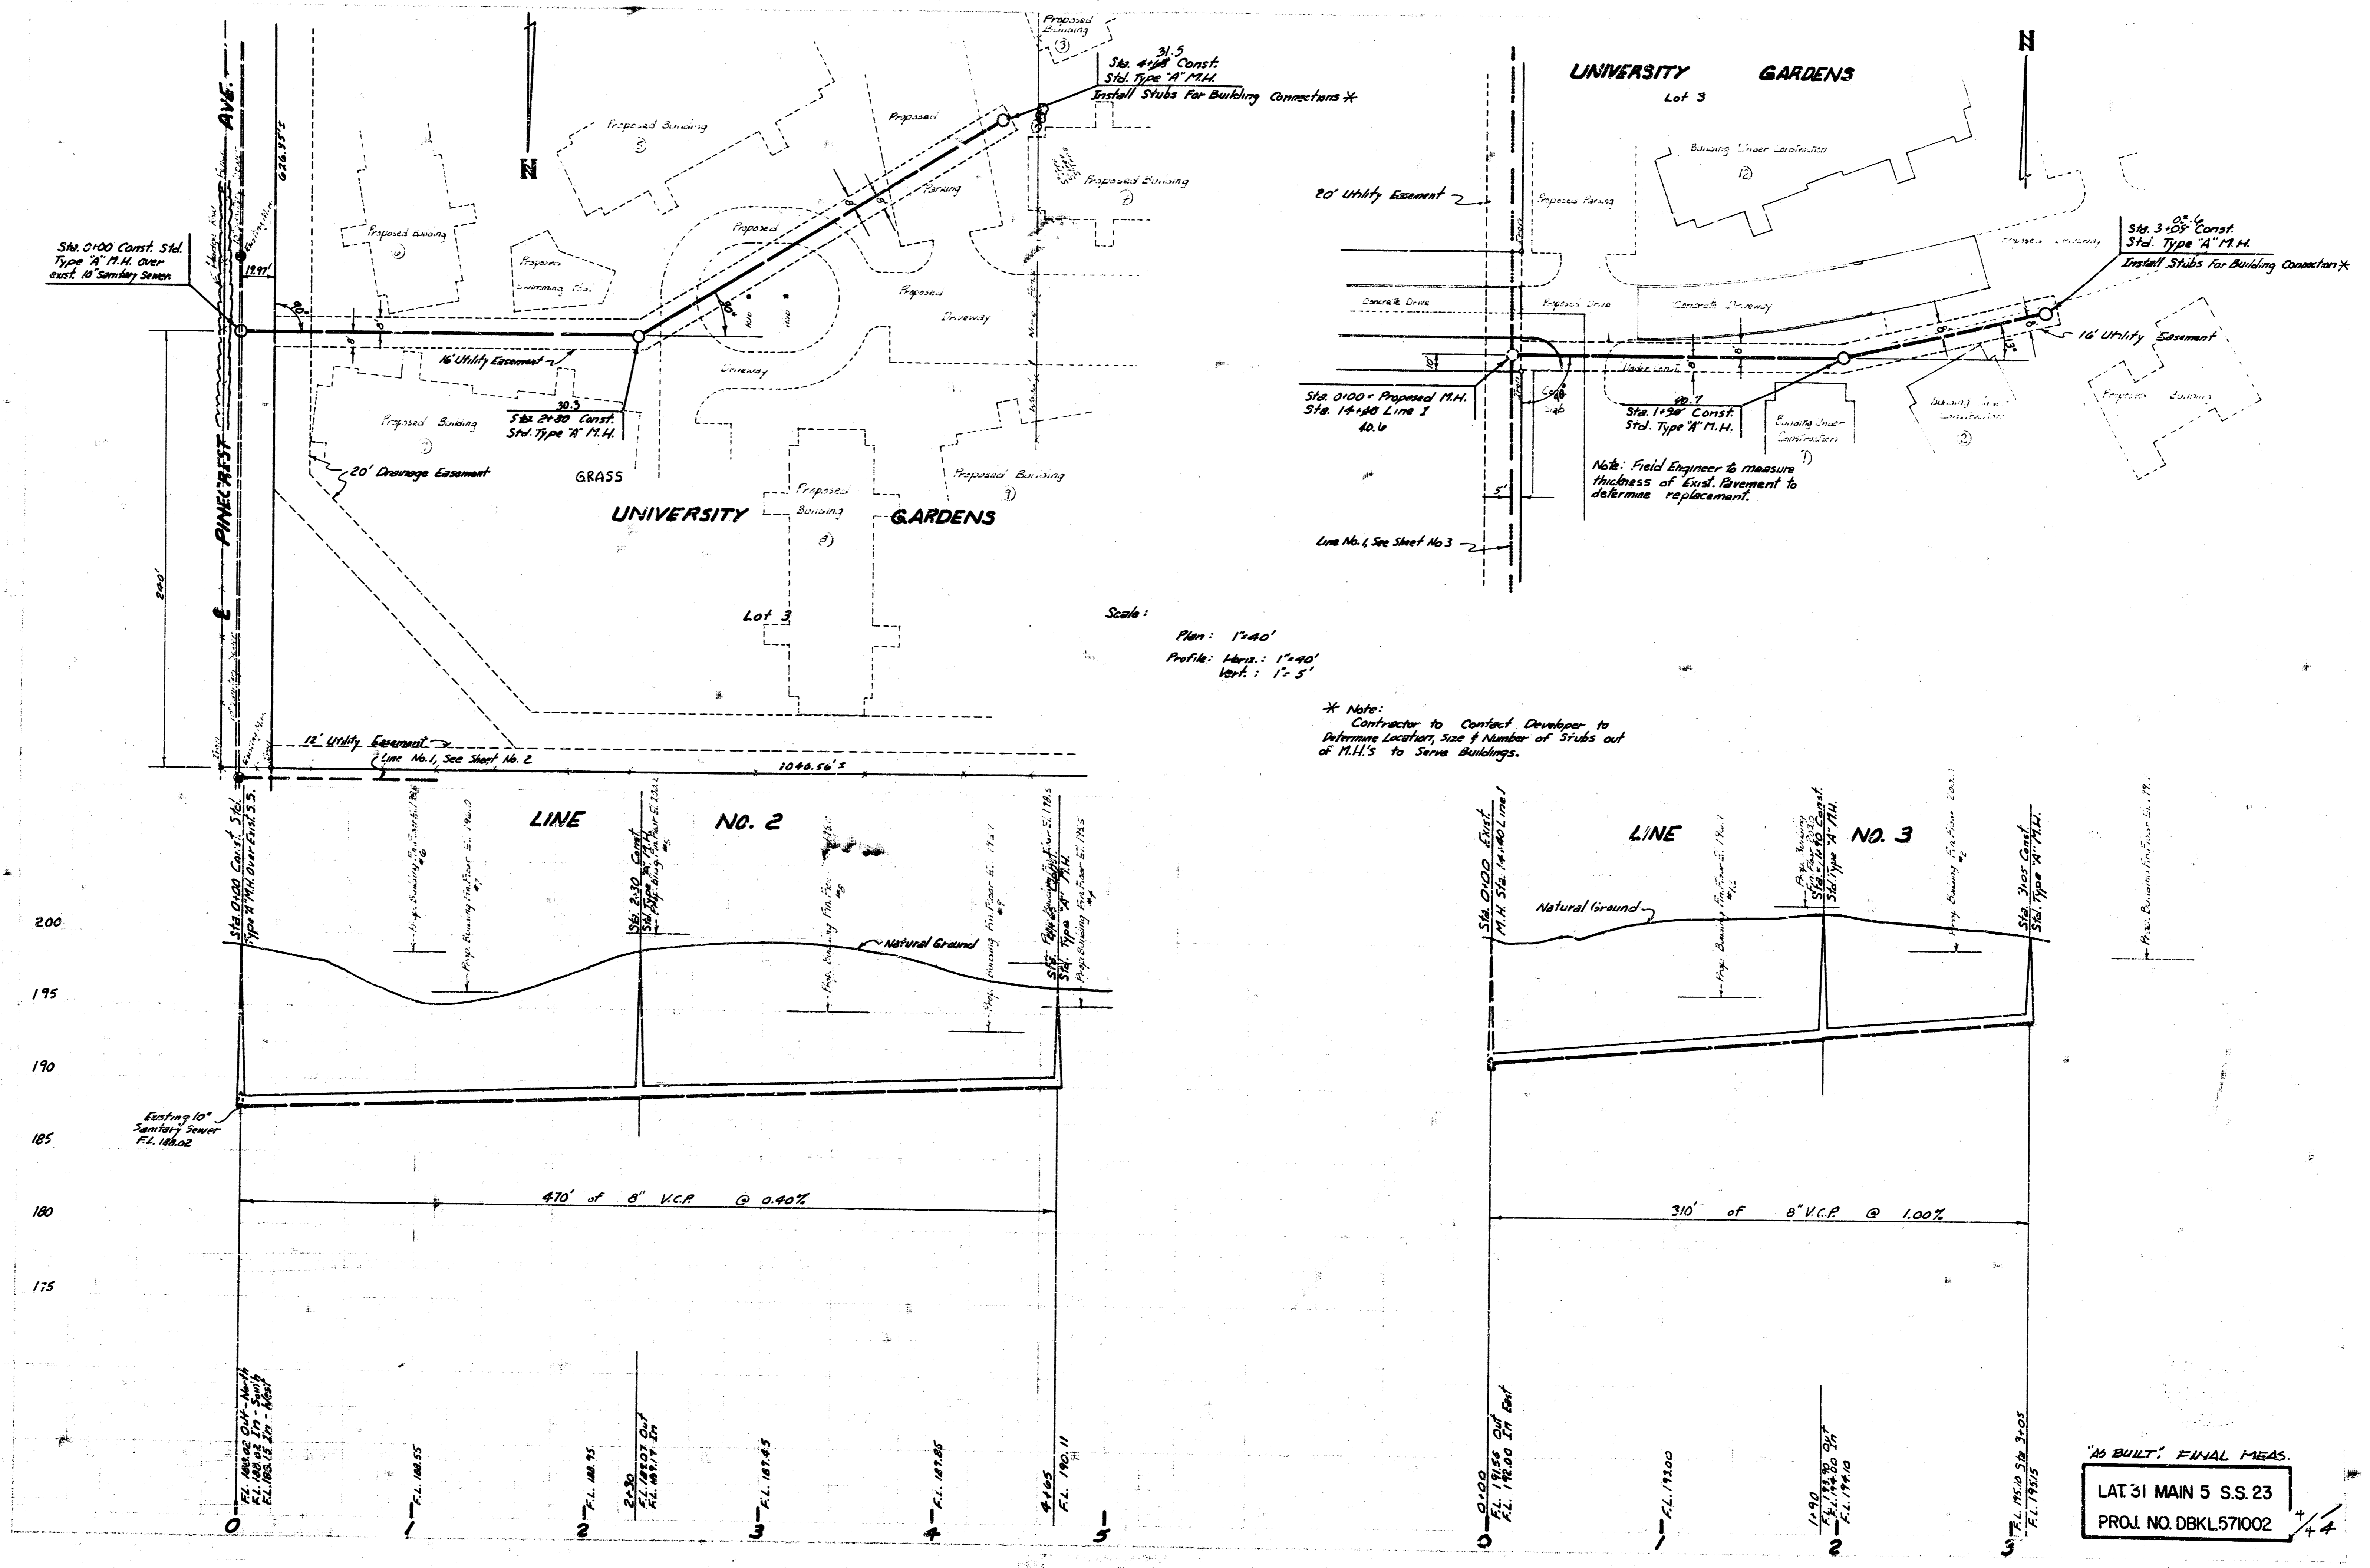

"AS BUILT" FINAL MEAS.
 LAT 31 MAIN 5 S.S. 23
 PROJ. NO. DBKL571002