


NOTE: FIELD ENGINEER TO ESTABLISH SEWER ALIGNMENT USING GIVEN DIMENSIONS AND ANGLES FROM THE S. E. CORNER OF THE N. E. QUARTER OF SEC. 1, T27S, R1E OF 6TH P. M.

This project will be constructed under the supervision of the CITY ENGINEER and conforming to the SPECIFICATIONS of the CITY OF WICHITA. The CONTRACTOR will reimburse the City of Wichita for all cost of Engineering, Plans, and Inspection.

Plan Scale 1" = 40'
Prof. Scale Hor. 1" = 40'
Prof. Scale Ver. 1" = 5'

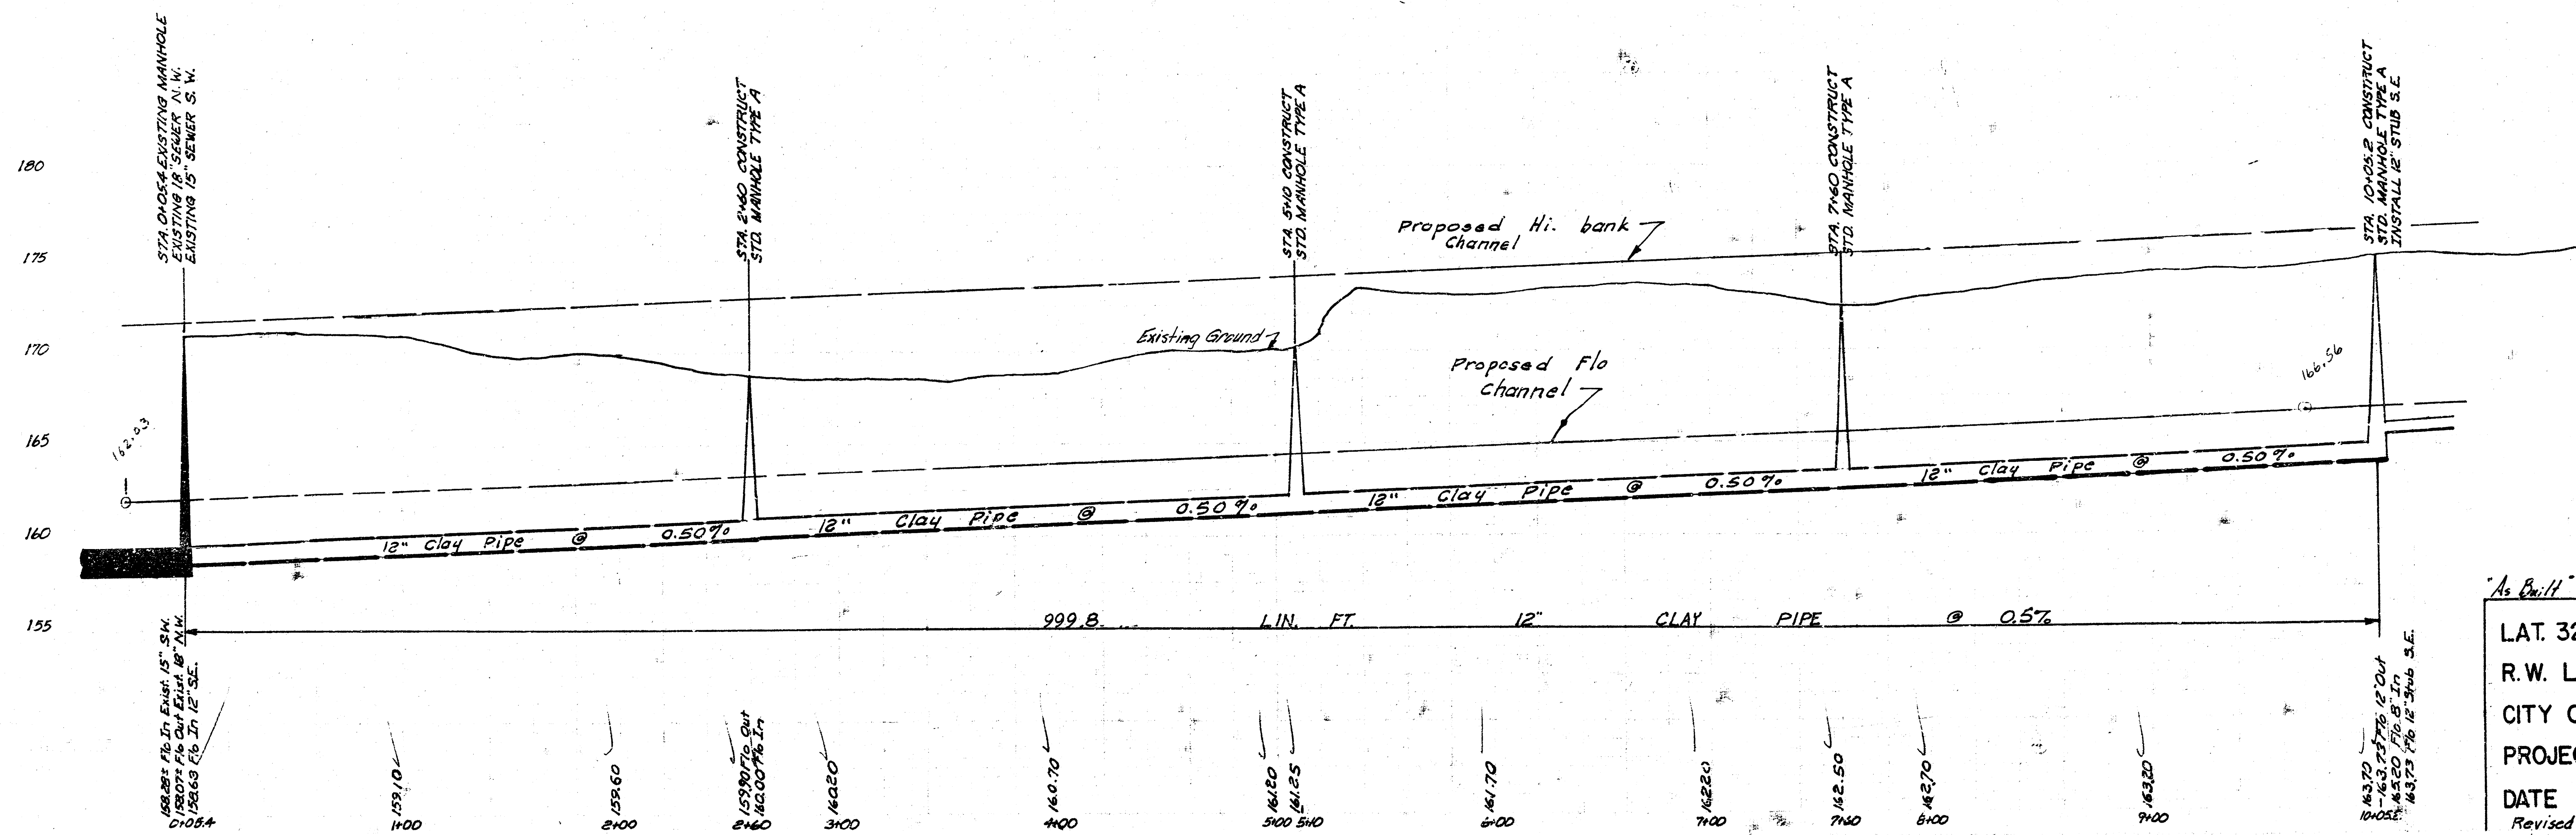


"As Built" Final measmts. IH-80


LAT. 32, MAIN 5, S.S. NO. 23
R. W. LINN CITY ENGINEER
CITY OF WICHITA, KS.
PROJECT NO. AAKB 502027
DATE Aug. 1972
Revised 10-20-73
Sheet #1 1-31-73 1/2

PLAN 10-20-72

B. M. 200.45 CITY STD. @ N.E. COR. WOODLAWN & 21ST ST.
B. M. 188.48 CITY STD. @ WOODLAWN & 25TH ST. NO. 26'S. & 47'E. OF N.E. COR.

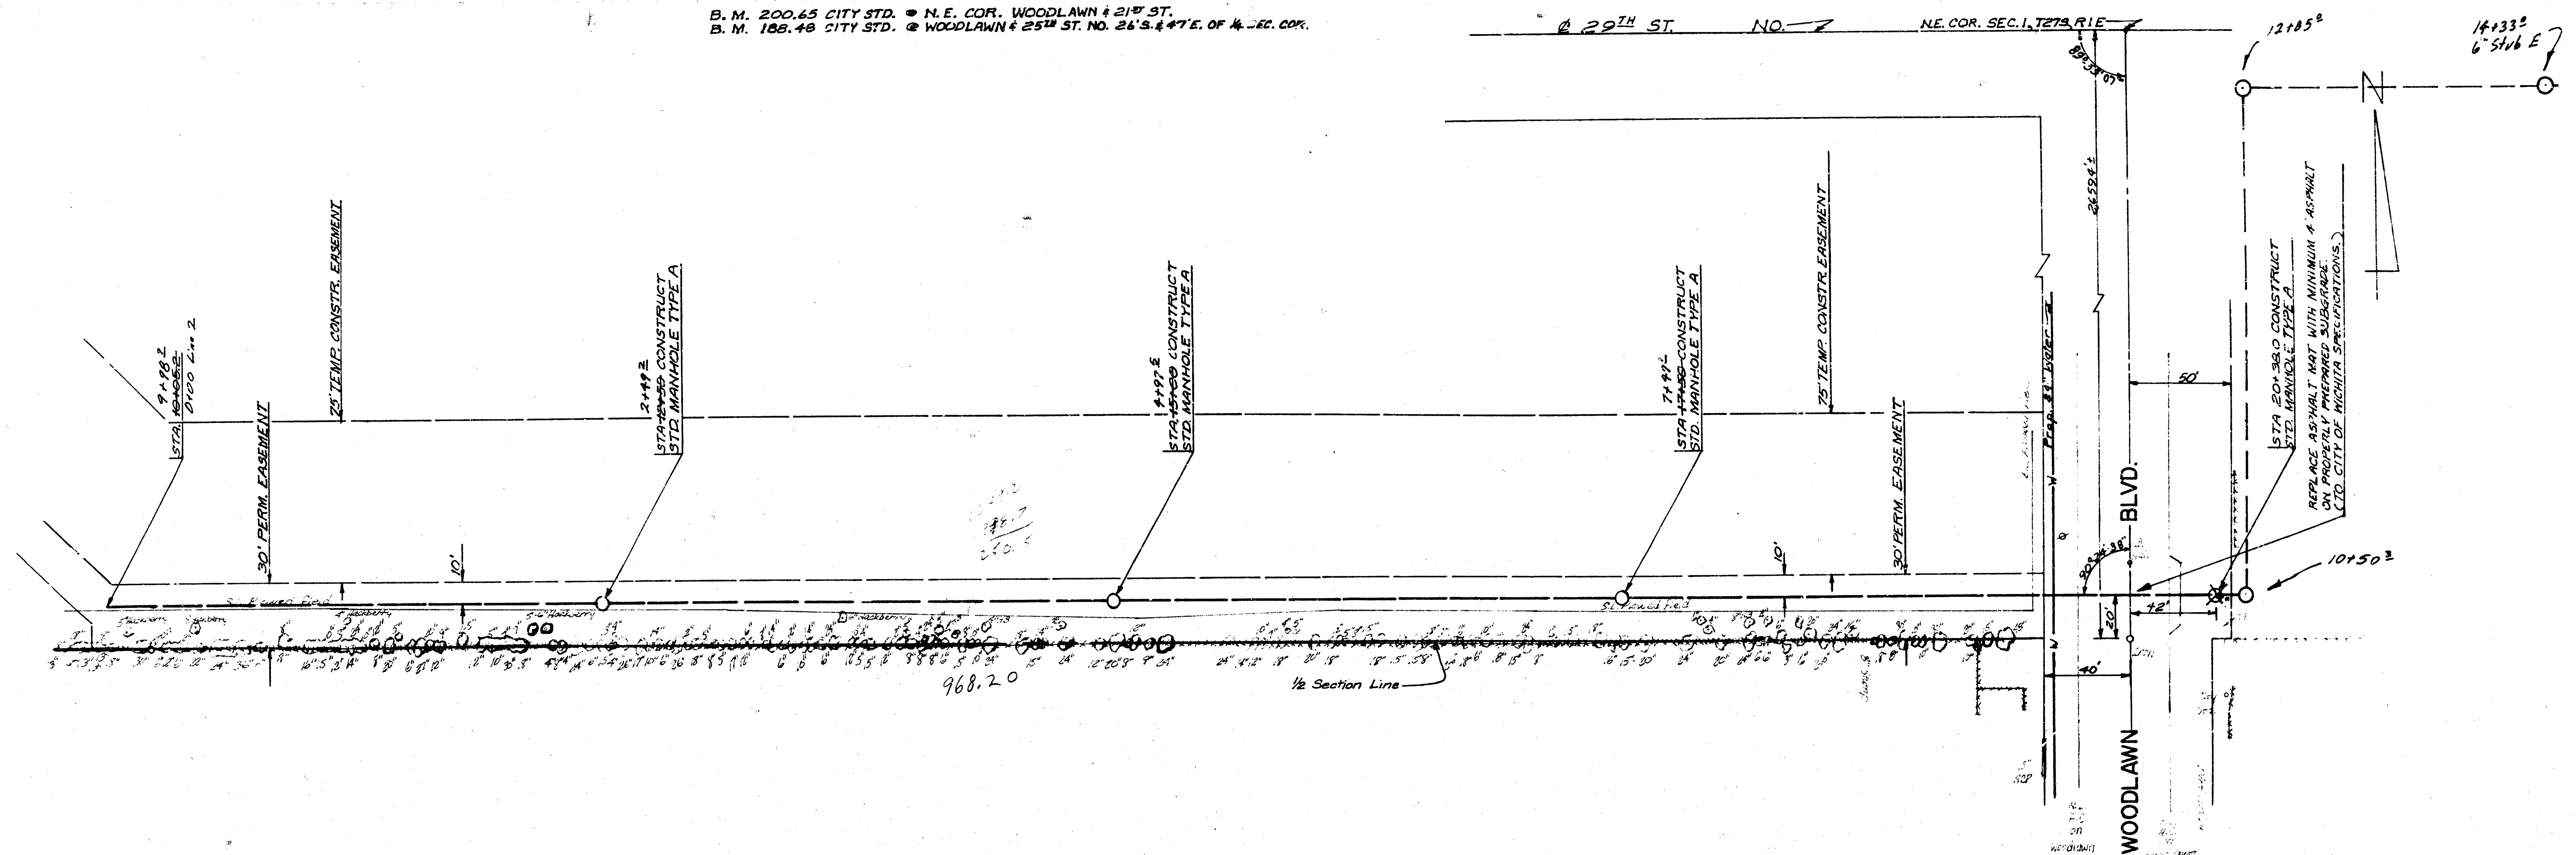

190
185
180
175
170
165
160

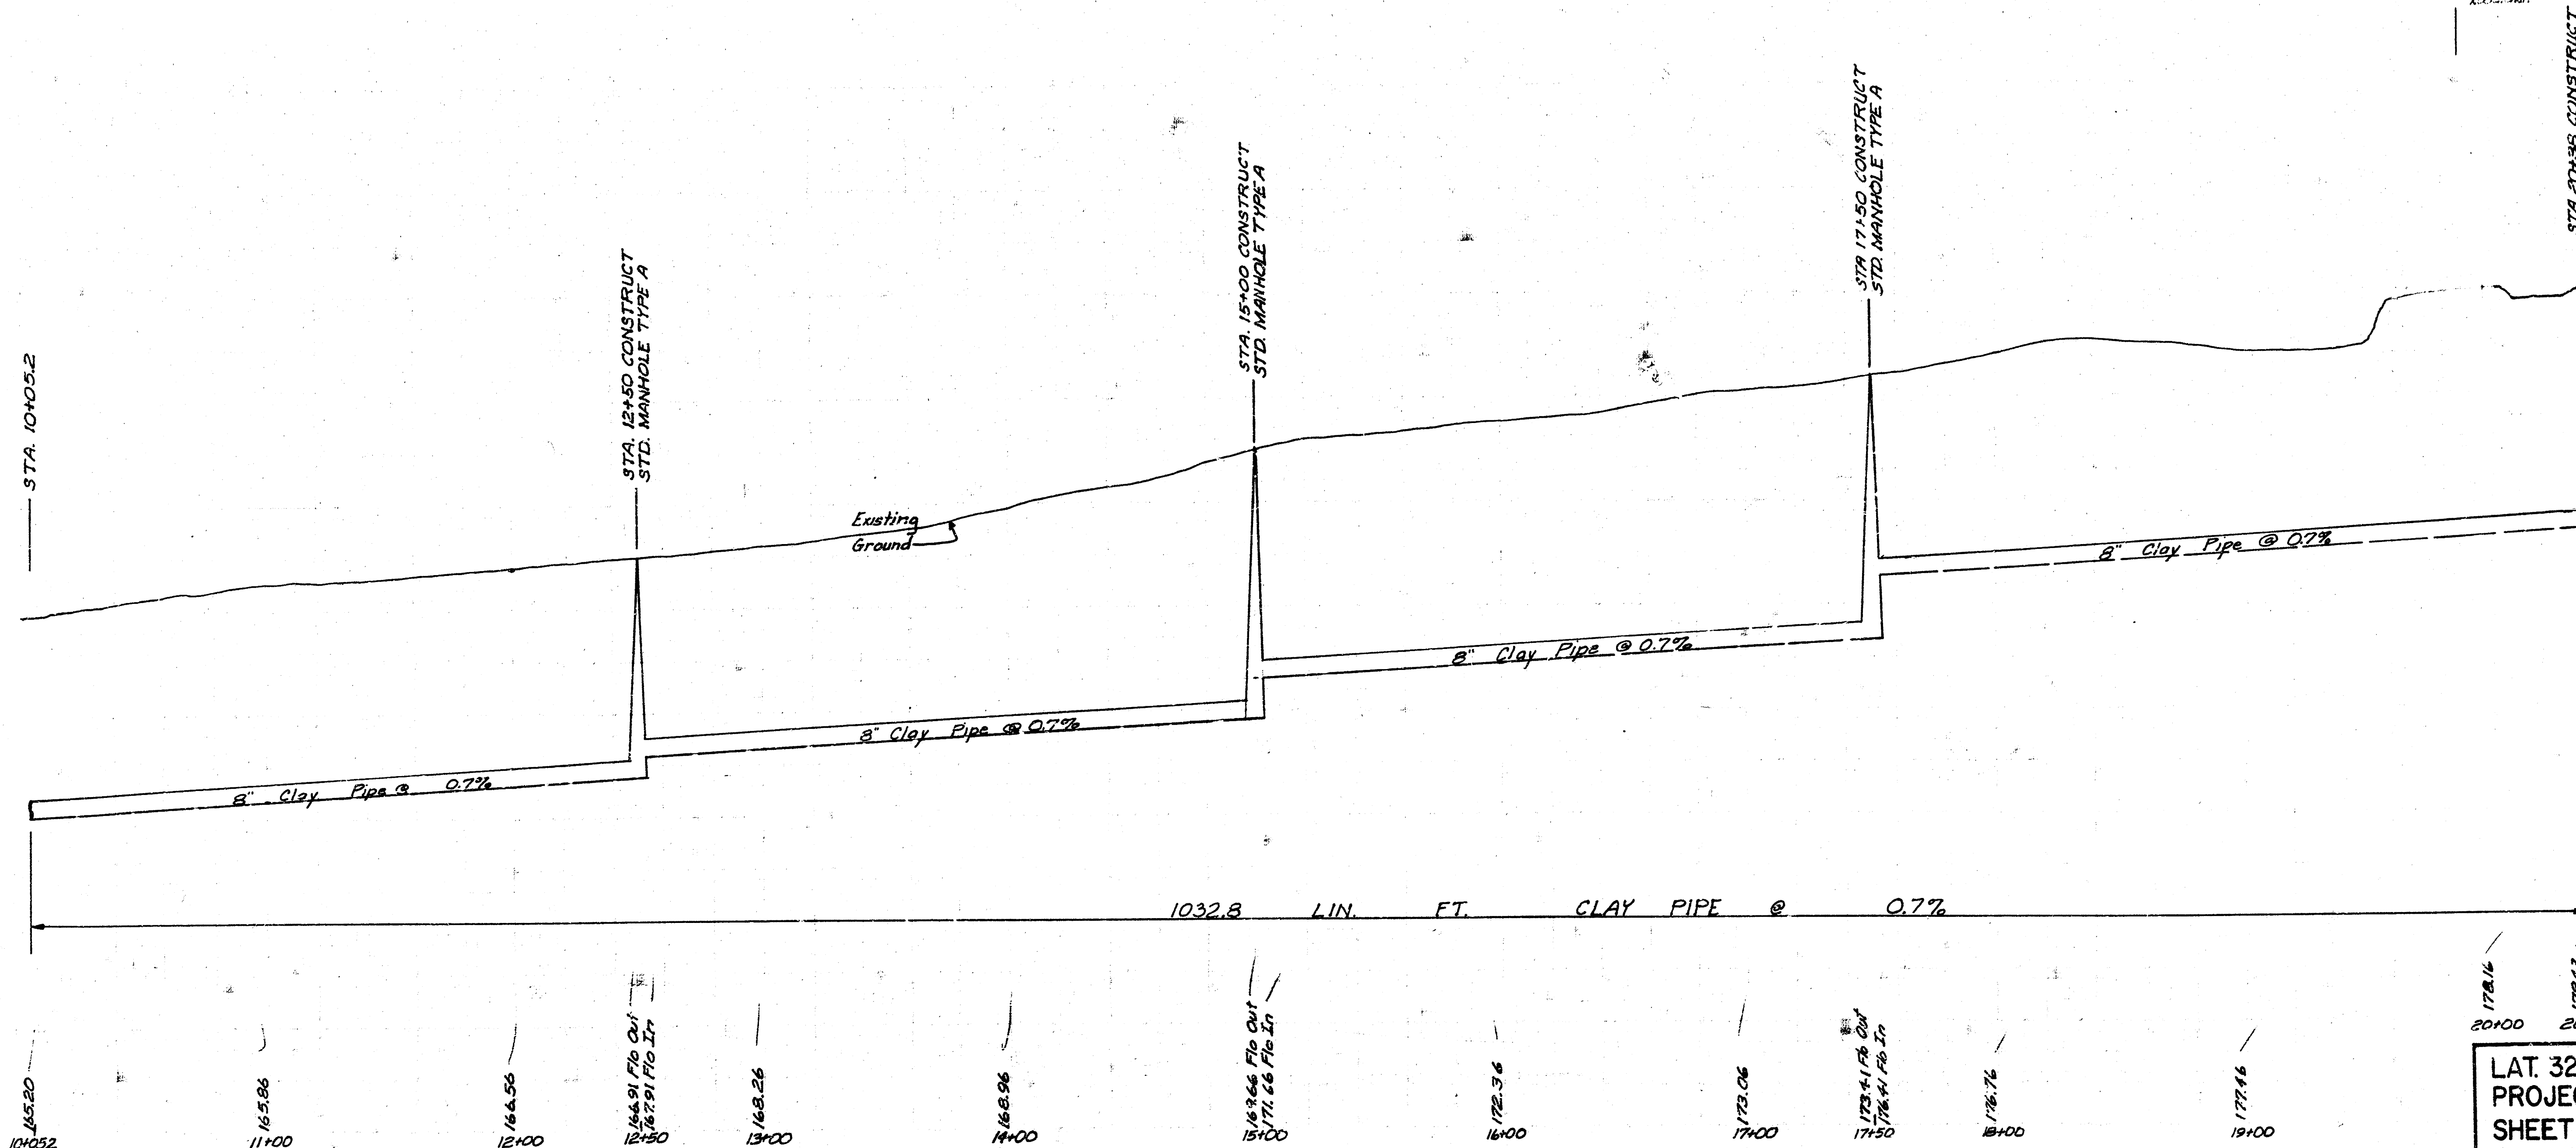

Plan Scale 1"=40'
Profile Scale Hor. 1"=40'
Profile Scale Ver. 1"=5'

LAT. 32, MAIN 5, S.S. NO. 23
PROJECT NO. AAKB 502027
SHEET NO. 2 of 2
Revised 10-20-72

FILMED FROM THE BEST