


LATERAL 44, MAIN 5, SANITARY SEWER No. 23

Project no. 468-76-245-81320-000-000-001

CITY OF WICHITA, KANSAS
MIKE LINDEBAK CITY ENGINEER

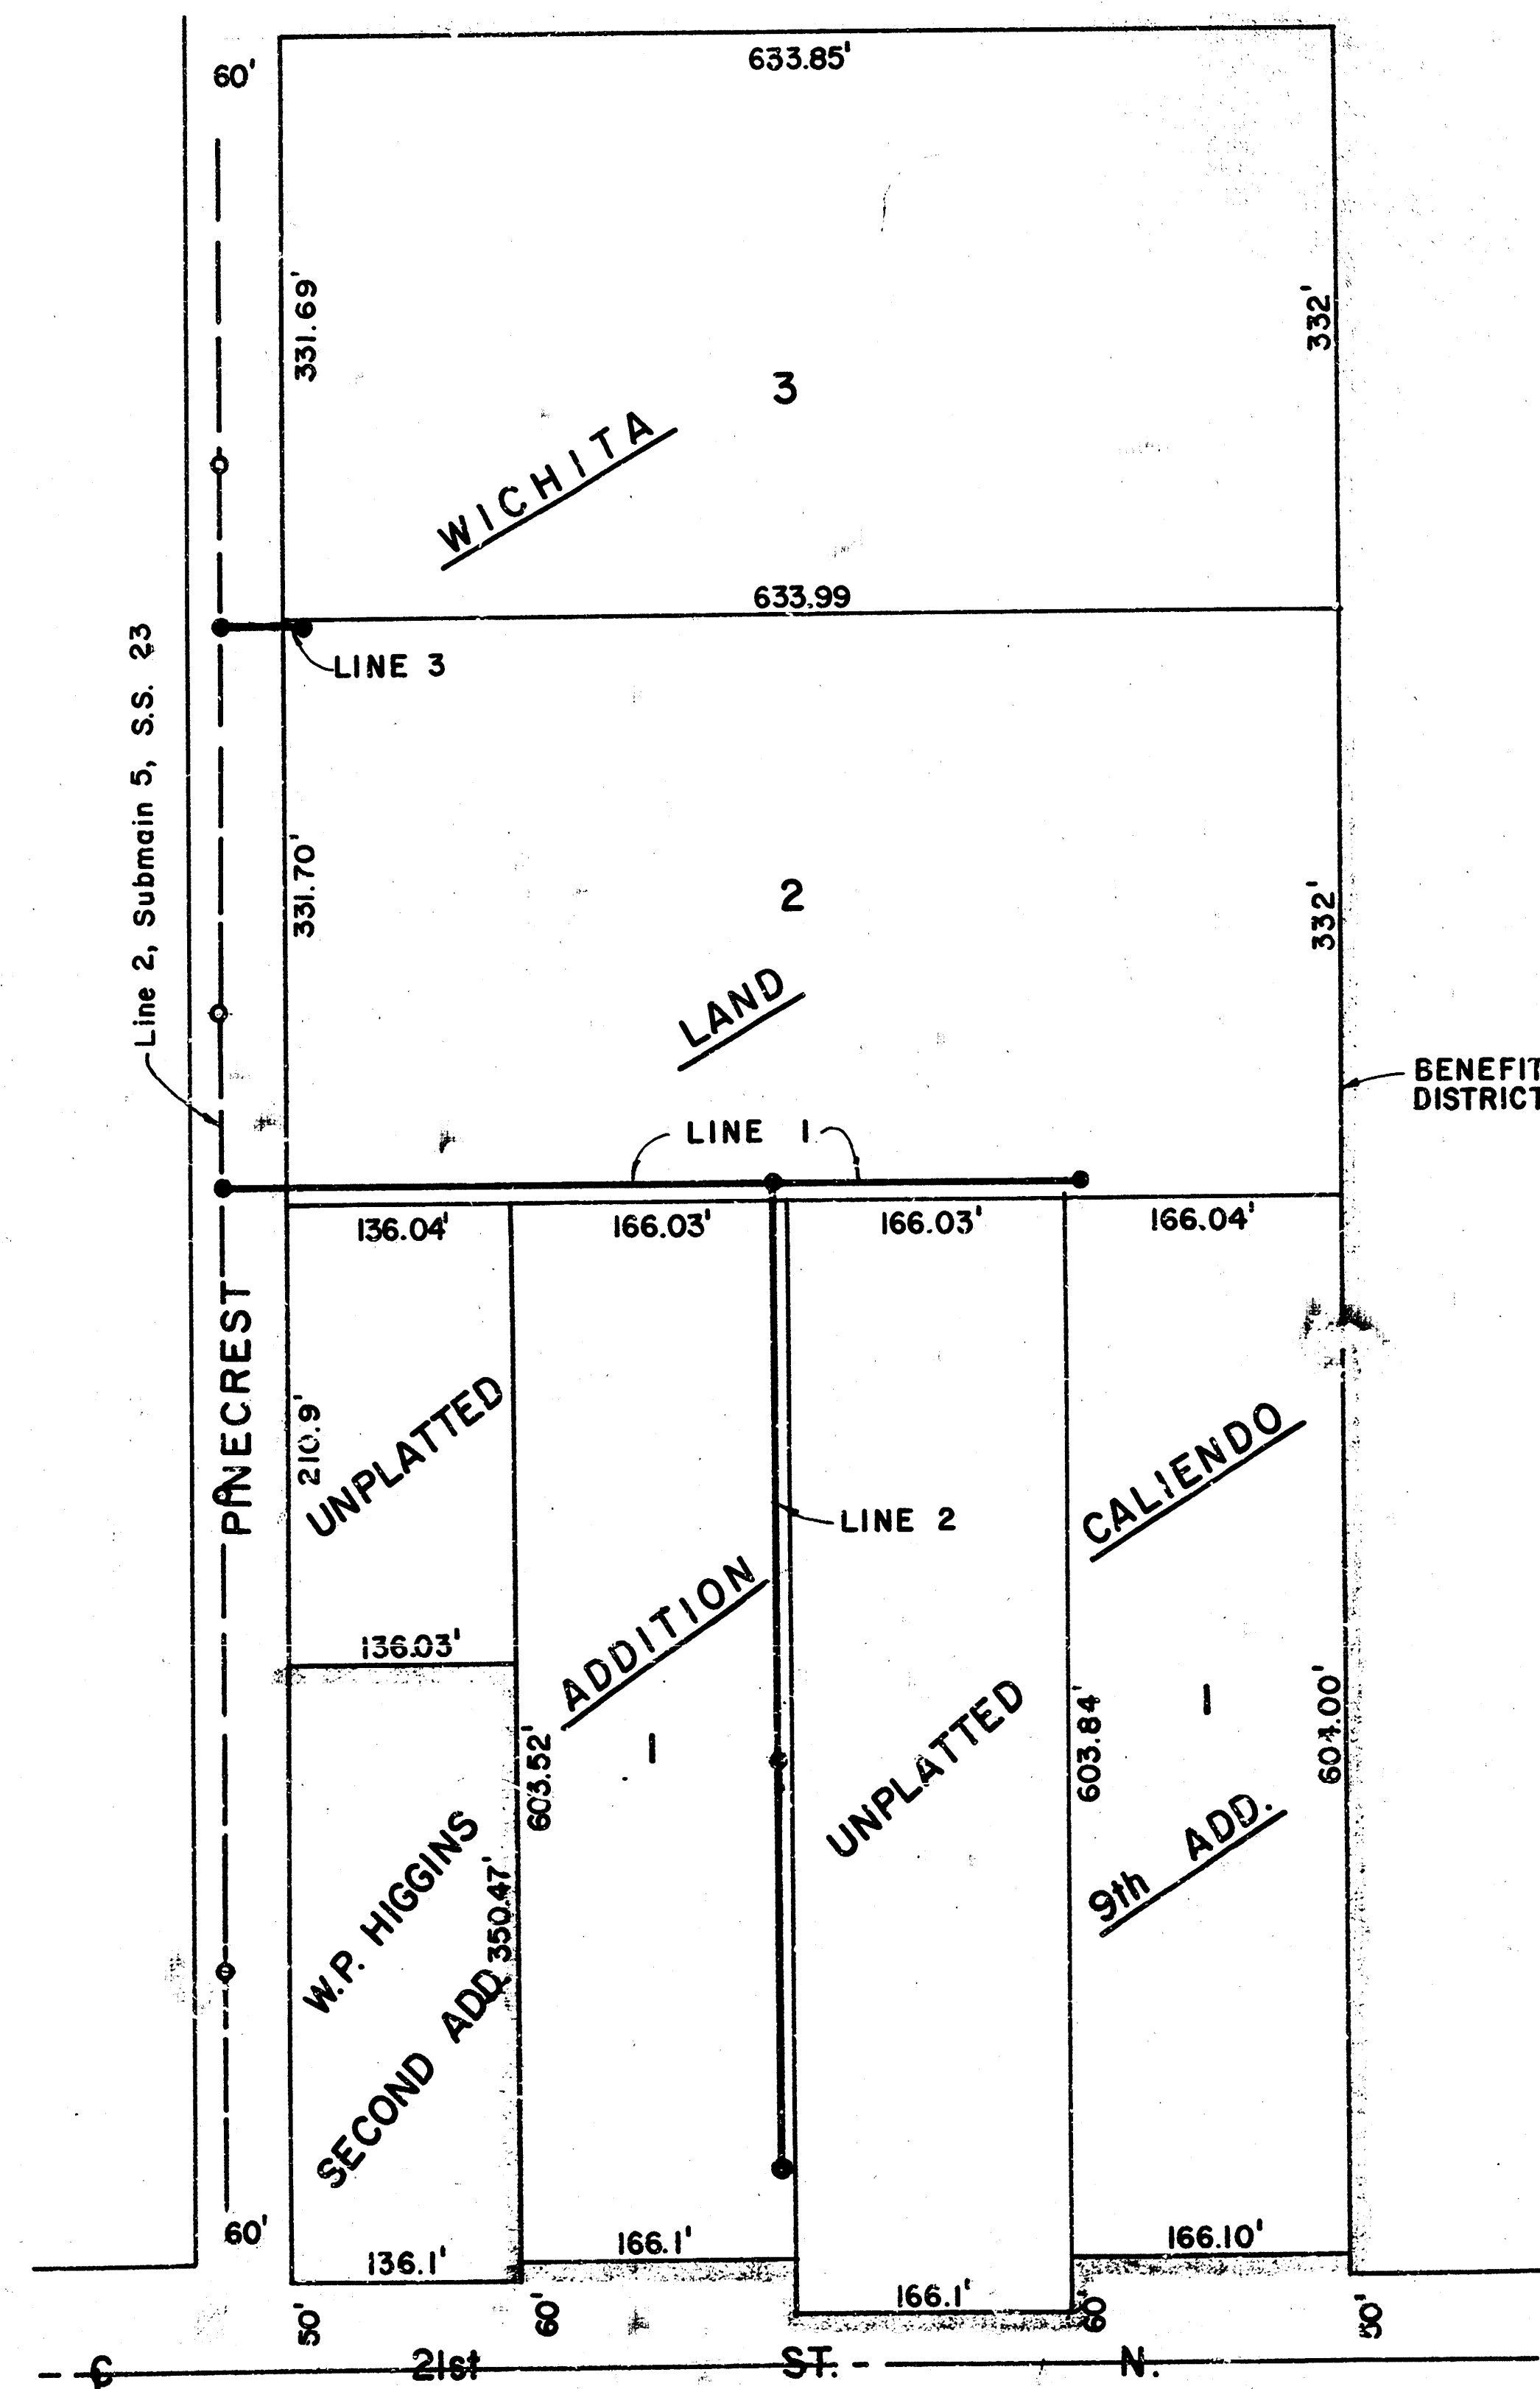

As Built
J.L.L.
8-84



1/3

BAUGHMAN COMPANY, P.A.
SURVEYING & ENGINEERING
316/262-7271 • 330 LAURA • WICHITA, KANSAS 67211

FILMED FROM THE BEST

WICHITA

Lot 2

LAND

Unplatted

STA. 0+00 = 3+34.5 (LINE 1)
TYPE "A" OR "C" STD. M.H.
TOP 215.2
210.2

STA. 3+30^{1/2} CONSTRUCT
TYPE "A" OR "C" STD. M.H.
TOP 220.2
219.7

STA. 5+65 CONSTRUCT
TYPE "A" OR "C" STD. M.H.
TOP 224.8
223.2 6" STD. W.

STA. 0+00 CONSTRUCT
TYPE "A" OR "C" STD. M.H.
OVER EXISTING 10" V.C.P.
TOP 189.1
188.1


STA. 0+45 CONSTRUCT
TYPE "A" OR "C" STD. M.H.
TOP 200.6
NE. & S.E. 1/4

SCALE:
PLAN - 1" = 40'
PROFILE - 1" = 40' HORIZ.
1" = 5' VERT.

As Built
J.L.L.
8-84

LINE 2

LINE 3

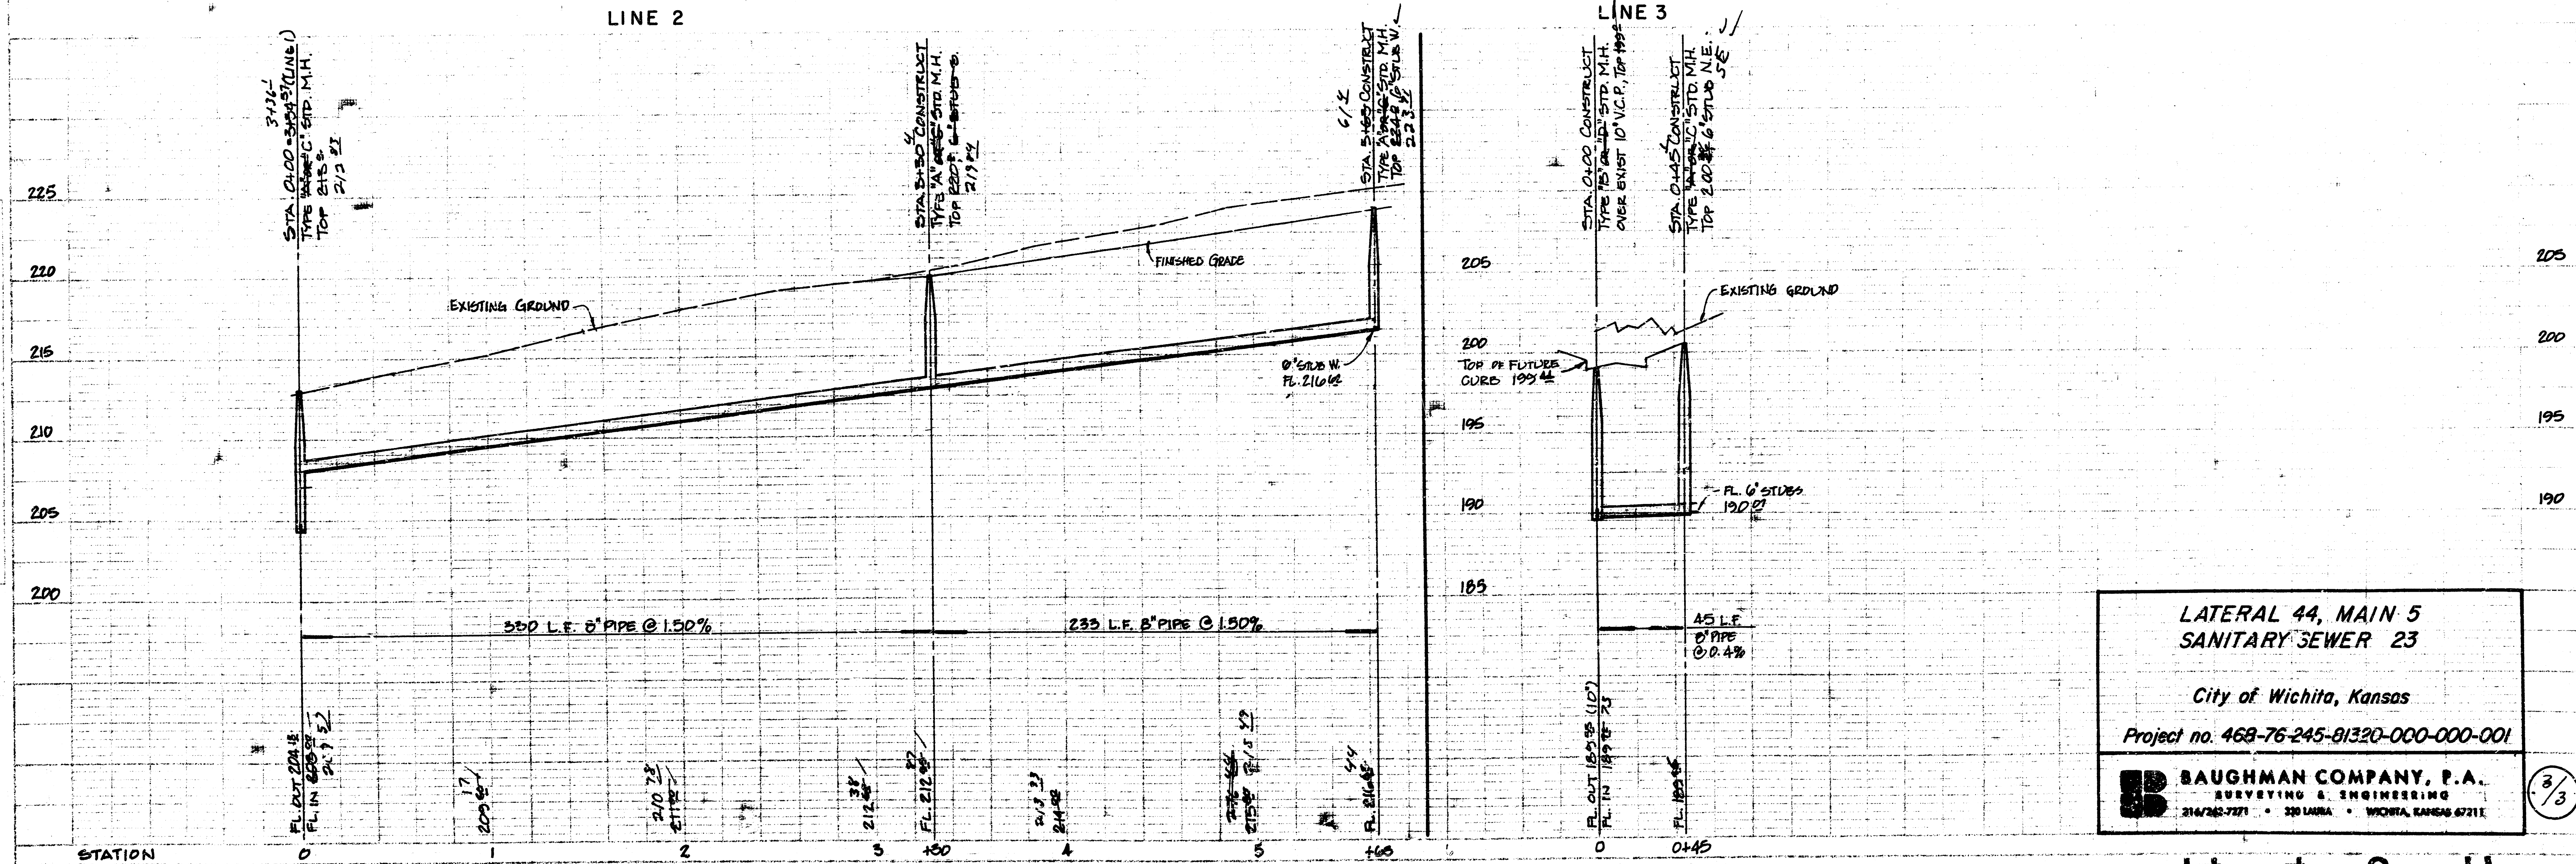

LATERAL 44, MAIN 5
SANITARY SEWER 23

City of Wichita, Kansas

Project no. 468-76-245-81320-000-000-001

BAUGHMAN COMPANY, P.A.
SURVEYING & ENGINEERING
214/262-7271 • 330 LANNA • WICHITA, KANSAS 67211

2/3

FILMED FROM THE BEST