


B.M. - R.R. Spike Imbedded in N. Key Wall of Outlet Structure on Comotara Lake. Elev. - 188.00

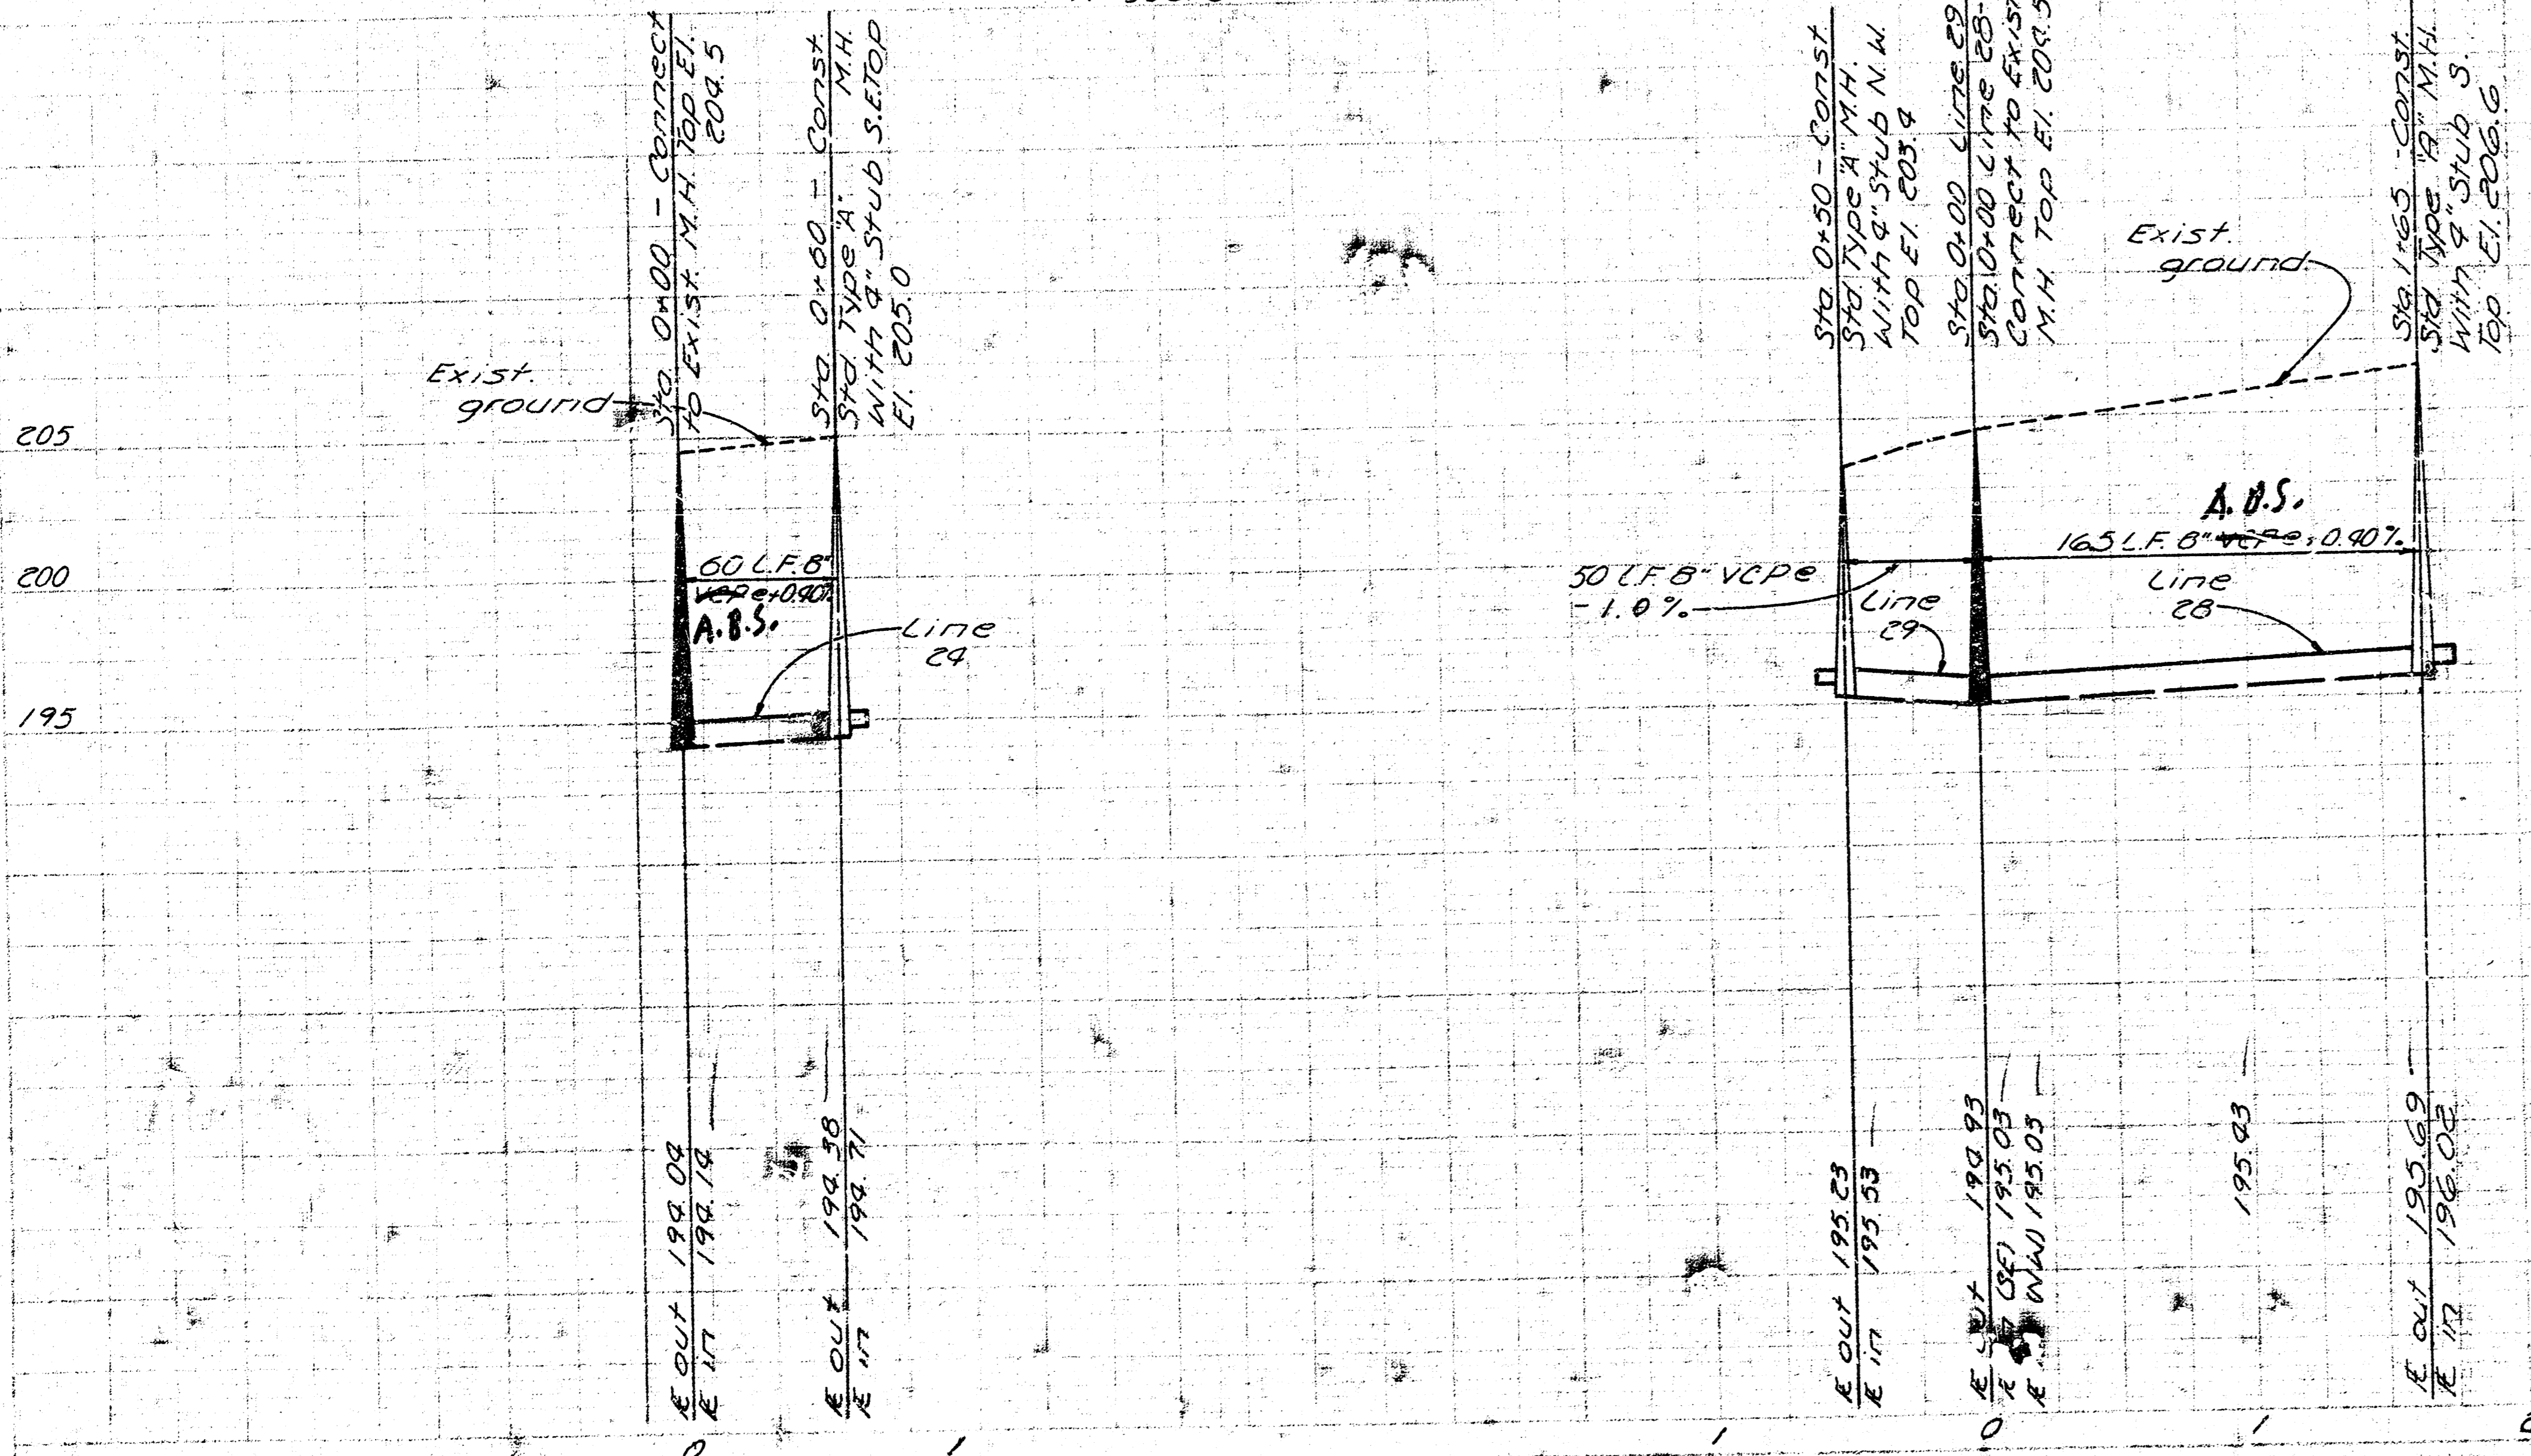

As built 8-15-77  
**PHEASANT RUN ADDITION**  
 WICHITA, KANSAS  
 LAT. 6 MAIN 6 S.S. NO. 23  
 PROJ. NO. DBKL 576001  
 SHEET 1 OF 1 LINE NO. 24 & 29

41 4 01 41