

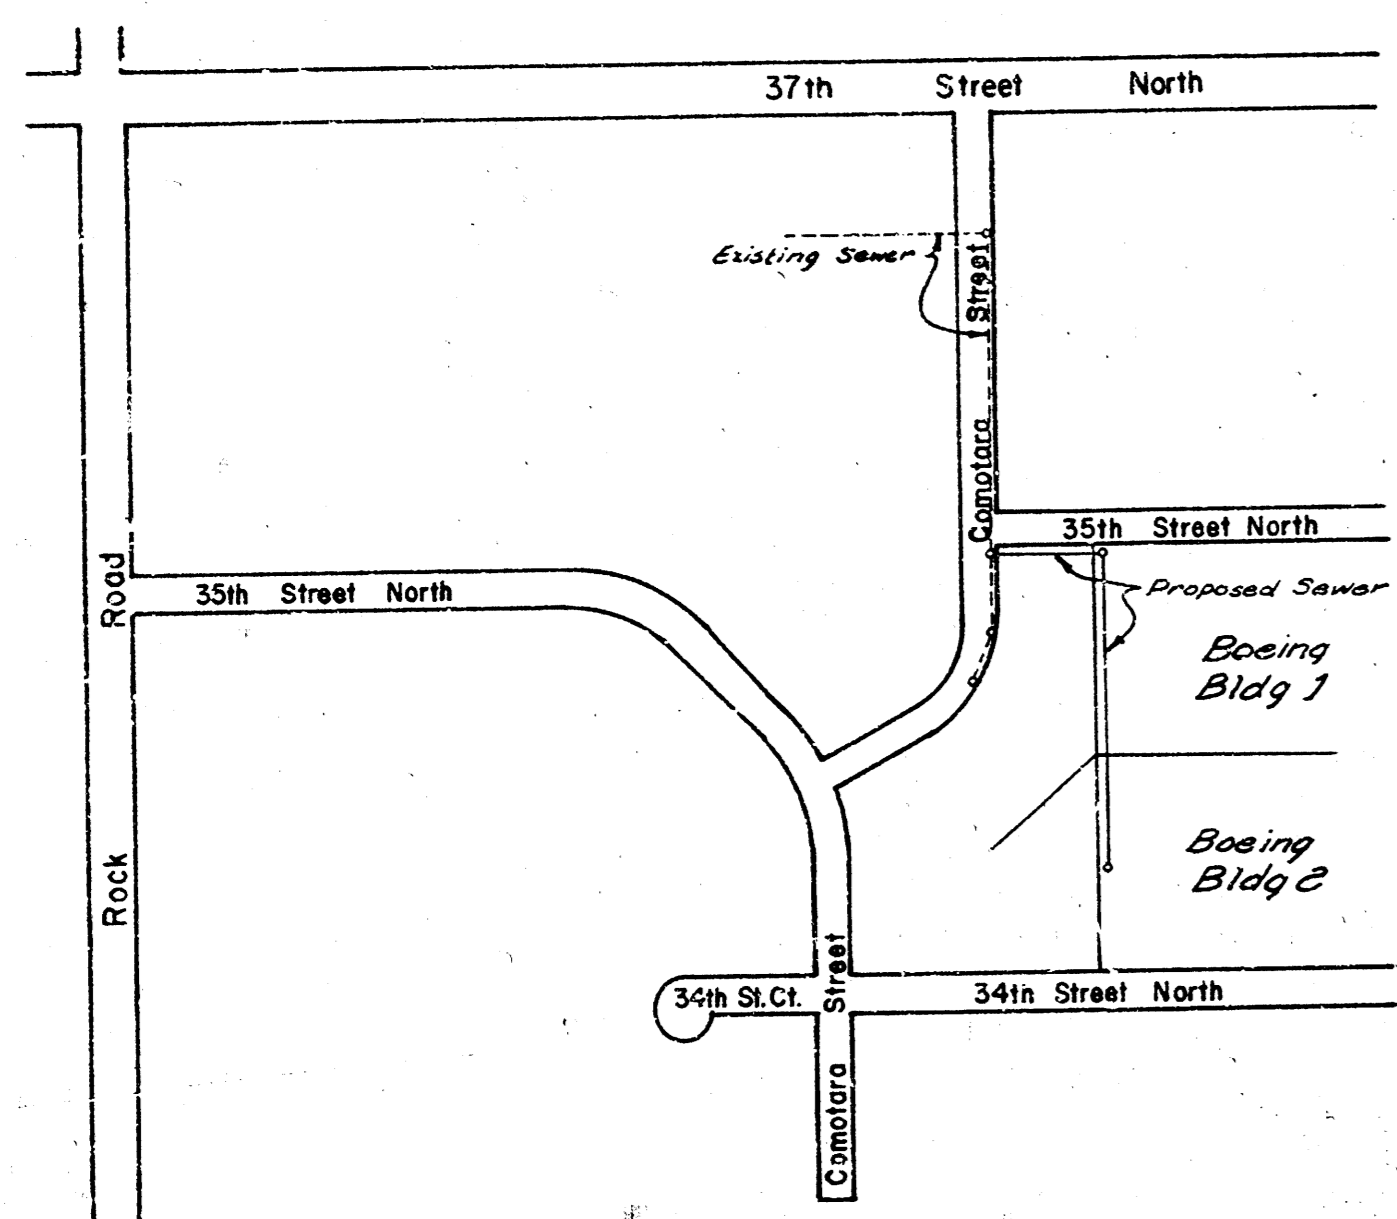


LATERAL 15, MAIN 7, S.S. 23
 Project No.
 468-76-245-80667-000-000-001

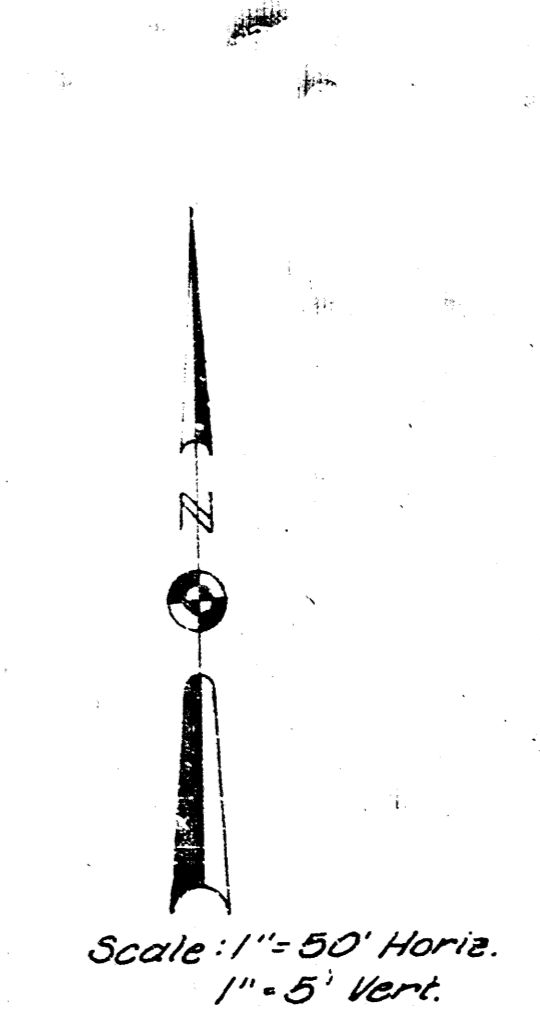

LOCATION MAP

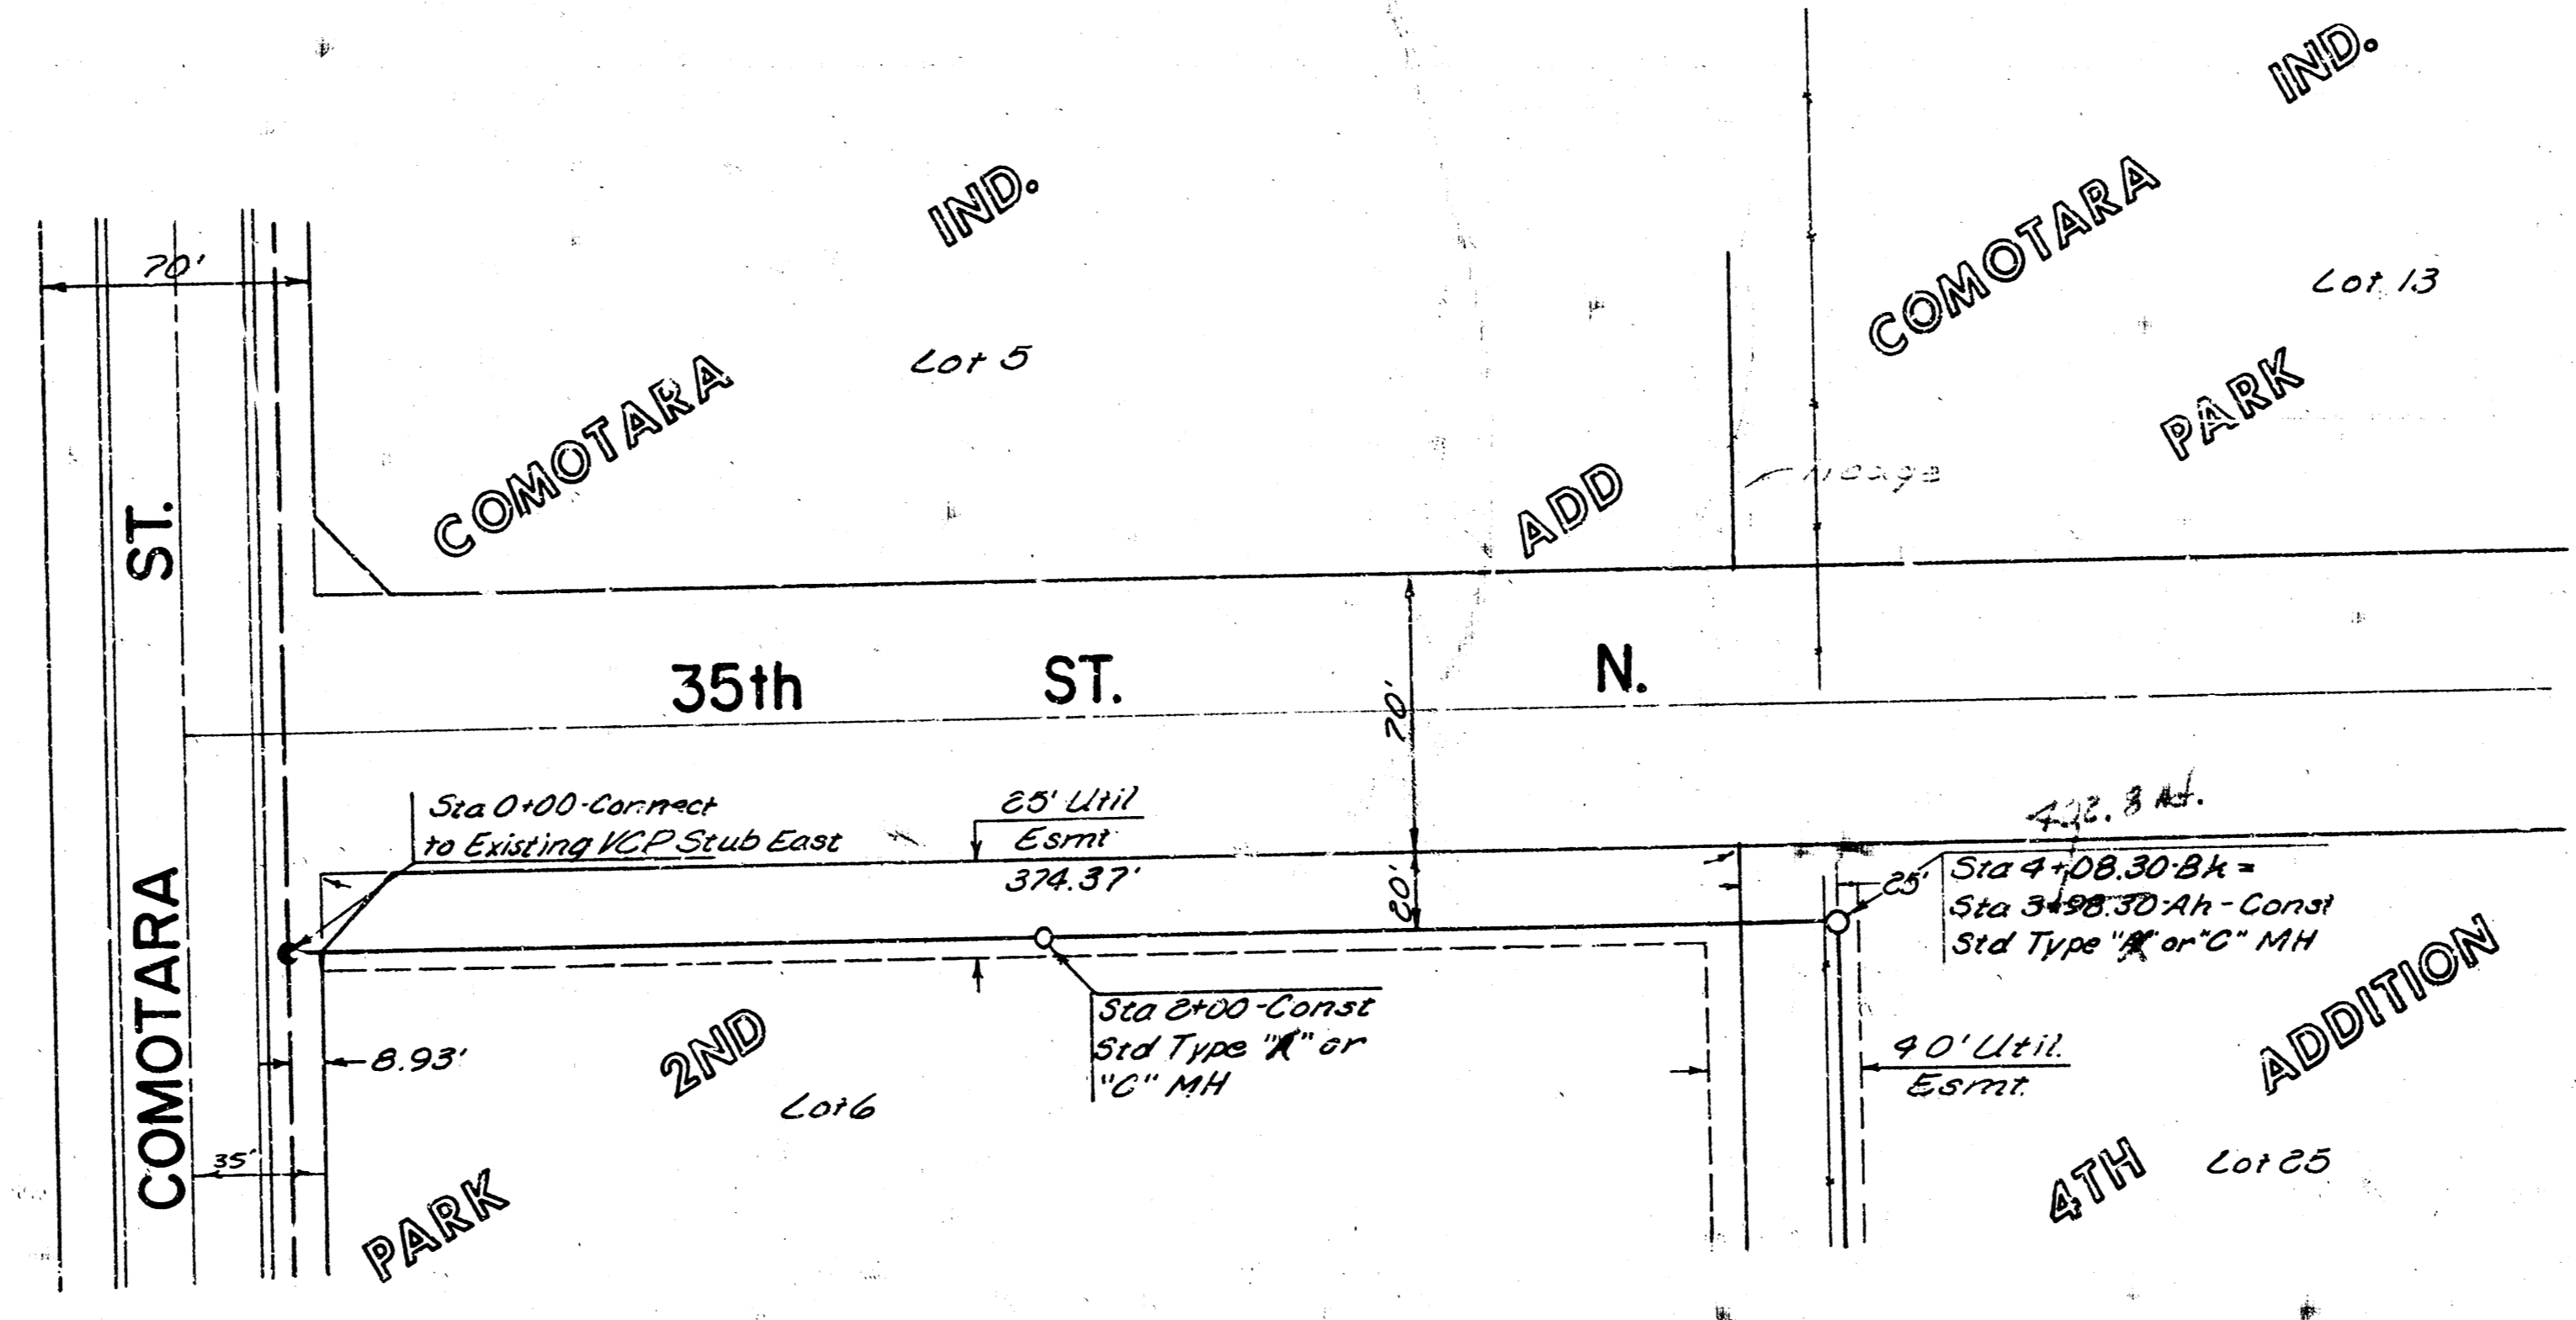


Scale: 1" = 50' Horiz.
 1" = 5' Vert.

*Benefit Dist.
 Lot 25 & 26 Comotara Ind. Park 4th
 Lot 2 Comotara Ind. Park 5th*

NOTE: SEE RESOLUTION FOR BENEFIT DISTRICT.

Revised 12-27-78, Sewer line moved 10' East to avoid conflict with new H&E power poles

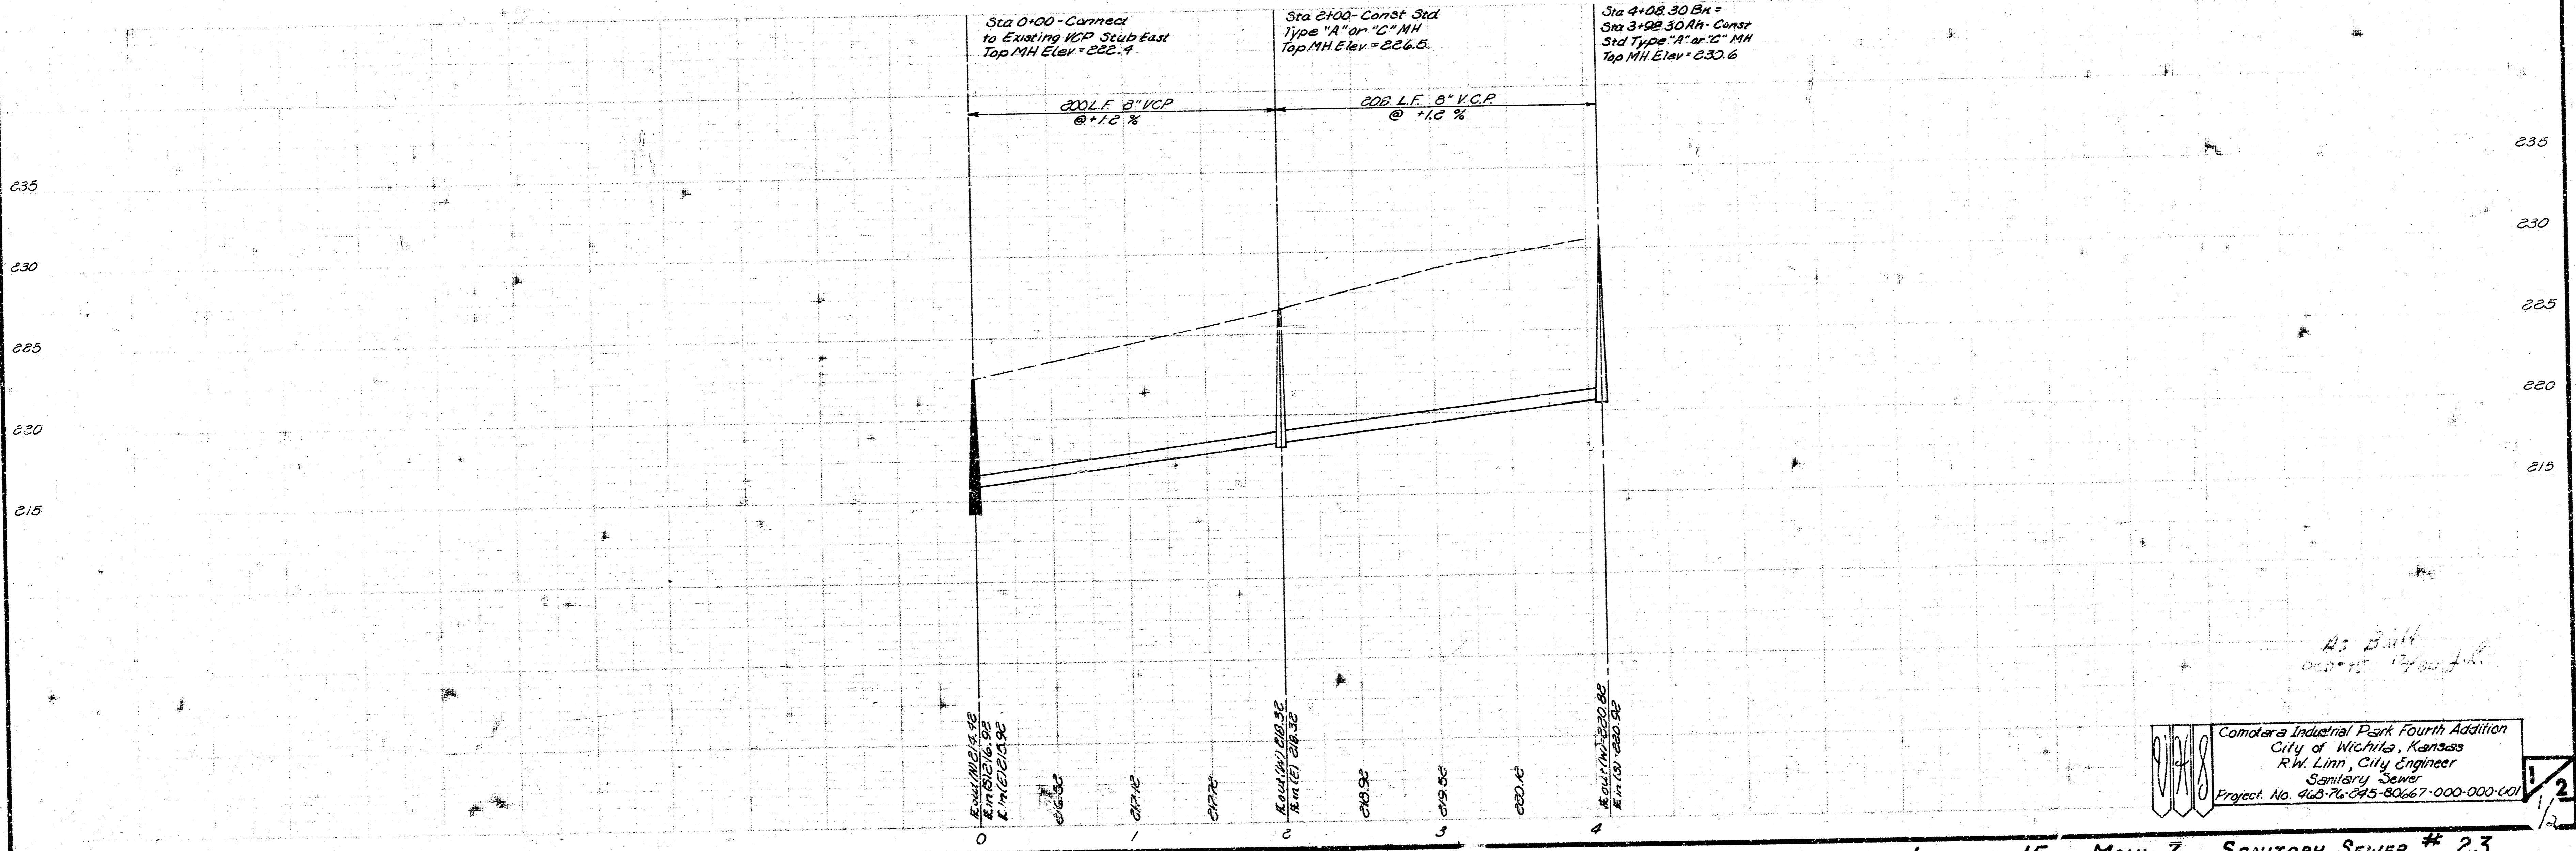

Comotara Industrial Park Fourth Addition
 City of Wichita, Kansas
 R.W. Linn, City Engineer
 Sanitary Sewer
 Project No. 468-76-245-80667-000-000-001

