


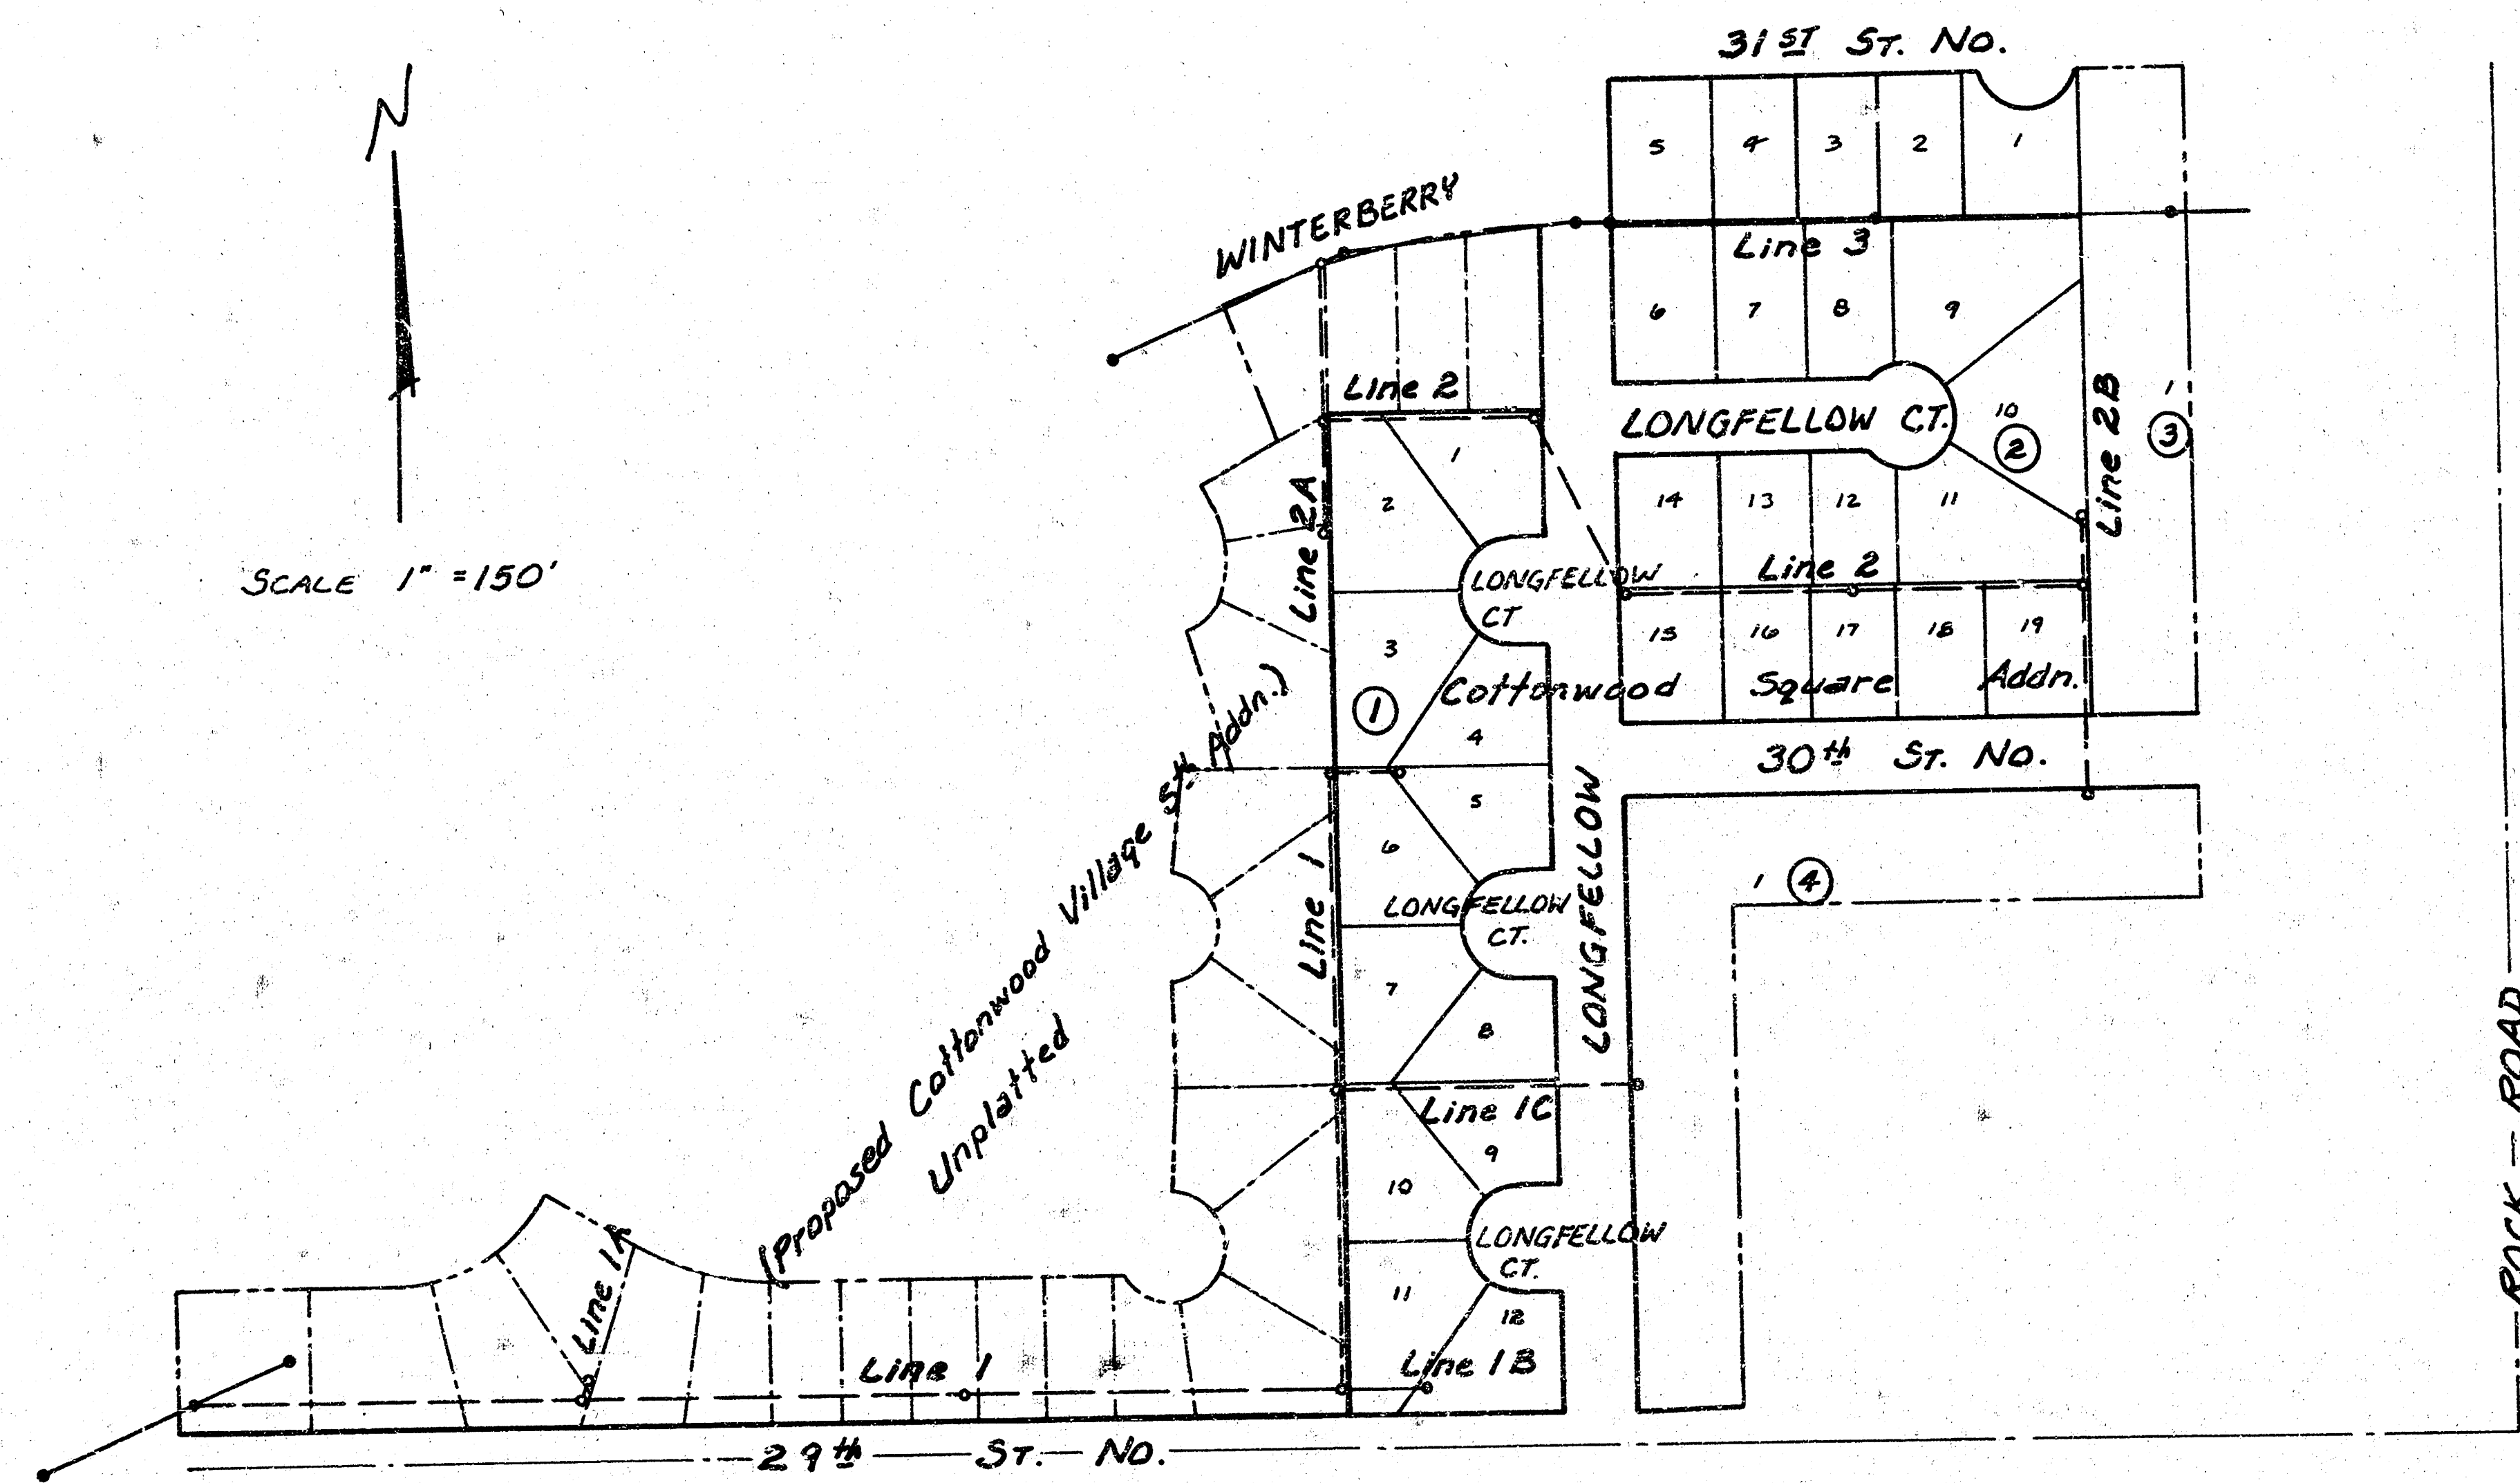

LAT 27, MAIN 7, SANITARY SEWER # 23


CITY OF WICHITA, KANSAS
R. W. BRUGGEMAN
DIRECTOR OF ENGINEERING / CITY ENGINEER

PROJ. NO. 468-76-245-81195-000-000-001

As Built
J.L.L.
4-83

INDEX

Line 1	Sheets	2-3
Line 1A	Sheet	2
Line 1B	Sheet	3
Line 1C	Sheet	3
Line 2	Sheets	4-5
Line 2A	Sheet	4
Line 2B	Sheet	5
Line 3	Sheet	5

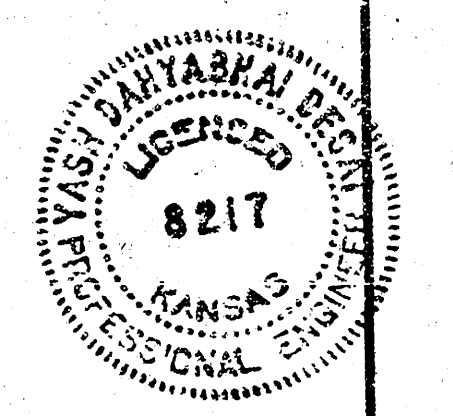

SCALE PLAN 1" = 40'
PROFILE 1" = 40' HORIZ.
1" = 5' VERT.

B.M. 213.302 City Std. Disc 44 ft. S. & 48 ft. W.
of E. both 29th St. No. & Rock Road
B.M. 213.76 "5" cut NW corner of 7'x10' concrete
box SW. corner 29th St. No. & Rock Road
B.M. 217.87 Step Bench W. face P.P. NE corner
29th St. No. & Rock Road
B.M. 214.56 R.R. Spike S. face P.P. NE corner
29th St. No. & Rock Road

COTTONWOOD
SQUARE
ADDITION

STA 0+20 CONST. STD.
MH. TYPE "A" OF "B"
INSTALL 4" STUB N.

STA 3+70 LINE 1
STA 0+00 LINE 1A
CONST. STD. MH.
TYPE "A" OF "B"

STA 7+40 CONST. STD.
MH. TYPE "A" OF "B"

STA 11+07.4 LINE 1
STA 0+00 LINE 1B
CONST. STD. MH.
TYPE "A" OF "B"

As Built
JL2
4-83


STA 0+00 CONST. STD. OUTSIDE
DROP TYPE "A" OF "B" MANHOLE
OVER EXIST. 15" SANITARY SEWER

STA 3+70 LINE 1
STA 0+00 LINE 1A
CONST. STD. MH.
TYPE "A" OF "B"


STA 7+40 CONST. STD.
MH. TYPE "A" OF "B"

STA 11+07.4 LINE 1
STA 0+00 LINE 1B
CONST. STD. MH.
TYPE "A" OF "B"

STA 0+00 LINE 1A
STA 3+70 LINE 1
STA 0+20 CONST. STD.
MH. TYPE "A" OF "B"
INSTALL 4" STUB N.

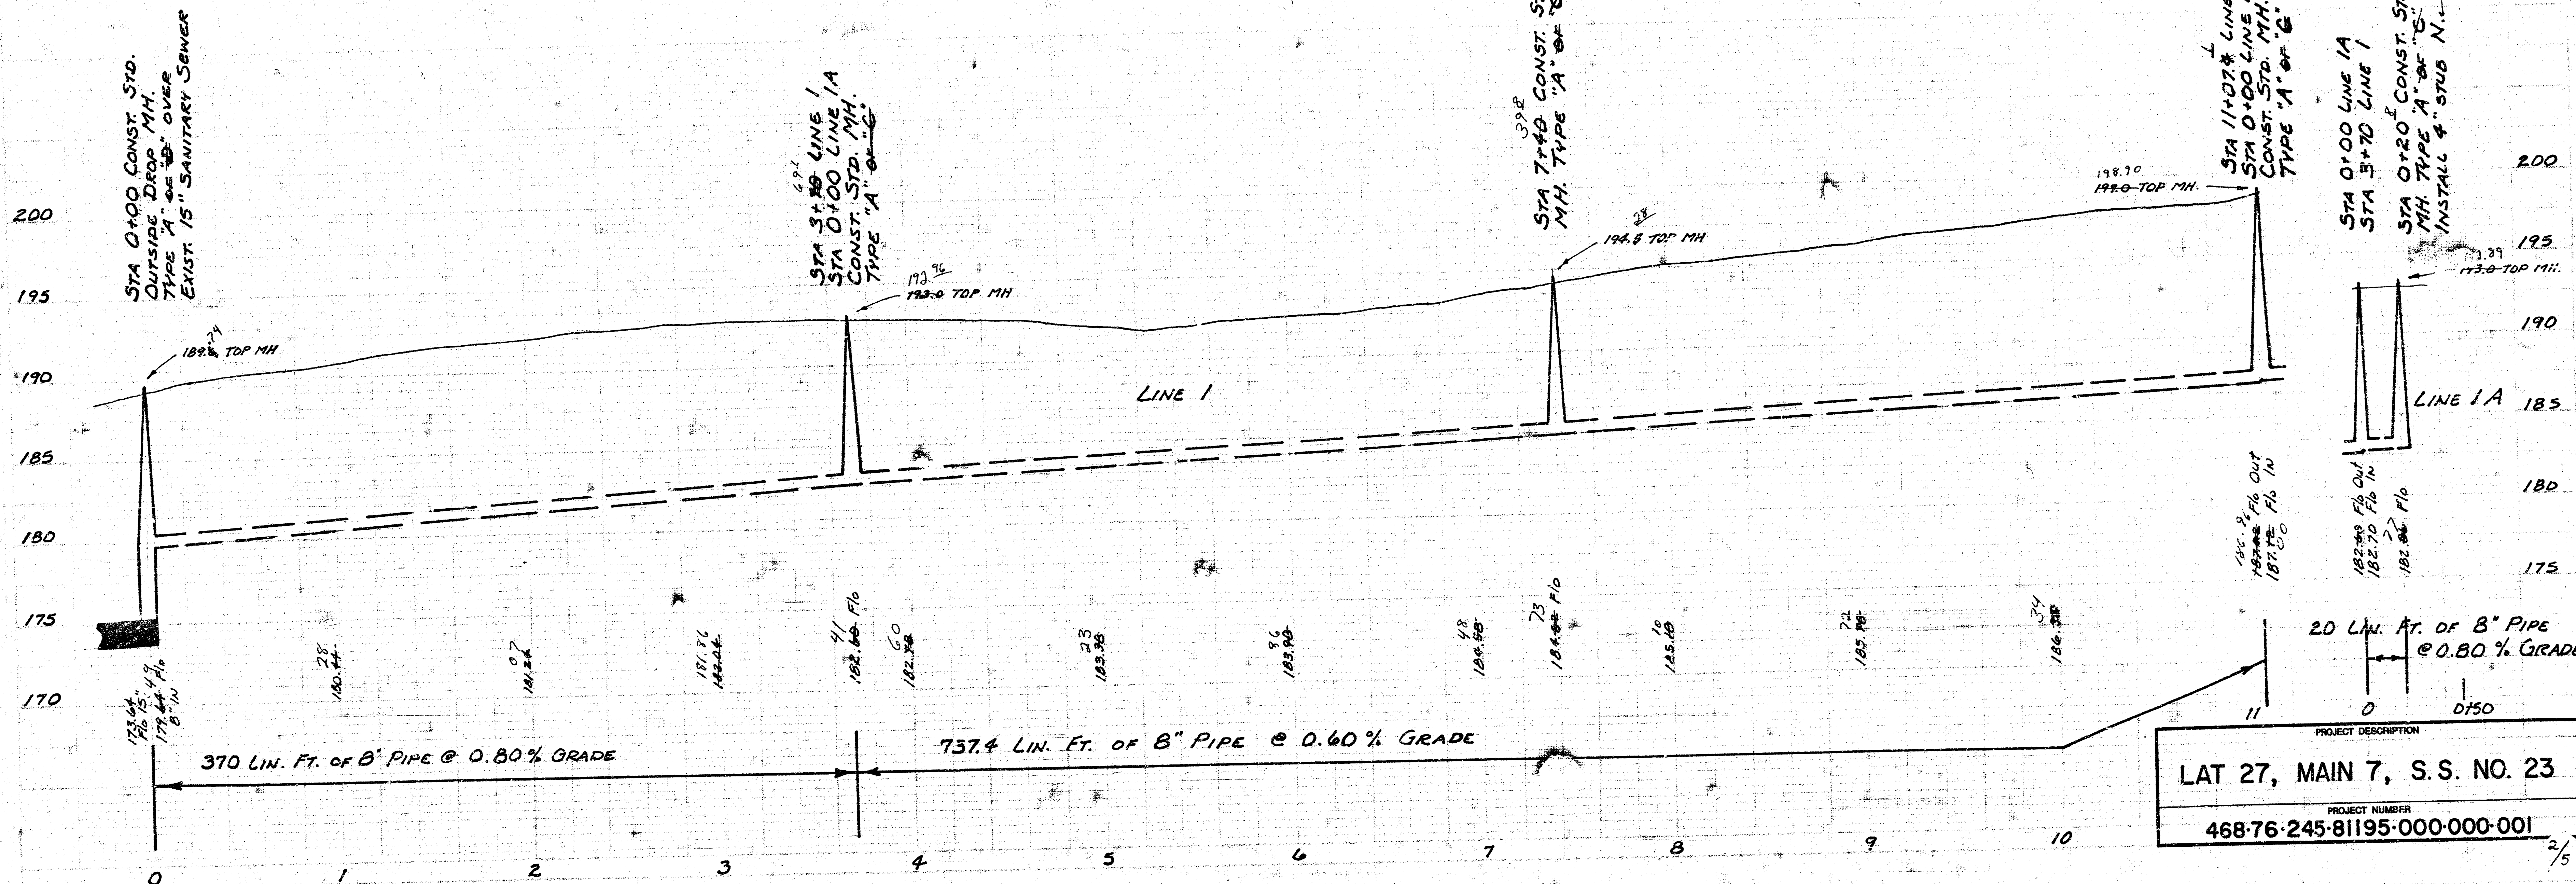

PROJECT DESCRIPTION
LAT 27, MAIN 7, S.S. NO. 23
PROJECT NUMBER
468-76-245-81195-000-000-001

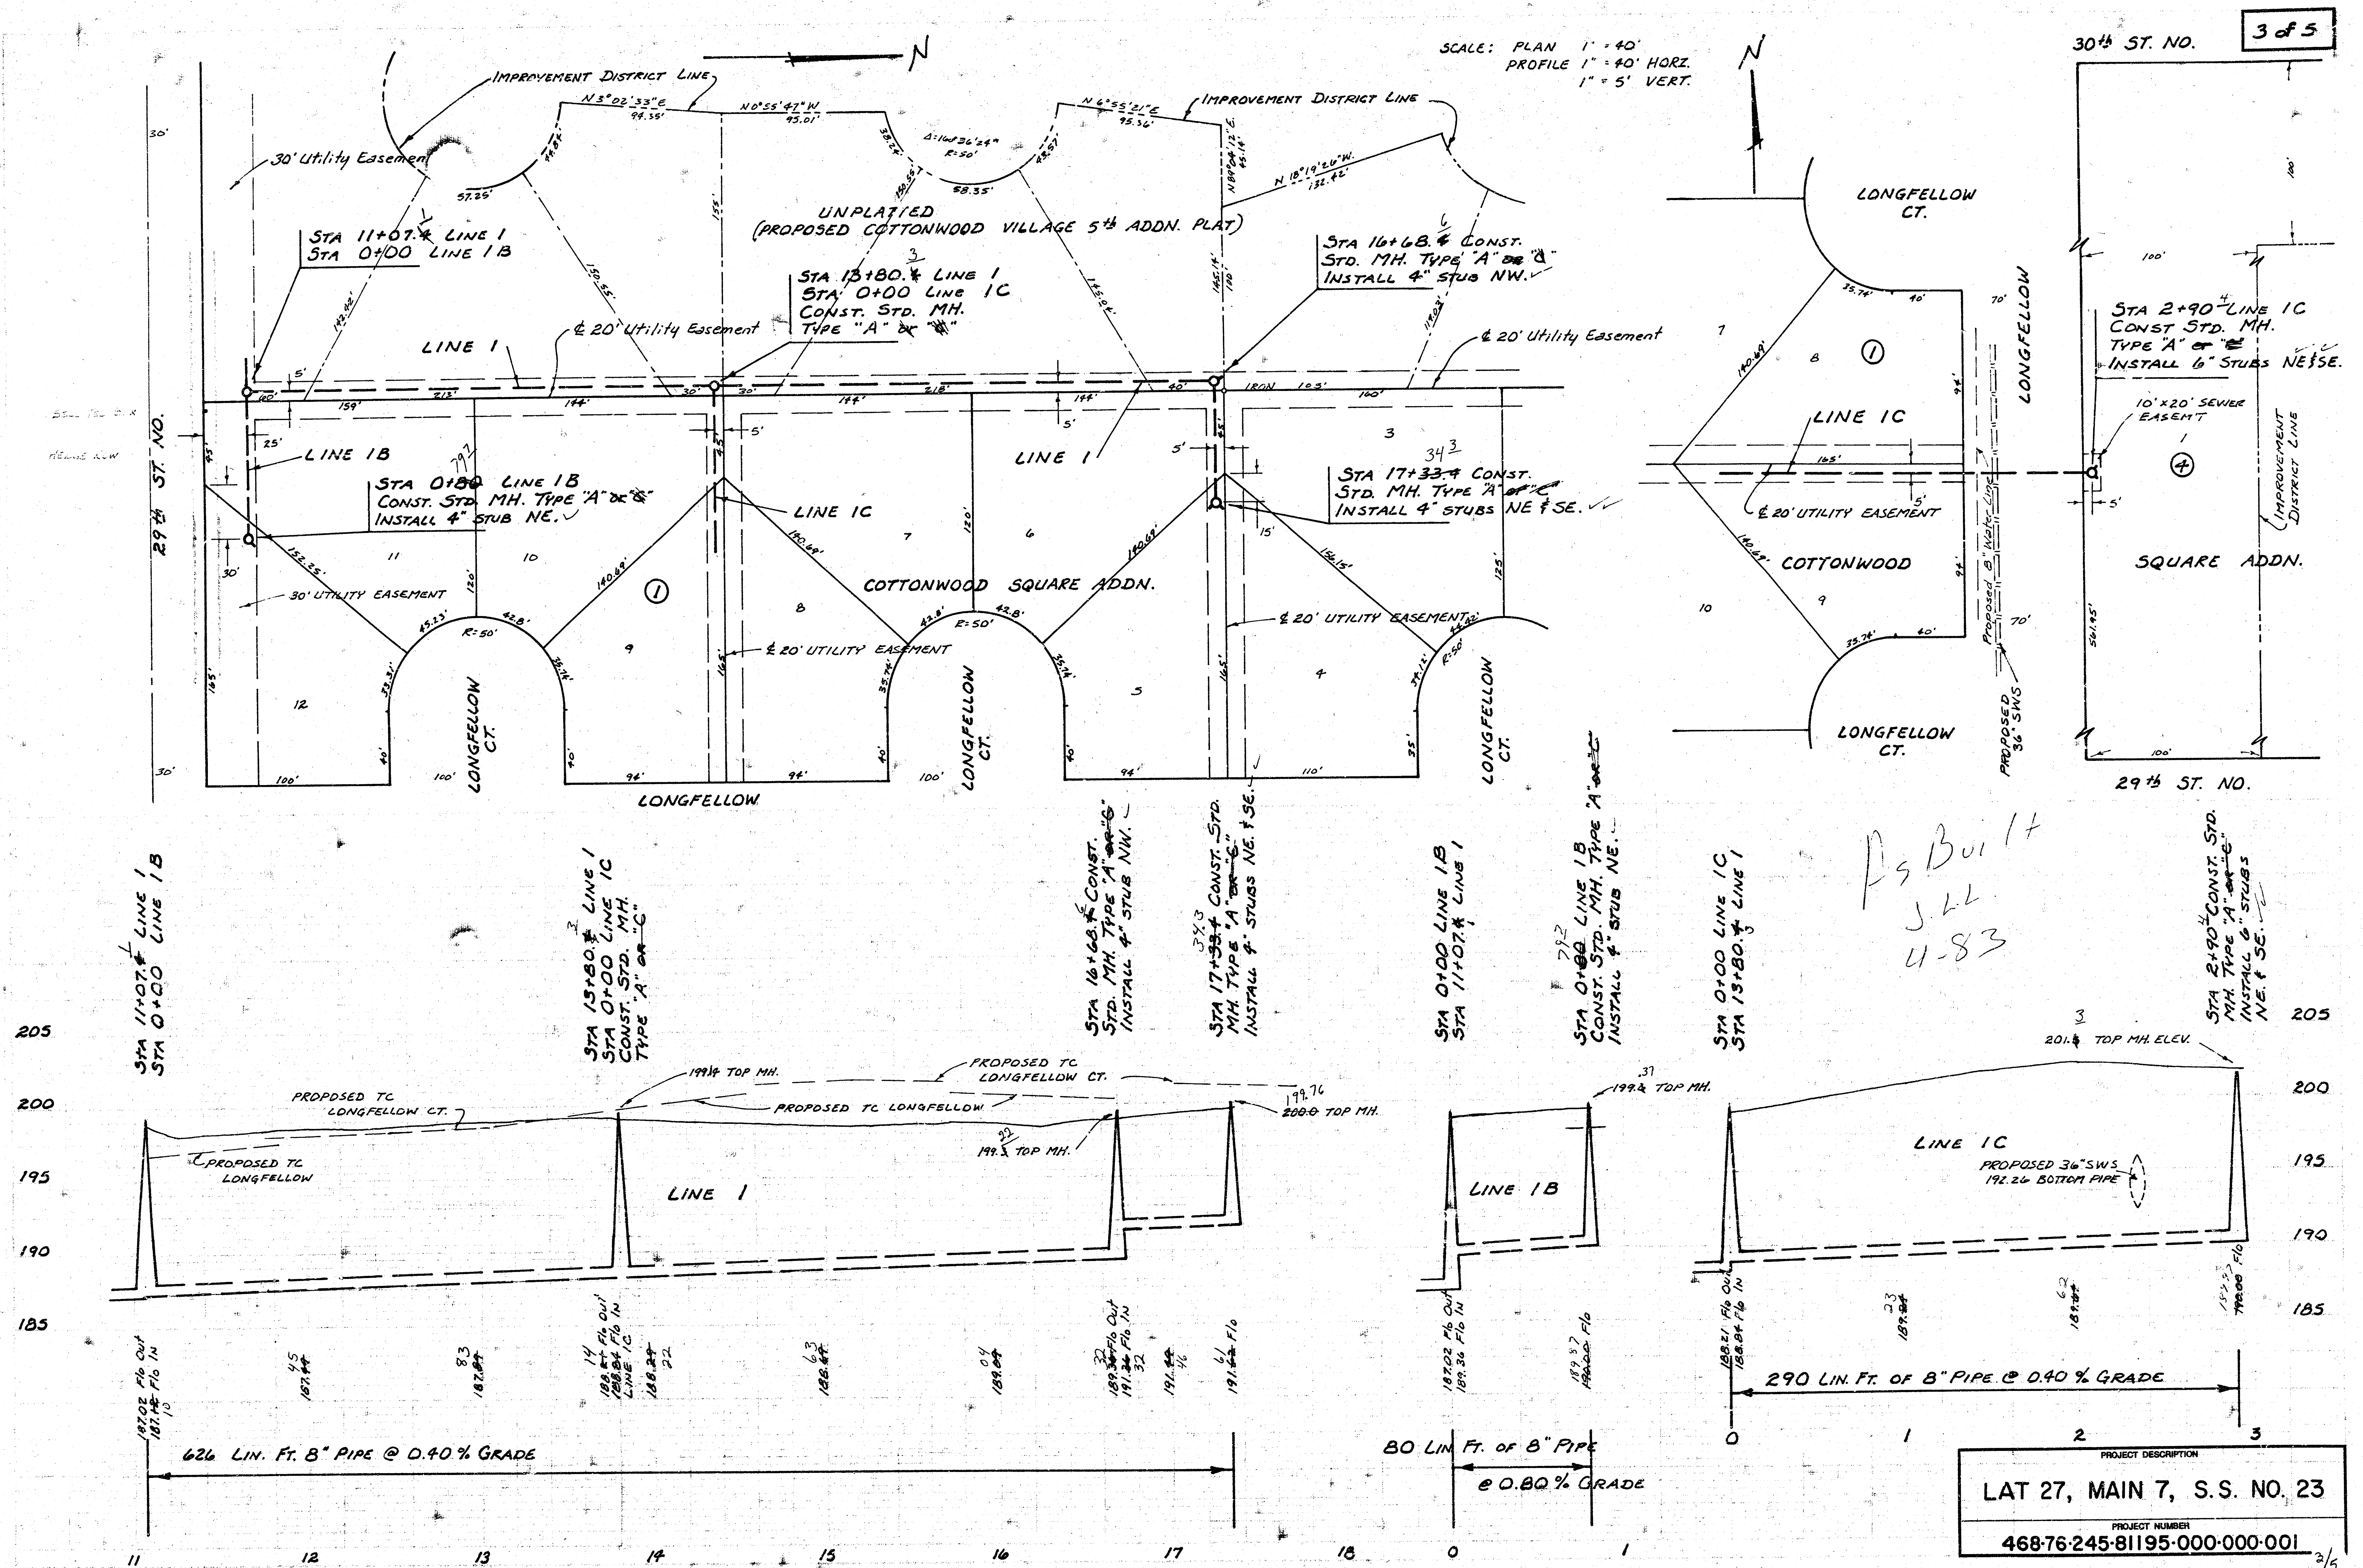

PROJECT DESCRIPTION

LAT 27, MAIN 7, S.S. NO. 23

PROJECT NUMBER

468-76-245-81195-000-000 4/5

