

SANITARY SEWER NO. 23 LATERAL 31, MAIN 7 ALLEN'S FARM PROJECT NO. 468-76-245-81337-000-000-001


CITY OF WICHITA, KANSAS
MIKE LINDEBAK, CITY ENGINEER
MARCH, 1984

GENERAL NOTES

1. RISER PIPE SHALL BE INSTALLED TO SERVE INDIVIDUAL LOTS OR TRACTS IN CONJUNCTION WITH NEW SANITARY SEWER CONSTRUCTION, UNLESS OTHERWISE ORDERED BY THE ENGINEER, BECAUSE OF GROUND WATER, UNSTABLE SOIL OR UNUSUALLY DEEP CONSTRUCTION. RISER LOCATIONS SHALL BE AS APPROVED BY THE PROPERTY OWNER WITH THE CONCURRENCE OF THE ENGINEER. INSTALLATION OF RISERS ON SEWERS BECAUSE OF UNUSUAL DEPTH WILL BE REQUIRED WHEN THE SEWER IS DEEPER THAN TWELVE FEET (12'). THE CONTRACTOR WILL BE REQUIRED TO FILE WRITTEN DOCUMENTATION WITH THE ENGINEER IN A FORM APPROVED BY THE ENGINEER INDICATING THE LOCATIONS WHERE RISERS ARE TO BE INSTALLED AS REQUESTED BY THE PROPERTY OWNER OR HIS AUTHORIZED REPRESENTATIVE. RISER PIPE CONSTRUCTION SHALL CONFORM TO THE REQUIREMENTS AS SHOWN ON THE STANDARD RISER DETAIL SHEET.
2. THE CONTRACTOR SHALL BE RESPONSIBLE FOR PRESERVING PROPERTY IRONS. THE CONTRACTOR SHALL BE REQUIRED TO RE-ESTABLISH ANY PROPERTY IRONS WHICH ARE DAMAGED OR DESTROYED BY HIS CONSTRUCTION OPERATIONS. SUCH IRONS SHALL BE RE-ESTABLISHED BY A LICENSED LAND SURVEYOR OR A LICENSED PROFESSIONAL ENGINEER IN ACCORDANCE WITH STATE LAWS.
3. A PORTION OF EXCESS EXCAVATED MATERIAL SHALL BE MOUNDED AROUND MANHOLES WHICH EXTEND MORE THAN ONE (1) FOOT ABOVE THE EXISTING GROUND. SUCH MOUNDS SHALL BE CONSTRUCTED WITH A SIX (6) FEET DIAMETER FLAT TOP WITH 4 TO 1 SIDE SLOPES DOWN TO THE ORIGINAL GROUND. THE ELEVATION OF THE FLAT TOP OF THE MOUND SHALL BE 0.4 FOOT BELOW THE TOP OF THE MANHOLE.
4. TREES TO BE REMOVED ARE MARKED $\otimes$. ALL TREES WHICH IN THE OPINION OF THE FIELD ENGINEER CAN BE SAVED SHALL BE SAVED.
5. CONTRACTOR SHALL NOTIFY THE UTILITY COMPANIES OF CONSTRUCTION SCHEDULING AND LOCATION OF ANY UNDERGROUND LINES.
6. EXISTING UTILITIES AND THEIR LOCATIONS, AS SHOWN ON THE PLANS, REPRESENT THE BEST INFORMATION OBTAINABLE FOR DESIGN. LOCATION INFORMATION HAS BEEN OBTAINED FROM THE VARIOUS UTILITY COMPANIES AND IS EITHER FROM COMPANY RECORD DRAWINGS OR COMPANY PROVIDED FIELD LOCATIONS. THE PLAN LOCATIONS SHOWN ARE NOT GUARANTEED. ADDITIONAL EXISTING UTILITIES MAY ALSO BE ENCOUNTERED.

BENCH MARKS

- B.M. #1 "X" cut on N. Hdwl. RCB N.W. Cor.
49' W. & 17' N. of C.L. of 29th St.
No. 5 Woodlawn
Elev. = 175.85
- B.M. #2 Top of 3/4" Bar & Rad. Pt. on
the Turn-a-Round.
455' E. & 375' N. of C.L. of
29th St. No. & Woodlawn
Elev. = 174.10

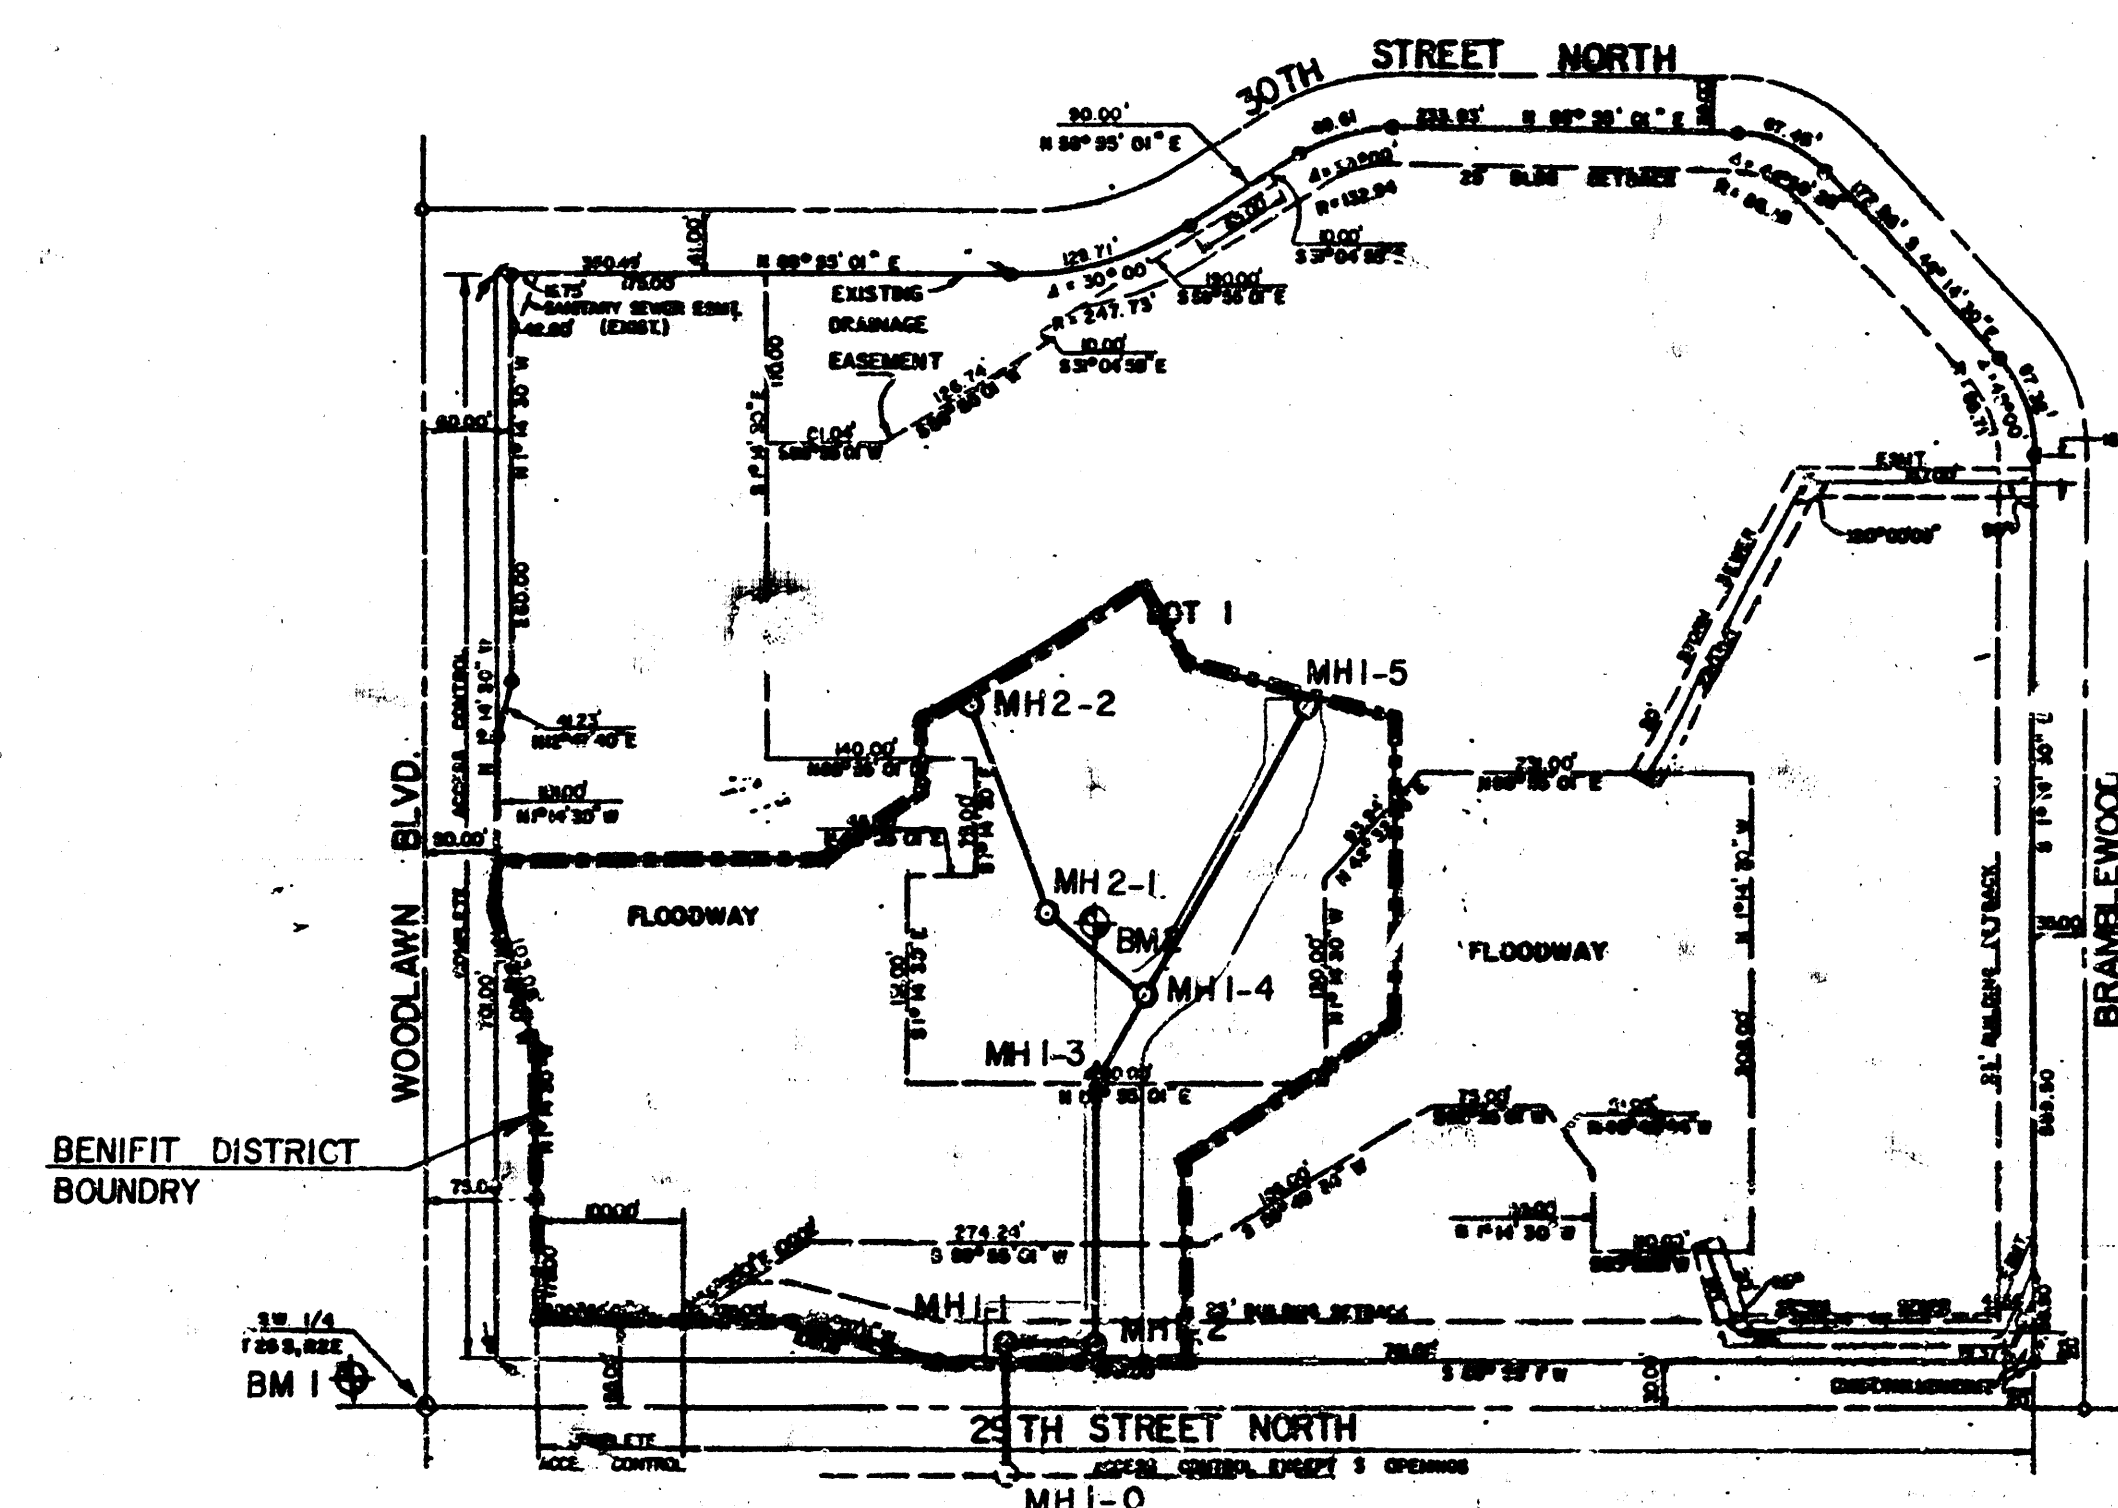

INDEX TO DRAWINGS

SHEET NO.	DESCRIPTION
1	TITLE SHEET
2	LINE 1 & 2
3-4	MANHOLE DETAILS
5	FINAL PLAT





REVISED 4-11-84


	SANITARY SEWER EXTENSION ALLEN'S FARM		Design
			Drawn by
			Checked by
			Date
MID-KANSAS ENGINEERING CONSULTANTS PA 240 NORTH ROCK ROAD SUITE 130 WICHITA, KANSAS 67206 682-6561		Sheet 1 of 5	

FILMED FROM THE BEST

ALLEN'S FARM
LAT. 31, MAIN 7, S-S #23
PROJ. NO. 468-76-245-8337-000-000-001

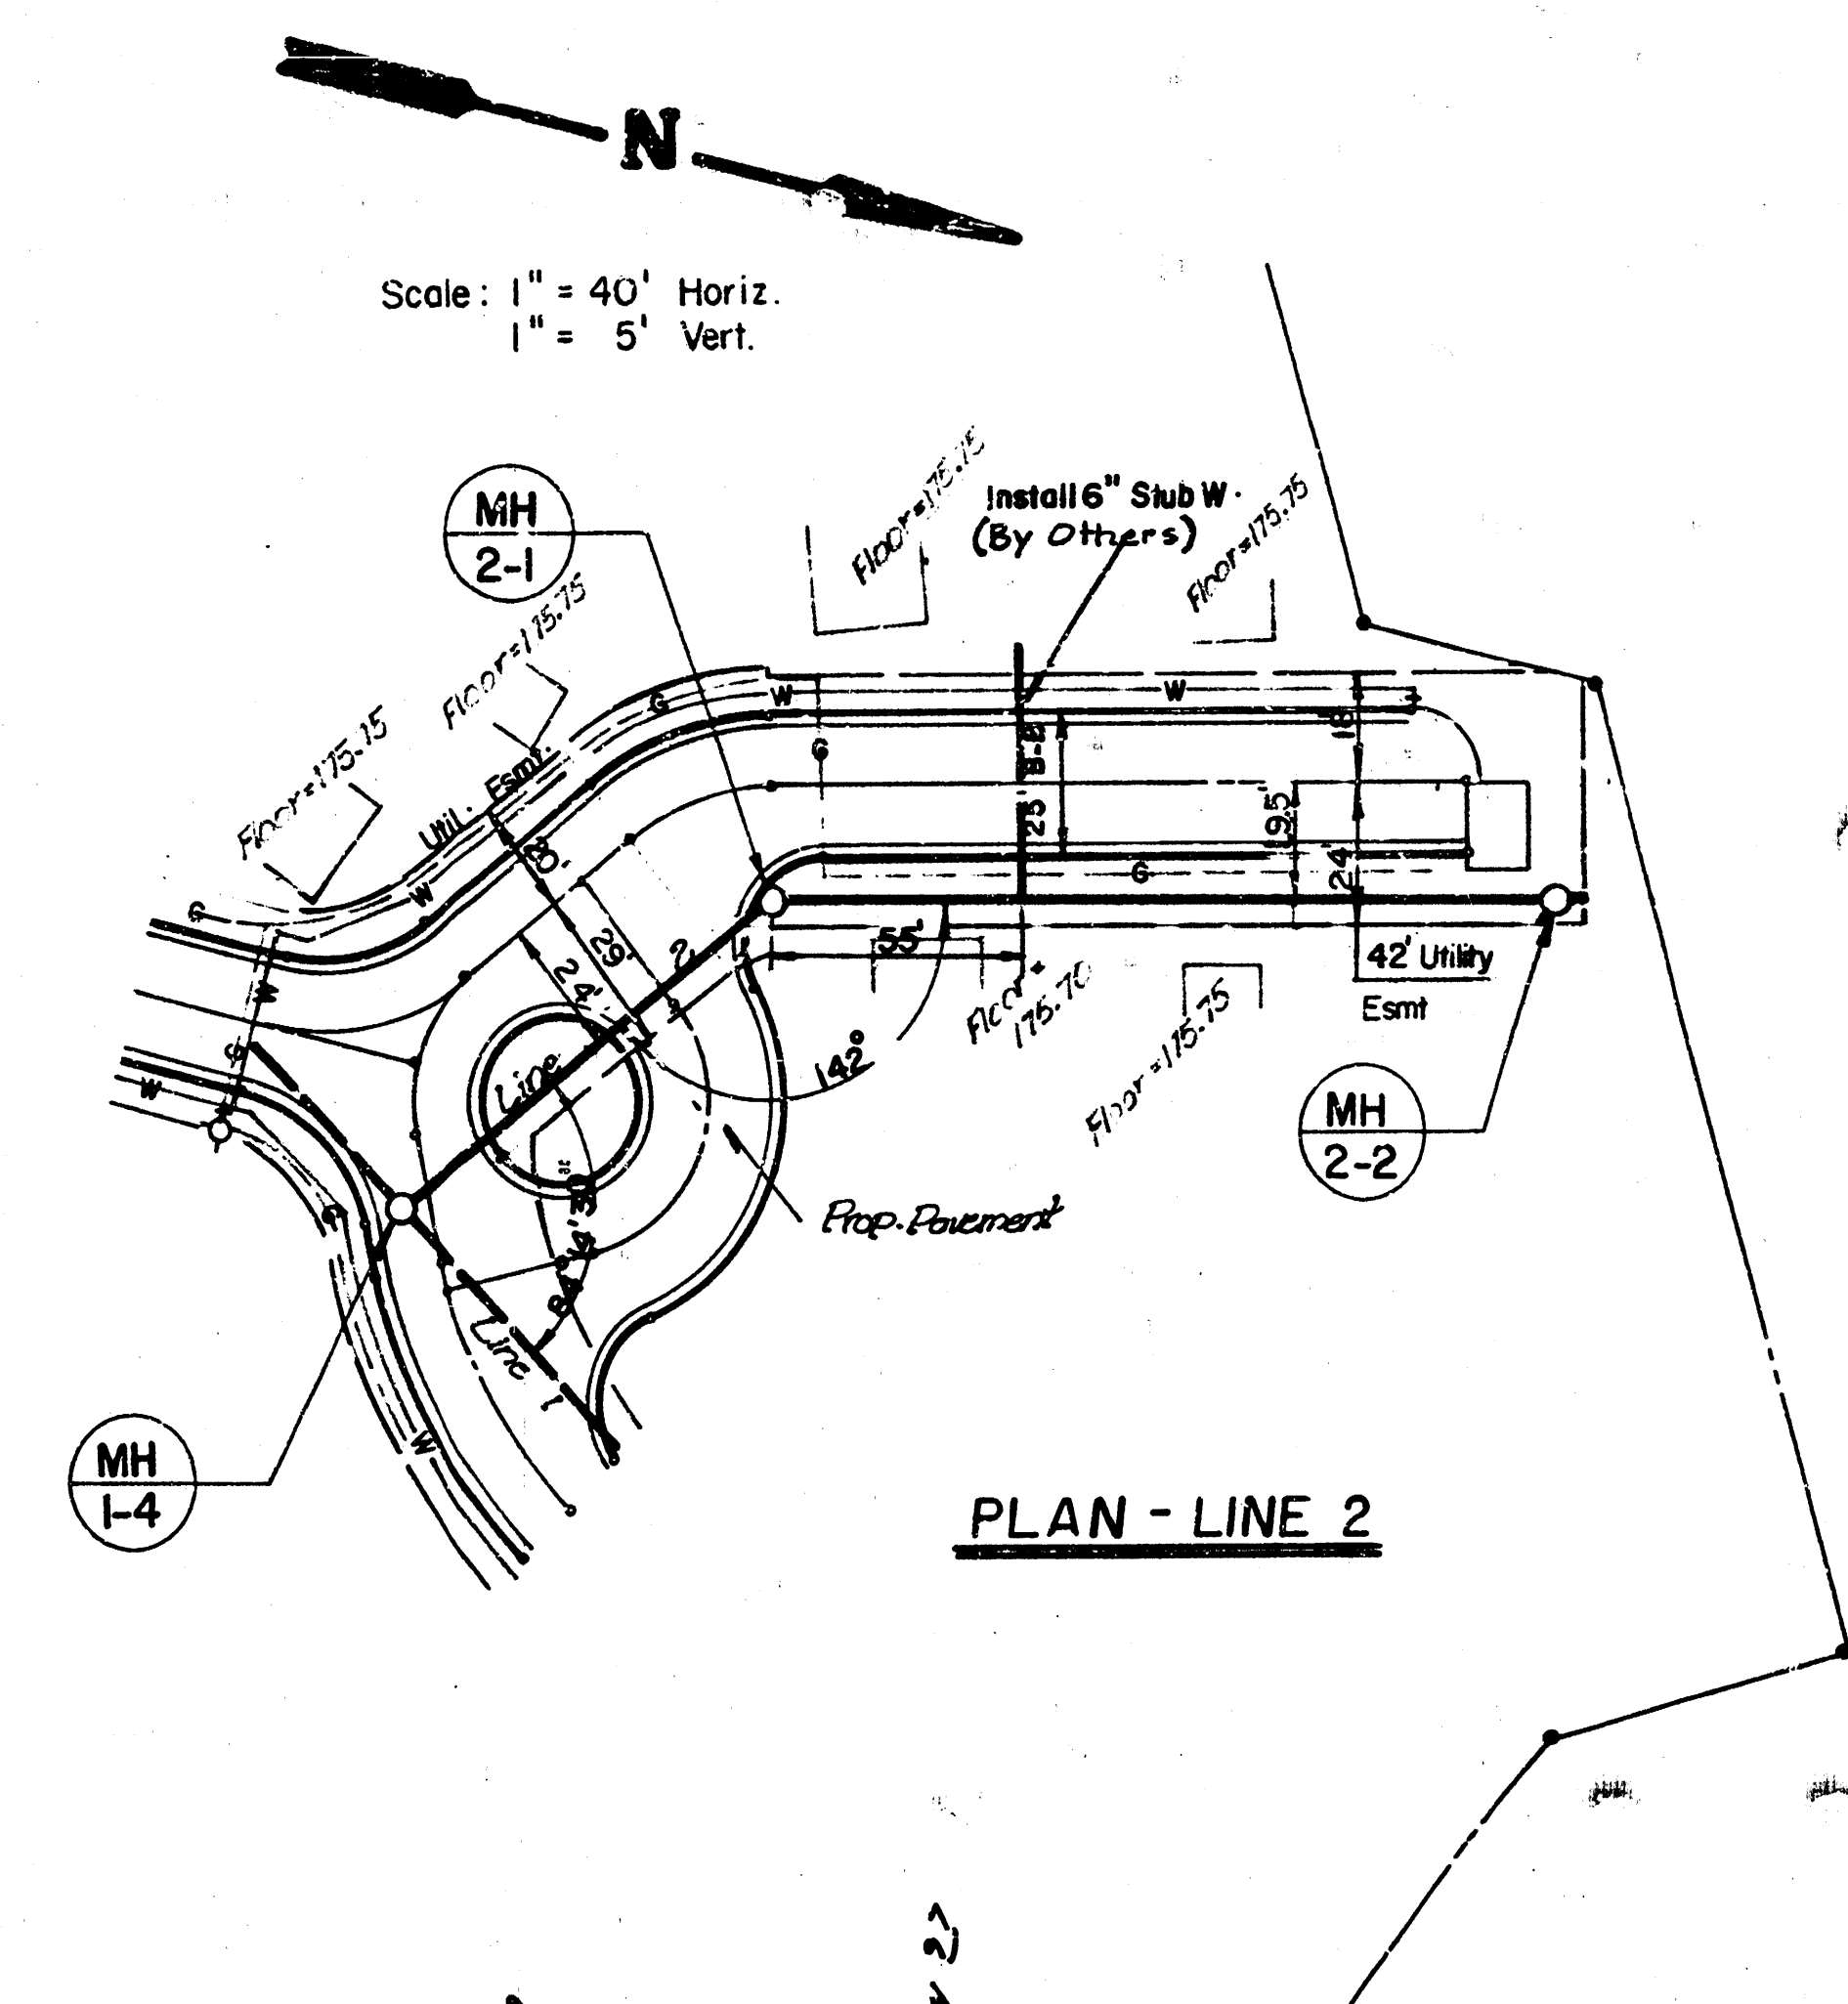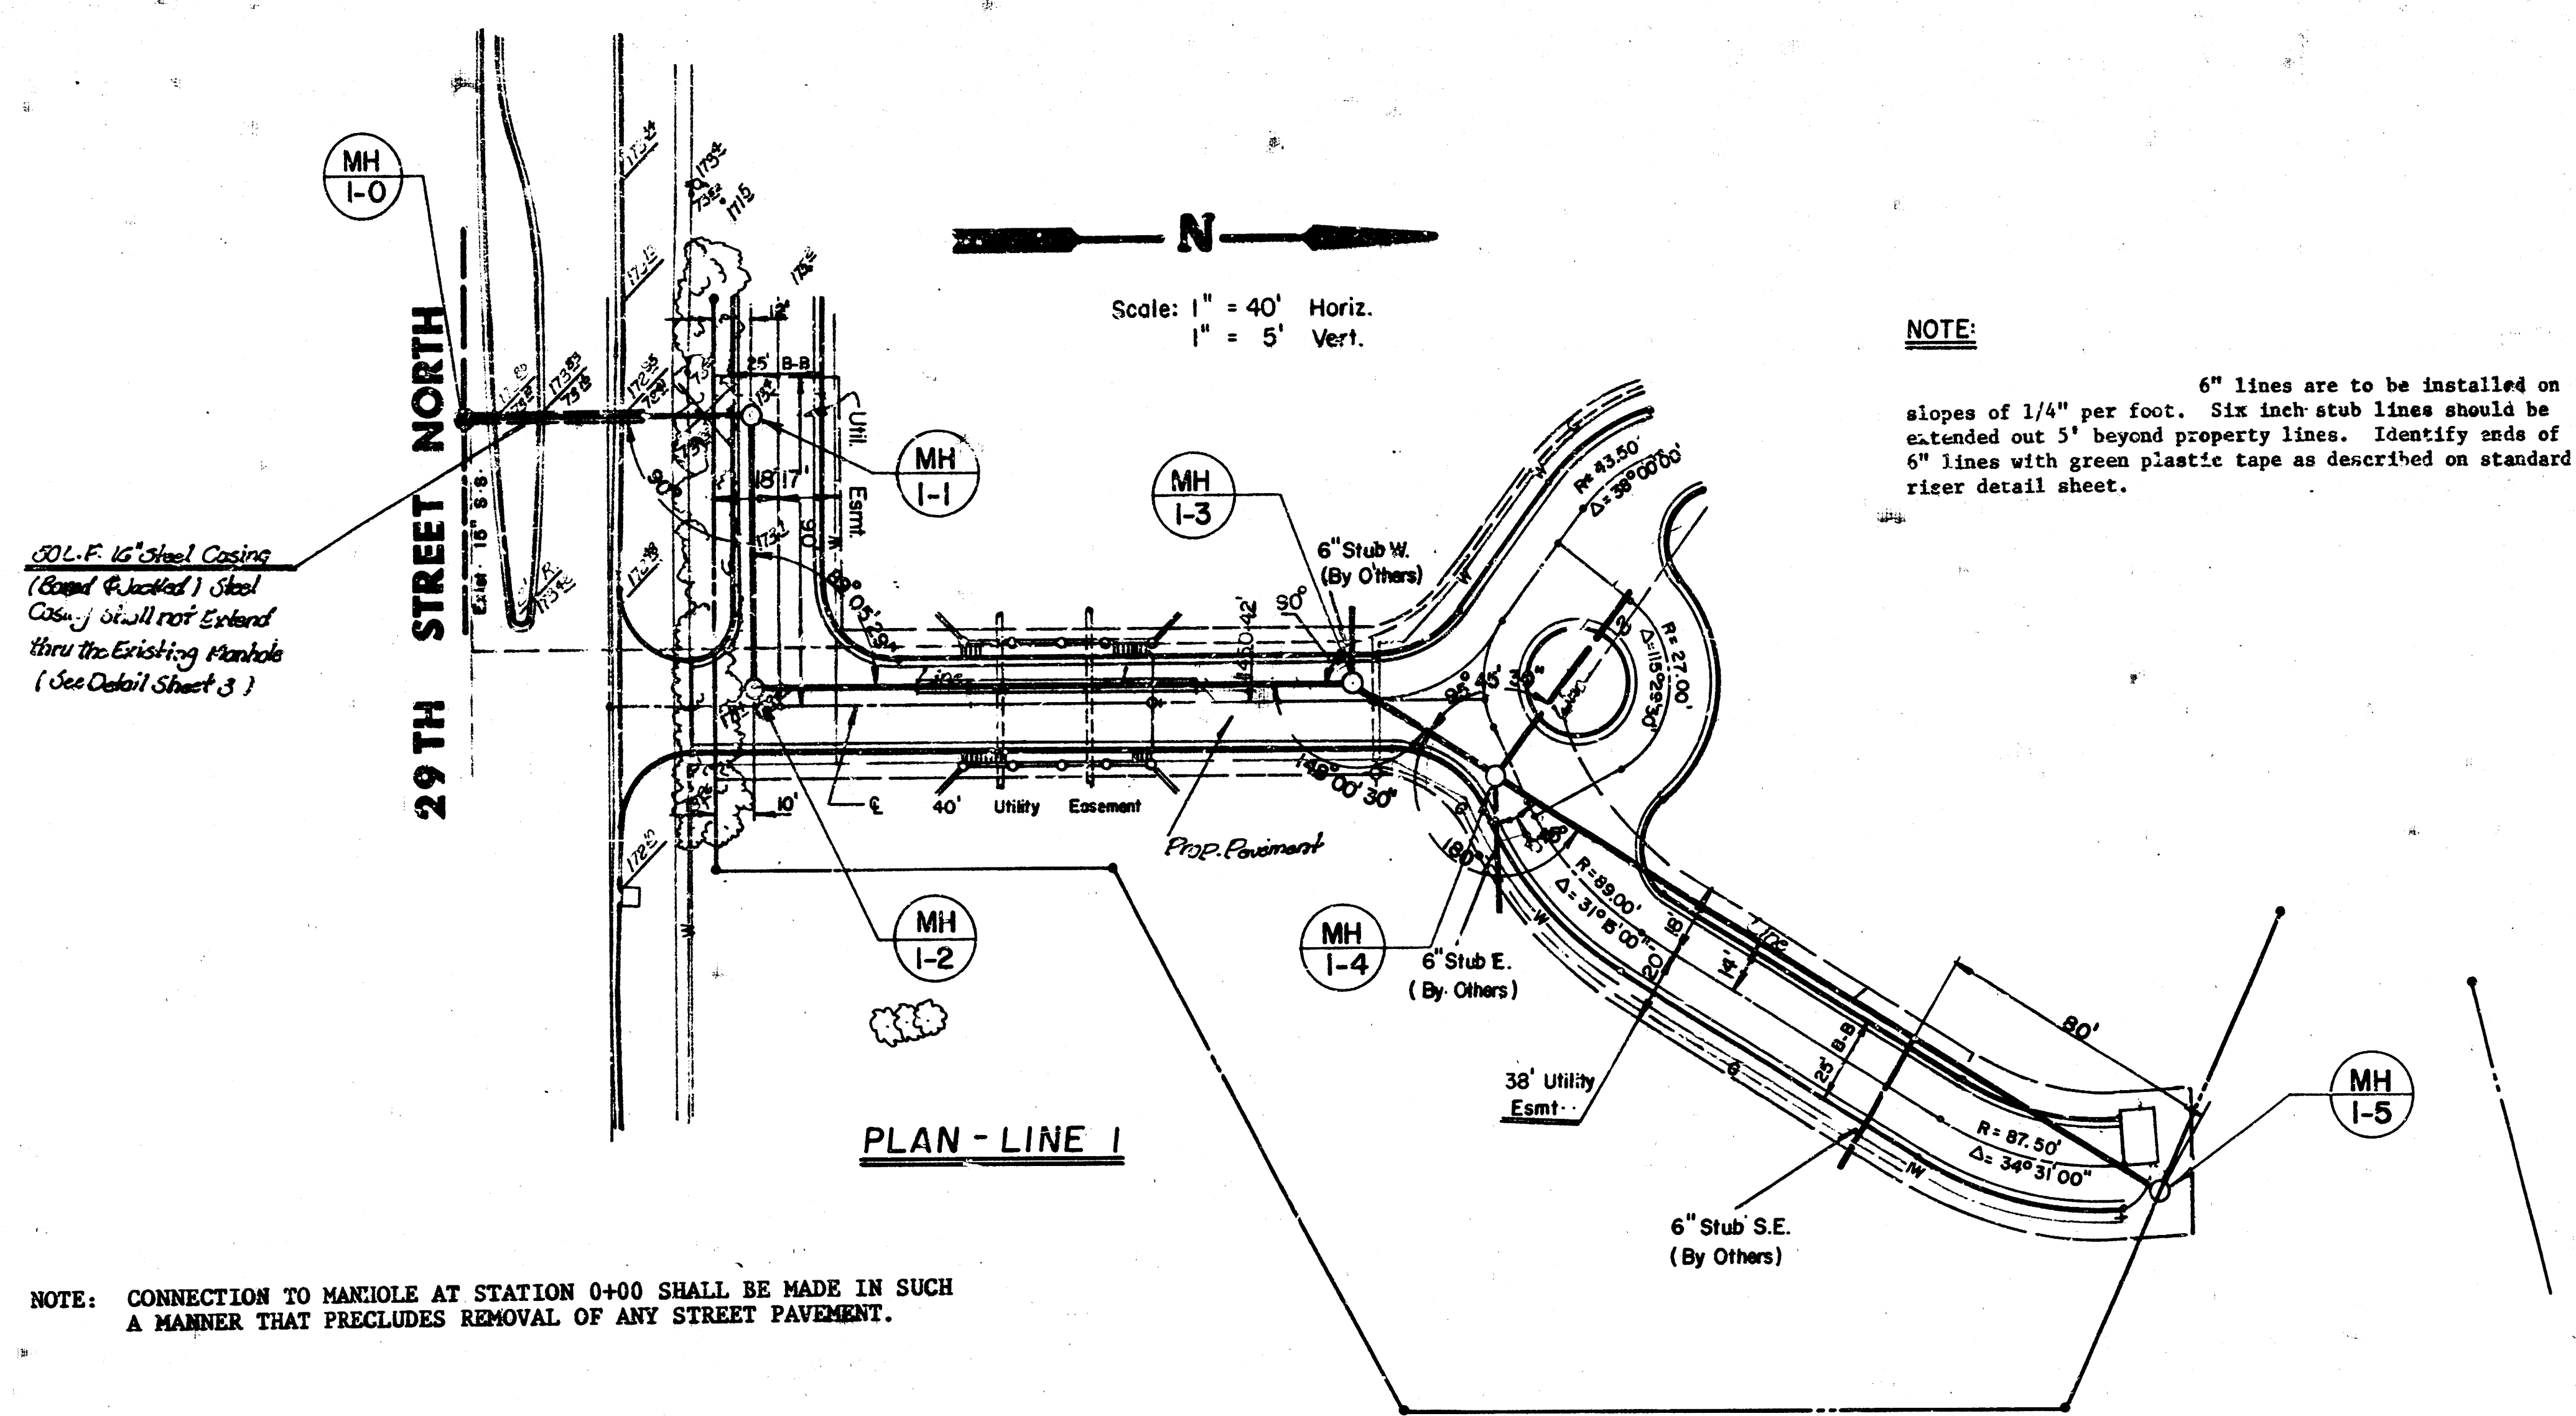

As Built
7-8-81
JSS

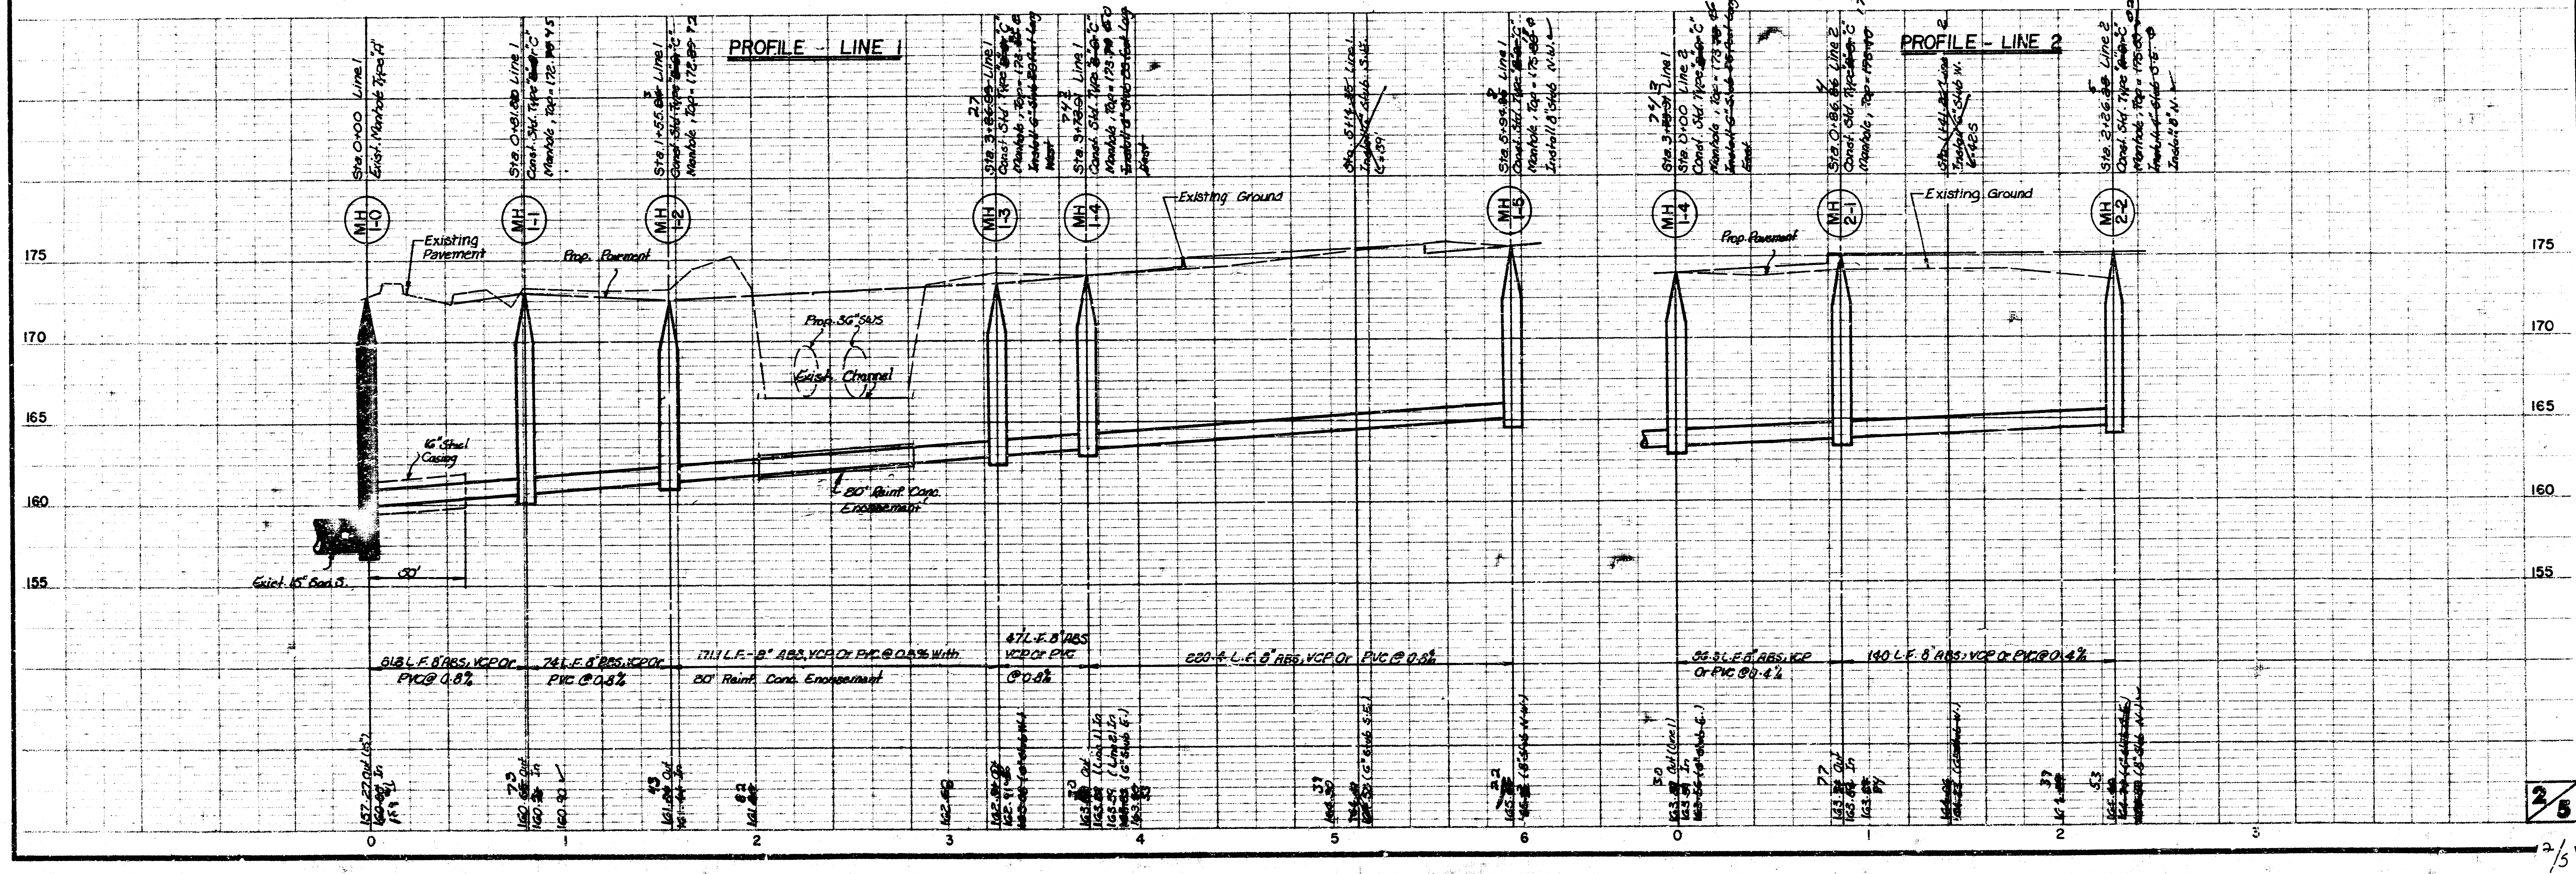


SEWER APPURTENANCES DETAILS

ADOPTED AS STANDARD DESIGN
BY


CITY OF WICHITA, KANSAS

REVISED SEPTEMBER 1980
REVISED DECEMBER 1981


TYPE "A" MANHOLE

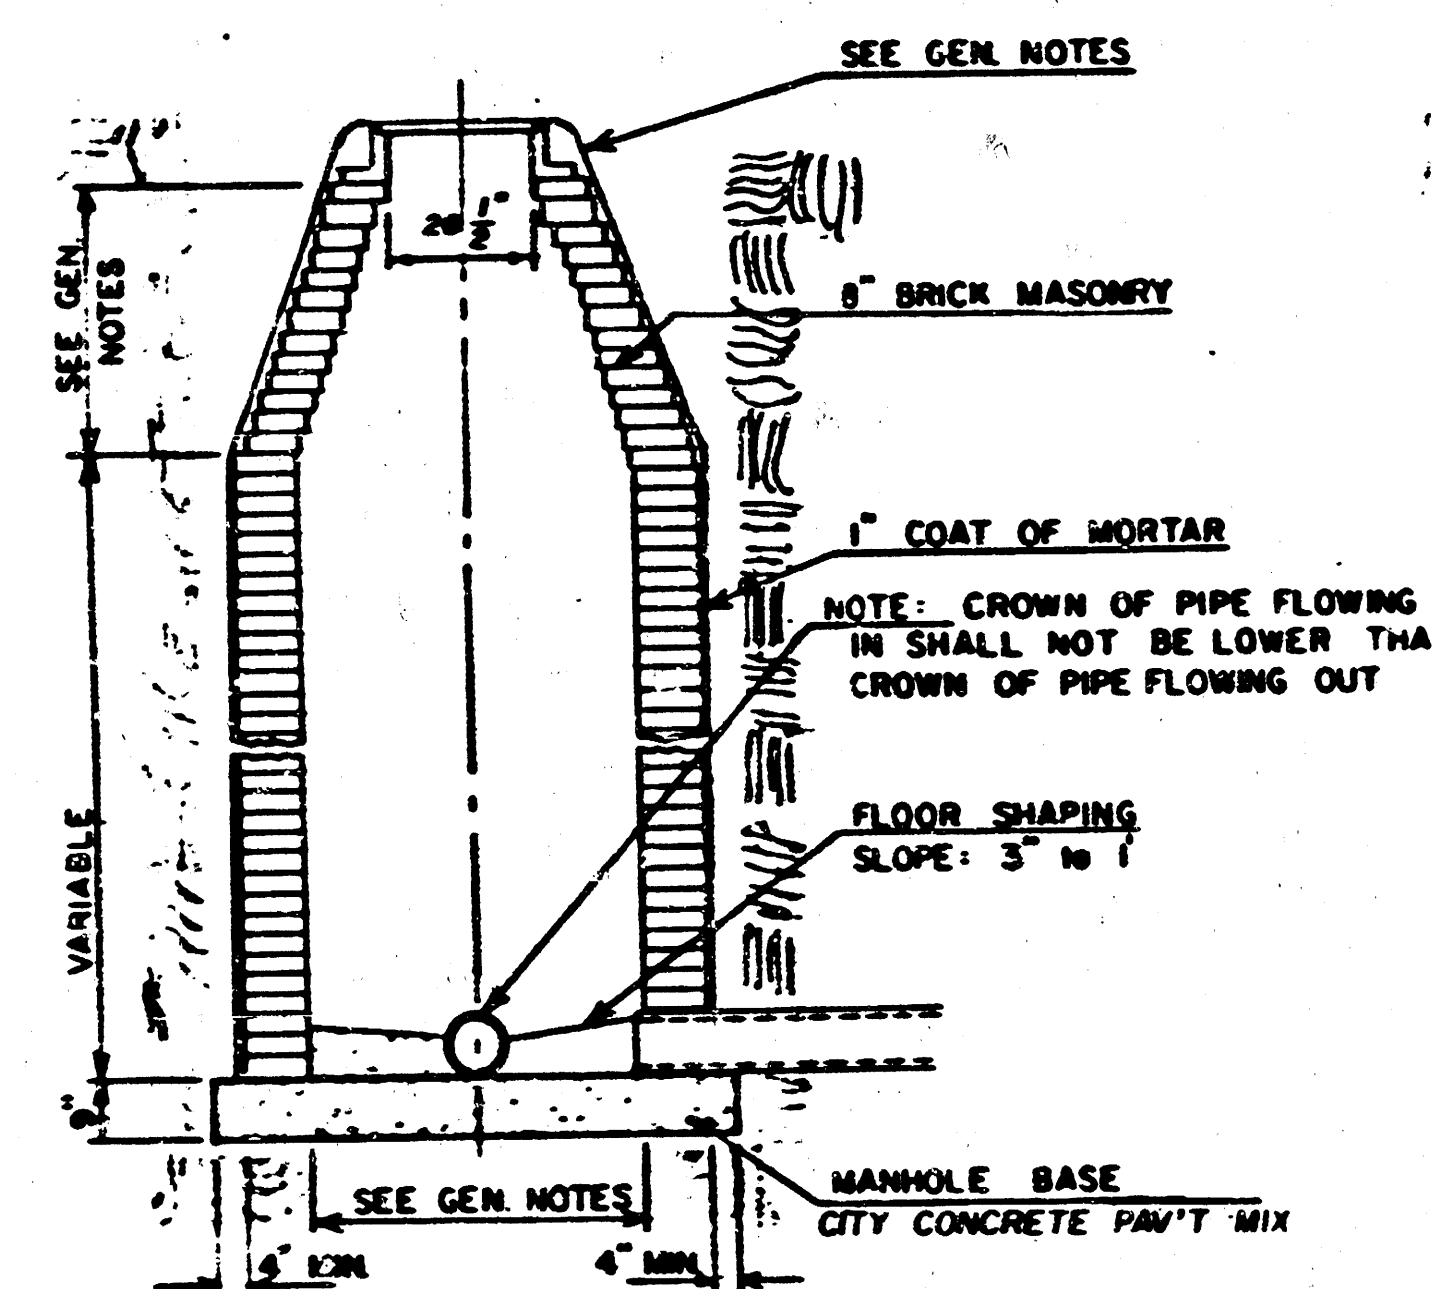



TYPE "A" INSIDE DROP MANHOLE

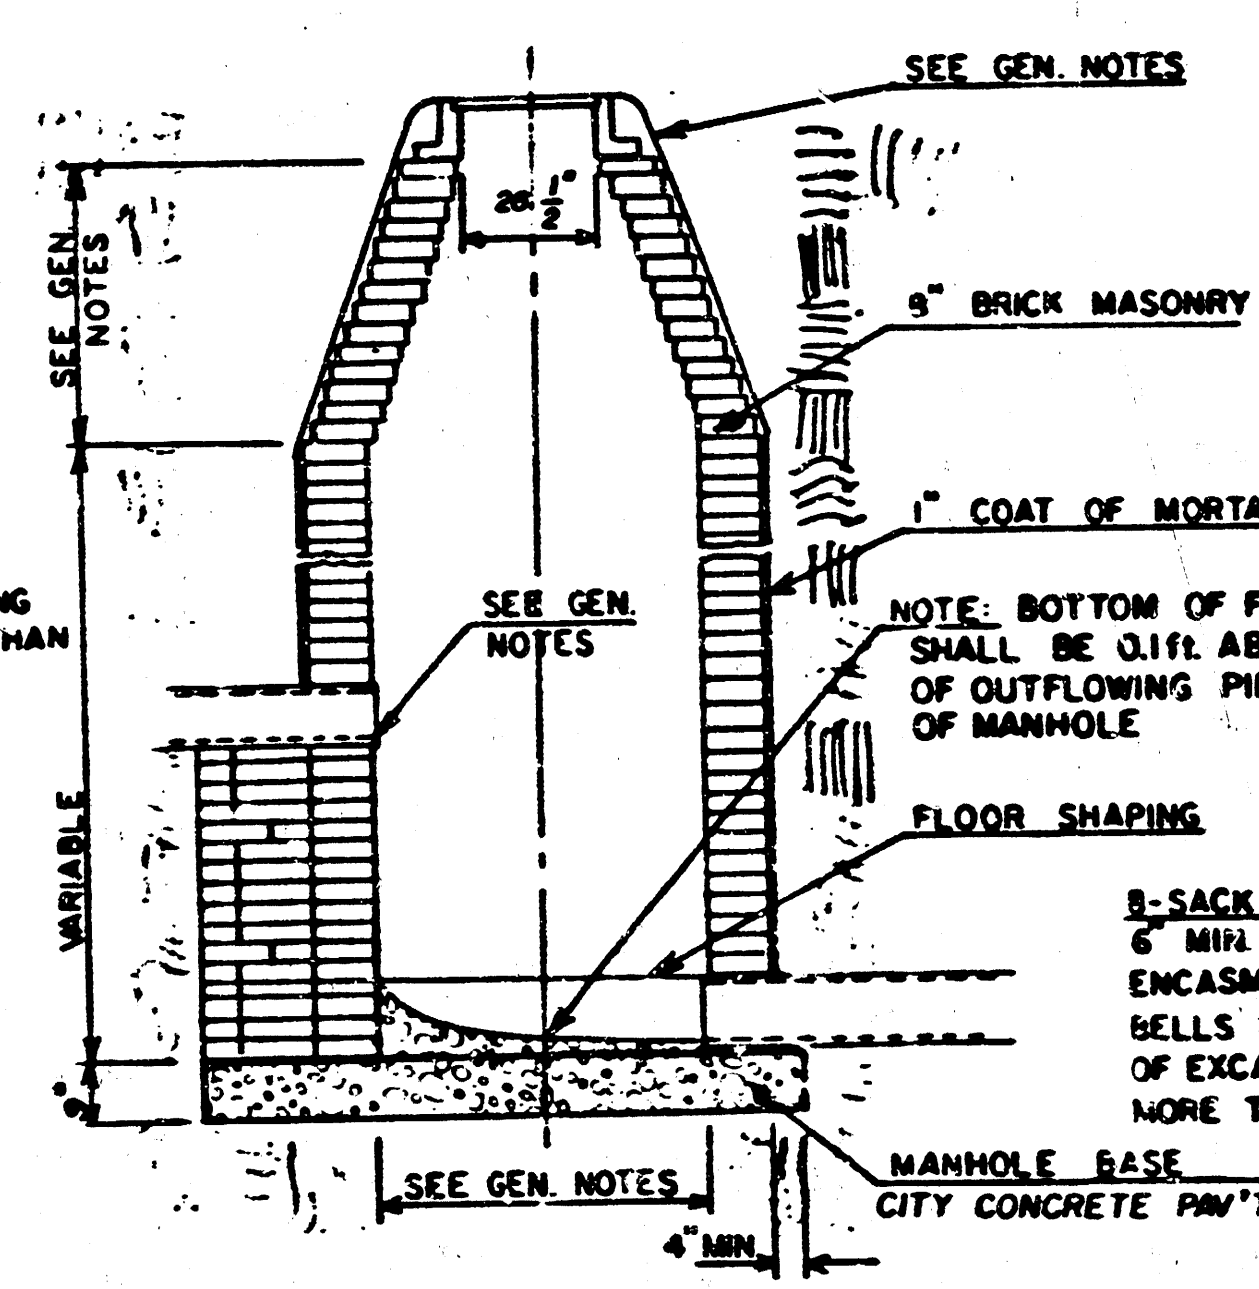

TYPE "A" OUTSIDE DROP MANHOLE

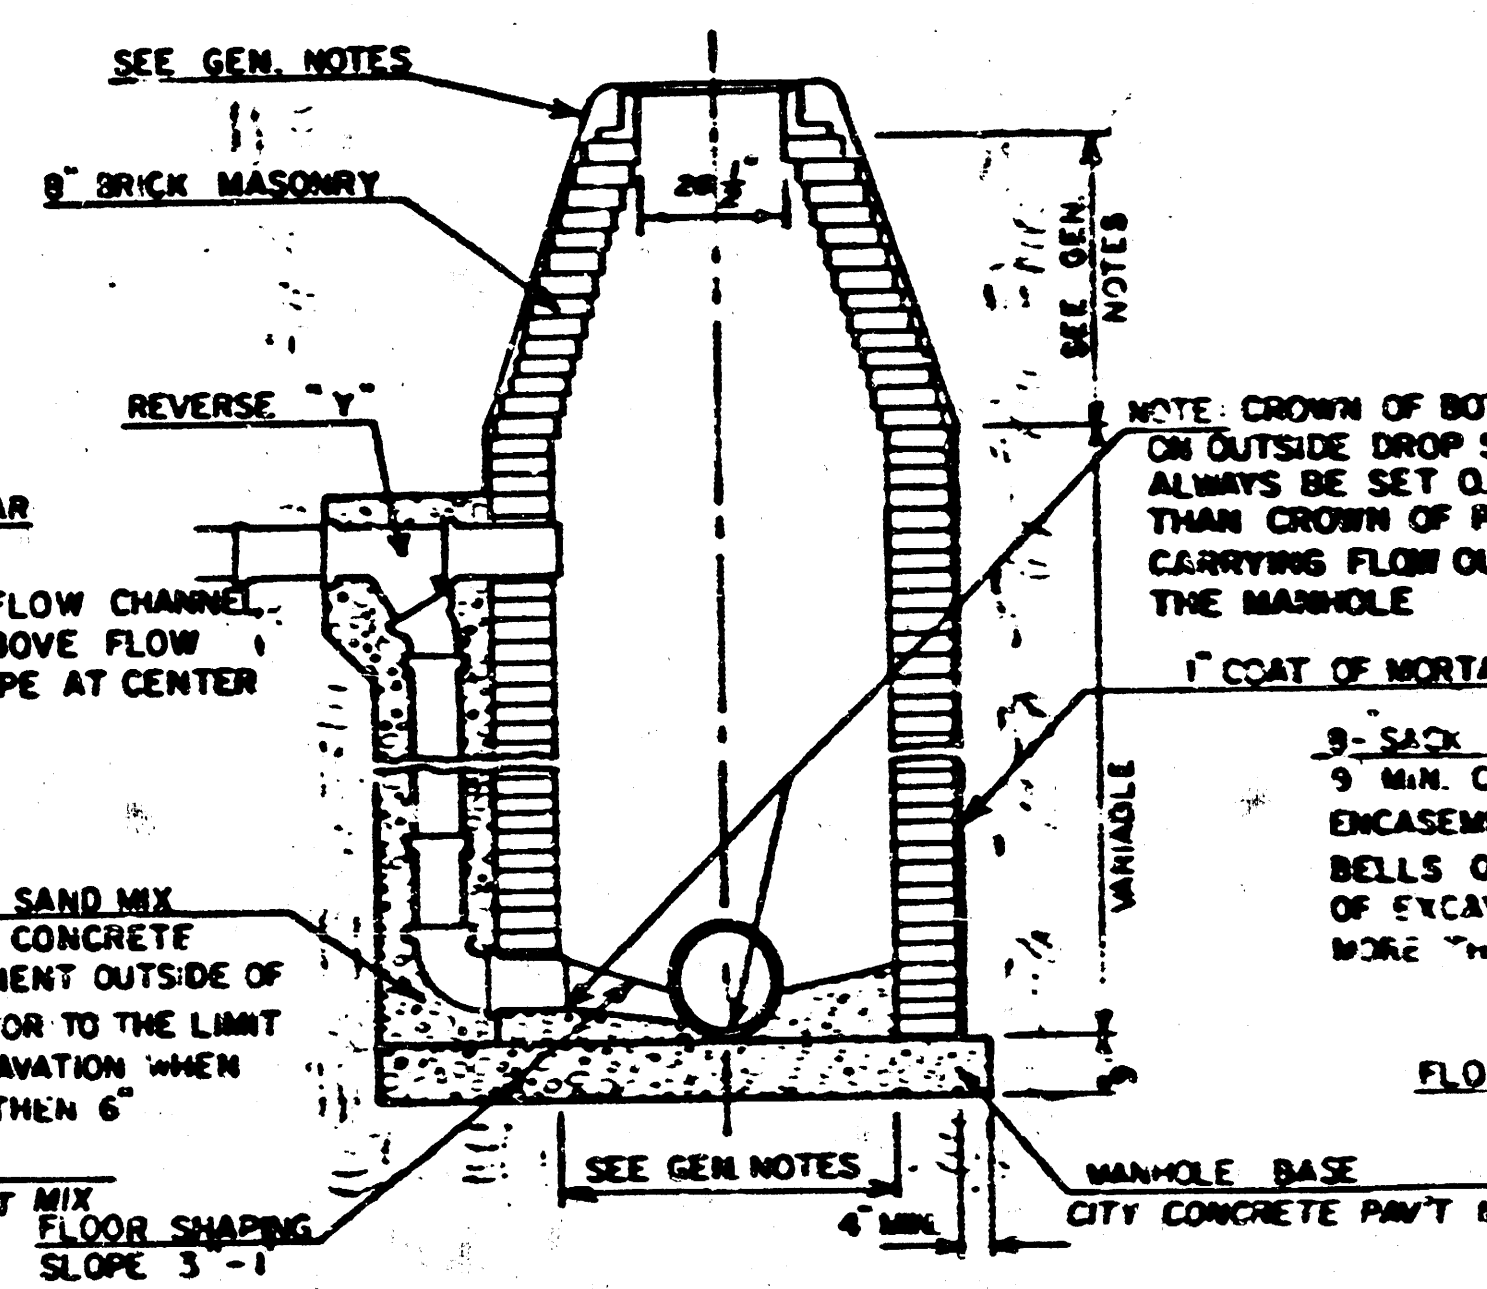

DETAIL OF OUTSIDE DROP
CONSTRUCTED ON EXISTING MANHOLE

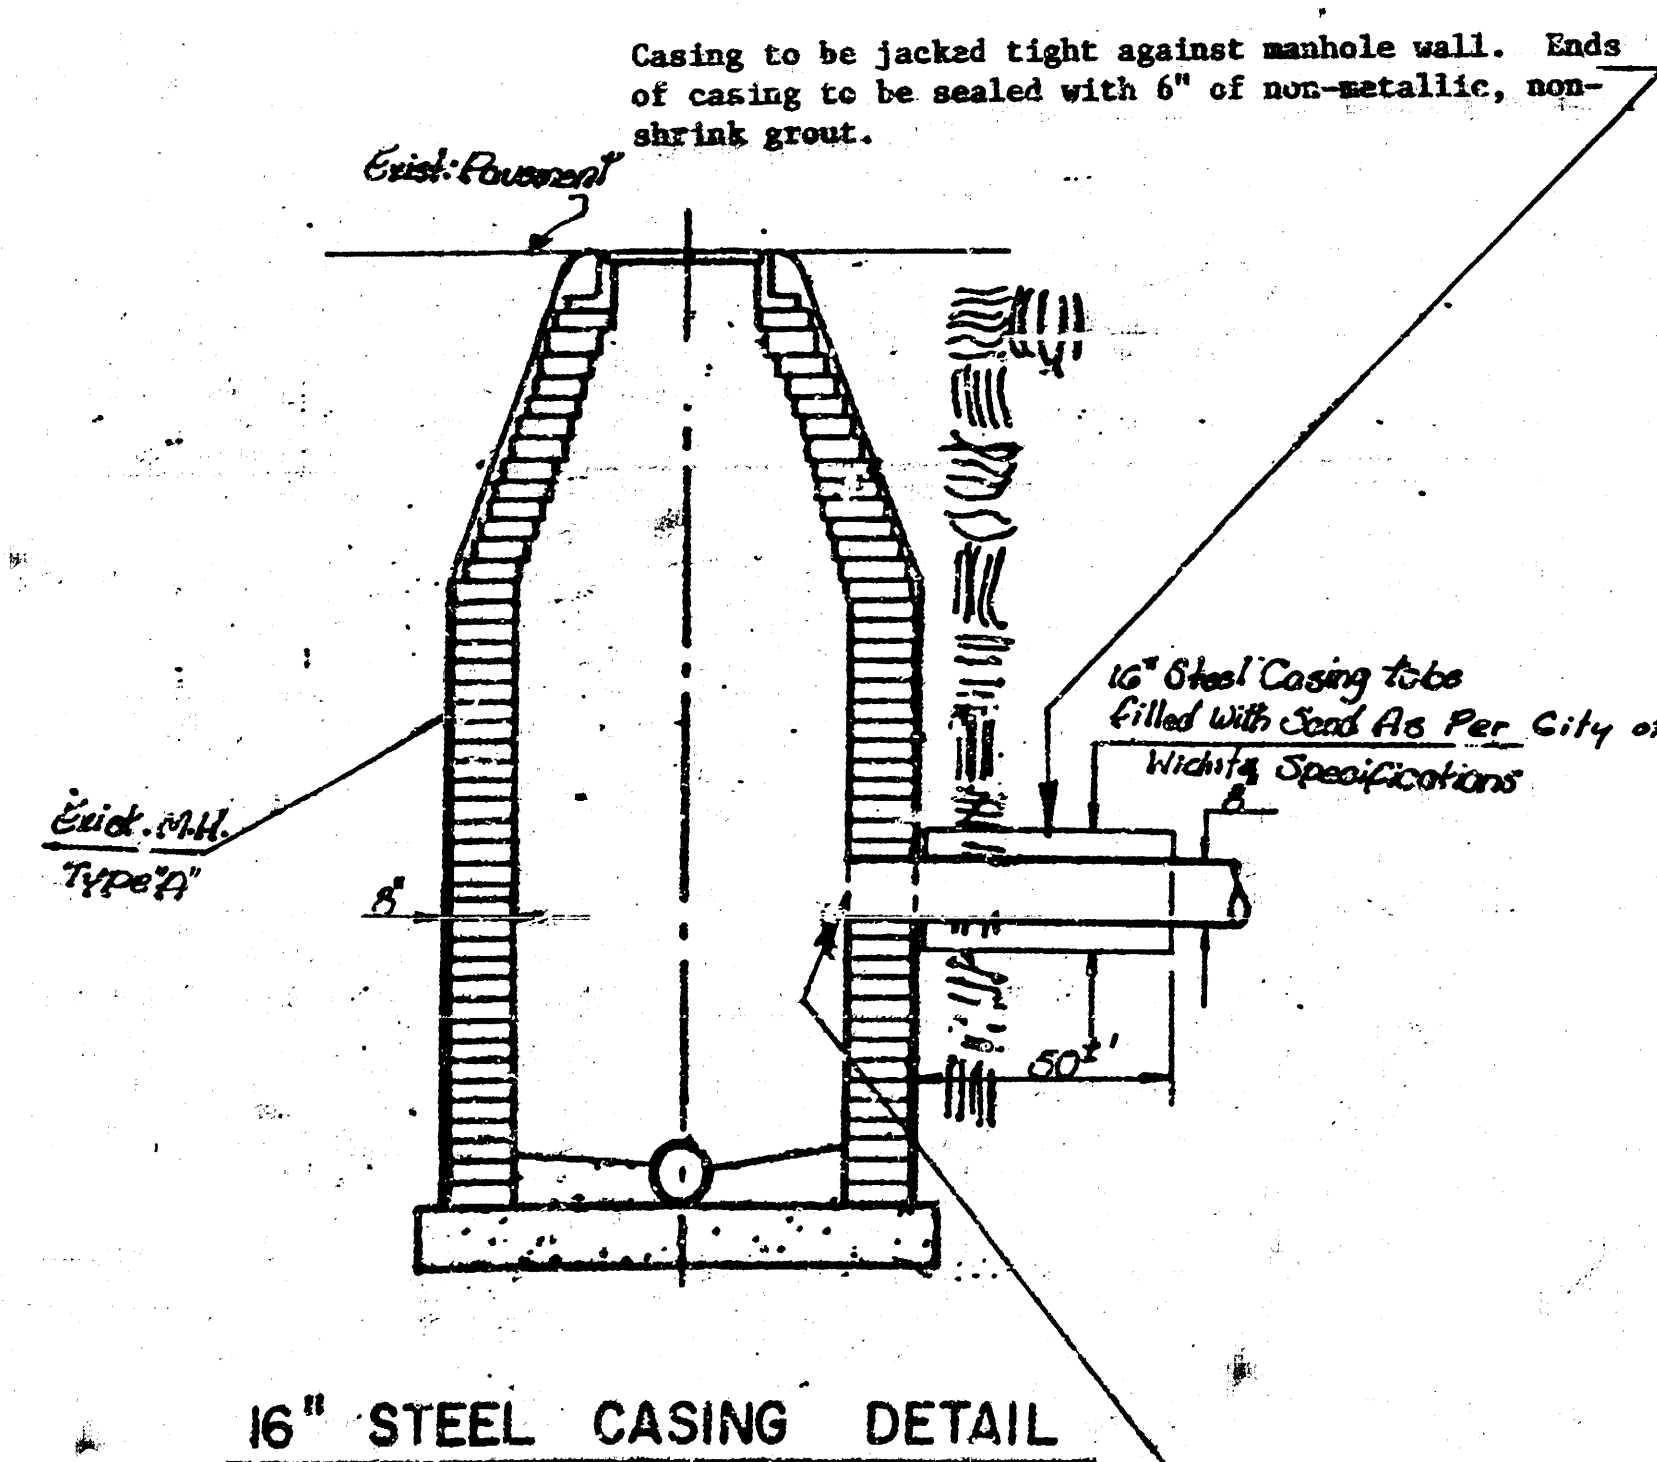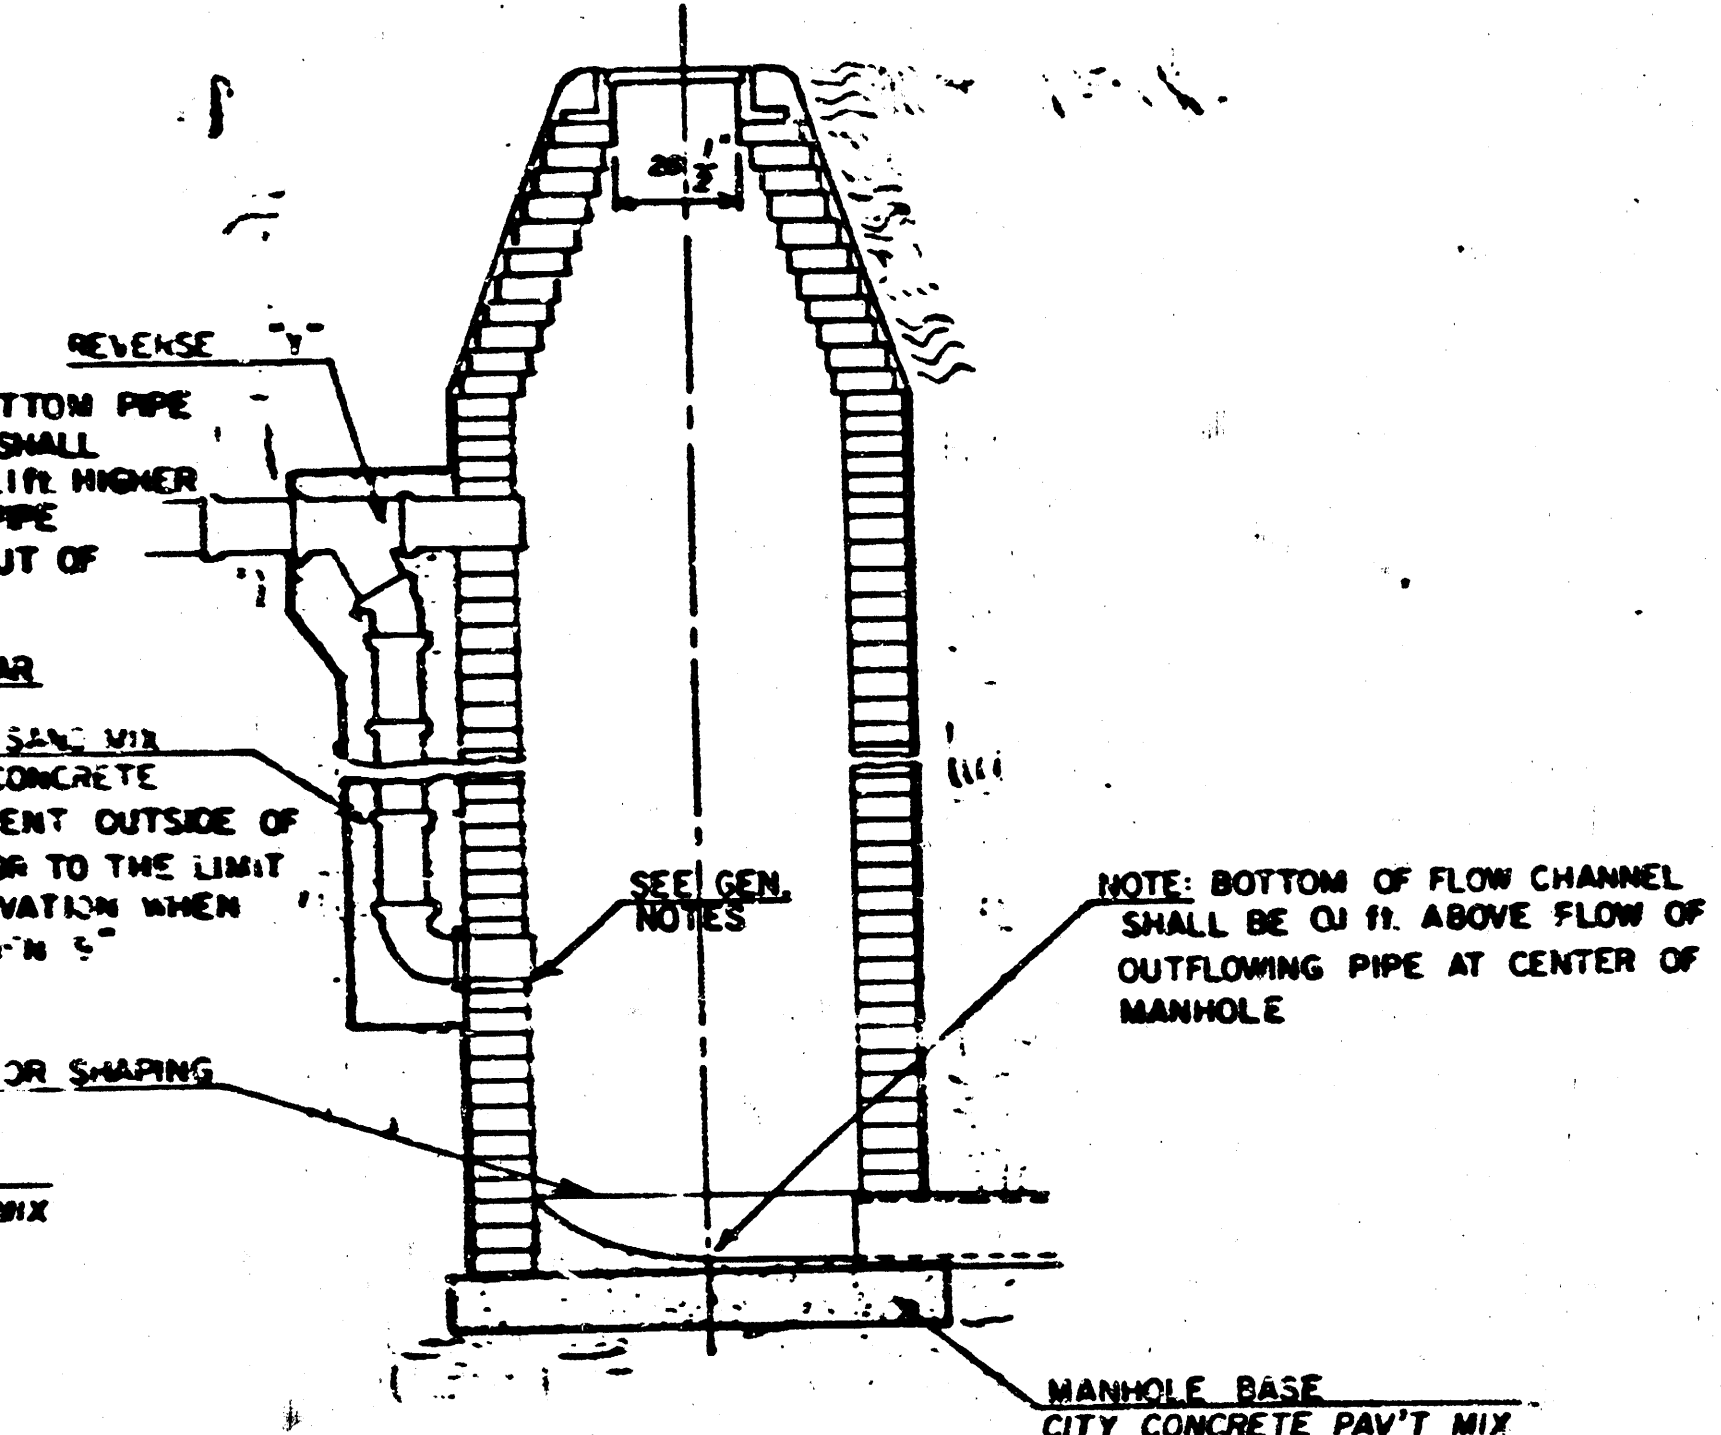

- GENERAL NOTES**
- MORTAR USED IN MASONRY CONSTRUCTION SHALL CONTAIN 8 SACKS OF CEMENT PER CUBIC YARD. CONCRETE USED IN MANHOLE BASES SHALL CONFORM TO THE REQUIREMENTS OF CONCRETE FOR CONCRETE PAVEMENT CONSTRUCTION AS SPECIFIED IN THE CITY STANDARD PAVING SPECIFICATIONS USING CITY CONCRETE PAVEMENT MIX WITHOUT AIR ENTRAINING ADMIXTURE. MORTAR SHALL BE PLACED AROUND THE MANHOLE RING AS SHOWN ON THE DRAWINGS WHEN MANHOLES ARE CONSTRUCTED IN UNPAVED AREAS. TYPE "A" MANHOLES CAN BE USED ON SEWERS UP TO 16" IN DEPTH WHEN THE MANHOLE IS NOT LOCATED WITHIN PUBLIC STREET PAVEMENT. MANHOLES CONSTRUCTED WHERE PIPE SIZES ARE SMALLER THAN 24" SHALL HAVE AN INSIDE DIAMETER OF 4'. MANHOLES CONSTRUCTED WHERE PIPE SIZES ARE 24" OR LARGER SHALL HAVE AN INSIDE DIAMETER OF 5'. THE HEIGHT OF THE CORBELS ON 4' DIAMETER MANHOLES SHALL BE 4'. MANHOLES HAVING A DIAMETER OF 5' SHALL HAVE CORBELS 6' IN HEIGHT. COMPLETED MANHOLE SHALL BE WITHOUT LEAKS AND WATER TIGHT.
 - REINFORCING STEEL SHALL BE INSTALLED IN THE MANHOLE BASES AND SHALL CONSIST OF NO. 4 BARS PLACED 6" CENTERS IN BOTH DIRECTIONS. THE MANHOLE BASE REINFORCEMENT SHALL BE PLACED 6" ABOVE THE BOTTOM OF THE MANHOLE BASE. ALL COSTS FOR FURNISHING AND INSTALLING REINFORCING STEEL SHALL BE INCLUDED IN THE UNIT PRICE BID FOR THE MANHOLE.
 - OPENINGS SHALL BE CUT INTO THE MANHOLE WALL WHEN OUTSIDE DROPS ARE CONSTRUCTED ON EXISTING MANHOLES. SUCH OPENINGS CUT INTO EXISTING MANHOLES SHALL BE AS SMALL AS PRACTICAL TO FACILITATE INSTALLING AND CROUTING THE NEW PIPE IN PLACE. WATERSTOP GASKETS SHALL BE USED WITH P.V.C. AND A.B.S. COMPOSITE PIPE. THE NEW PIPE SHALL BE CROUTED INTO THE OPENING USING AN APPROVED NONSHRINK GROUT FOR THE FULL MANHOLE WALL THICKNESS. THE EXTERIOR OF THE COMPLETED CONNECTION SHALL BE SEALED WITH AN APPROVED BITUMINOUS COATING SUCH THAT THE CONNECTION WILL BE WATER TIGHT. FLOOR OF MANHOLE SHALL BE MODIFIED TO FORM NEW FLOW CHANNEL FOR THE NEW CONNECTION AS INDICATED BY THE DRAWING. THE VERTICAL DROP FROM THE LOWER PIPE ON SUCH OUTSIDE DROP CONNECTIONS SHALL NOT EXCEED 4' FOR INFLOWING PIPES SIZED 12" OR SMALLER AND 2' FOR INFLOWING PIPES SIZED LARGER THAN 12". EXCEPT THE CROWN OF THE LOWER PIPE SHALL NEVER BE SET BELOW THE CROWN OF ANY LARGER OUTFLOWING PIPE. THIS WORK, INCLUDING MODIFICATION OF MANHOLE FLOOR, SHALL BE PAID FOR AT THE UNIT PRICE BID FOR OUTSIDE DROP STACK CONSTRUCTED ON EXISTING MANHOLE.
 - THE FLOORS OF ALL MANHOLES SHALL BE SHAPED WITH FLOW CHANNELS SUCH THAT THE MANHOLES WILL BE SELF CLEANING AND FREE OF AREAS WHERE SOLIDUSION COULD BE DEPOSITED AS SEWAGE FLOWS THROUGH THE MANHOLE FROM ALL INLET PIPES TO THE OUTLET PIPE. FLOW CHANNELS SHALL BE FORMED TO MATCH THE BOTTOM HALVES OF THE INFLOWING PIPES AND THE OUTFLOWING PIPE AS SHOWN BY THE DRAWINGS EXCEPT FOR INSIDE DROP MANHOLES. FLOW CHANNELS FOR INSIDE DROP MANHOLES SHALL BE CONSTRUCTED AS INDICATED BY THE DRAWING. MANHOLE FLOORS SHALL HAVE SLOPES OF 3 INCHES PER FOOT IN THE AREAS OUTSIDE OF THE FLOW CHANNELS SLOPED TOWARD THE FLOW CHANNELS. PIPES LAID THROUGH MANHOLES SHALL HAVE THE TOP HALF REMOVED TO NEAT LINES FOR THE FULL INSIDE DIAMETER OF THE MANHOLE. MANHOLE FLOORS SHALL THEN BE SHAPED AROUND THE BOTTOM HALF OF THE PIPE WHICH FORMS THE FLOW CHANNEL.
 - PIPES INSTALLED WITHIN THE EXCAVATION MADE FOR THE MANHOLE SHALL BE GRADLED WITH CONCRETE TO THE LIMITS OF THE MANHOLE EXCAVATION. WHEN CLAY PIPE IS USED, THE CRADLE SHALL EXTEND TO THE FIRST JOINT OUTSIDE THE MANHOLE. THE CRADLE SHALL BE TERMINATED AT THE CLAY PIPE JOINT IN A MANNER WHICH WILL MAINTAIN THE FLEXIBILITY OF THE JOINT. COST OF THE CRADLE WITHIN MANHOLE EXCAVATION OR TO CLAY PIPE JOINTS ADJACENT TO MANHOLE SHALL BE INCLUDED IN THE UNIT PRICE BID FOR THE MANHOLE.
 - MANHOLE COVER CASTINGS AND MANHOLE FRAME CASTINGS SHALL CONFORM TO THE REQUIREMENTS AS INDICATED IN THE STANDARD SPECIFICATIONS AND AS SHOWN IN THE STANDARD DETAIL DRAWING.
 - THE VERTICAL DROP IN INSIDE DROP MANHOLES SHALL NOT EXCEED 4' FOR INFLOWING PIPES SIZED 12" OR SMALLER AND 2' FOR INFLOWING PIPES LARGER THAN 12". THE CROWNS OF INFLOWING PIPES SHALL NEVER BE SET LOWER THAN THE CROWN OF THE OUTFLOWING PIPE.
 - STANDARD MANHOLES TYPE "A" AND STANDARD INSIDE DROP MANHOLES TYPE "A" SHALL BE BID AS STANDARD MANHOLES FOR THE TYPE AND DIAMETER INDICATED. OUTSIDE DROP MANHOLES TYPE "A" SHALL BE BID AS STANDARD OUTSIDE DROP MANHOLES FOR THE TYPE AND DIAMETER INDICATED. ALL MANHOLE DIAMETERS WILL BE 4' UNLESS INDICATED OTHERWISE.


anencephalic child to give

REVISOR
JAN 1985

TYPE "8" OUTSIDE DROP MANHOLE

TYPE "B" INSIDE DROP MANHOLE

TYPE "B" MANHOLE

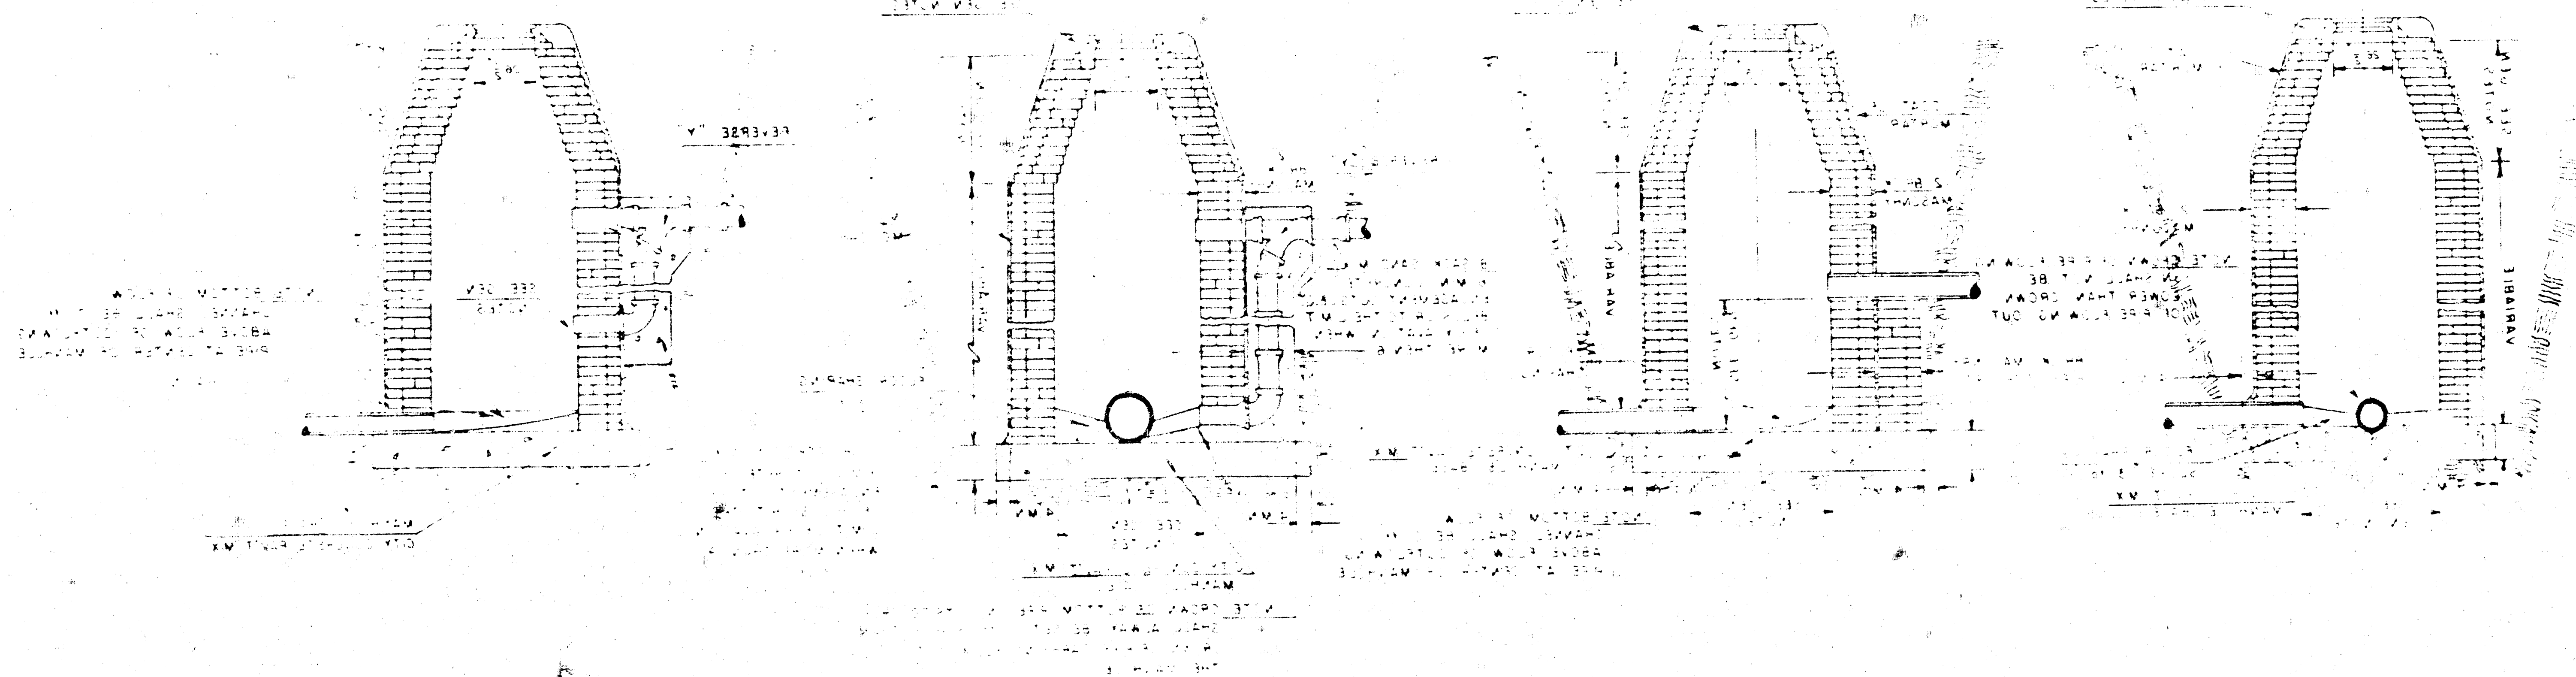[illegible][illegible][illegible]

1. The first group of people who are not
 2. 3. The second group of people who are not
 4. 5. The third group of people who are not
 6. 7. The fourth group of people who are not
 8. 9. The fifth group of people who are not
 10. 11. The sixth group of people who are not
 12. 13. The seventh group of people who are not
 14. 15. The eighth group of people who are not
 16. 17. The ninth group of people who are not
 18. 19. The tenth group of people who are not
 20. 21. The eleventh group of people who are not
 22. 23. The twelfth group of people who are not
 24. 25. The thirteenth group of people who are not
 26. 27. The fourteenth group of people who are not
 28. 29. The fifteenth group of people who are not
 30. 31. The sixteenth group of people who are not
 32. 33. The seventeenth group of people who are not
 34. 35. The eighteenth group of people who are not
 36. 37. The nineteenth group of people who are not
 38. 39. The twentieth group of people who are not
 40. 41. The twenty-first group of people who are not
 42. 43. The twenty-second group of people who are not
 44. 45. The twenty-third group of people who are not
 46. 47. The twenty-fourth group of people who are not
 48. 49. The twenty-fifth group of people who are not
 50. 51. The twenty-sixth group of people who are not
 52. 53. The twenty-seventh group of people who are not
 54. 55. The twenty-eighth group of people who are not
 56. 57. The twenty-ninth group of people who are not
 58. 59. The thirtieth group of people who are not
 60. 61. The thirty-first group of people who are not
 62. 63. The thirty-second group of people who are not
 64. 65. The thirty-third group of people who are not
 66. 67. The thirty-fourth group of people who are not
 68. 69. The thirty-fifth group of people who are not
 70. 71. The thirty-sixth group of people who are not
 72. 73. The thirty-seventh group of people who are not
 74. 75. The thirty-eighth group of people who are not
 76. 77. The thirty-ninth group of people who are not
 78. 79. The fortieth group of people who are not
 80. 81. The forty-first group of people who are not
 82. 83. The forty-second group of people who are not
 84. 85. The forty-third group of people who are not
 86. 87. The forty-fourth group of people who are not
 88. 89. The forty-fifth group of people who are not
 90. 91. The forty-sixth group of people who are not
 92. 93. The forty-seventh group of people who are not
 94. 95. The forty-eighth group of people who are not
 96. 97. The forty-ninth group of people who are not
 98. 99. The fiftieth group of people who are not
 100. 101. The fifty-first group of people who are not
 102. 103. The fifty-second group of people who are not
 104. 105. The fifty-third group of people who are not
 106. 107. The fifty-fourth group of people who are not
 108. 109. The fifty-fifth group of people who are not
 110. 111. The fifty-sixth group of people who are not
 112. 113. The fifty-seventh group of people who are not
 114. 115. The fifty-eighth group of people who are not
 116. 117. The fifty-ninth group of people who are not
 118. 119. The sixtieth group of people who are not
 120. 121. The sixty-first group of people who are not
 122. 123. The sixty-second group of people who are not
 124. 125. The sixty-third group of people who are not
 126. 127. The sixty-fourth group of people who are not
 128. 129. The sixty-fifth group of people who are not
 130. 131. The sixty-sixth group of people who are not
 132. 133. The sixty-seventh group of people who are not
 134. 135. The sixty-eighth group of people who are not
 136. 137. The sixty-ninth group of people who are not
 138. 139. The seventieth group of people who are not
 140. 141. The seventy-first group of people who are not
 142. 143. The seventy-second group of people who are not
 144. 145. The seventy-third group of people who are not
 146. 147. The seventy-fourth group of people who are not
 148. 149. The seventy-fifth group of people who are not
 150. 151. The seventy-sixth group of people who are not
 152. 153. The seventy-seventh group of people who are not
 154. 155. The seventy-eighth group of people who are not
 156. 157. The seventy-ninth group of people who are not
 158. 159. The eightieth group of people who are not
 160. 161. The eighty-first group of people who are not
 162. 163. The eighty-second group of people who are not
 164. 165. The eighty-third group of people who are not
 166. 167. The eighty-fourth group of people who are not
 168. 169. The eighty-fifth group of people who are not
 170. 171. The eighty-sixth group of people who are not
 172. 173. The eighty-seventh group of people who are not
 174. 175. The eighty-eighth group of people who are not
 176. 177. The eighty-ninth group of people who are not
 178. 179. The ninetieth group of people who are not
 180. 181. The ninety-first group of people who are not
 182. 183. The ninety-second group of people who are not
 184. 185. The ninety-third group of people who are not
 186. 187. The ninety-fourth group of people who are not
 188. 189. The ninety-fifth group of people who are not
 190. 191. The ninety-sixth group of people who are not
 192. 193. The ninety-seventh group of people who are not
 194. 195. The ninety-eighth group of people who are not
 196. 197. The ninety-ninth group of people who are not
 198. 199. The hundredth group of people who are not
 200. 201. The hundred-first group of people who are not
 202. 203. The hundred-second group of people who are not
 204. 205. The hundred-third group of people who are not
 206. 207. The hundred-fourth group of people who are not
 208. 209. The hundred-fifth group of people who are not
 210. 211. The hundred-sixth group of people who are not
 212. 213. The hundred-seventh group of people who are not
 214. 215. The hundred-eighth group of people who are not
 216. 217. The hundred-ninth group of people who are not
 218. 219. The hundred-tenth group of people who are not
 220. 221. The hundred-eleventh group of people who are not
 222. 223. The hundred-twelfth group of people who are not
 224. 225. The hundred-thirteenth group of people who are not
 226. 227. The hundred-fourteenth group of people who are not
 228. 229. The hundred-fifteenth group of people who are not
 230. 231. The hundred-sixteenth group of people who are not
 232. 233. The hundred-seventeenth group of people who are not
 234. 235. The hundred-eighteenth group of people who are not
 236. 237. The hundred-nineteenth group of people who are not
 238. 239. The hundred-twentieth group of people who are not
 240. 241. The hundred-twenty-first group of people who are not
 242. 243. The hundred-twenty-second group of people who are not
 244. 245. The hundred-twenty-third group of people who are not
 246. 247. The hundred-twenty-fourth group of people who are not
 248. 249. The hundred-twenty-fifth group of people who are not
 250. 251. The hundred-twenty-sixth group of people who are not
 252. 253. The hundred-twenty-seventh group of people who are not
 254. 255. The hundred-twenty-eighth group of people who are not
 256. 257. The hundred-twenty-ninth group of people who are not
 258. 259. The hundred-thirtieth group of people who are not
 260. 261. The hundred-thirty-first group of people who are not
 262. 263. The hundred-thirty-second group of people who are not
 264. 265. The hundred-thirty-third group of people who are not
 266. 267. The hundred-thirty-fourth group of people who are not
 268. 269. The hundred-thirty-fifth group of people who are not
 270. 271. The hundred-thirty-sixth group of people who are not
 272. 273. The hundred-thirty-seventh group of people who are not
 274. 275. The hundred-thirty-eighth group of people who are not
 276. 277. The hundred-thirty-ninth group of people who are not
 278. 279. The hundred-fortieth group of people who are not
 280. 281. The hundred-forty-first group of people who are not
 282. 283. The hundred-forty-second group of people who are not
 284. 285. The hundred-forty-third group of people who are not
 286. 287. The hundred-forty-fourth group of people who are not
 288. 289. The hundred-forty-fifth group of people who are not
 290. 291. The hundred-forty-sixth group of people who are not
 292. 293. The hundred-forty-seventh group of people who are not
 294. 295. The hundred-forty-eighth group of people who are not
 296. 297. The hundred-forty-ninth group of people who are not
 298. 299. The hundred-fiftieth group of people who are not
 300. 301. The hundred-fifty-first group of people who are not
 302. 303. The hundred-fifty-second group of people who are not
 304. 305. The hundred-fifty-third group of people who are not
 306. 307. The hundred-fifty-fourth group of people who are not
 308. 309. The hundred-fifty-fifth group of people who are not
 310. 311. The hundred-fifty-sixth group of people who are not
 312. 313. The hundred-fifty-seventh group of people who are not
 314. 315. The hundred-fifty-eighth group of people who are not
 316. 317. The hundred-fifty-ninth group of people who are not
 318. 319. The hundred-sixtieth group of people who are not
 320. 321. The hundred-sixty-first group of people who are not
 322. 323. The hundred-sixty-second group of people who are not
 324. 325. The hundred-sixty-third group of people who are not
 326. 327. The hundred-sixty-fourth group of people who are not
 328. 329. The hundred-sixty-fifth group of people who are not
 330. 331. The hundred-sixty-sixth group of people who are not
 332. 333. The hundred-sixty-seventh group of people who are not
 334. 335. The hundred-sixty-eighth group of people who are not
 336. 337. The hundred-sixty-ninth group of people who are not
 338. 339. The hundred-seventieth group of people who are not
 340. 341. The hundred-seventy-first group of people who are not
 342. 343. The hundred-seventy-second group of people who are not
 344. 345. The hundred-seventy-third group of people who are not
 346. 347.

[illegible][illegible]

1. The first group of people who are interested in the study of the history of the United States are the people who are interested in the history of the United States. They are interested in the history of the United States because they want to know more about the United States. They want to know more about the United States because they want to know more about the United States.

[illegible][illegible][illegible]

State of Kansas ss:
County of Sedgwick

This is to certify that this plat was filed in the Office of the Register of Deeds this 26th day of MARCH, 1981, at 11:30 o'clock, A.M. to correct the following dimensional reference for the south half of 30th Street North east of Woodlawn from 35 feet to 41 feet.

Bette F. McCart, Register of Deeds
Pat Kettler, Deputy

FINAL PLAT OF

ALLENS FARM

AN ADDITION TO WICHITA, SEDGWICK COUNTY, KANSAS

I, Steven E. Anderson, a Land Surveyor in Kansas do hereby certify that I have been in responsible charge of surveying and platting of "Allens Farm", an addition to Wichita, Sedgwick County, Kansas into a lot, streets and floodway, the same being accurately set forth in the accompanying plat and described as follows:

Beginning at the intersection of the North right of way line of Twenty-Ninth Street North and the East right of way line of Woodlawn Boulevard, said point of beginning being 30 feet Northerly and 50 feet Easterly from the Southwest corner of Section 31, Township 26 South, Range 2 East of the 6th P.M.; thence Northerly along said East line of Woodlawn Boulevard bearing North 1°14'30" West, 701.00 feet to the Southwest corner of Cottonwood Village First Addition to Wichita, Sedgwick County, Kansas; thence Easterly along the boundary of said addition bearing North 88°55'01" East, 350.49 feet; thence along a curve to the left having a central angle of 30°06'00", a radius of 247.73 feet and a length of 129.71 feet; thence North 58°55'01" East, 90.00 feet; thence along a curve to the right having a central angle of 30°00'00", a radius of 132.94 feet, and a length of 69.61 feet; thence North 88°55'01" East, 21.97 feet to the Southeast corner of Cottonwood Village Second Addition to Wichita, Sedgwick County, Kansas; thence along the boundary of said addition bearing North 88°55'01" East, 211.96 feet; thence along a curve to the right having a central angle of 44°50'29", a radius of 86.18 feet and a length of 67.45 feet; thence South 46°14'30" East, 172.86 feet; thence along a curve to the right having a central angle of 45°00'00", a radius of 85.71 feet and a length of 67.32 feet; thence South 1°14'30" East, 106.50 feet to the intersection of the West right of way line of Bramblewood and the North line of Block 1, Cottonwood Village Third Addition to Wichita, Sedgwick County, Kansas; thence Southerly along the West line of Bramblewood bearing South 1°14'30" East, 423.00 feet to the North right of way line of Twenty-Ninth Street North; thence Westerly along said North line of Twenty-Ninth Street North bearing South 88°55'01" West, 1061.00 feet to the point of beginning; containing 17.97 acres, more or less.

I hereby certify that the details of this plat are correct to the best of my knowledge and belief this 26 day of October, 1980.



By: Steven E. Anderson
Steven E. Anderson
VAN DOREN-HAZARD-STALLINGS
260 North Rock Road, Suite 250
Wichita, Kansas 67206

Know all men by these presents that we the undersigned property owners of the land as above set forth in the Surveyor's Certificate, have caused the same to be surveyed and platted into a lot, streets, and a floodway, the same to be known as "Allens Farm", an addition to Wichita, Sedgwick County, Kansas. The streets are hereby dedicated to and for the use of the public. The floodway shall be the responsibility of the owners of the property in the subdivision until such time as the governing body exercising jurisdiction elects to assume the responsibility for maintenance and improvement of the drainage, provided further, that no structure shall be constructed on or within said floodway, nor shall any fill, change of grade, creation of channel or other work be carried on without the permission of the Wichita-Sedgwick County Flood Control Office or their successors of office. Easements for the construction and maintenance of public utilities and drainage, as indicated on the accompanying plat are hereby granted. All abutter's rights of access over and across the north line of Twenty-Ninth Street North and the east line of Woodlawn are hereby granted to the City of Wichita, provided, however, that the subdivision shall have access to Twenty-Ninth Street North at three locations to be determined by the Engineers of the City of Wichita. Minimum pad elevation shall be 173.1, City of Wichita Datum.

Woodlawn Development Company

By: C.J. Nelson
C.J. Nelson, President

STATE OF KANSAS

COUNTY OF SEDGWICK

Be it remembered that on this 26th day of October, 1980 before me, a Notary Public in and for said State and County, came the Woodlawn Development Company by C.J. Nelson, President to me personally known to be the same person who executed the foregoing instrument of writing and duly acknowledged the execution of the same. In testimony whereof I have hereunto set my hand and affixed my notarial seal the day and year above written.

Carolyn R. Owen, Notary Public
My Appointment Expires: May 11, 1981

This plat of "Allens Farm" has been submitted to and approved by the Wichita-Sedgwick County Metropolitan Area Planning Commission, Wichita, Kansas.

Dated this 11th day of September, 1980.

Wichita-Sedgwick County Metropolitan Area Planning Commission

James L. Gardner II, Vice-Chairman
Robert A. Lakin, Secretary

This plat approved and all dedications shown hereon, if any, accepted by the City Commission of the City of Wichita, Kansas this 29 day of October, 1980.

Robert G. Knight, Mayor
Donald C. Grigg, City Clerk

This plat approved and all dedications shown hereon, if any, accepted by the Board of County Commissioners of Sedgwick County, Kansas this 29 day of October, 1980.

Everett Patrick, Chairman
Tom Scott, Commissioner
Donald E. Gragg, Commissioner

Attest: Dorothy K. White, County Clerk

Entered on transfer record this 29 day of October, 1980.

Dorothy K. White, County Clerk

STATE OF KANSAS

COUNTY OF SEDGWICK

This is to certify that this instrument was filed for record in the Register of Deeds Office at 12:30pm o'clock on the 29th day of OCTOBER, 1980.

Bette F. McCart, Register of Deeds

Pat Kettler, Deputy