



B.M. 219.80 R.P. SPIKE N-FACE P.P. SW.
COR. 37th ST. NO. 4 COMOTARA.

SCALE PLAN 1" = 40'
PROFILE 1" = 40' HORIZ.
1" = 5' VERT.

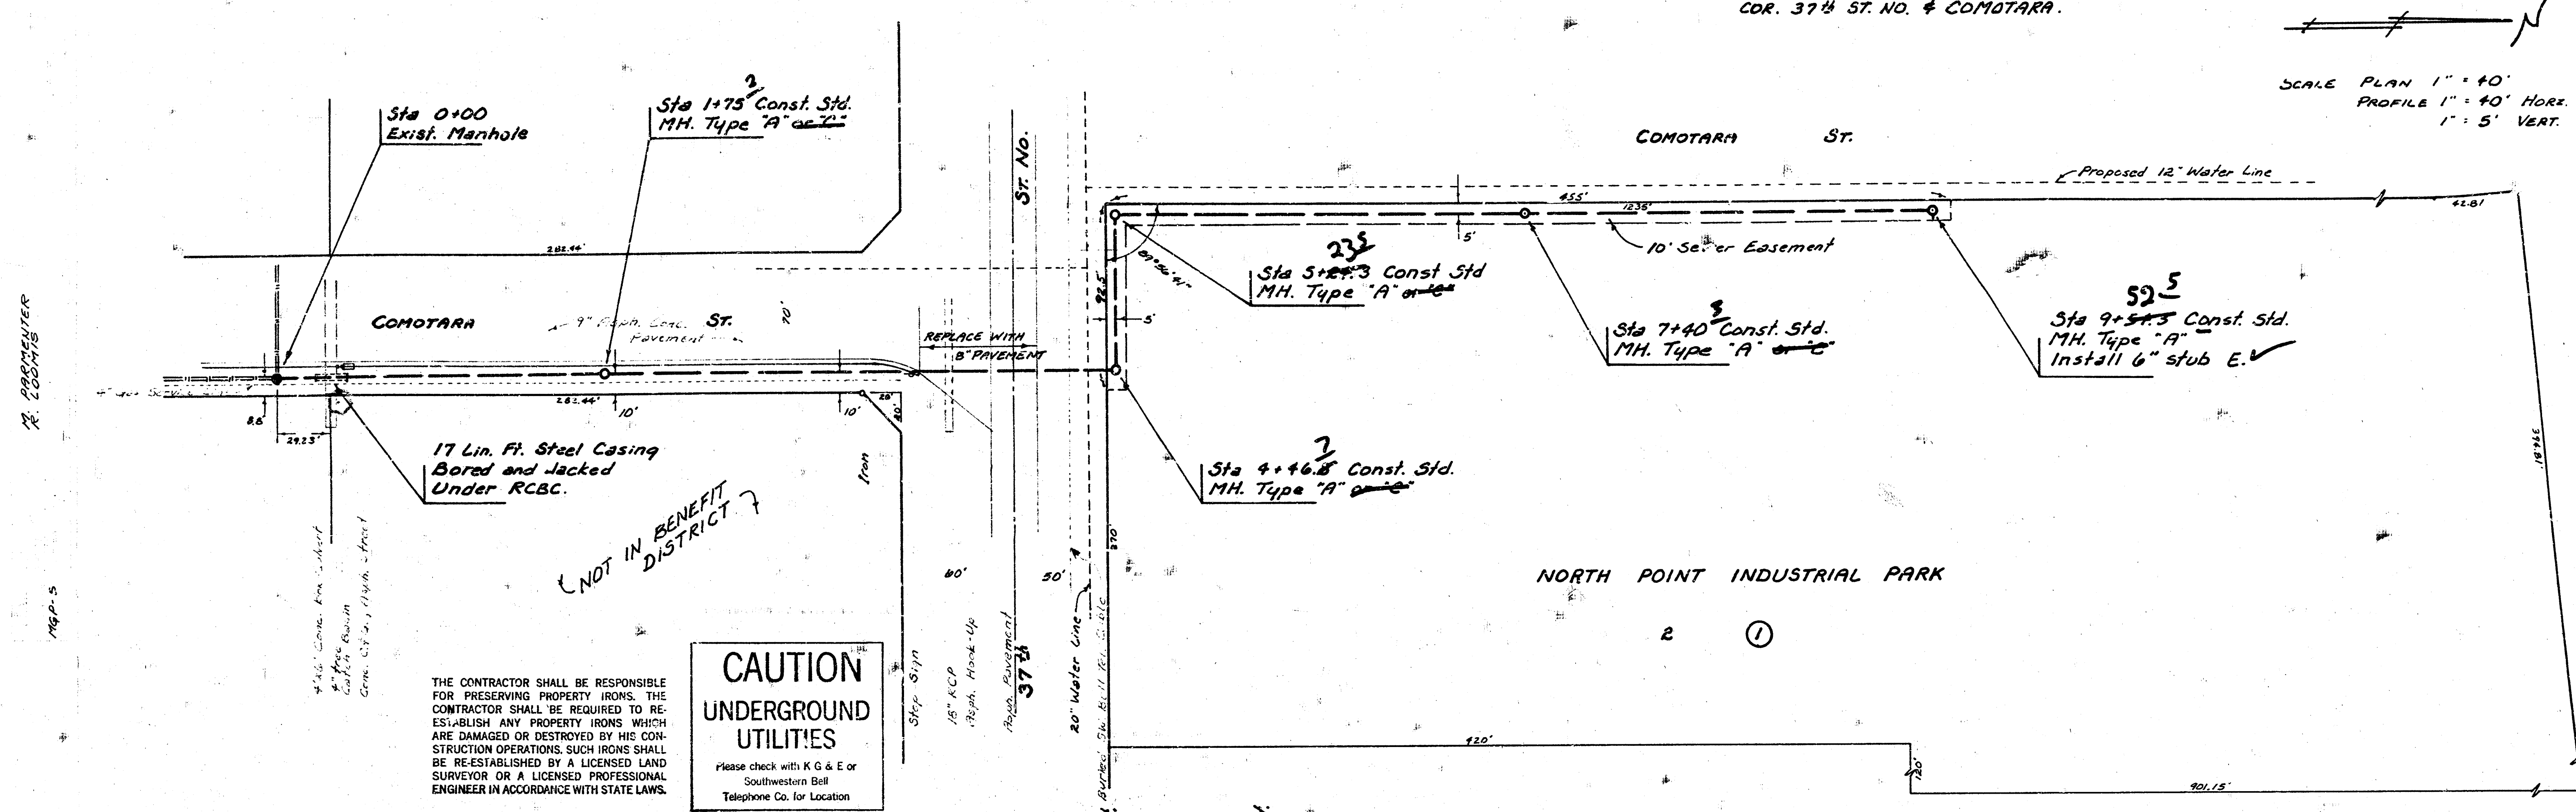


THE CONTRACTOR SHALL BE RESPONSIBLE FOR PRESERVING PROPERTY IRONS. THE CONTRACTOR SHALL BE REQUIRED TO RE-ESTABLISH ANY PROPERTY IRONS WHICH ARE DAMAGED OR DESTROYED BY HIS CONSTRUCTION OPERATIONS. SUCH IRONS SHALL BE RE-ESTABLISHED BY A LICENSED LAND SURVEYOR OR A LICENSED PROFESSIONAL ENGINEER IN ACCORDANCE WITH STATE LAWS.

CAUTION
UNDERGROUND UTILITIES
Please check with K & E or Southwestern Bell Telephone Co. for Location

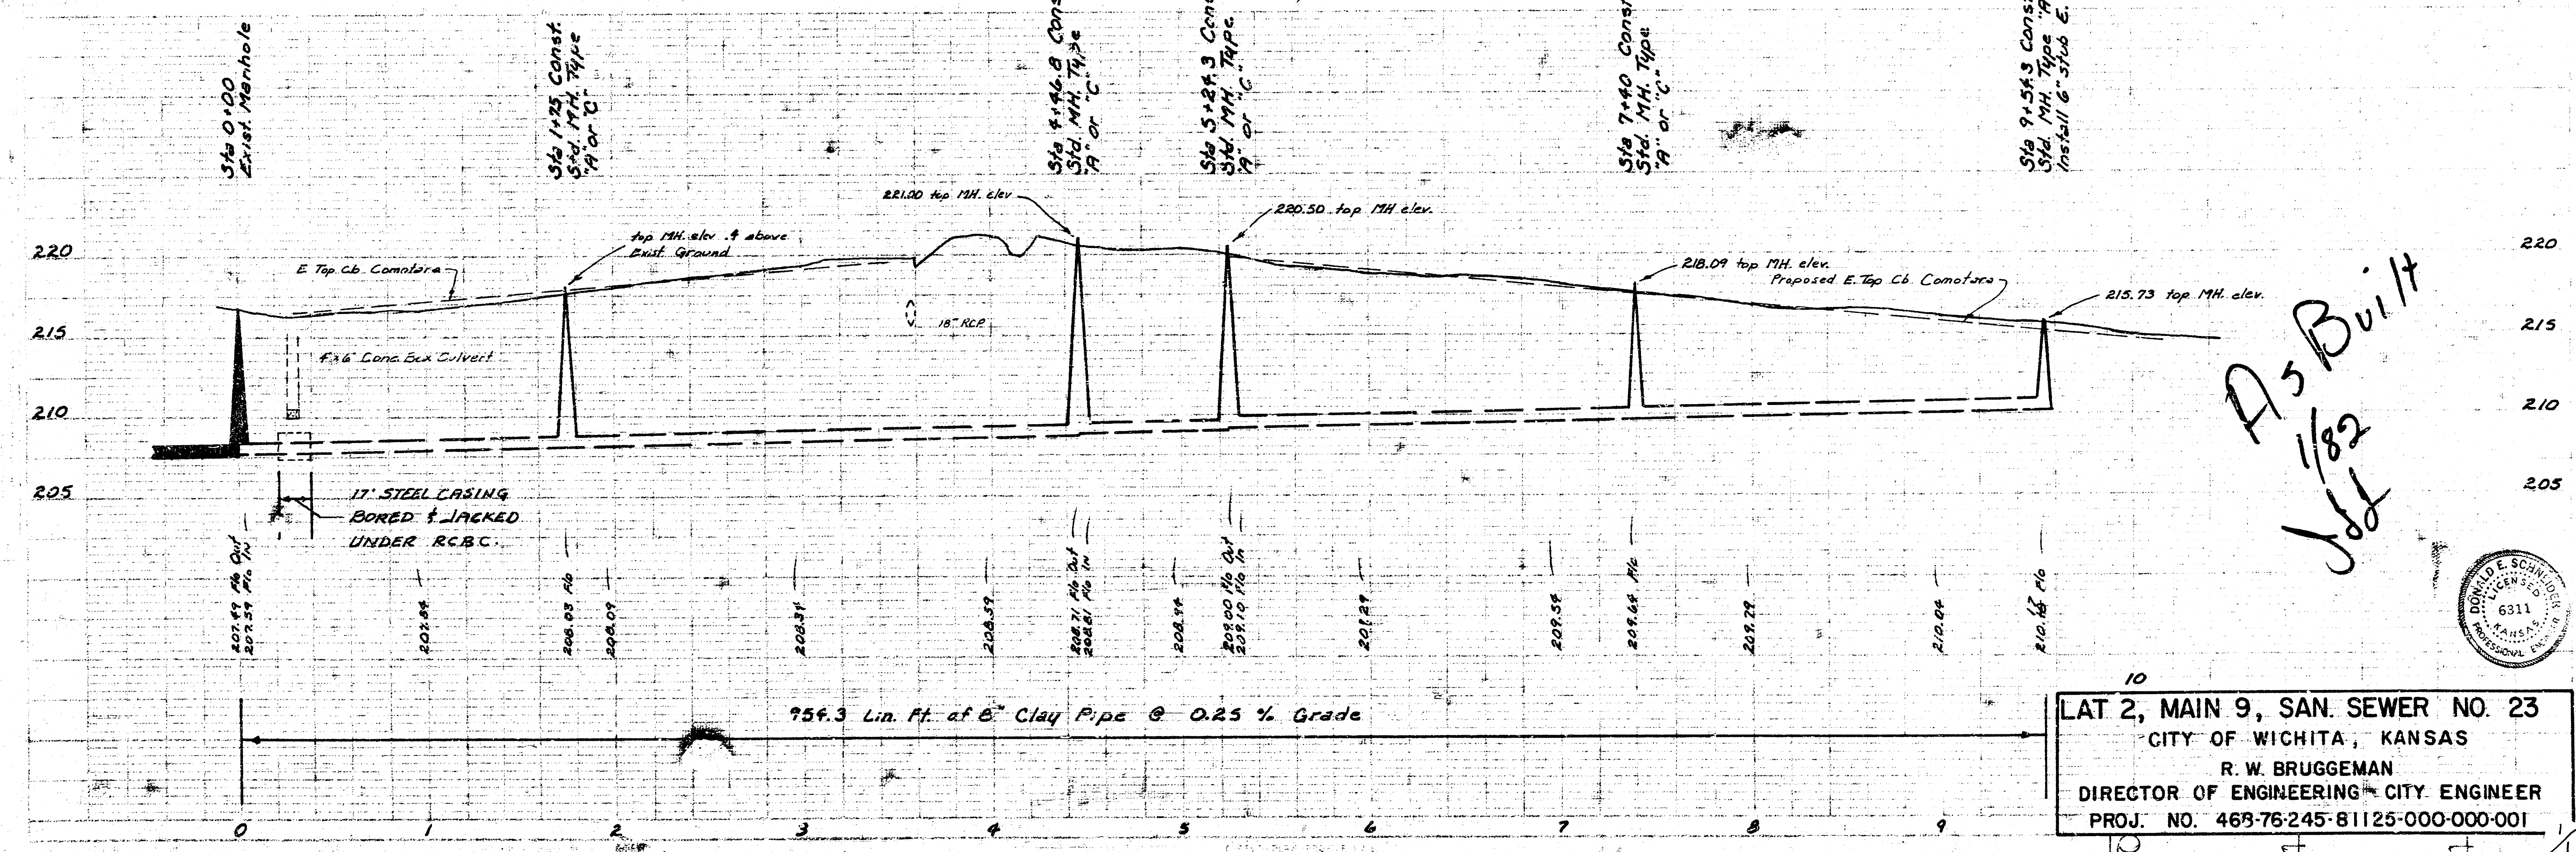

As Built
Jef
1/82

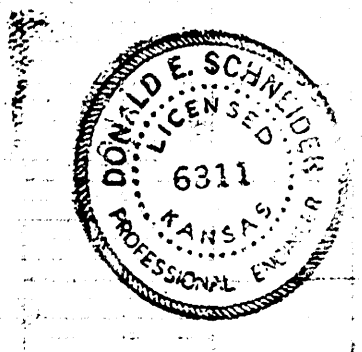

LAT 2, MAIN 9, SAN. SEWER NO. 23
CITY OF WICHITA, KANSAS
R. W. BRUGGEMAN
DIRECTOR OF ENGINEERING - CITY ENGINEER
PROJ. NO. 463-76-245-81125-000-001