
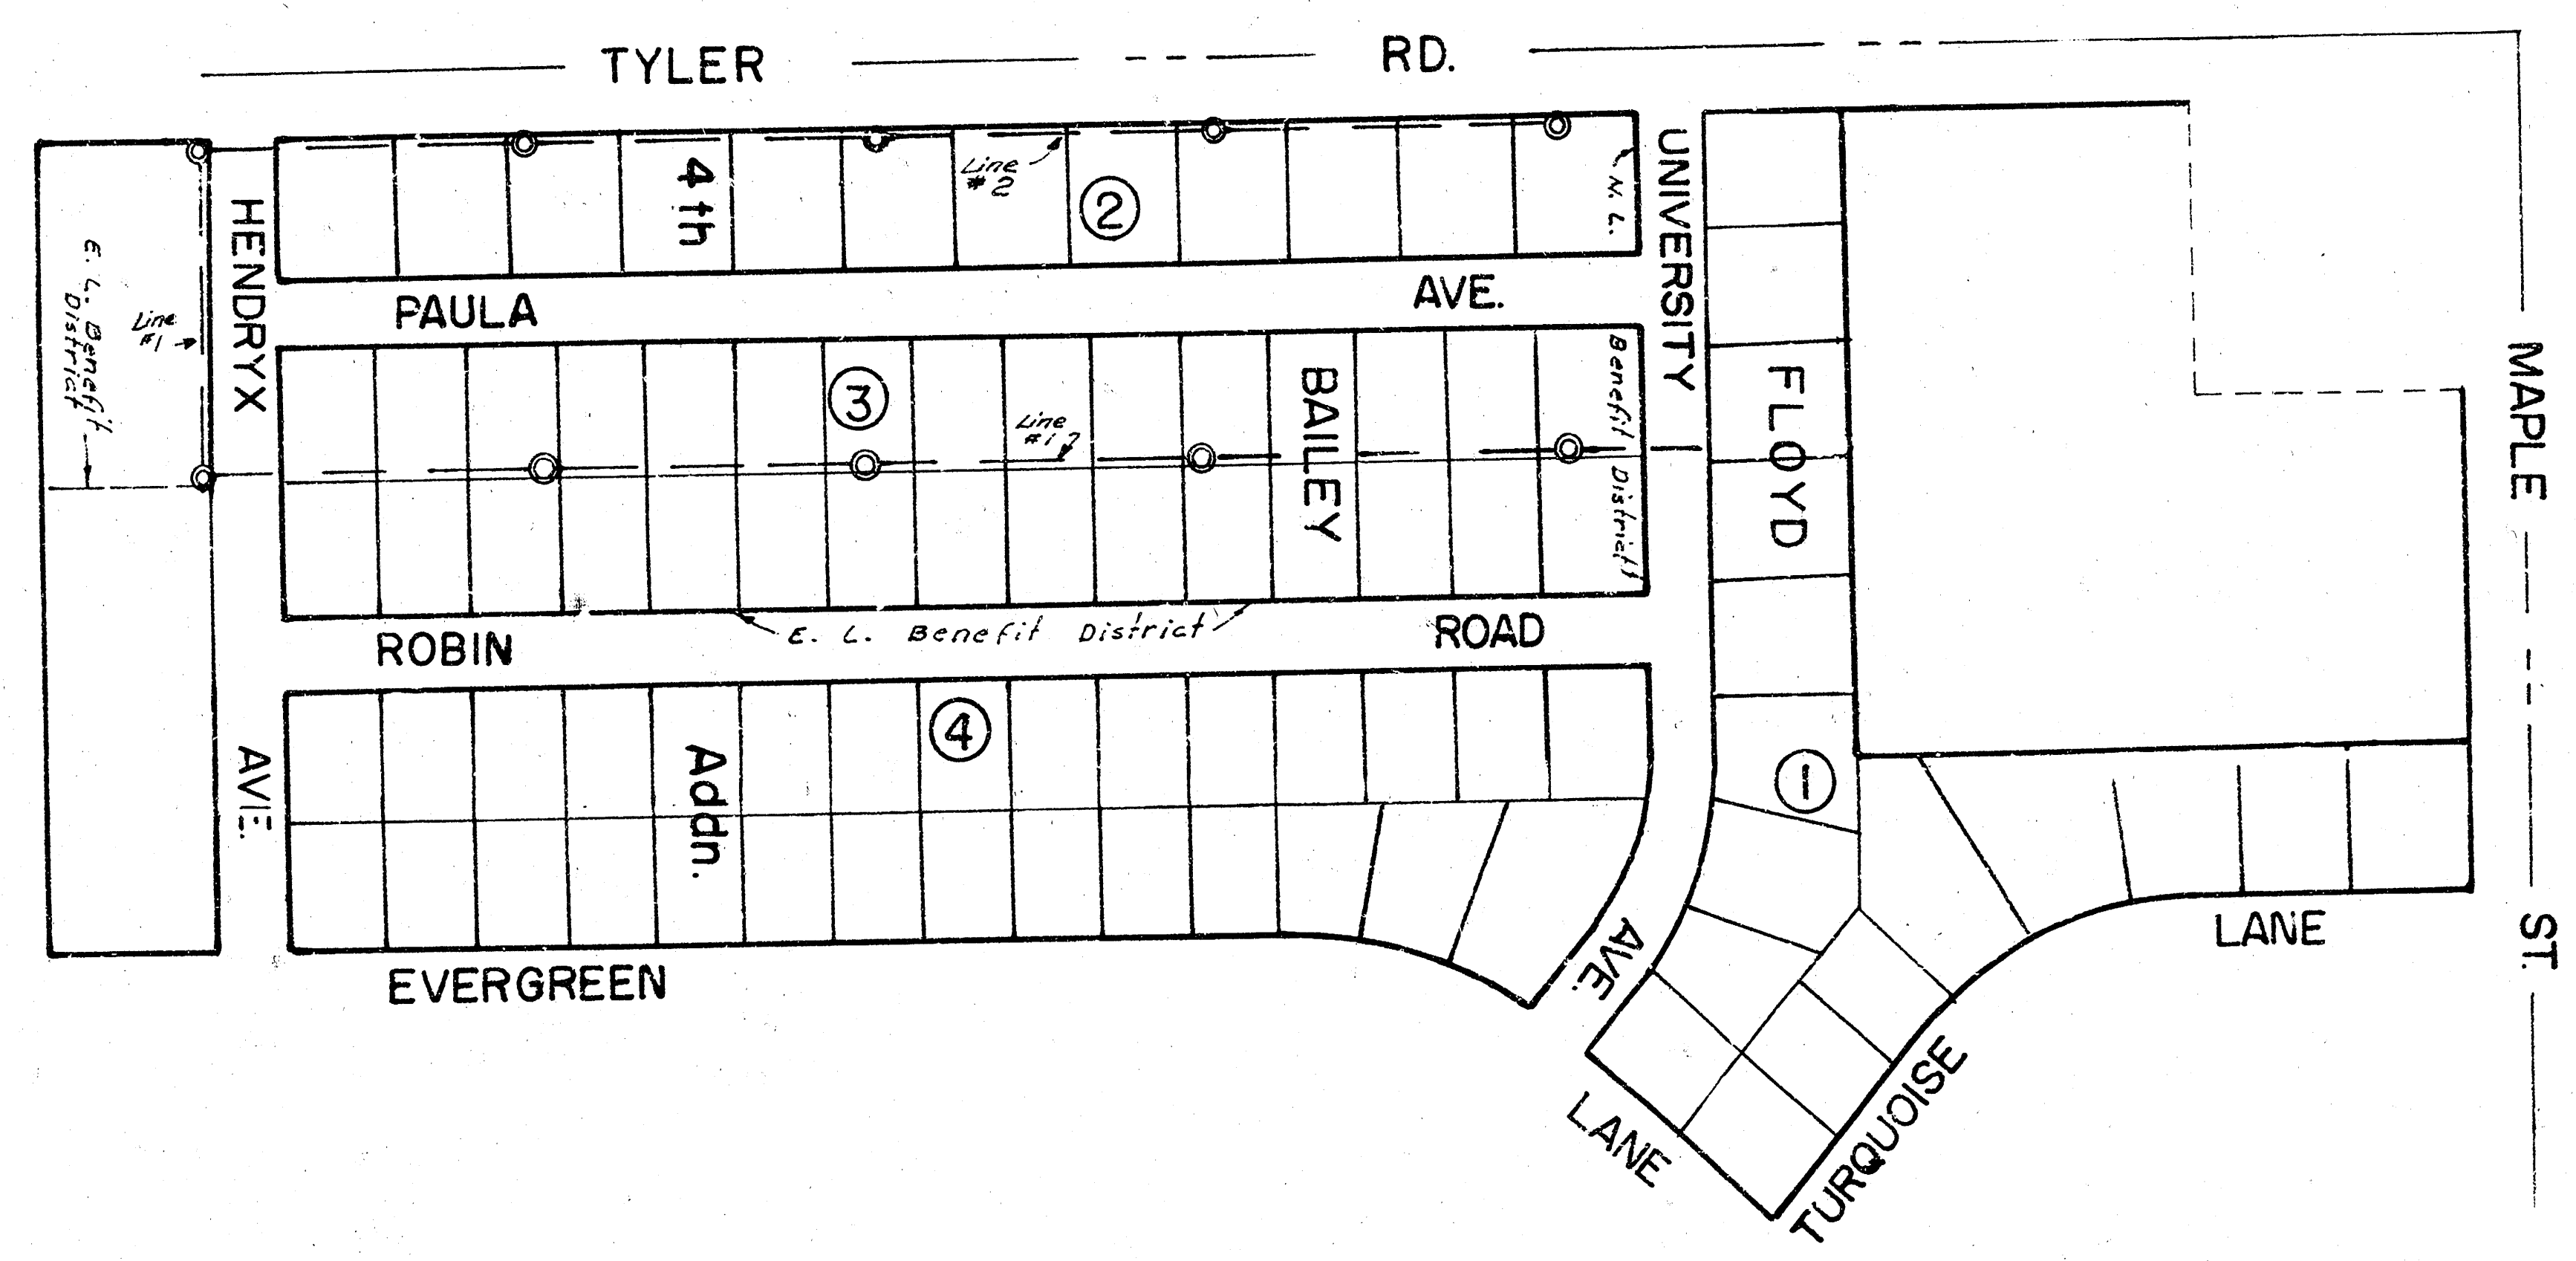


Lateral 7, Southwest Main

Project No. DBKL 568030

R. W. Linn City Engineer

City of Wichita, Kansas

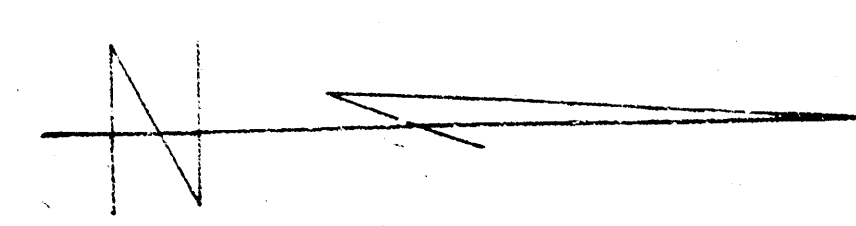




Line No. 1
2

Sheet No. 2 & 3
4



As Built Final Measurements
H-105

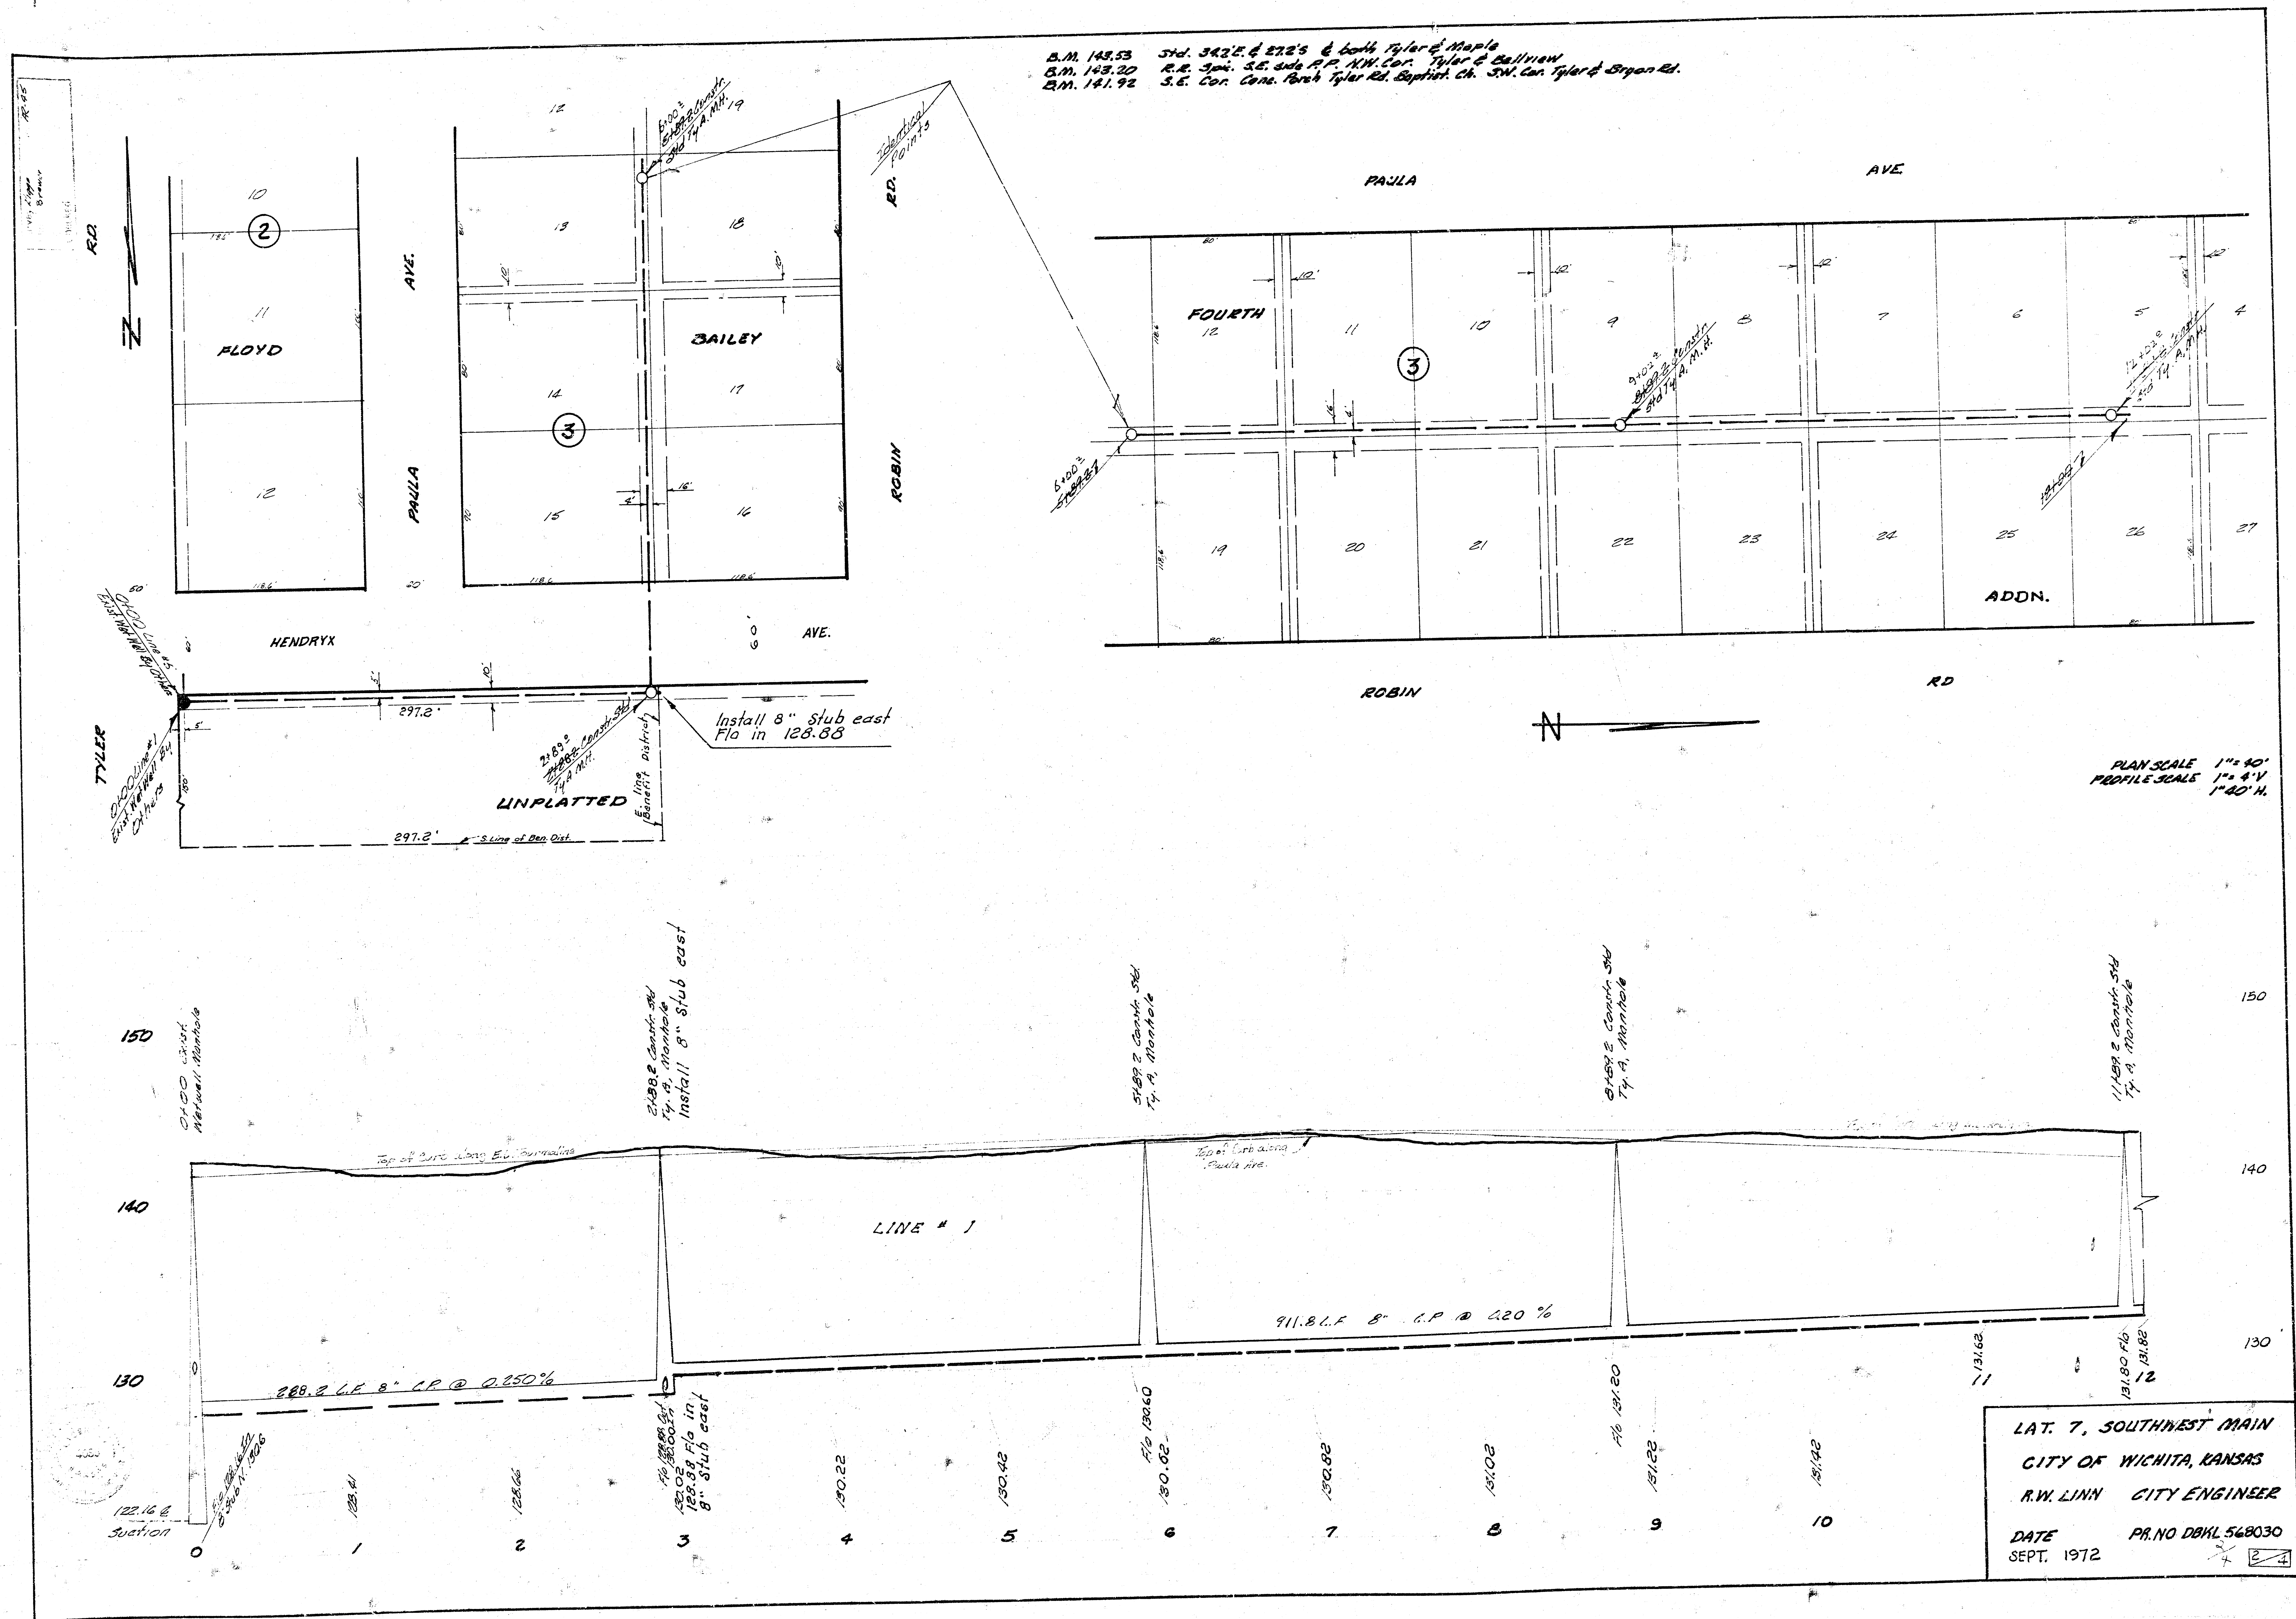

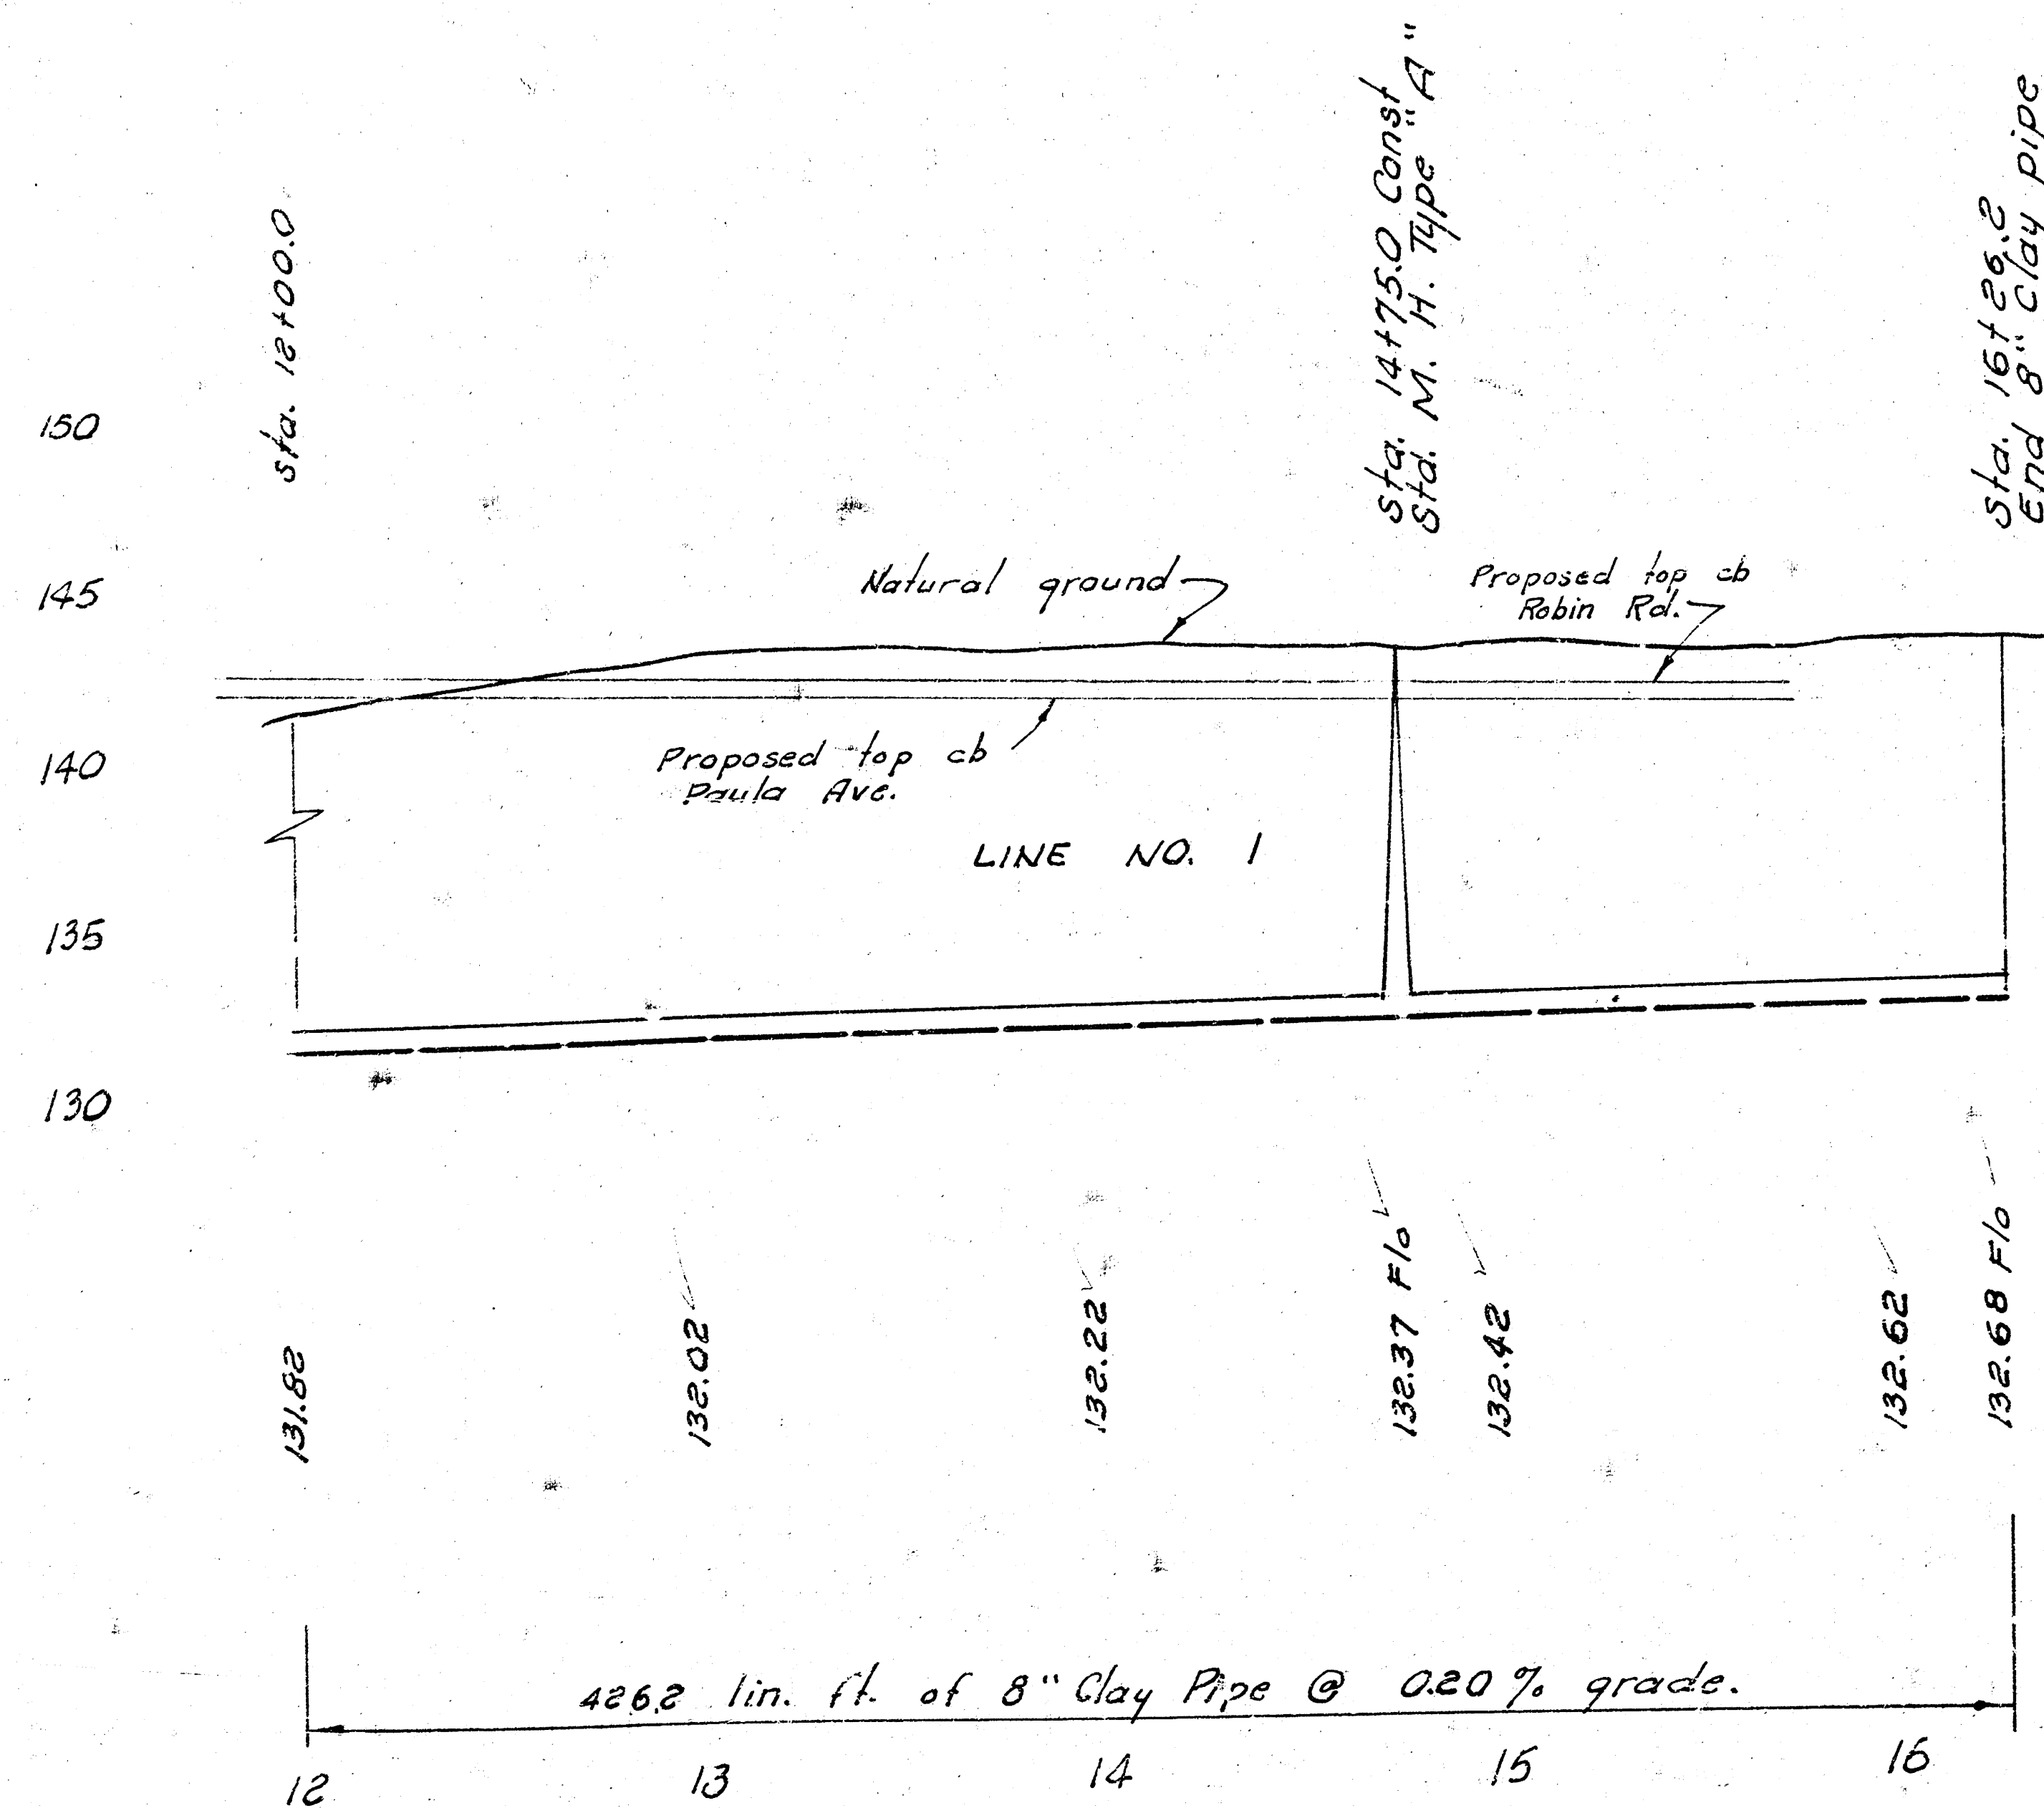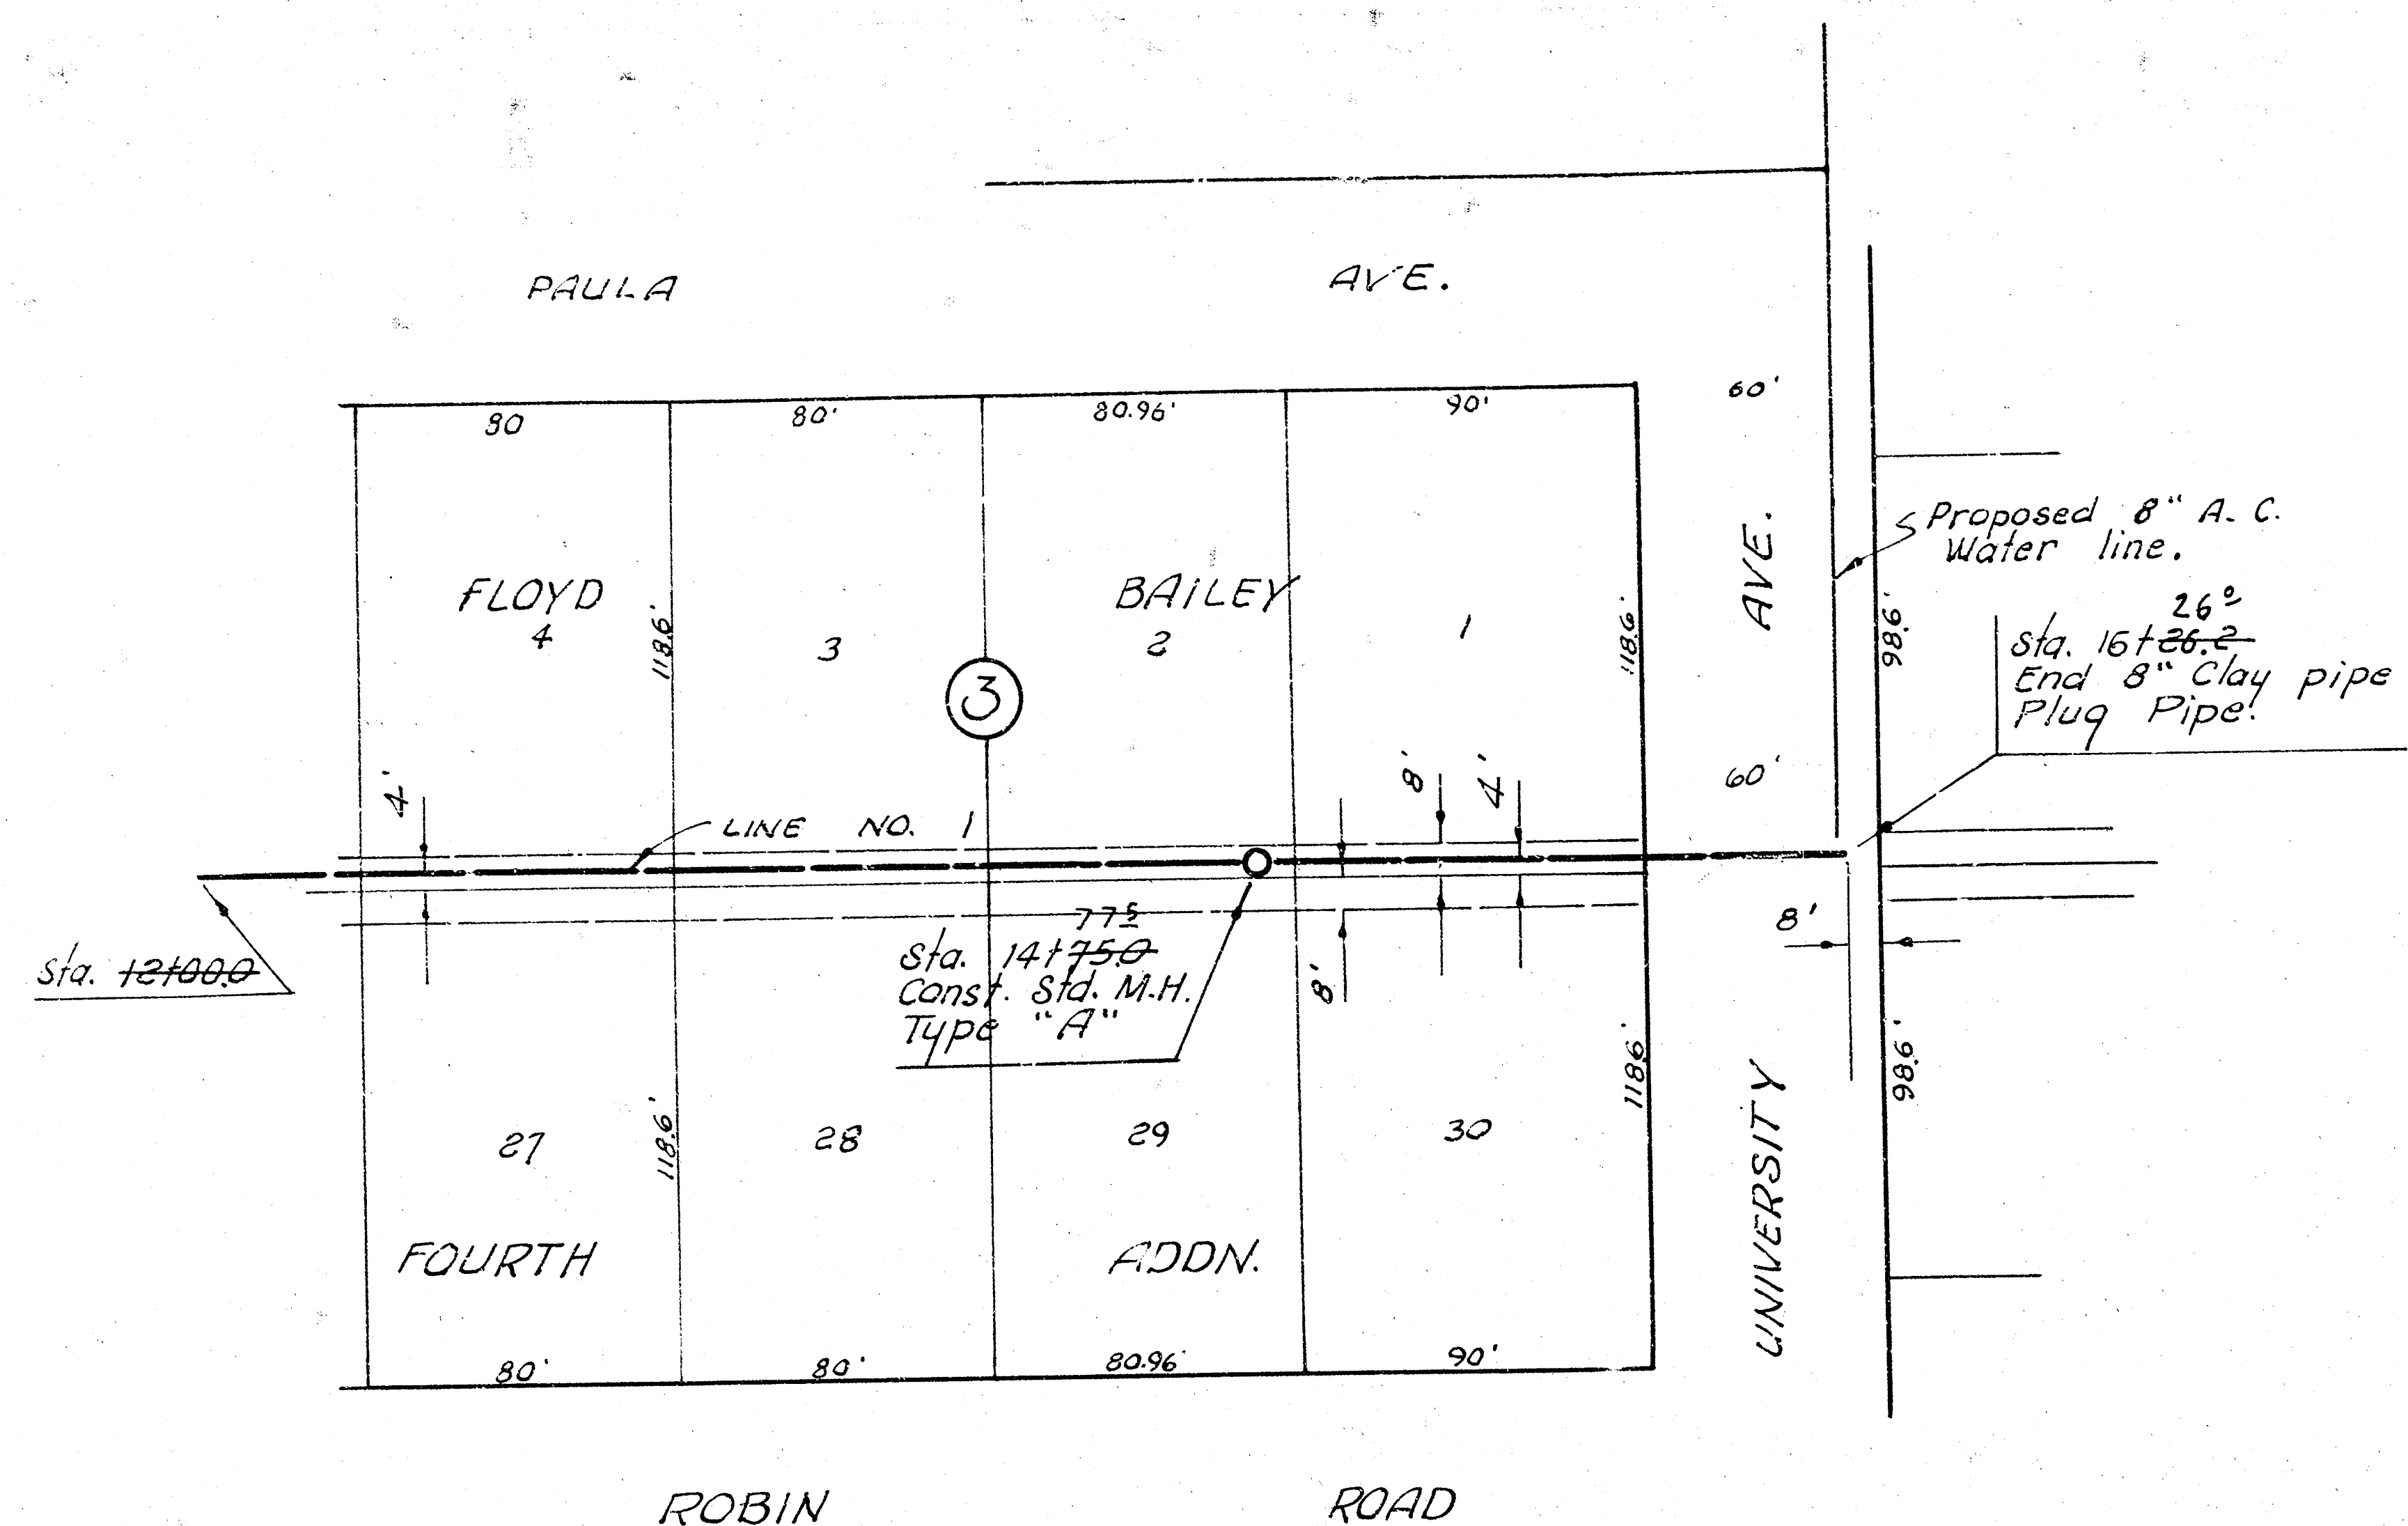

LAT. 7, S. W. MAIN
PROJECT NO. DBK L568030 3/4

