

NOTE TO CONTRACTOR
 This project will be constructed under the supervision of the CITY ENGINEER and conforming to the SPECIFICATIONS of the CITY OF WICHITA. The CONTRACTOR will reimburse the City of Wichita for all cost of ~~inspection~~ inspection.

3-10-80
 APPROVED AS NOTED
 By CITY ENGINEER OF WICHITA
 Sanitary Sewers
 Storm Sewers
 Driveway Approaches


BENCHMARK
 T.O.C. EL. 1514.25

FIN FLOOR EL. 22.0
 (22.0' - 1522.0')


MANHOLE #1 (TYPE 'A')
 T.O.C. = 1521.50
 F.L.H. = 1515.90
 F.L.O.V. = 1515.80

MANHOLE #2 (TYPE 'A')
 T.O.C. = 1520.35
 F.L.H. = 1515.20
 F.L.O.V. = 1515.10


EXIST. MANHOLE
 W/O SUB-CUT
 F.L. EL. 1514.62

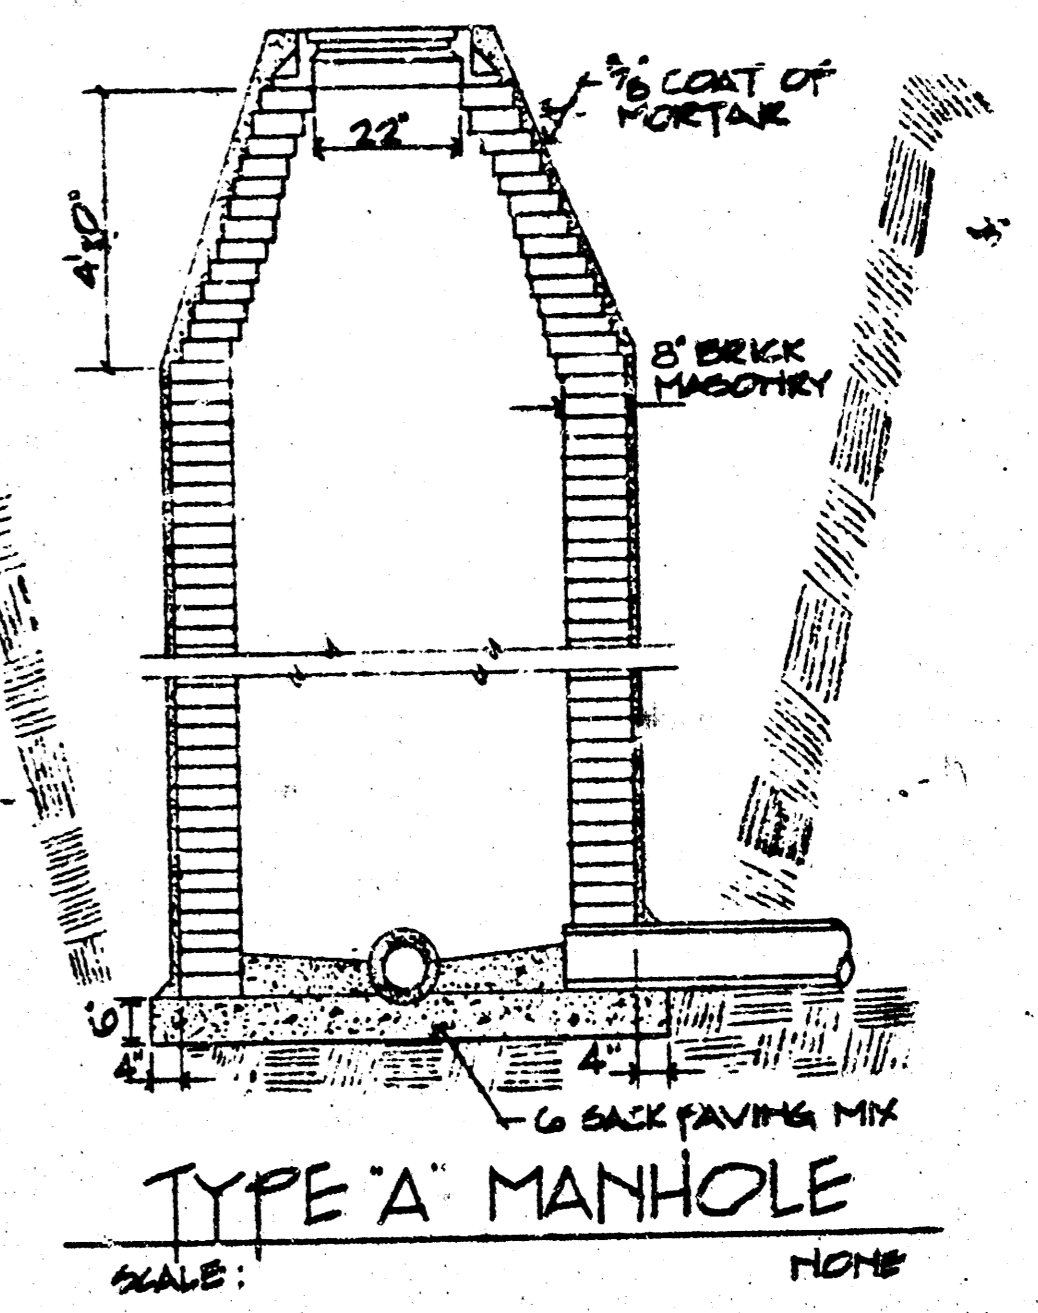

PLAN
 SCALE 1"=50'-0"

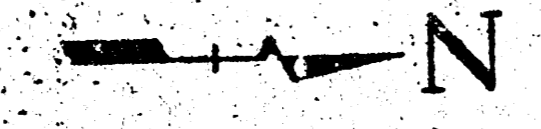

CITY OF WICHITA PROJECT NO: 46B-76-245-8091A-000-000-00B

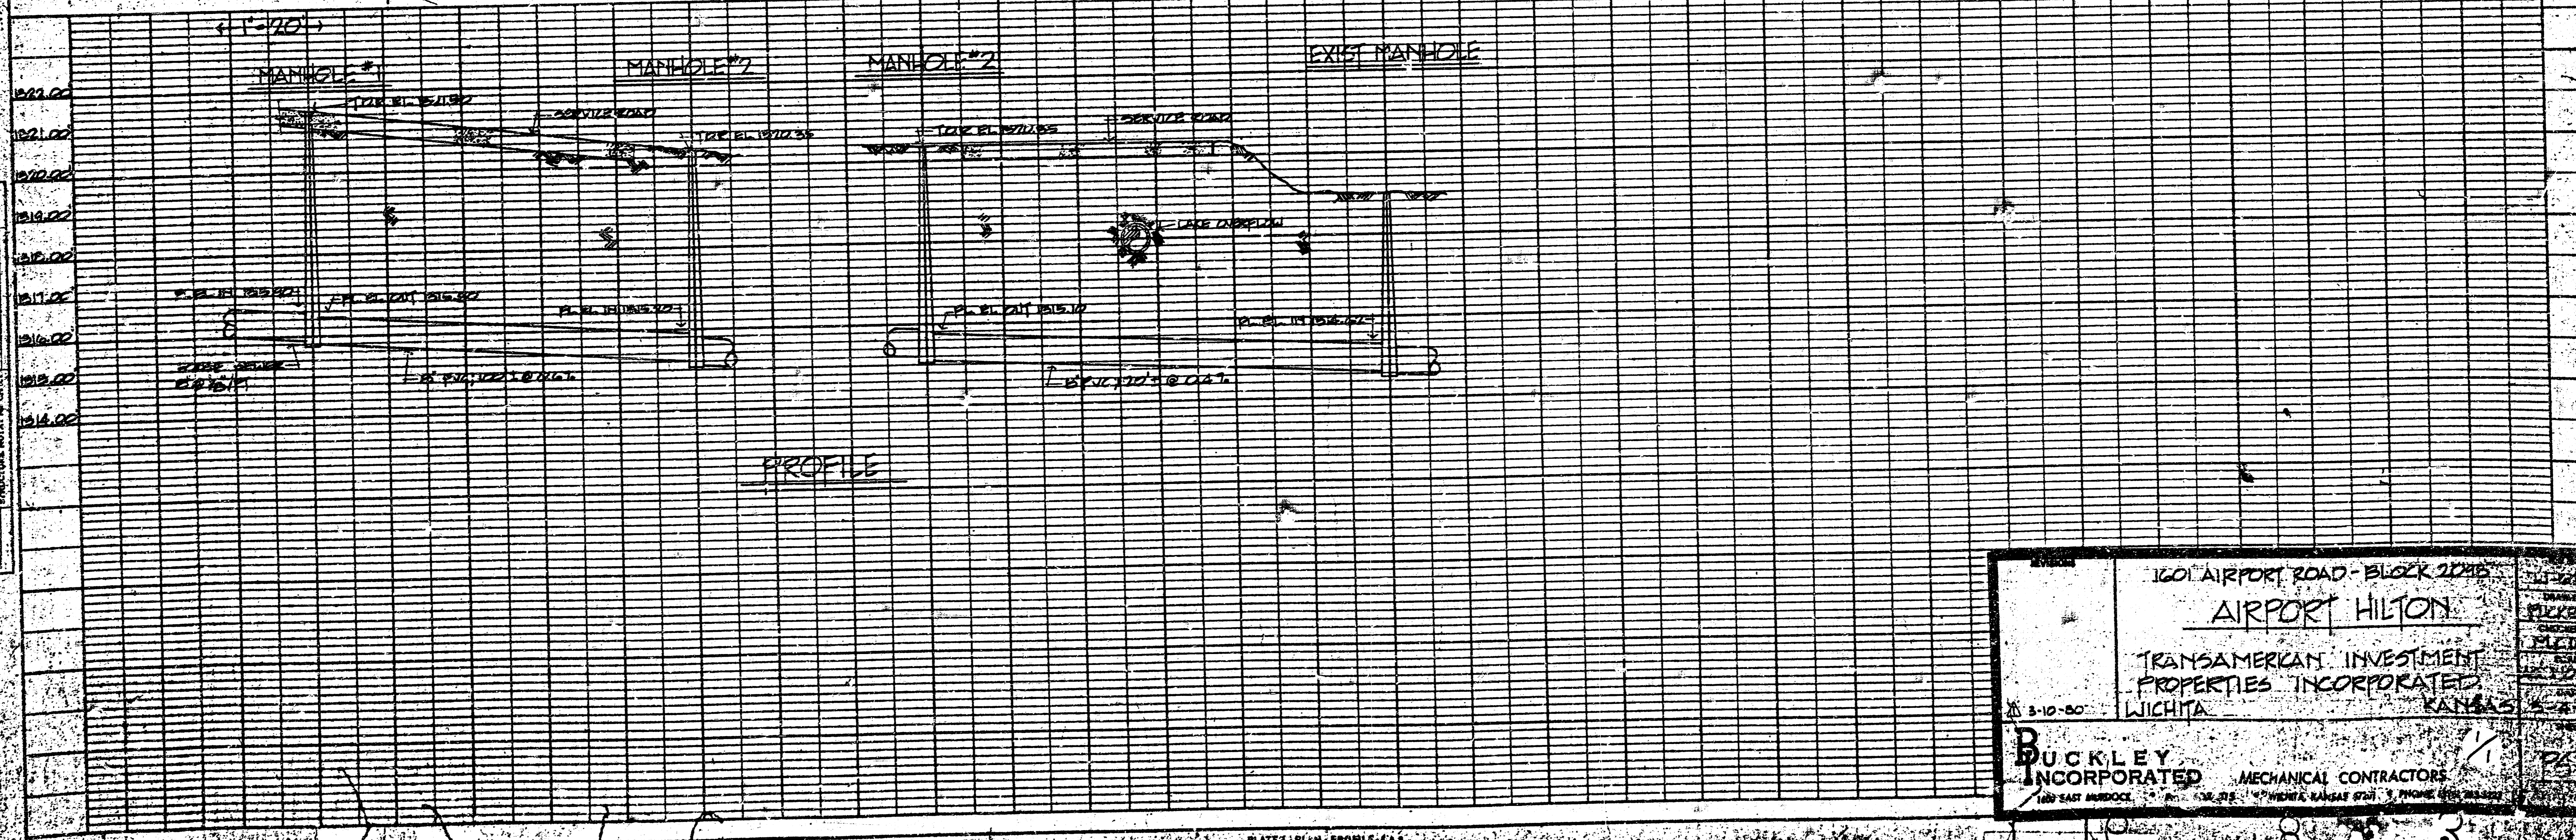

PROFILE

1601 AIRPORT ROAD - BLOCK 20415
 AIRPORT HILTON
 TRANSAMERICAN INVESTMENT
 PROPERTIES INCORPORATED
 WICHITA, KANSAS

3-10-80

BUCKLEY
 INCORPORATED
 MECHANICAL CONTRACTORS
 120 EAST HARDOCK ST. WICHITA, KANSAS 67202

PLATE: PLAN - PROFILE - SANITARY SEWERS - 1/2\"/>