

- Contractor will be required to provide notice to utility companies a minimum of twenty-four (24) hours prior to any excavation, as follows:
Kansas One-Call 687-2470
The Contractor must notify the following in case of an emergency:


Cablevision 262-4270
or
K.P.L. Gas Service Company 263-2061
Kansas Gas & Electric Company 264-1141
Arkio Gas Company 942-3350
Southwestern Bell Telephone Company 263-8161
City of Wichita Water Department 1-571-2611
City of Wichita Sewer Maintenance 268-4908
268-4071

- Properties within the project limits may have underground sprinkler systems in public right-of-way which conflict with new construction. Contractor will be required to remove such improvements should they not be removed by their owner at the time of construction of the project. The Contractor will be required to salvage all sprinkler heads and/or valves and give such material to their owner. Portions of underground sprinkler systems not in conflict with new construction shall be protected from damage and shall remain in place. All work in connection with underground sprinkler systems shall be considered as subsidiary to the contract pay items of work.


- Underground utility service lines and overhead utility pole lines are to be adjusted as necessary by others prior to construction unless the plans specifically call for their adjustment by the Contractor or unless the plans specifically identify a utility to be adjusted by its owner during construction. Existing utilities and their location, as shown on the plans, represent the best information obtainable for design. The Contractor will be required to work around existing utilities within the right-of-way which do not conflict with proposed construction.

- The Contractor shall give all property owners and/or tenants of developed property abutting the construction of this project a minimum of ten (10) days advance notice prior to start of construction.


- The Contractor shall be responsible for maintaining continuous flow of sewage through construction. Contractor's proposed method for maintaining sewage flow shall be approved by the Engineer. Cost of maintaining flow of sewage through construction will not be paid for directly and this cost shall be considered as subsidiary to the other pay items of work.

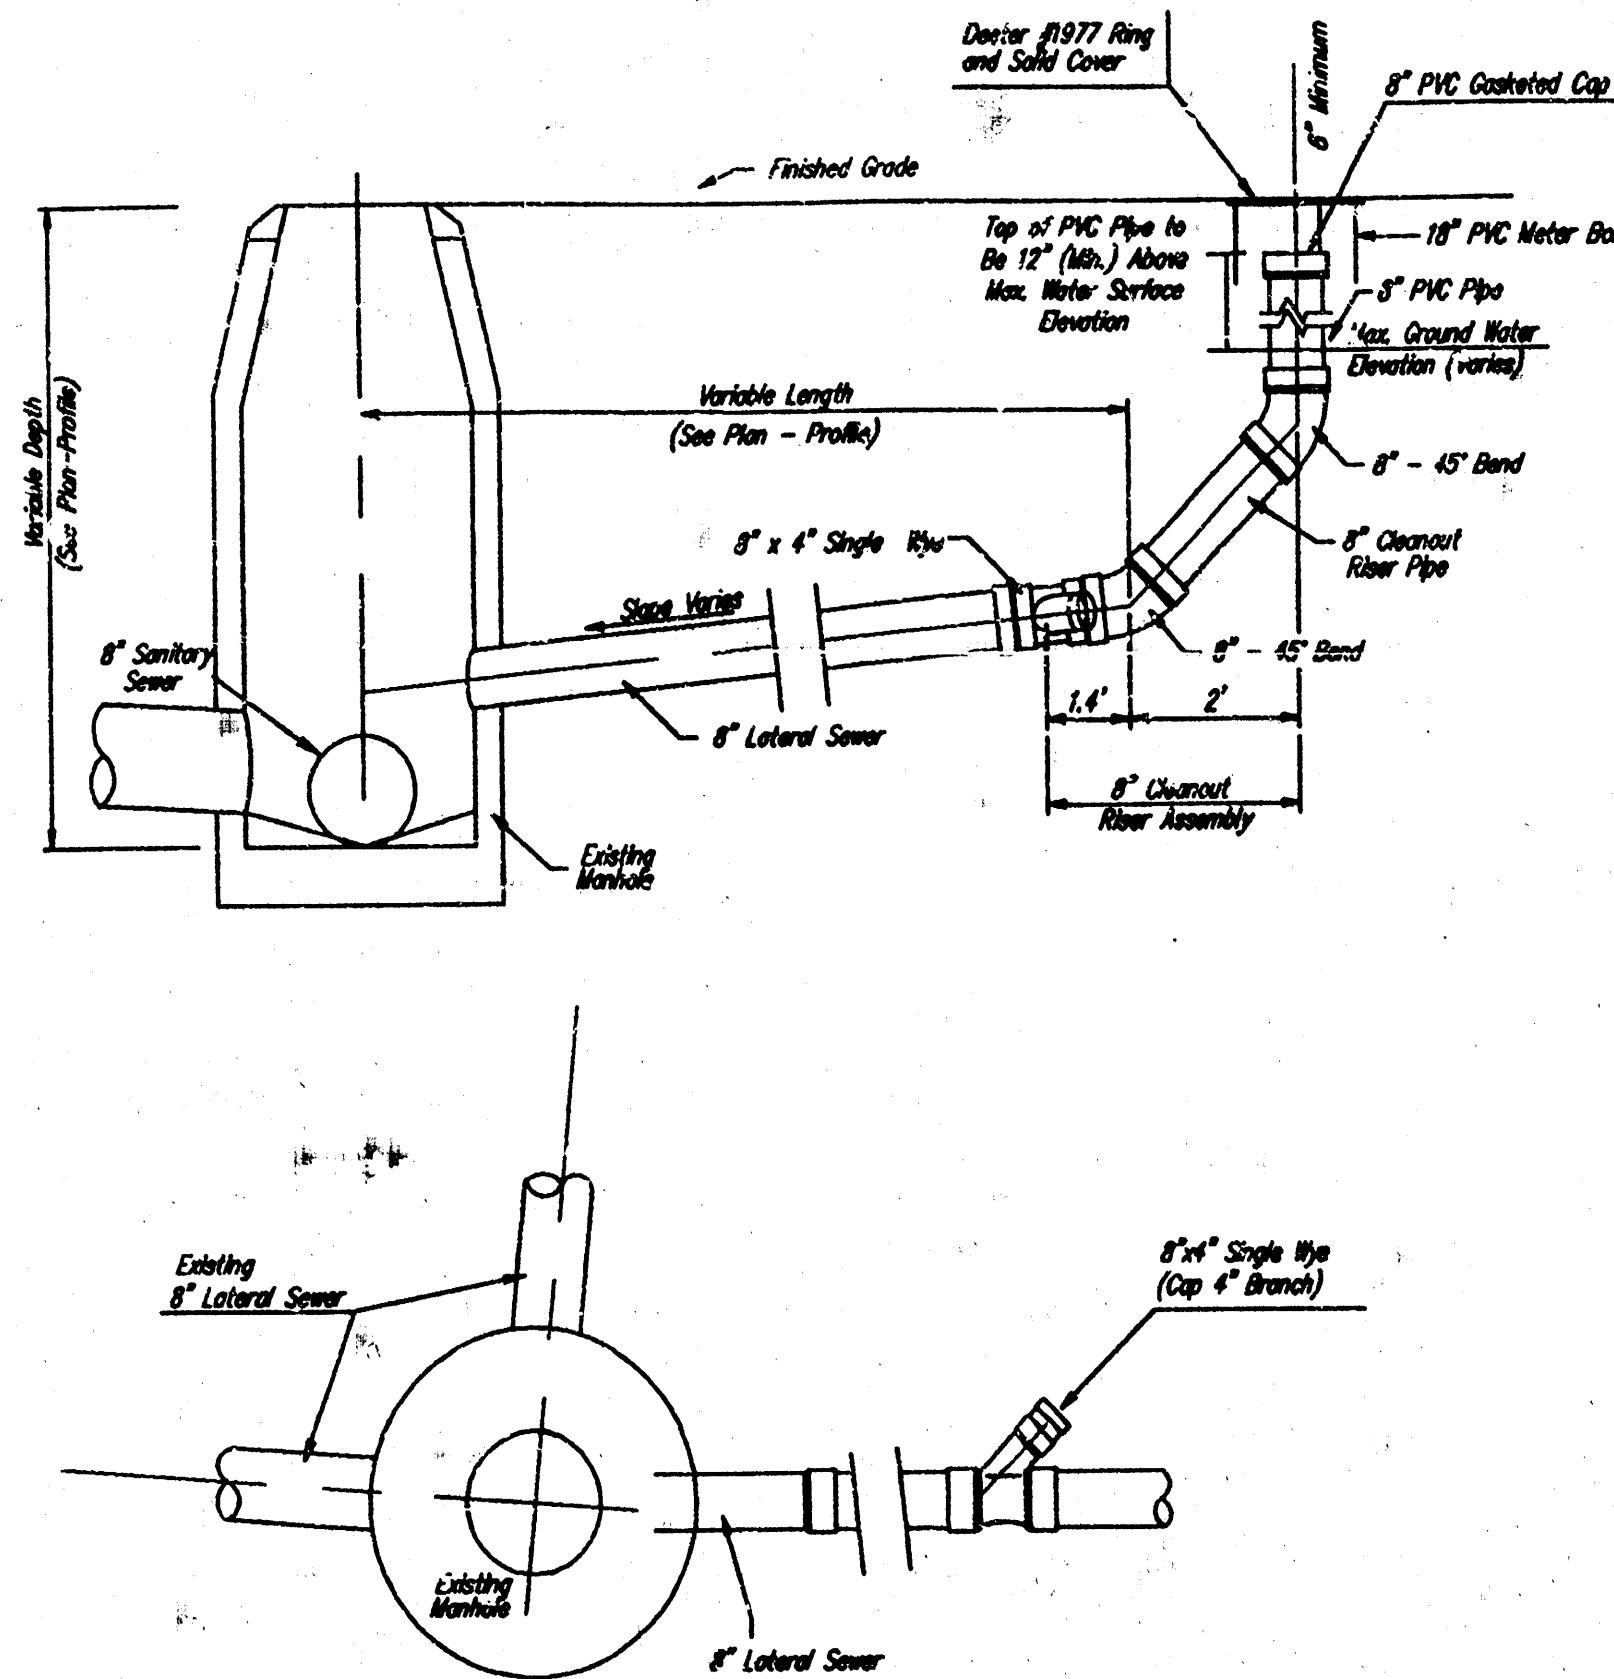


8" CLEANOUT RISER ASSEMBLY DETAIL
W/ MANHOLE CONNECTION

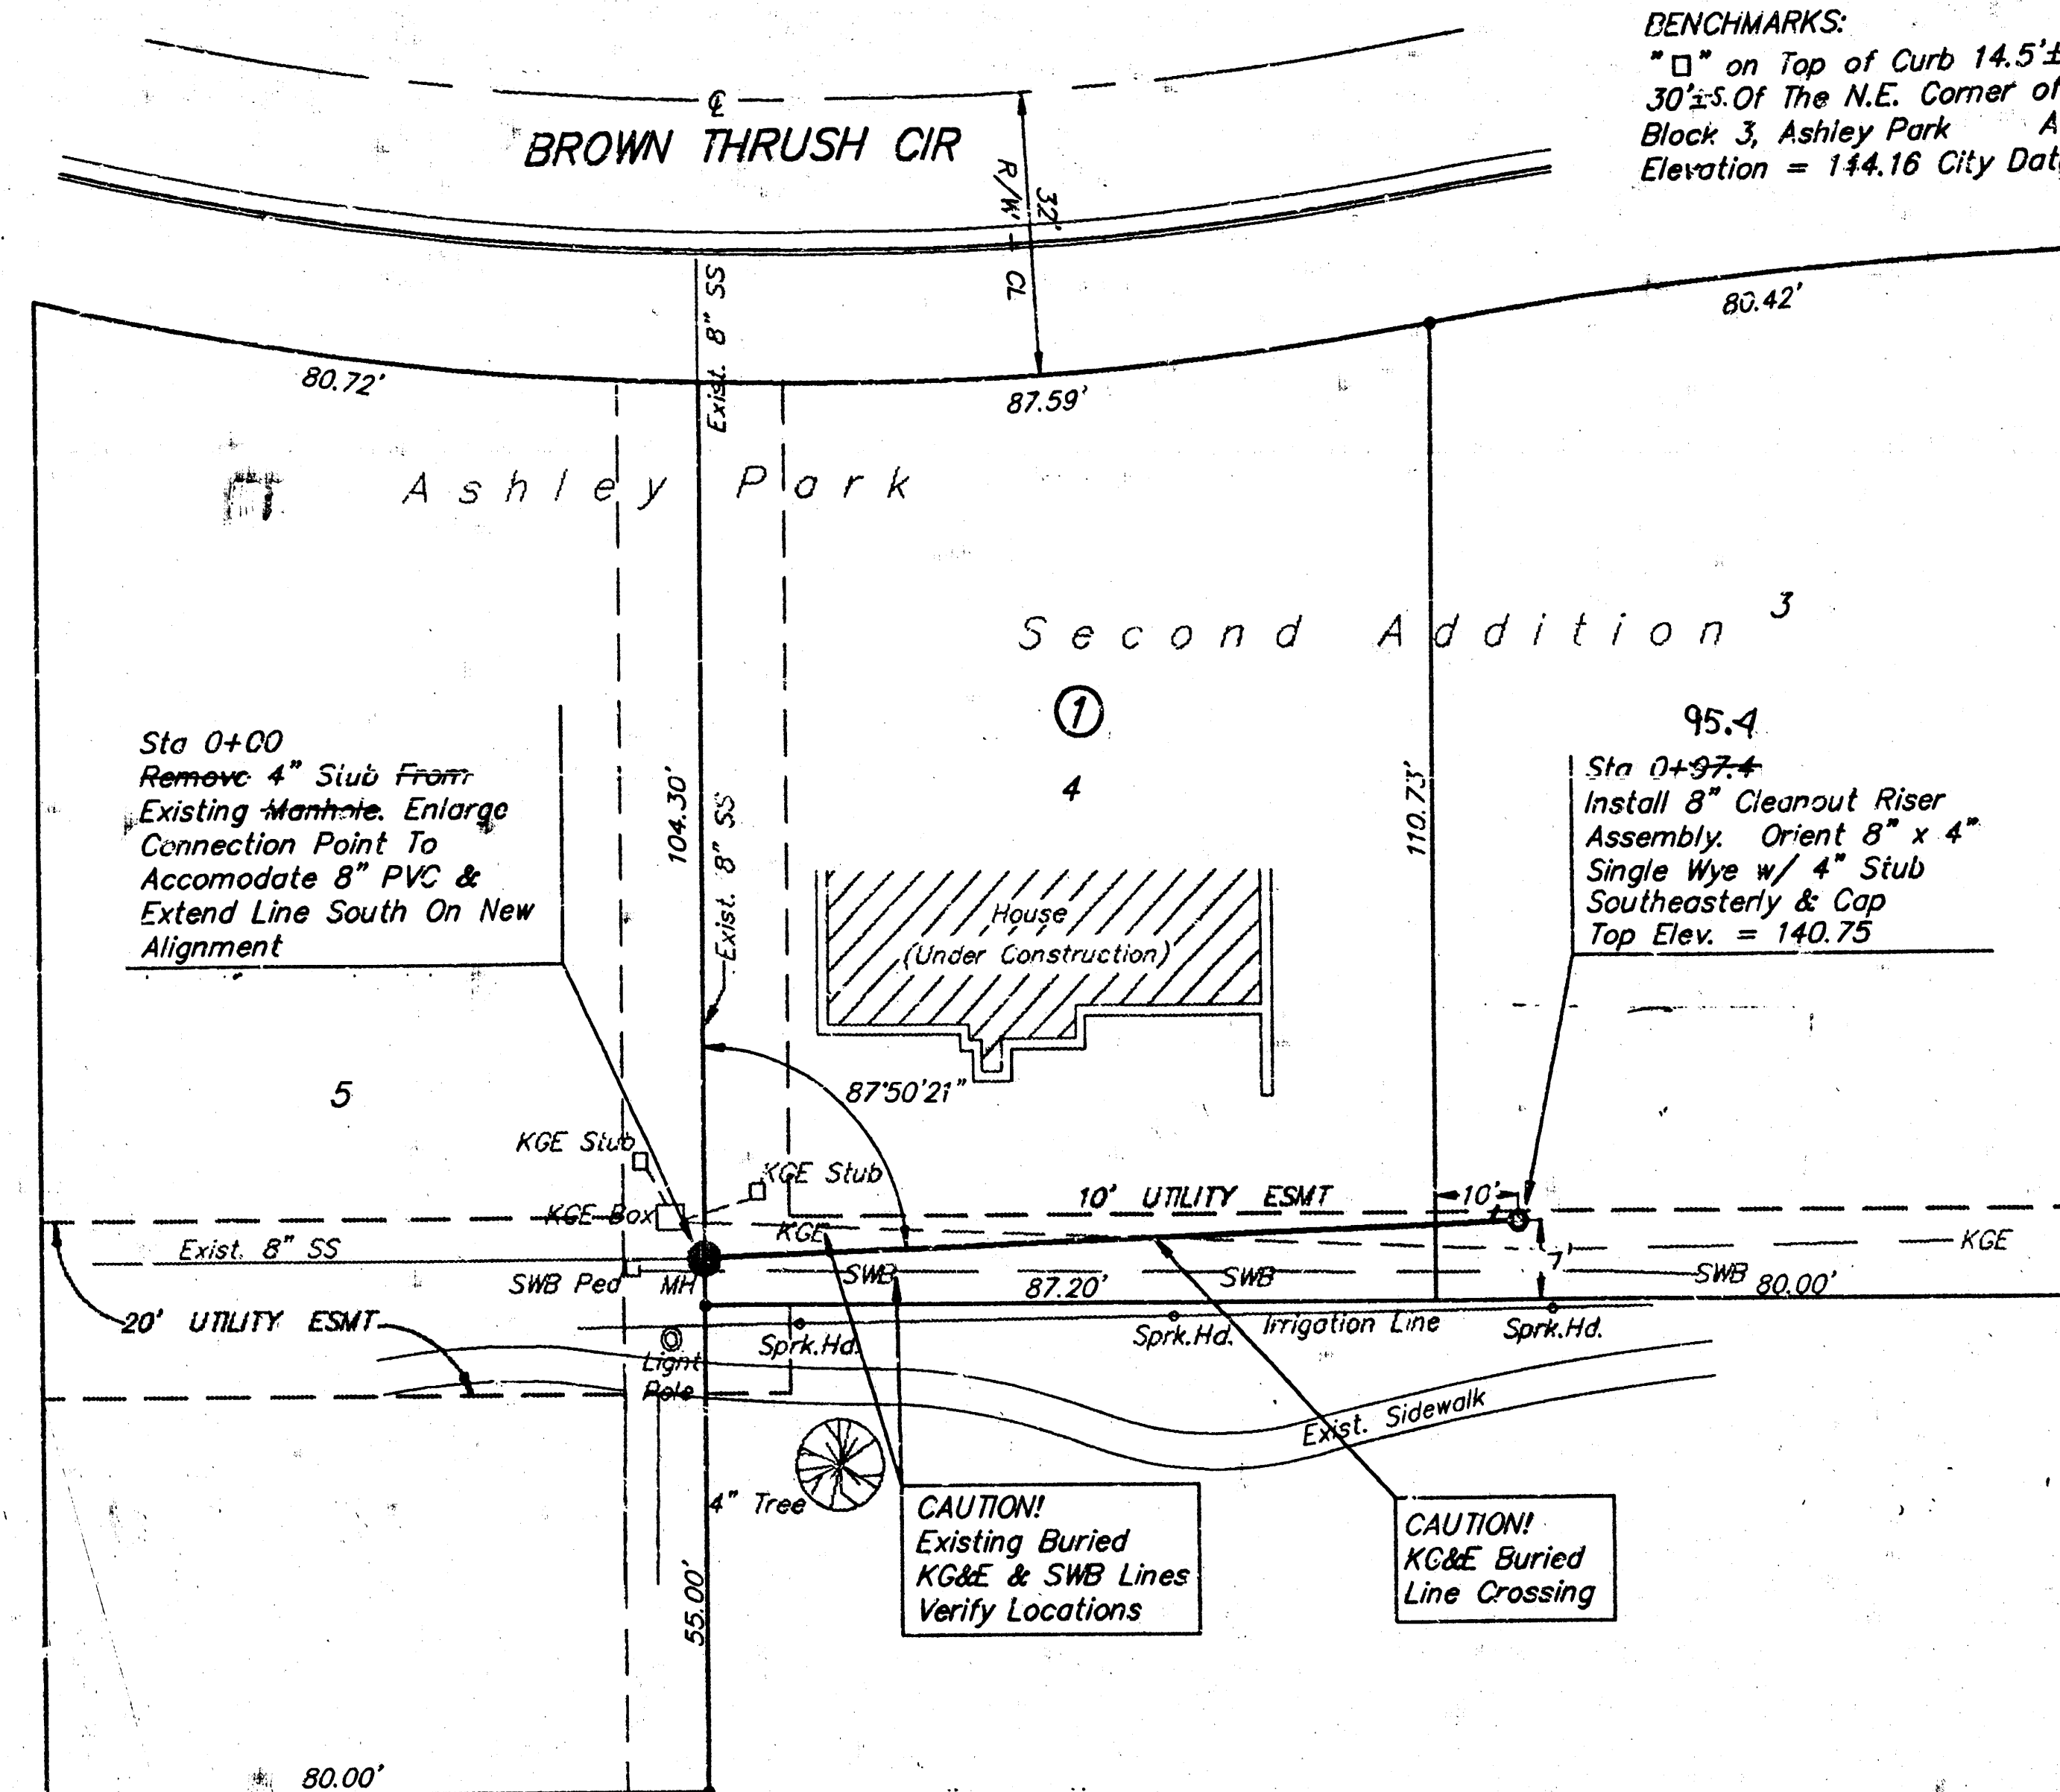

BENCHMARKS:
"B" on Top of Curb 14.5' E. &
30' S. of The N.E. Corner of Lot 17,
Block 3, Ashley Park Addition.
Elevation = 144.16 City Datum

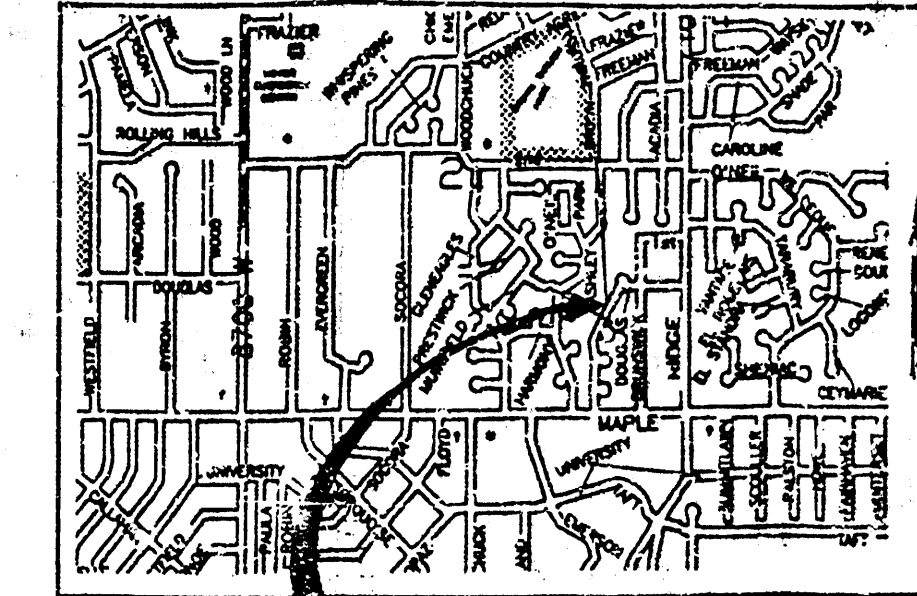

Site Location

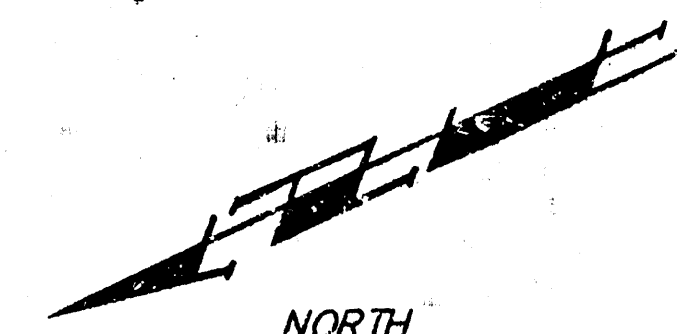

NORTH

SCALE:
1" = 20' Horiz.
1" = 5' Vert.
1" = 1'0"

APPROVED AS NOTED
BY CITY ENGINEER OF WICHITA

Sanitary Sewers VRH 11/4/93

Storm Sewers


Driveway Approaches

Water Mains

Paving

NOTE TO CONTRACTORS

Inspection and testing for this project is to be provided by a Licensed Consulting Engineering Firm under contract with the Owner/Developer. Solid inspection to be in accordance with the City of Wichita standard construction engineering practices and certified by a Licensed Professional Engineer. No work shall be performed in dedicated easements or public right-of-way by the Contractor without such inspection nor shall any work be commenced without written authorization by the City Engineer.

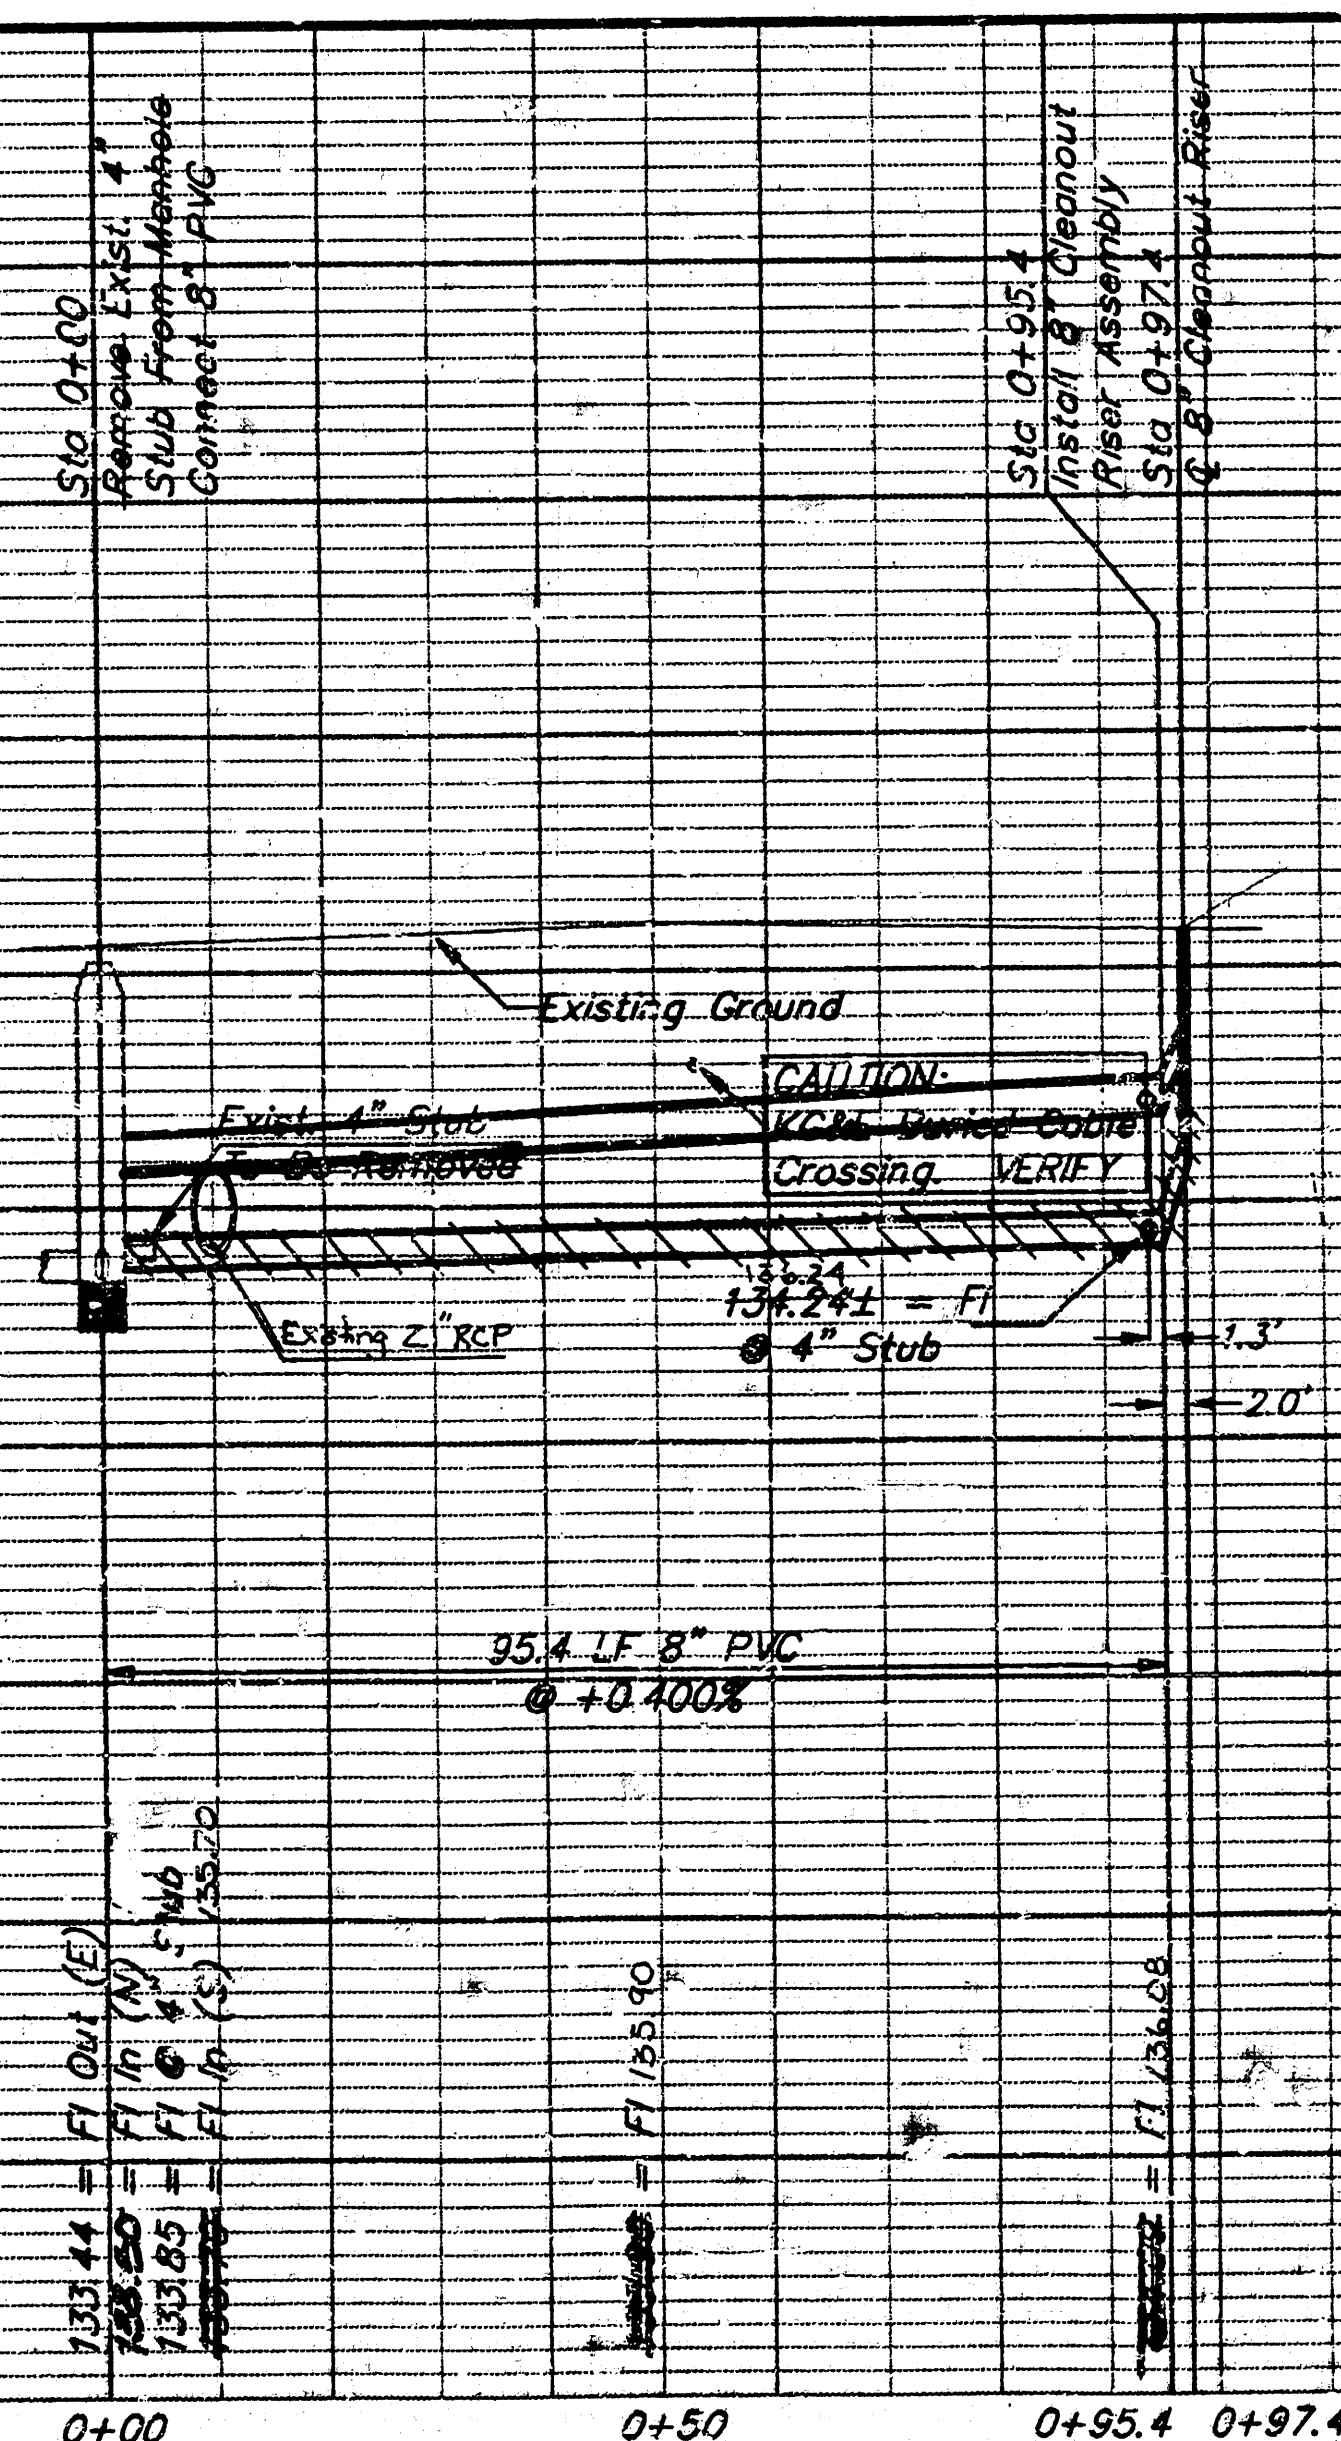


AS BUILT 11-29-93

SANITARY SEWER EXTENSION TO SERVE
ASHLEY PARK II - LOT 3, BLK 1

BAUGHMAN COMPANY P. A.
ENGINEERING & SURVEYING
316/262-7271 • 315 ELUS • WICHITA, KANSAS 67211

PROJECT NUMBER
118:PPS (607861)

DESIGN: NW/DY DRAWN: DY UTIL CHECK: DATE: Sept. 20, 1993 SCALE: NOTED

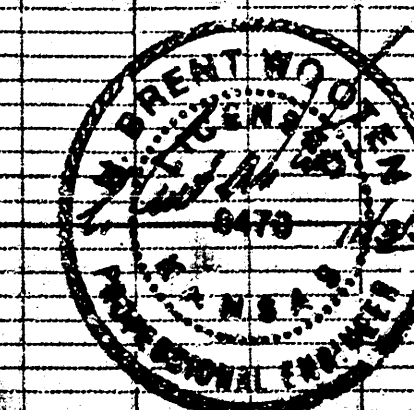

SHEET 1 OF 1