


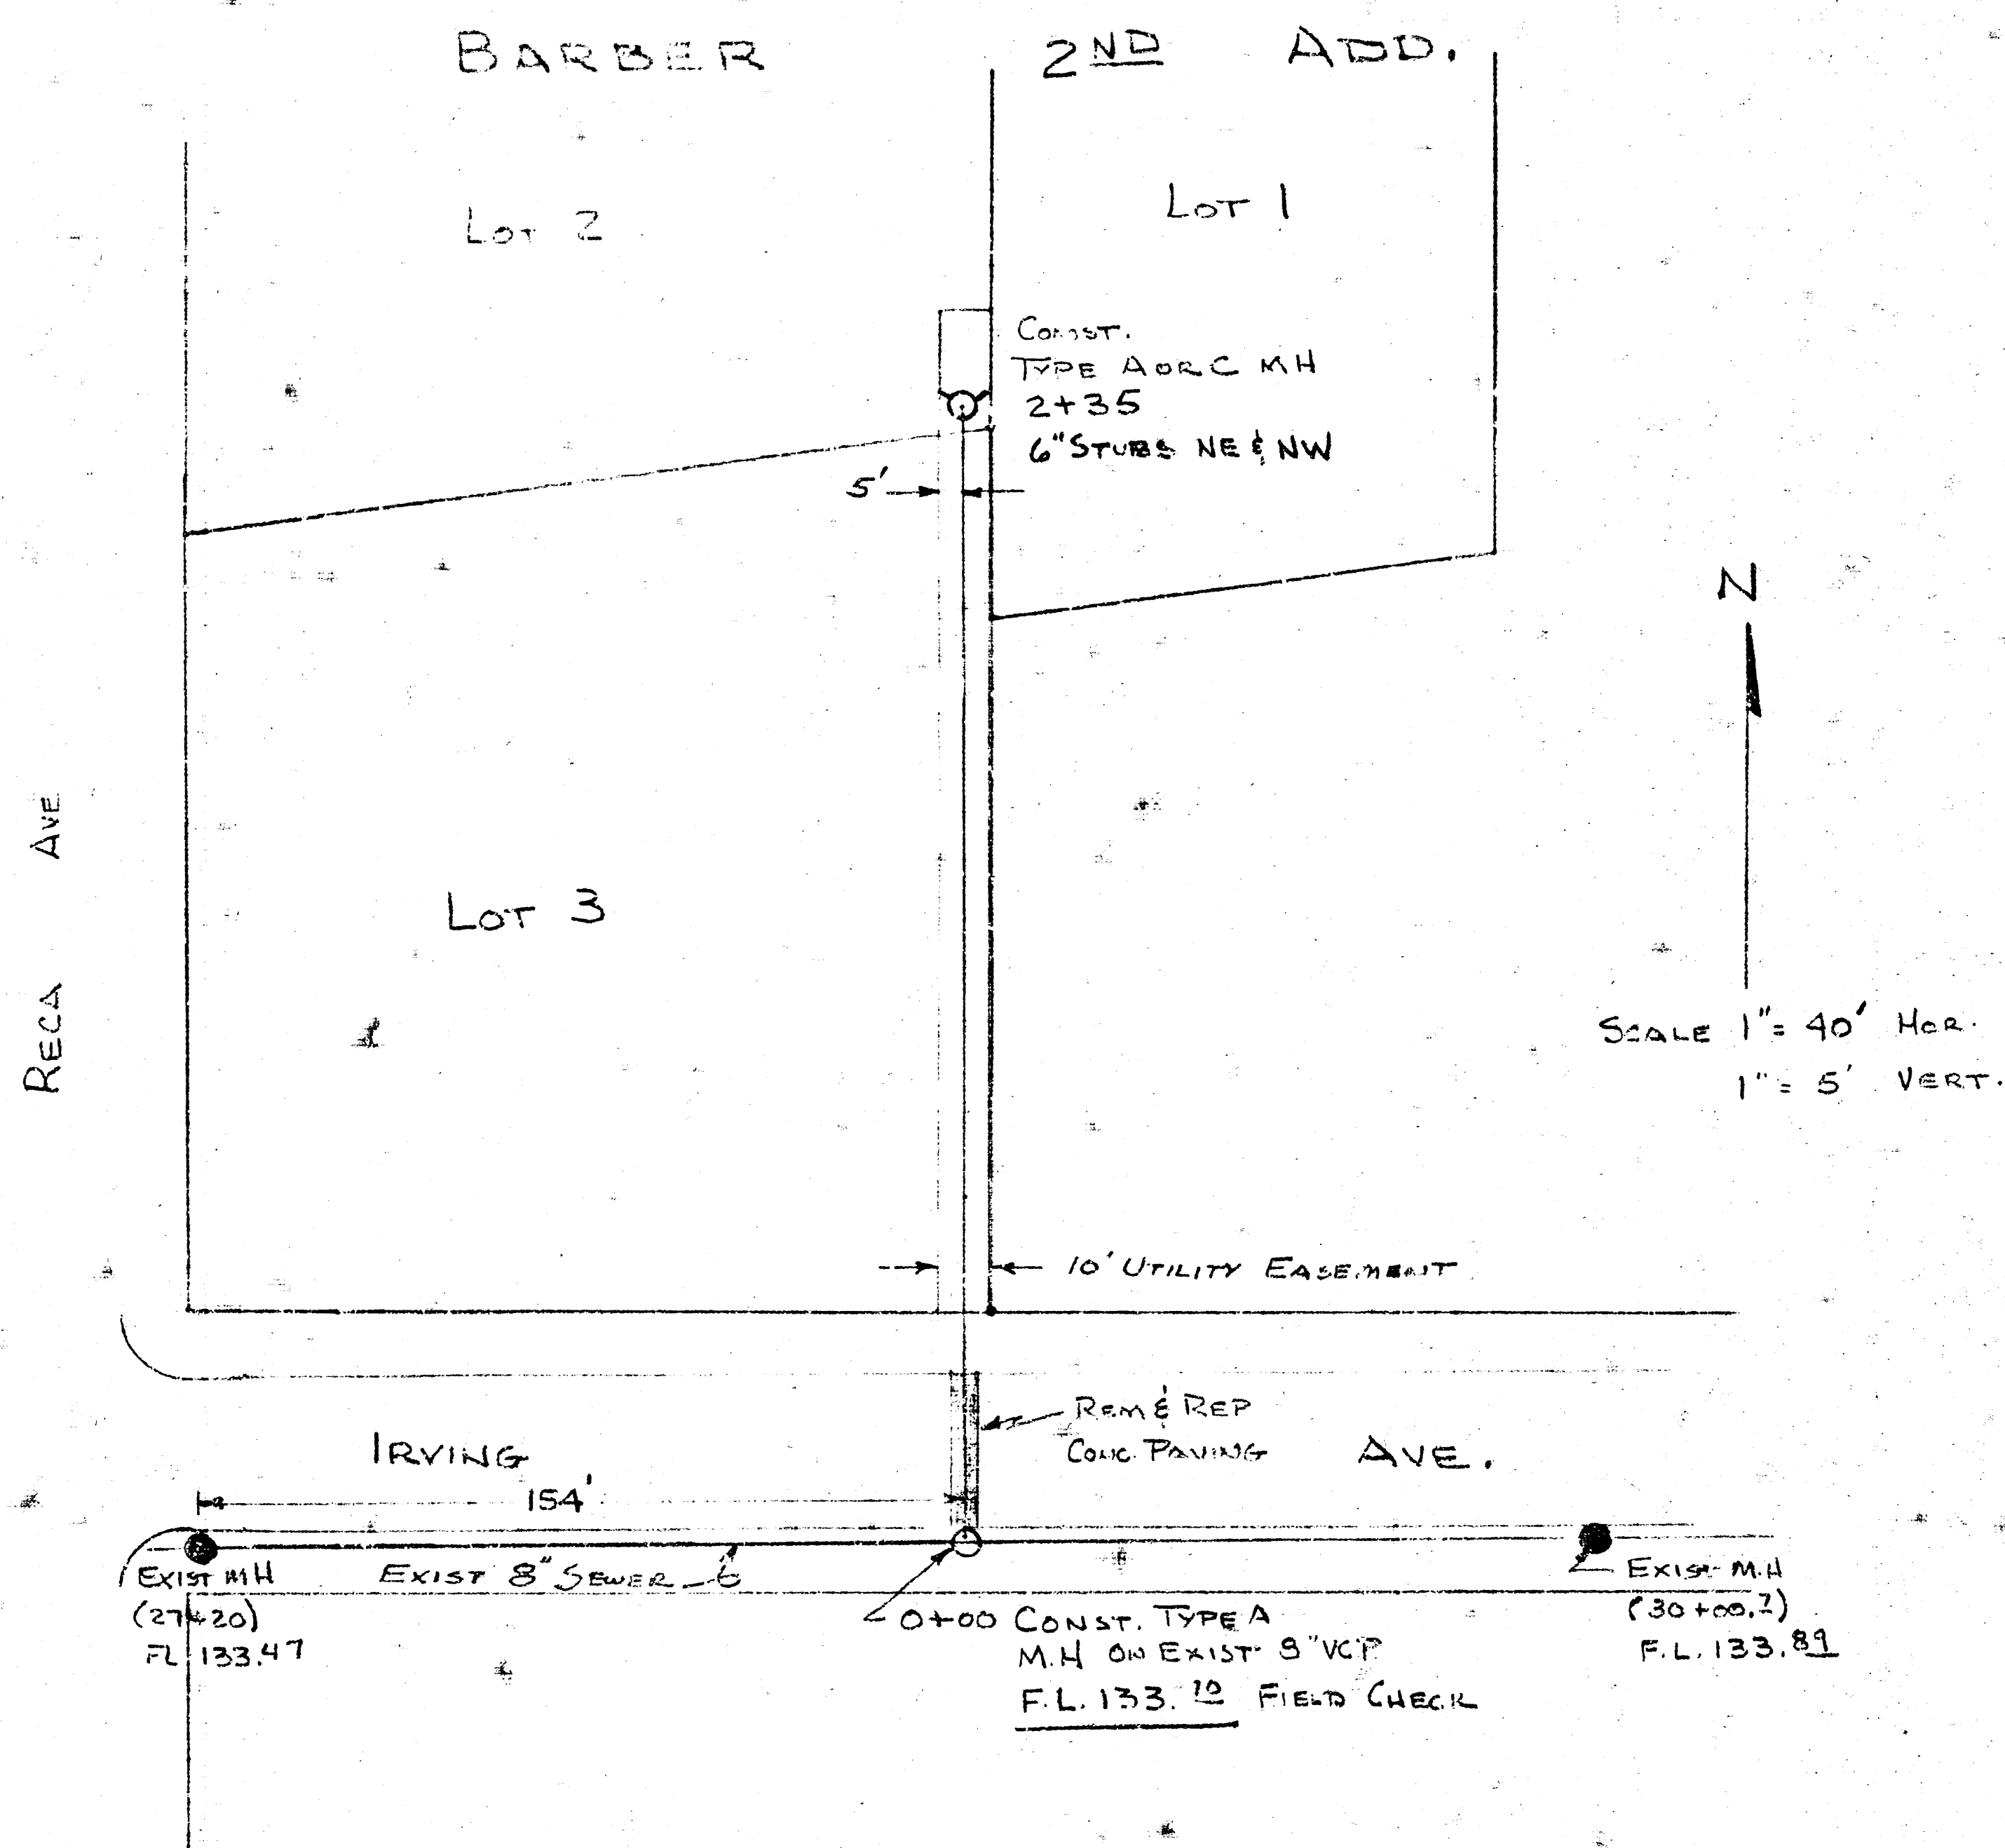


NOTE TO CONTRACTOR
 This project will be constructed under the supervision of the CITY ENGINEER and conforming to the SPECIFICATIONS of the CITY OF WICHITA. The CONTRACTOR will reimburse the City of Wichita for all cost of ~~engineering~~ and inspection.

N
 SCALE 1" = 40' HOR.
 1" = 5' VERT.

11-10-75
APPROVED AS NOTED
 By CITY ENGINEER OF WICHITA
 Sanitary Sewers D.E.S.
 Storm Sewers _____
 Driveway Approaches _____

DATE	BY
11/10/75	DAV
DATE	BY
DATE	BY
DATE	BY
DATE	BY

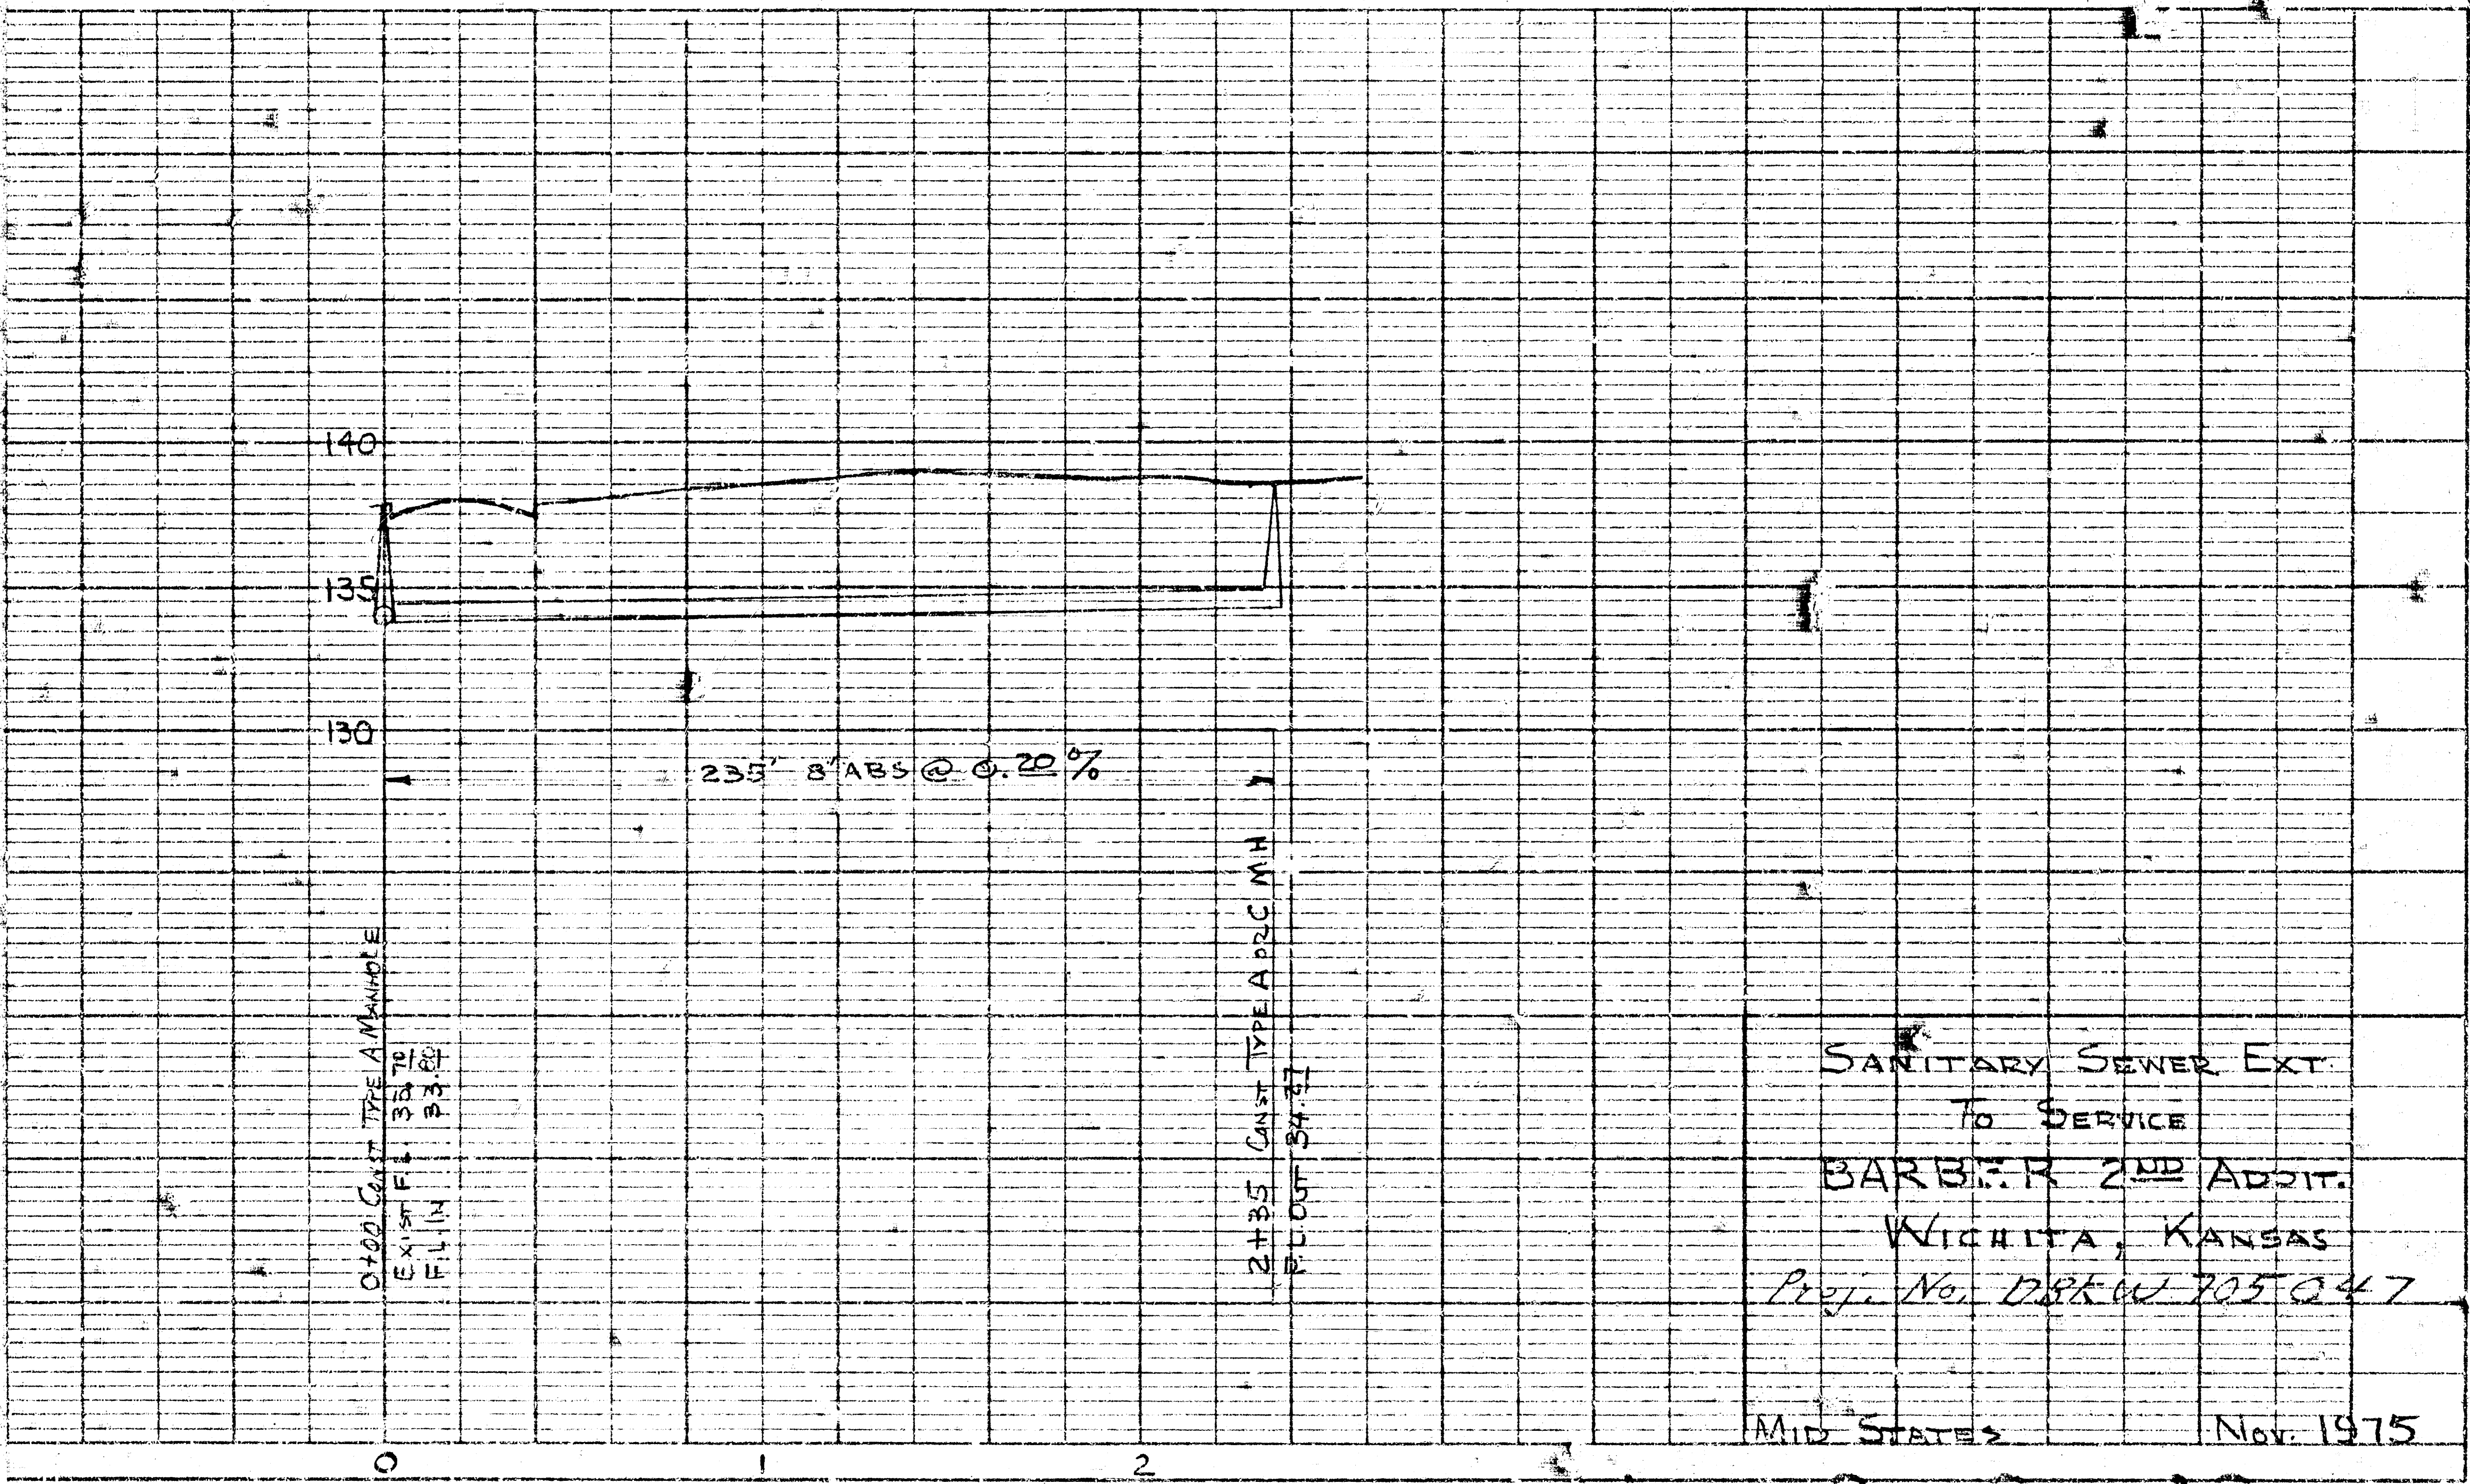

SANITARY SEWER EXT.
 TO SERVICE
 BARBER 2ND ADD.
 WICHITA, KANSAS
 Proj. No. D&W 105047

MID-STATE 8 3 13
 Nov. 1975

DATE	BY
11/10/75	DAV
DATE	BY
DATE	BY
DATE	BY
DATE	BY