



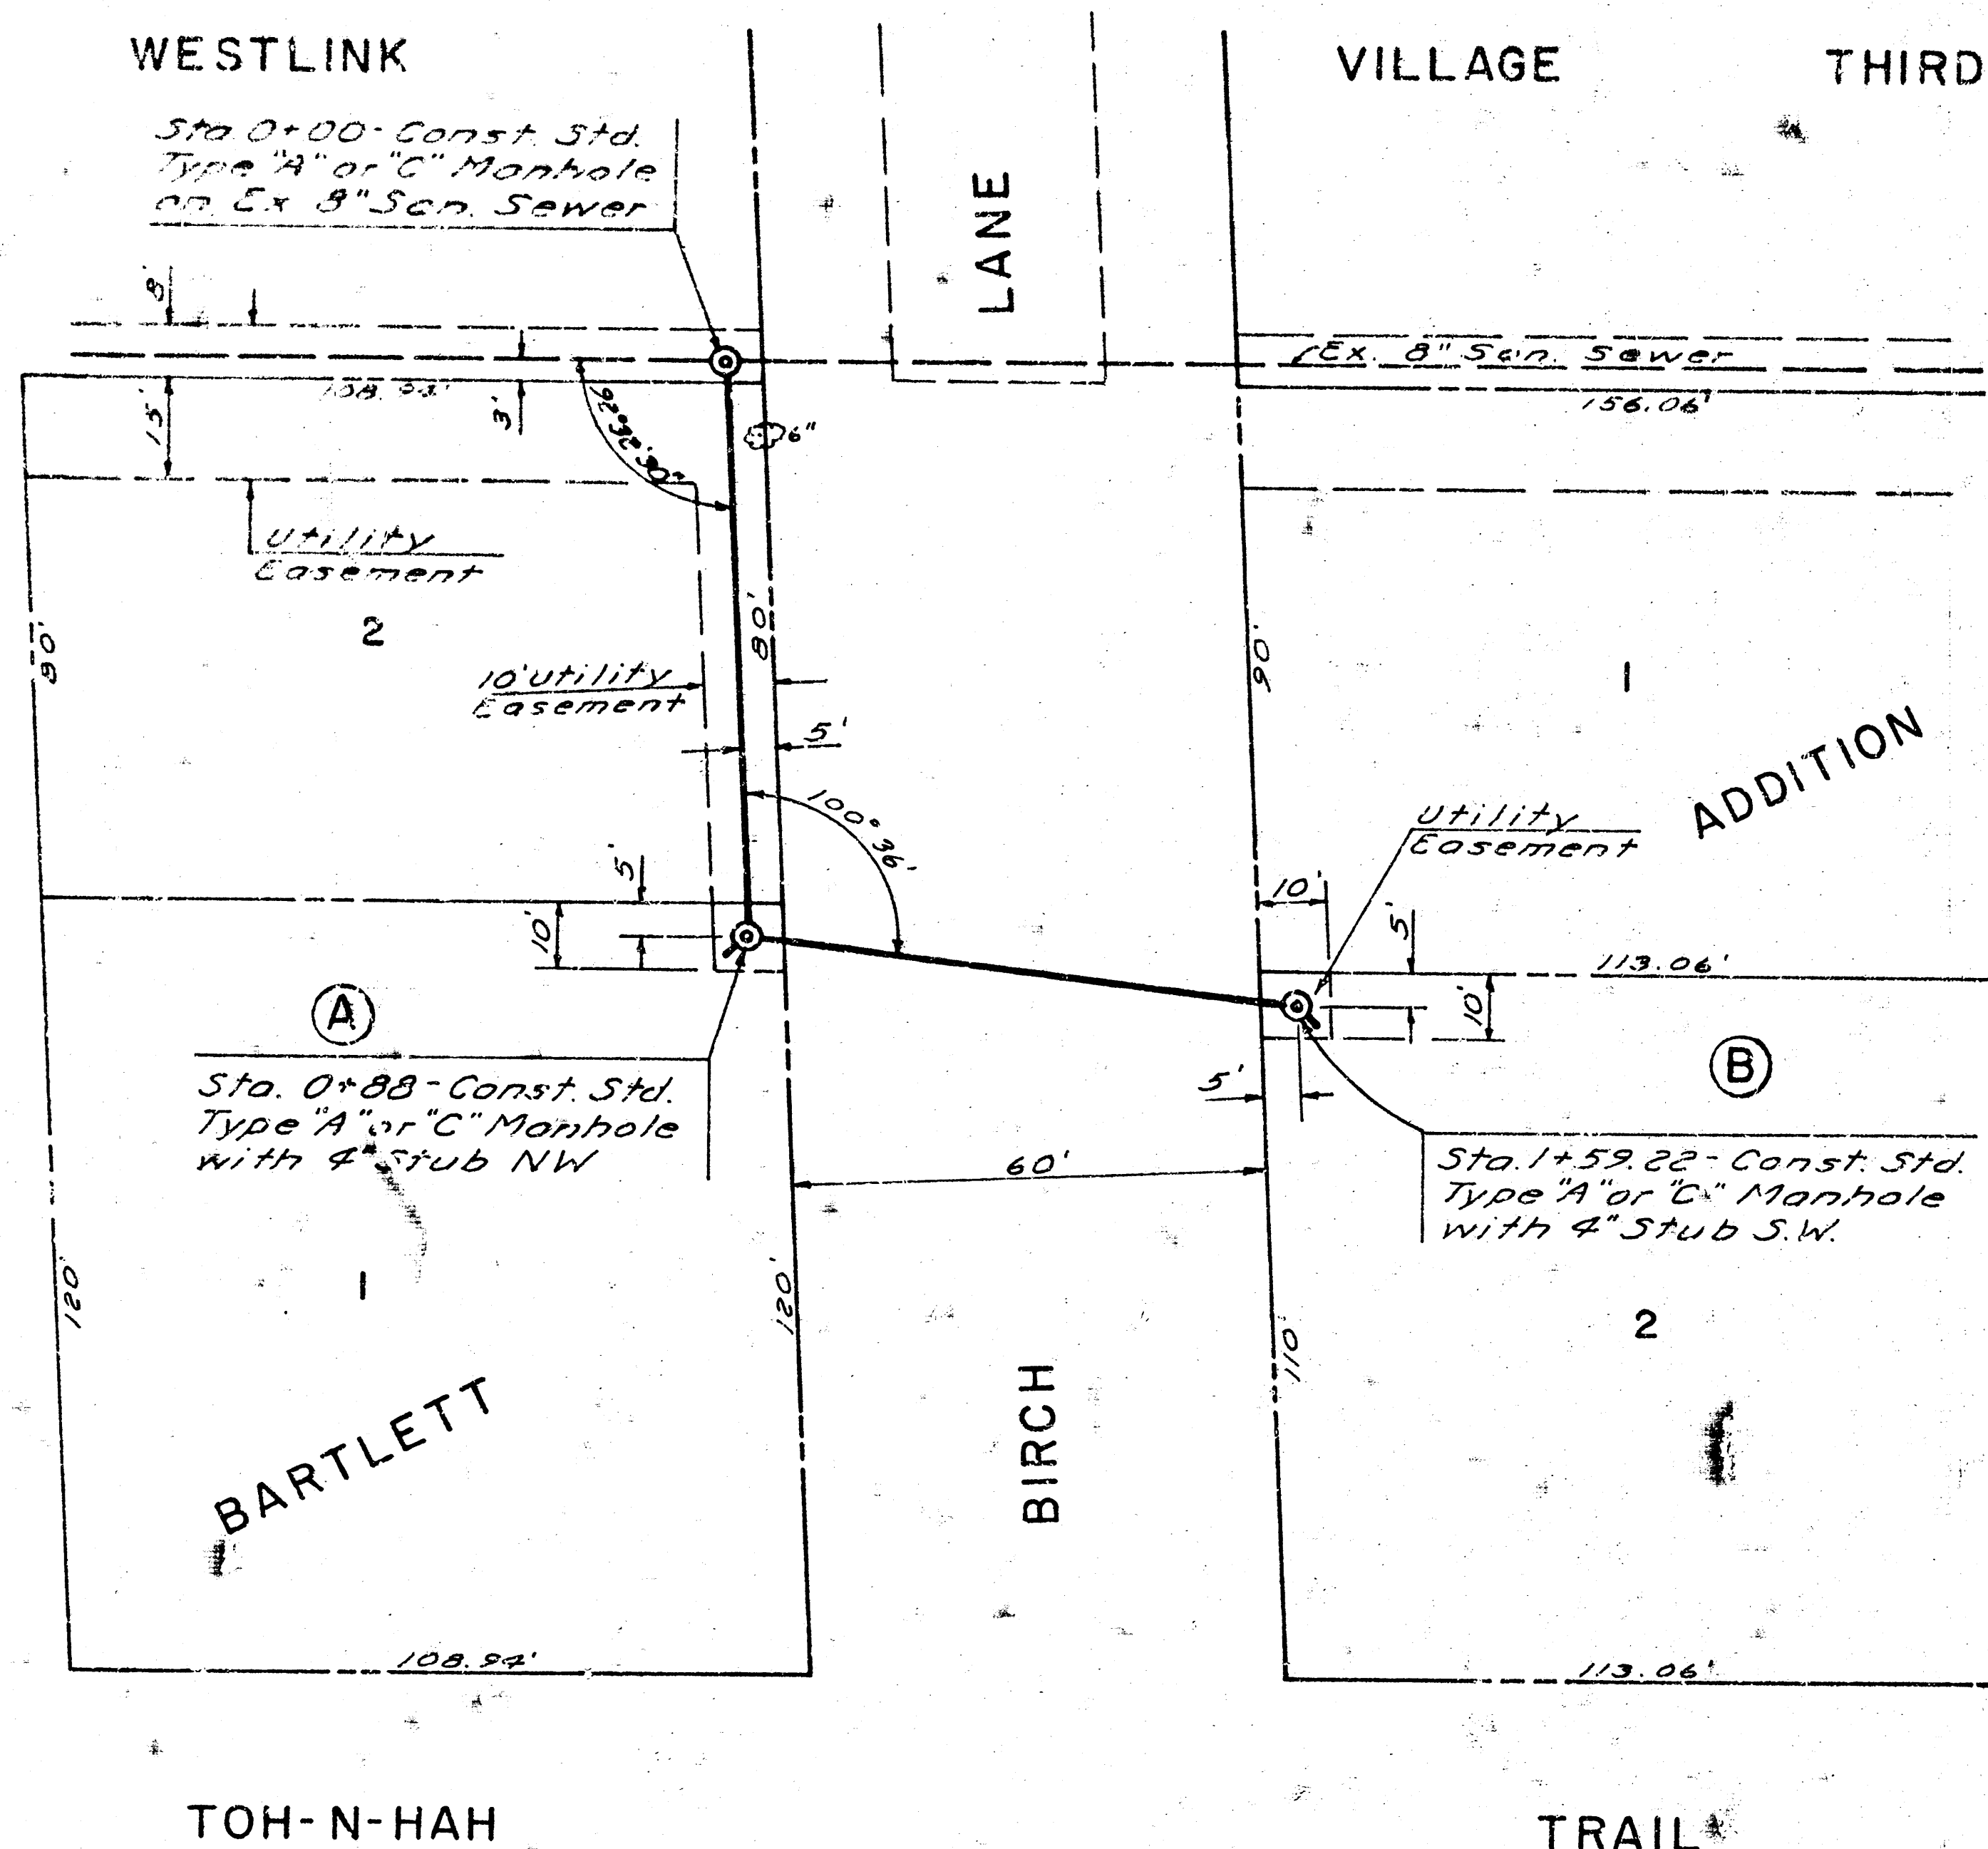

Scale: 1" = 30'
5-26-77
APPROVED AS NOTED
By CITY ENGINEER OF WICHITA
Sanitary Sewers O.E.S.
Storm Sewers _____
Driveway Approaches _____

NOTE TO CONTRACTOR
This project will be constructed under the supervision of the CITY ENGINEER and conforming to the specifications of the CITY OF WICHITA. The CONTRACTOR will be responsible for the City of Wichita for all cost of engineering, plans and inspection.

B.M. "X" on E. hub guard NE Cor. Culvert 1700' N. & Central & Main - El. 157.03

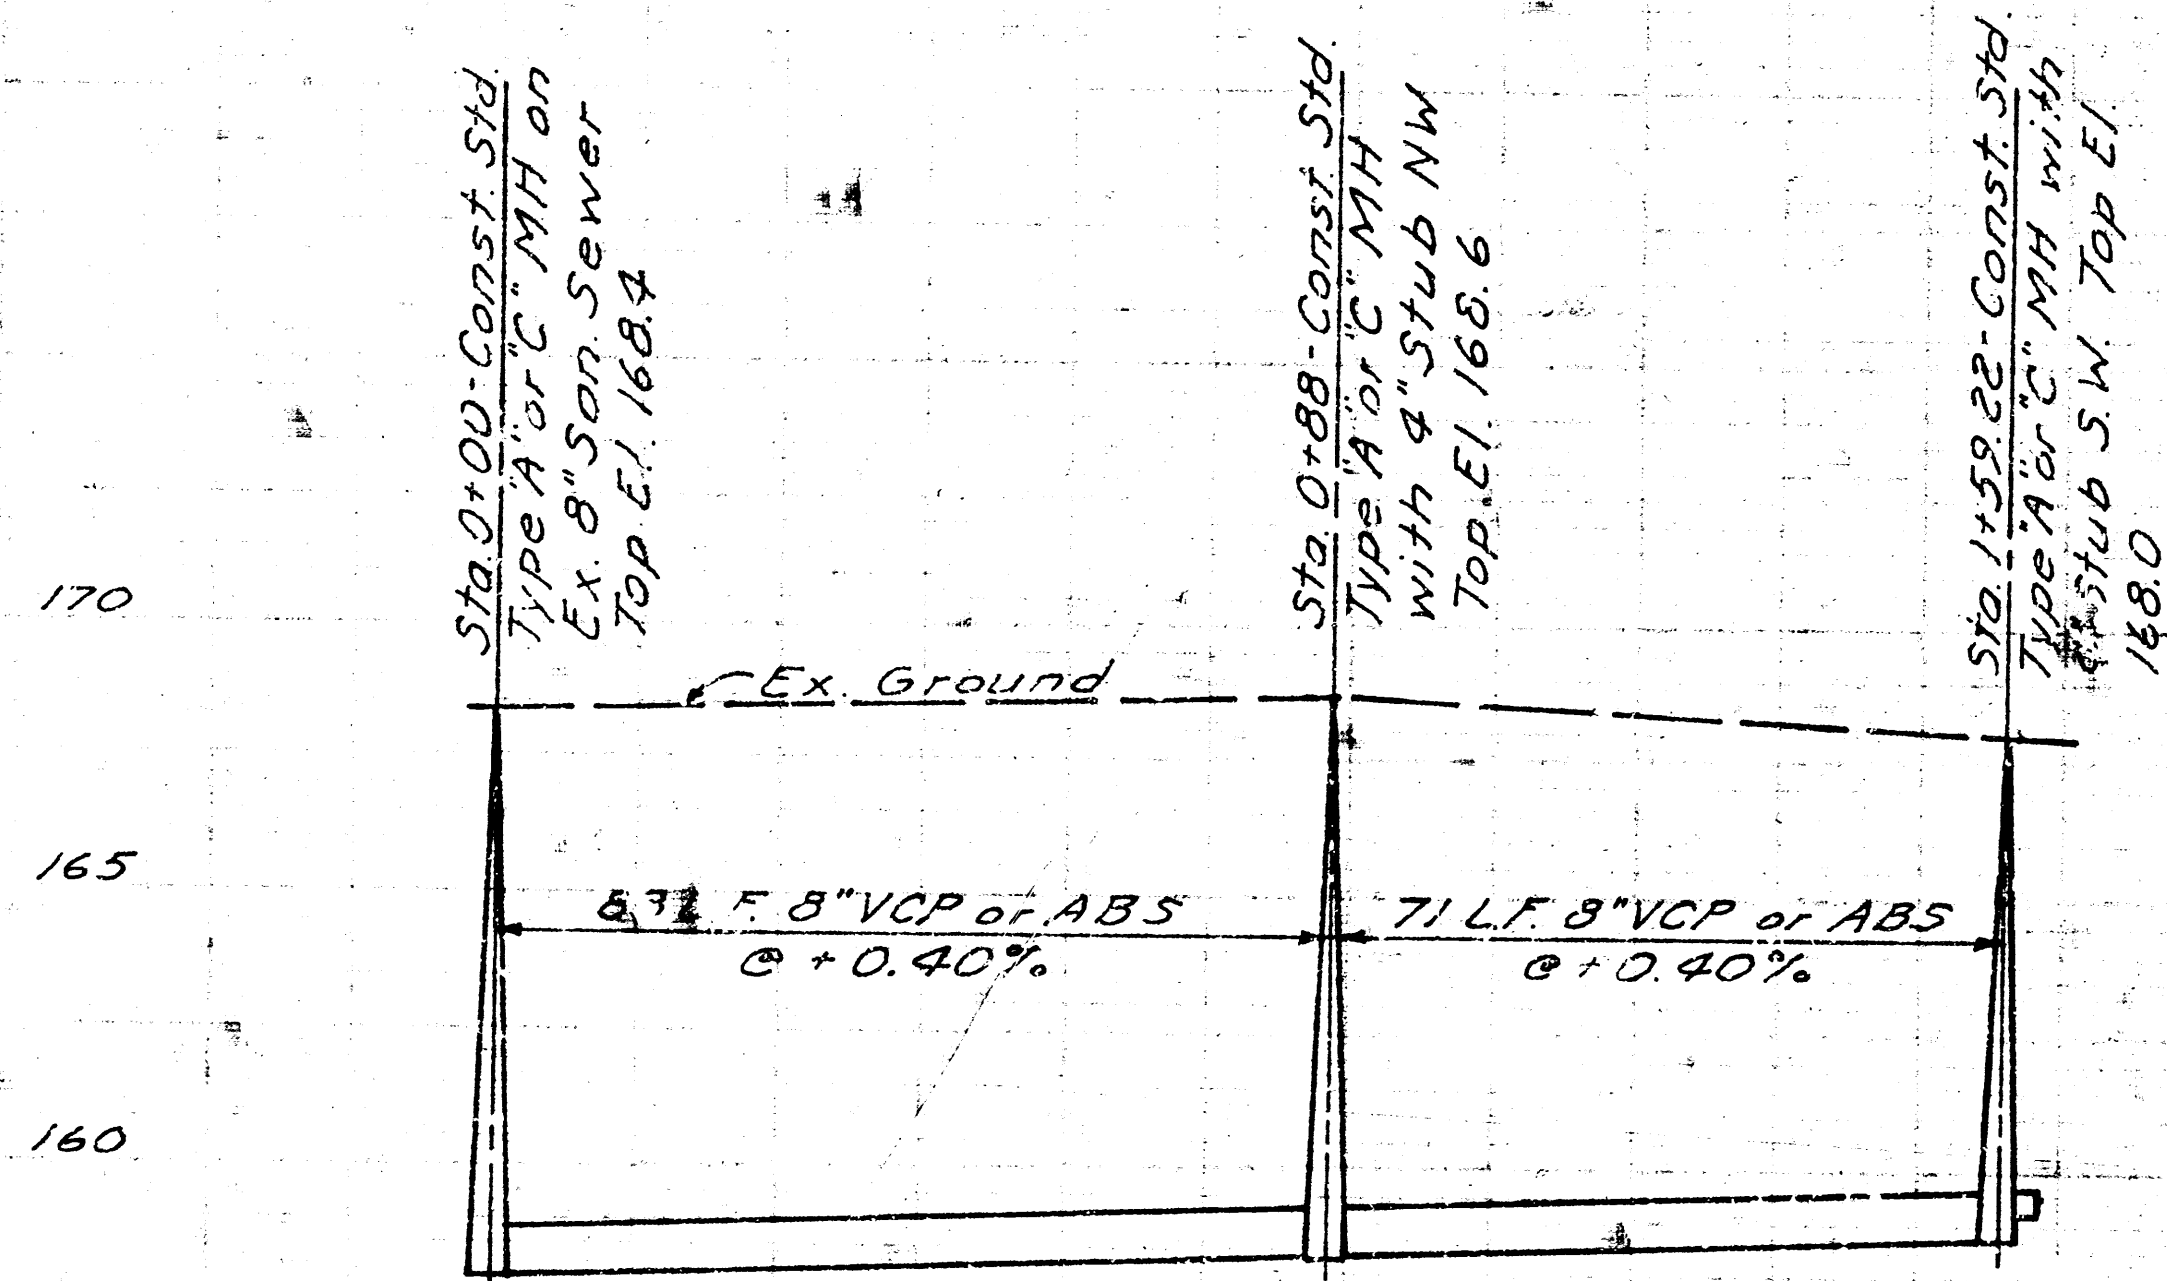

C. El. out 157.06
El. in (W) 157.06

+50' El. 158.16

El. out 158.31
El. in (S) 158.41
El. in (NW) 158.64

El. out 158.69
El. in (SW) 159.02

CITY PROJECT NO. DBKW 707025
SANITARY SEWER IMPROVEMENTS
FOR BARTLETT ADDITION, WICHITA, KS.

14 S 1 2