


5-5-80
 APPROVED AS NOTED
 By CITY ENGINEER OF WICHITA
 Sanitary Sewers *DEA*
 Storm Sewers _____
 Driveway Approaches _____

NOTE TO CONTRACTOR
 This project will be constructed under the supervision of the CITY ENGINEER and conforming to the SPECIFICATIONS of the CITY OF WICHITA. The CONTRACTOR will reimburse the City of Wichita for all cost of engineering, plans, and inspection.

Scale: Horiz. 1" = 40'
 Vert. 1" = 4'

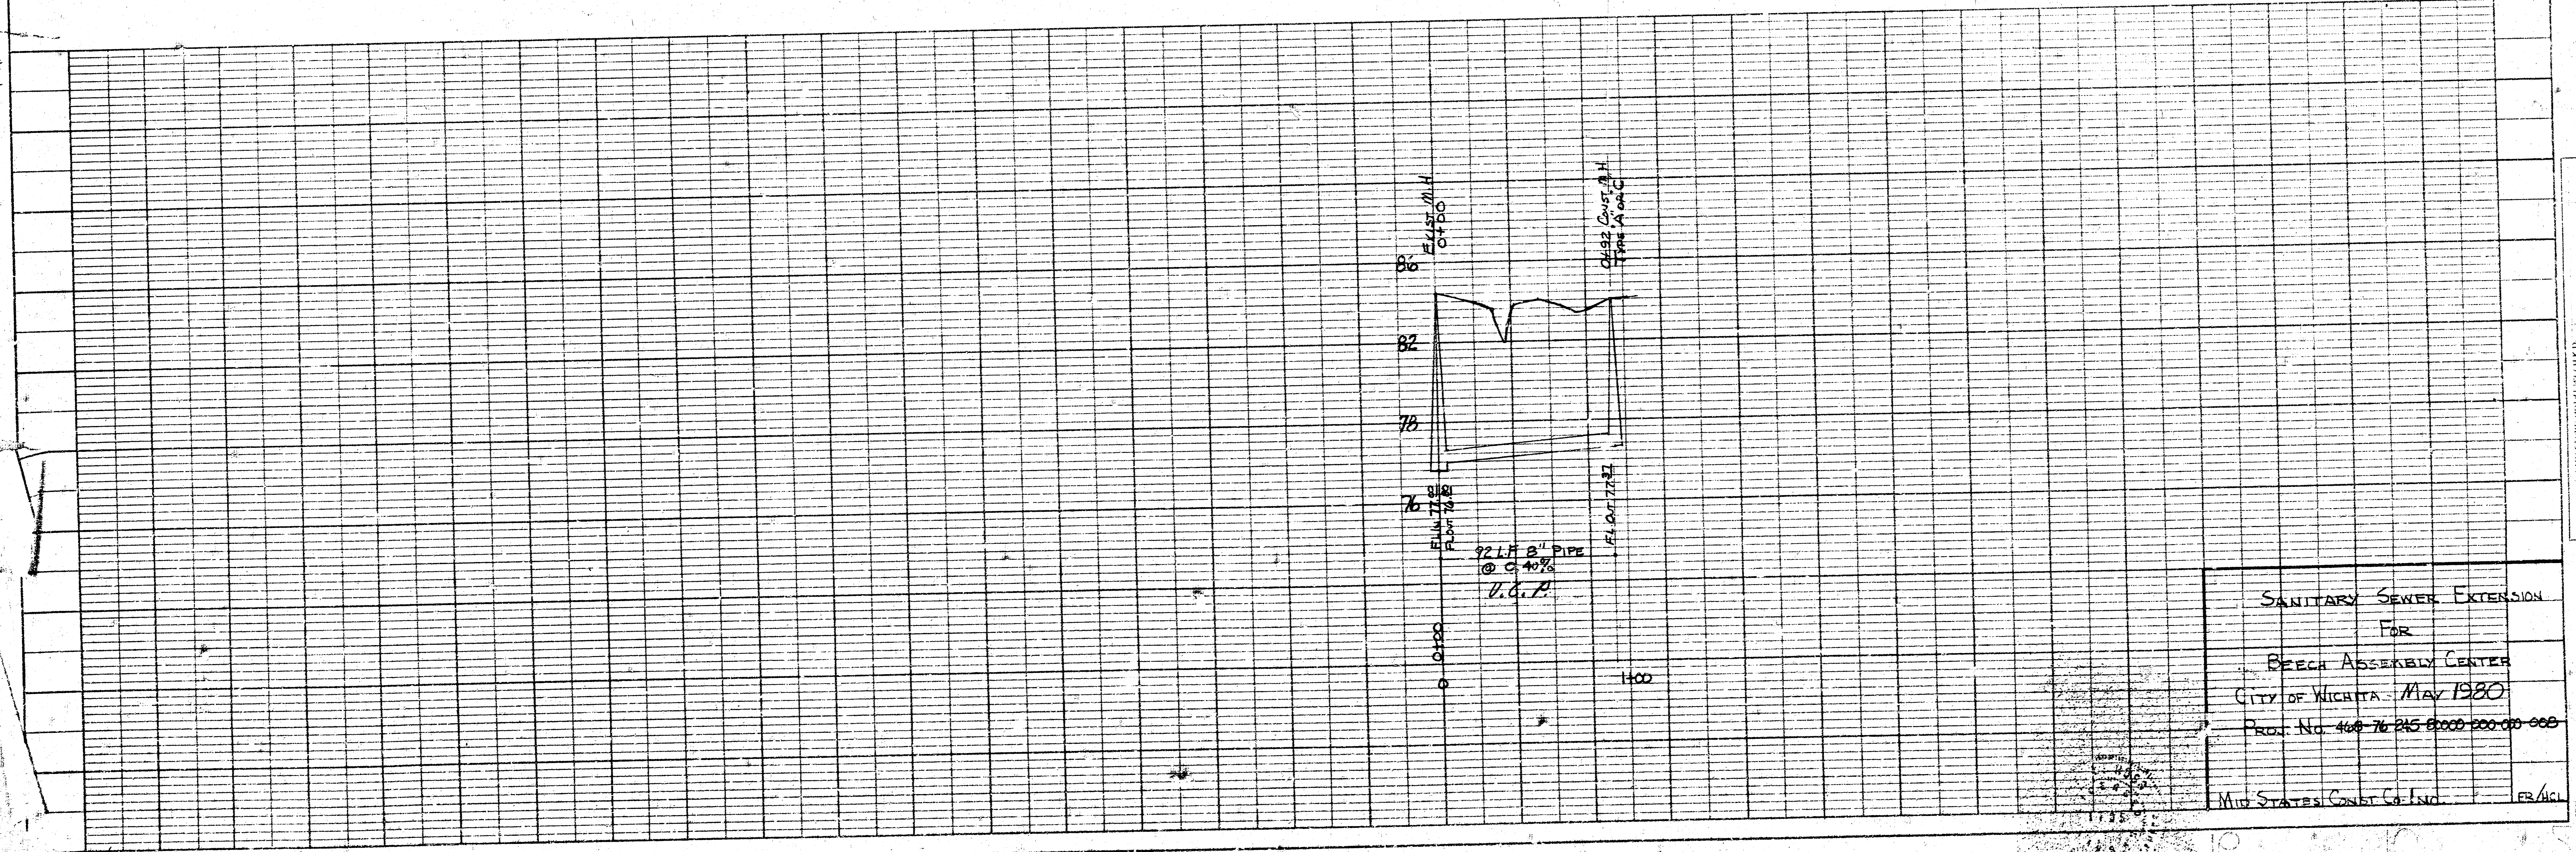

SANITARY SEWER EXTENSION
 FOR
 BEECH ASSEMBLY CENTER
 CITY OF WICHITA - MAY 1980
 PROJ. No. 460-76-245-0000-200-000-000
 MID STATES CONST. CO. INC. ER/HCL

DATE: 5-5-80
 DRAWN BY: [unclear]
 CHECKED BY: [unclear]
 APPROVED BY: [unclear]
 TITLE: SANITARY SEWER EXTENSION
 PROJECT: BEECH ASSEMBLY CENTER

DATE: 5-5-80
 DRAWN BY: [unclear]
 CHECKED BY: [unclear]
 APPROVED BY: [unclear]
 TITLE: SANITARY SEWER EXTENSION
 PROJECT: BEECH ASSEMBLY CENTER