



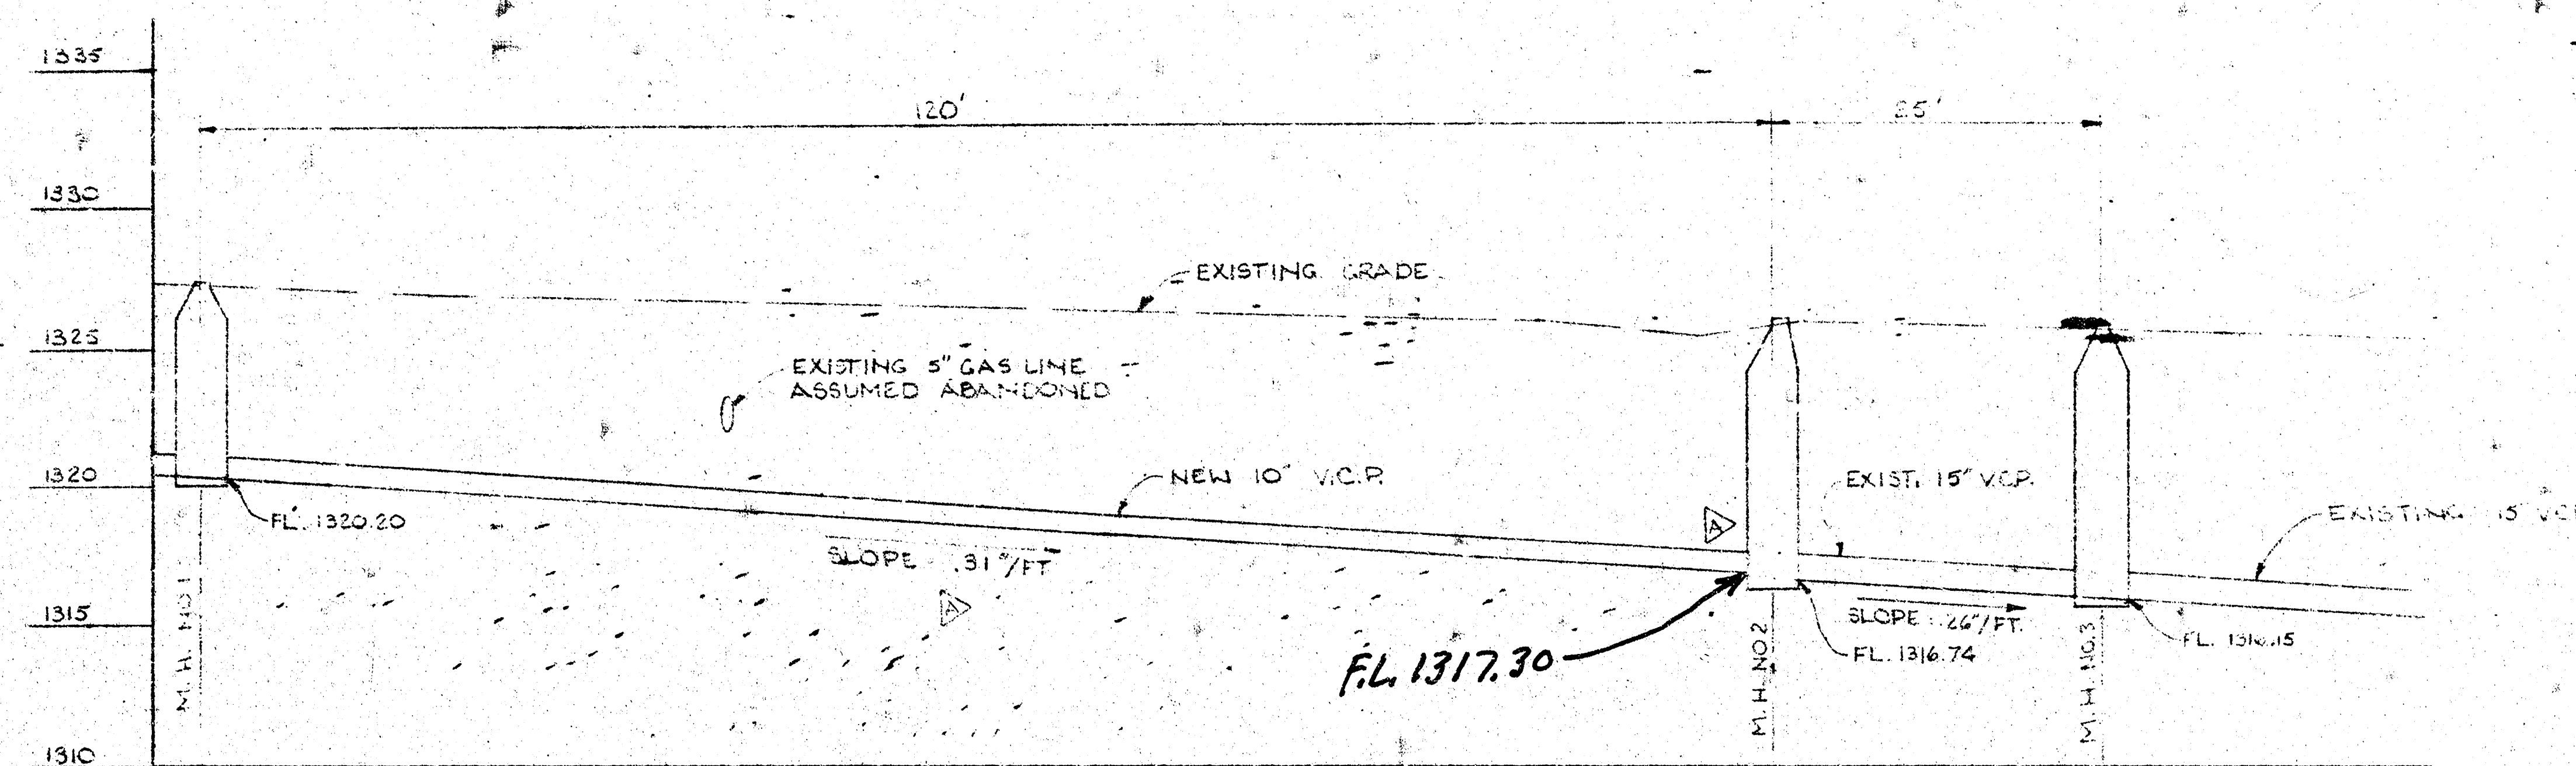

PROFILE - MANHOLE #1 THRU #3
 HORIZ. SCALE 1"=10'
 VERT. SCALE 1"=2'

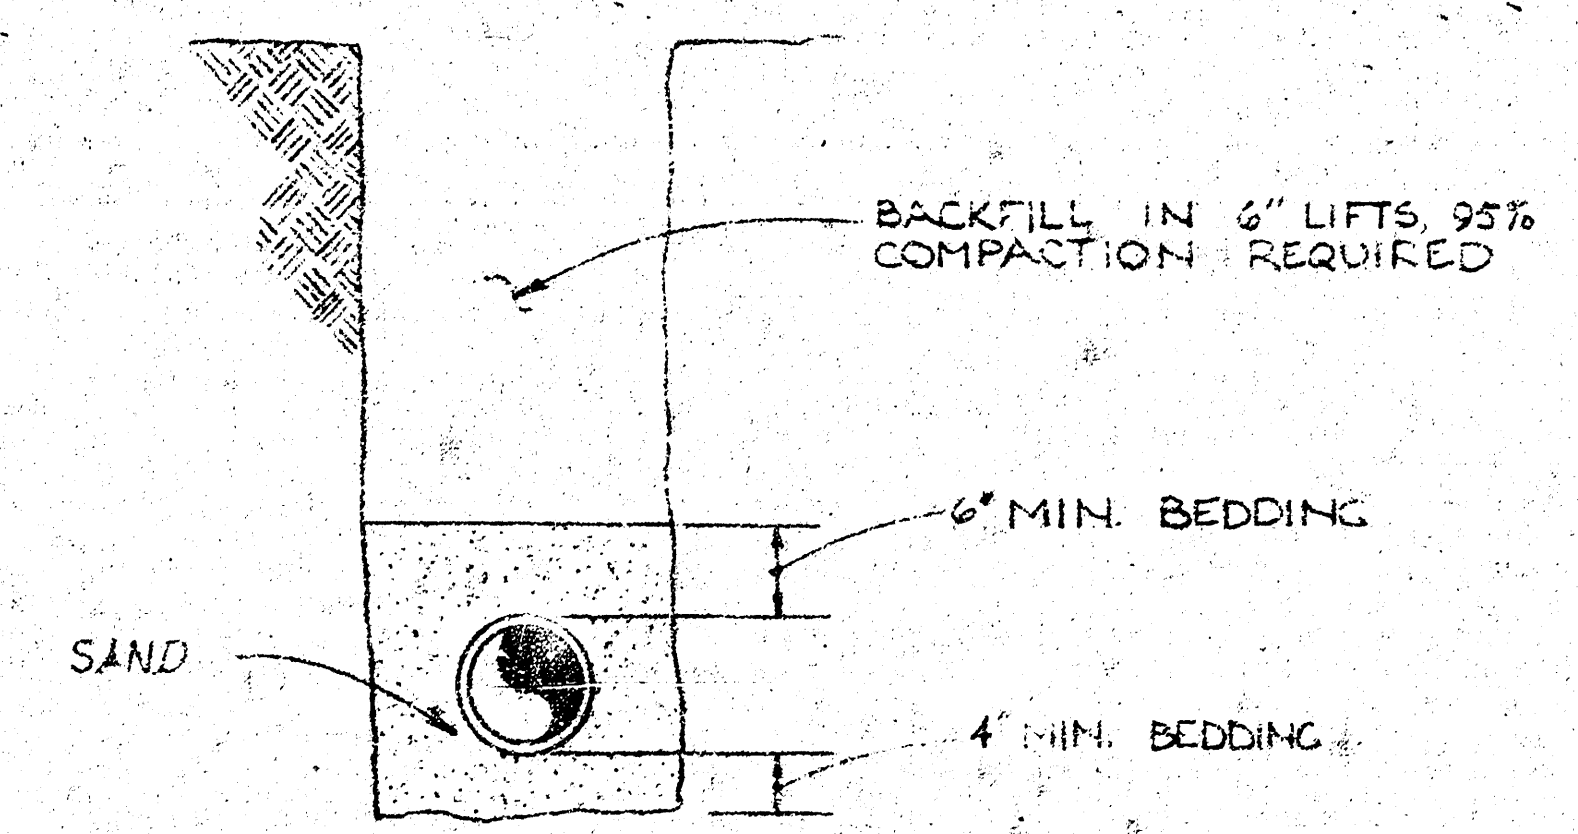

TYPICAL TRENCH DETAIL
 NO. SCALE

- NOTES:
1. FOR LOCATION AND LAYOUT PLAN OF SANITARY SEWER AND MANHOLES SEE DWG. GF-401
 2. FOR MANHOLE DETAILS SEE DWG. GF-403
 3. NEW SANITARY SEWER BETWEEN MANHOLE NO. 1 AND MANHOLE NO. 2 IS TO BE 10\"/>
 - 4. TOP OF NEW 10\"/>

APPROVED FOR CONSTRUCTION


DATE: 11-13-80

BY: [Signature]

NOTED

NOT REQUIRED

NOT REQUIRED

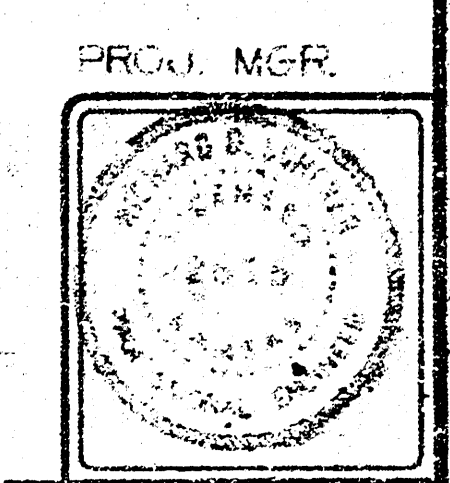

REV.	BY	DATE	DESCRIPTION
1	REM	11-13-80	REVISED SLOPE OF NEW 10\"/>


PROVIDE & INSTALL RECORDING WATER FLOW METER

GF-402-1


GF-402-1

GF-402-1

GF-402-1

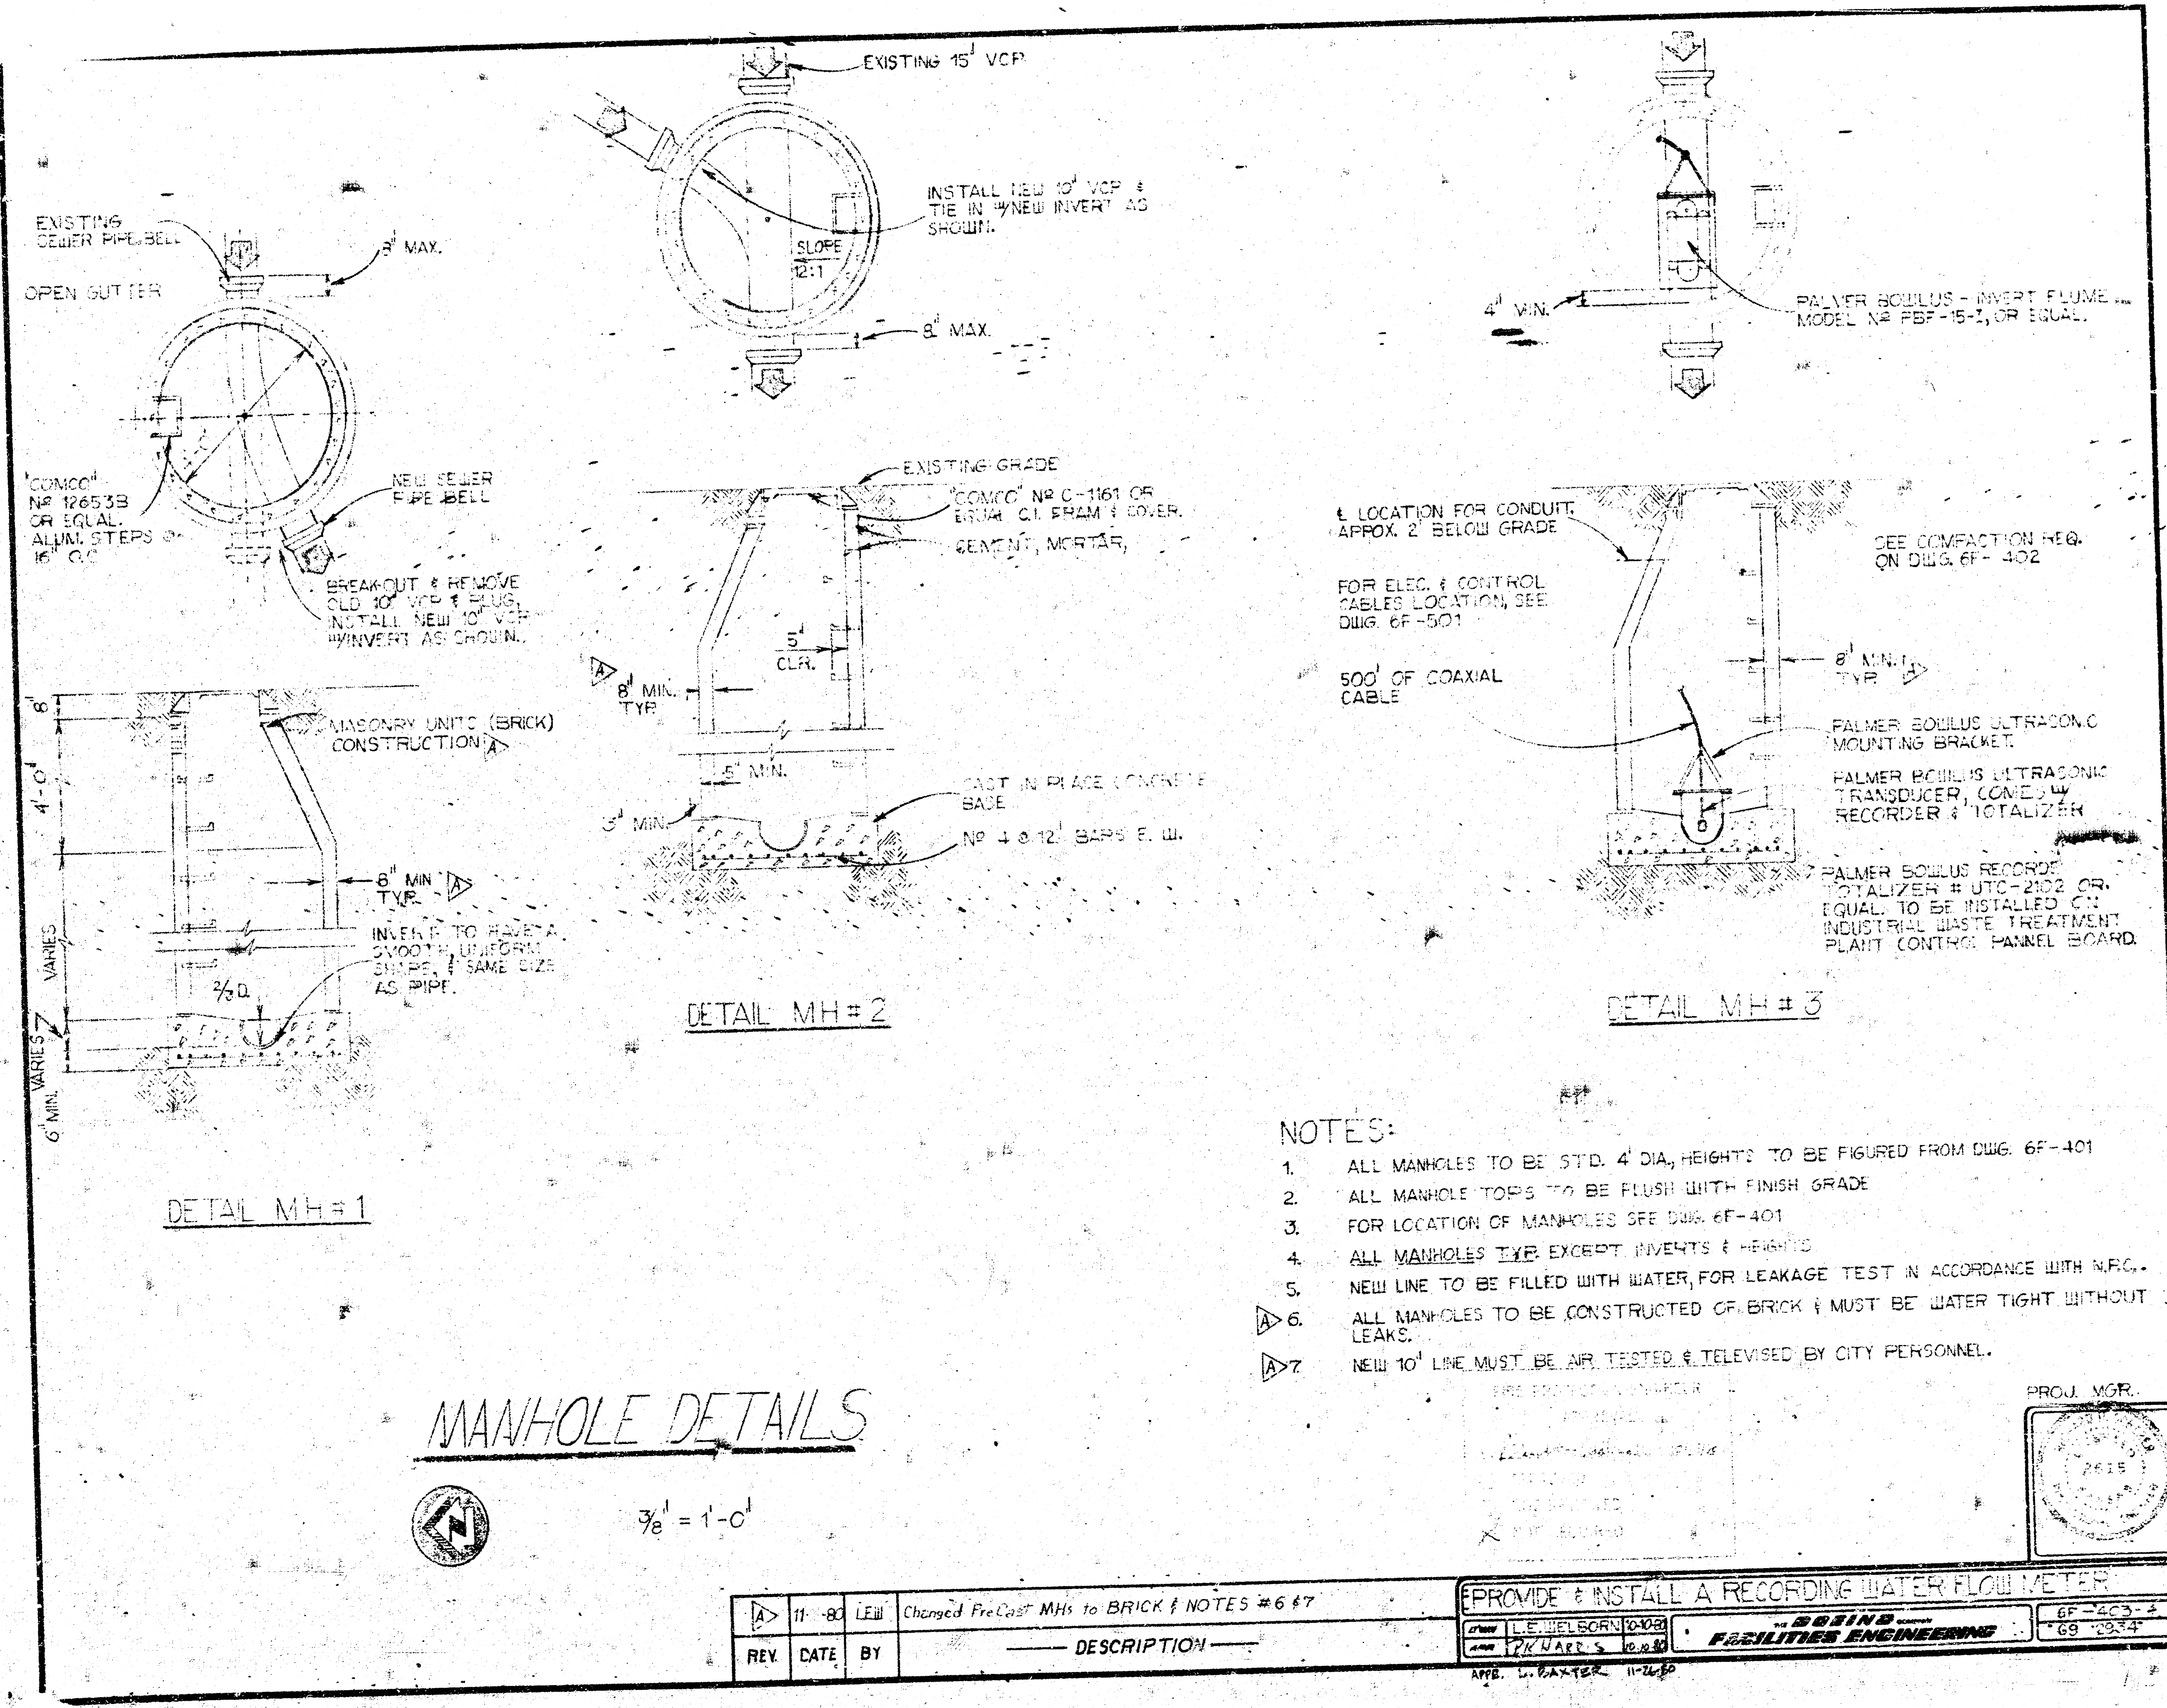

MANHOLE DETAILS

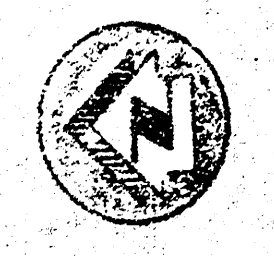

3/8" = 1'-0"

- NOTES:
1. ALL MANHOLES TO BE STD. 4' DIA. HEIGHTS TO BE FIGURED FROM DWG. 6F-401
 2. ALL MANHOLE TOPS TO BE FLUSH WITH FINISH GRADE
 3. FOR LOCATION OF MANHOLES SEE DWG. 6F-401
 4. ALL MANHOLES TYP. EXCEPT INVERTS & HEADINGS
 5. NEW LINE TO BE FILLED WITH WATER, FOR LEAKAGE TEST IN ACCORDANCE WITH N.R.C.
 6. ALL MANHOLES TO BE CONSTRUCTED OF BRICK & MUST BE WATER TIGHT WITHOUT LEAKS.
 7. NEW 10' LINE MUST BE AIR TESTED & TELEVIEWED BY CITY PERSONNEL.

REV.	DATE	BY	DESCRIPTION	PROVIDE & INSTALL A RECORDING WATER FLOW METER
11-80	LEW		Changed Pre-Cast MHS to BRICK & NOTES #6 & 7	PROJ. MGR.
				7415
				6F-503-1
				69-0934

