



PLAN
 SURVEYED
 NOTE BOOK
 ASSIGNMENT CHECKED
 DATE
 NO.

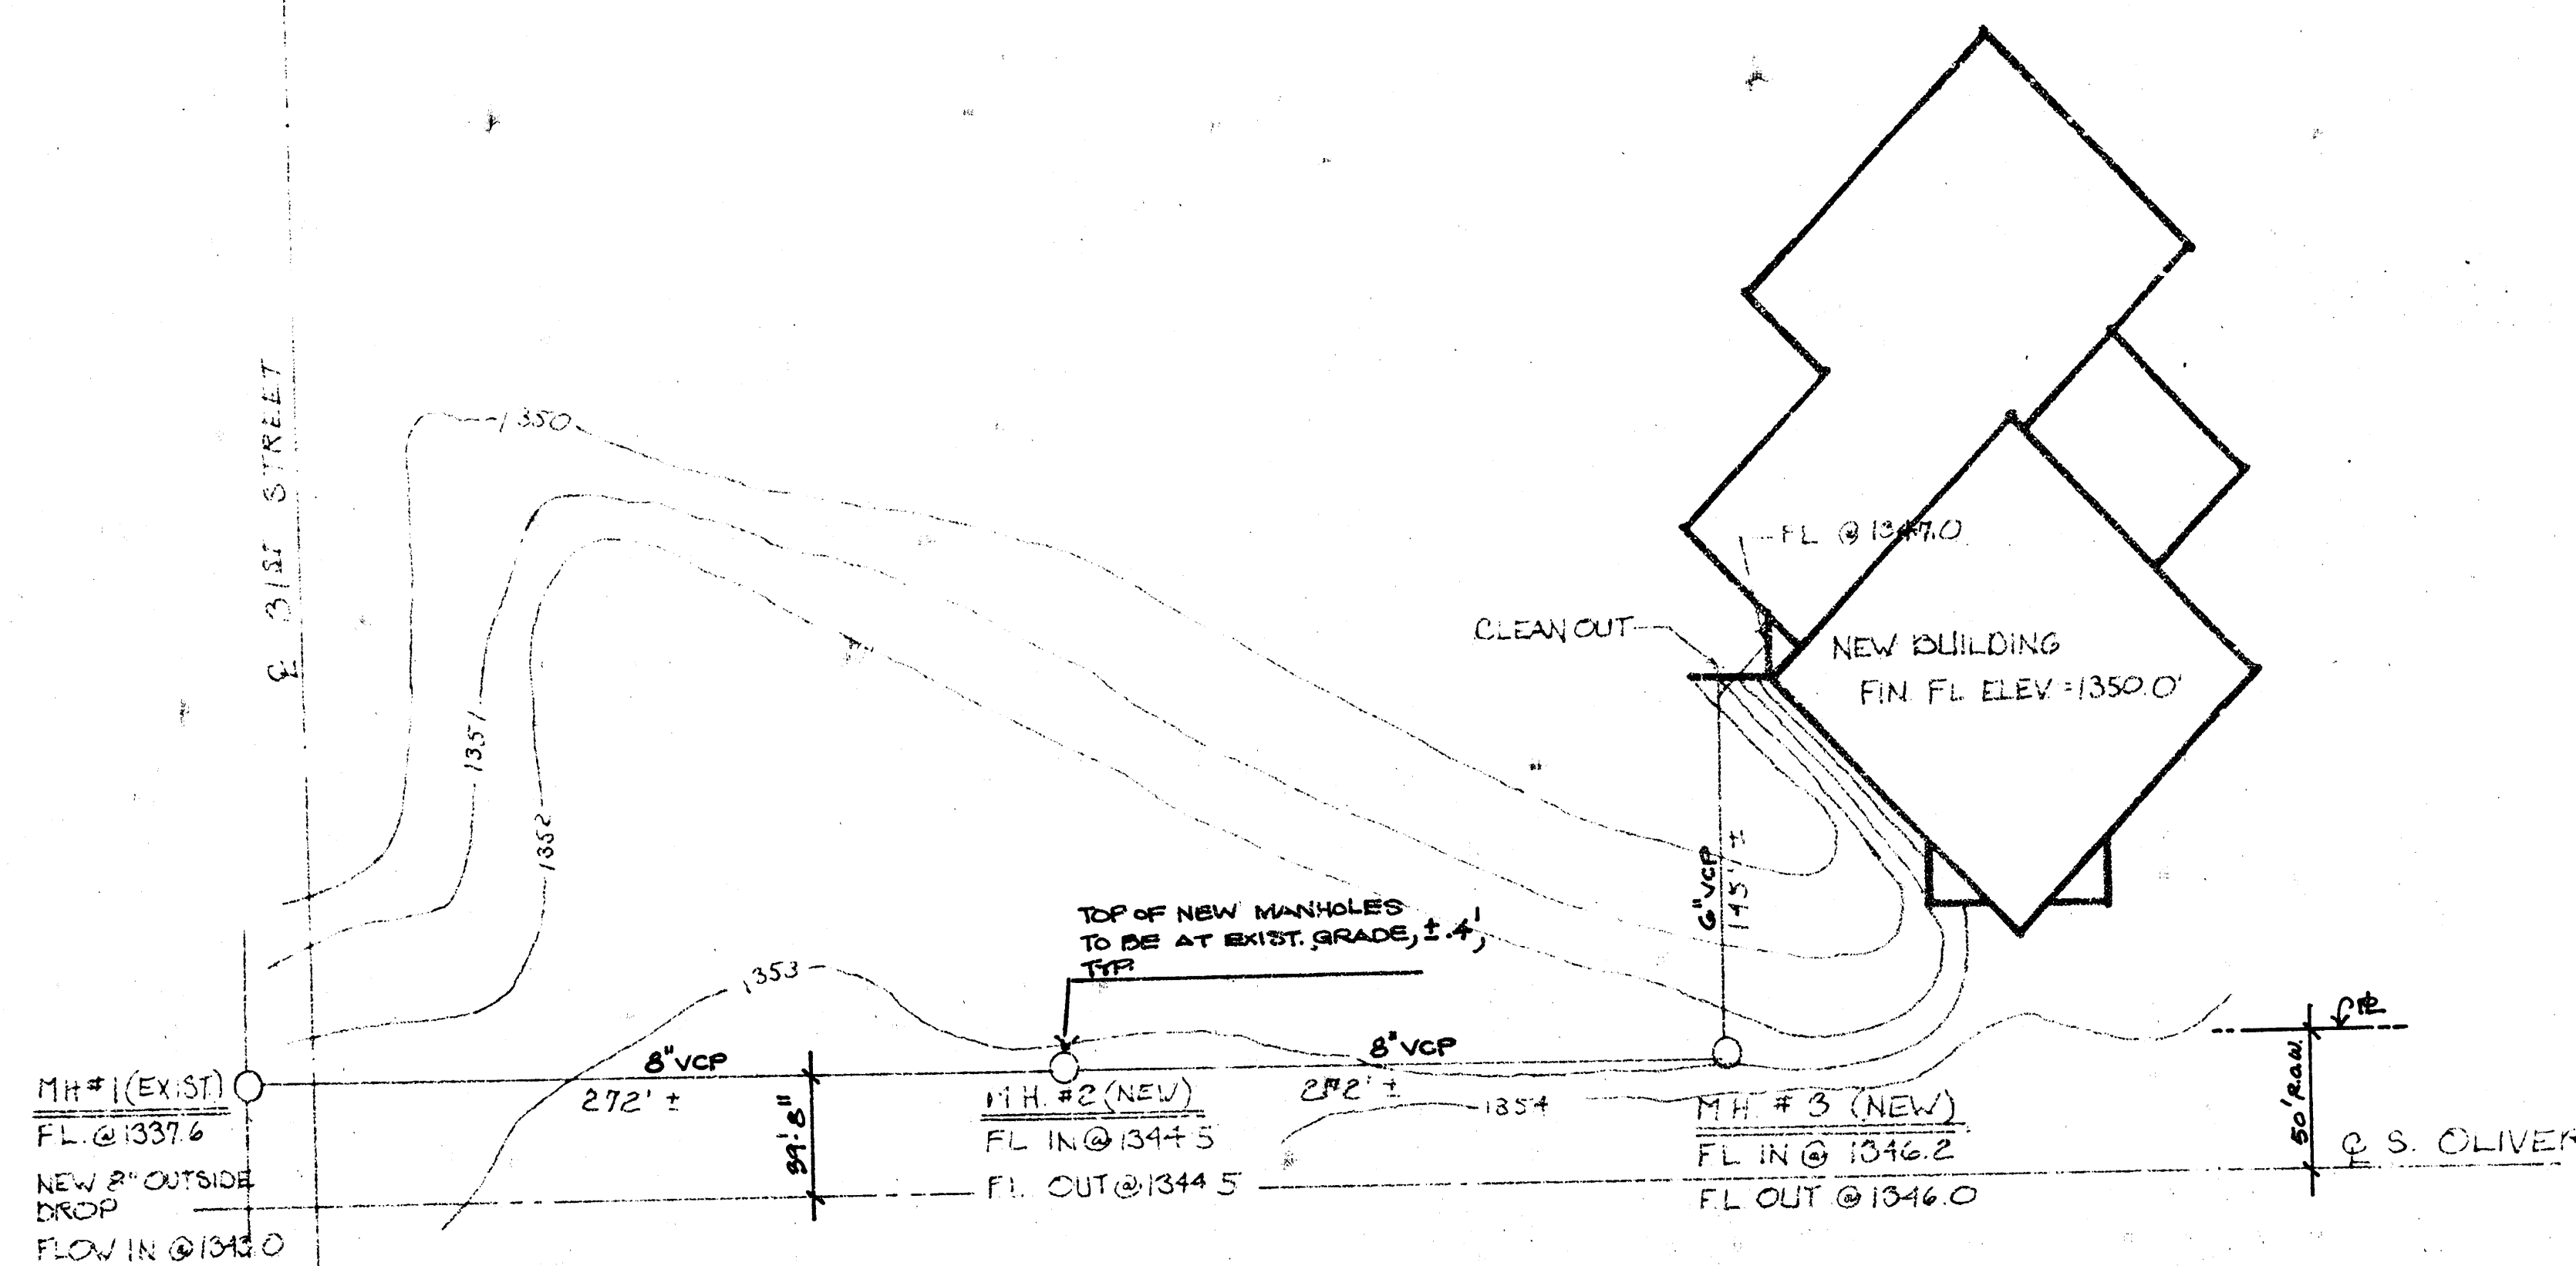

8-21-81
 APPROVED AS NOTED
 By CITY ENGINEER OF WICHITA
 Sanitary Sewers *P.L.S.*
 Storm Sewers _____
 Driveway Approaches _____

NOTE TO CONTRACTOR
 This project will be constructed under the supervision of the CITY ENGINEER and conforming to the SPECIFICATIONS of the CITY OF WICHITA. The CONTRACTOR will prepay the City of Wichita for all costs of Inspection.

PROFILE
 SURVEYED
 NOTE BOOK
 ASSIGNMENT CHECKED
 DATE
 NO.

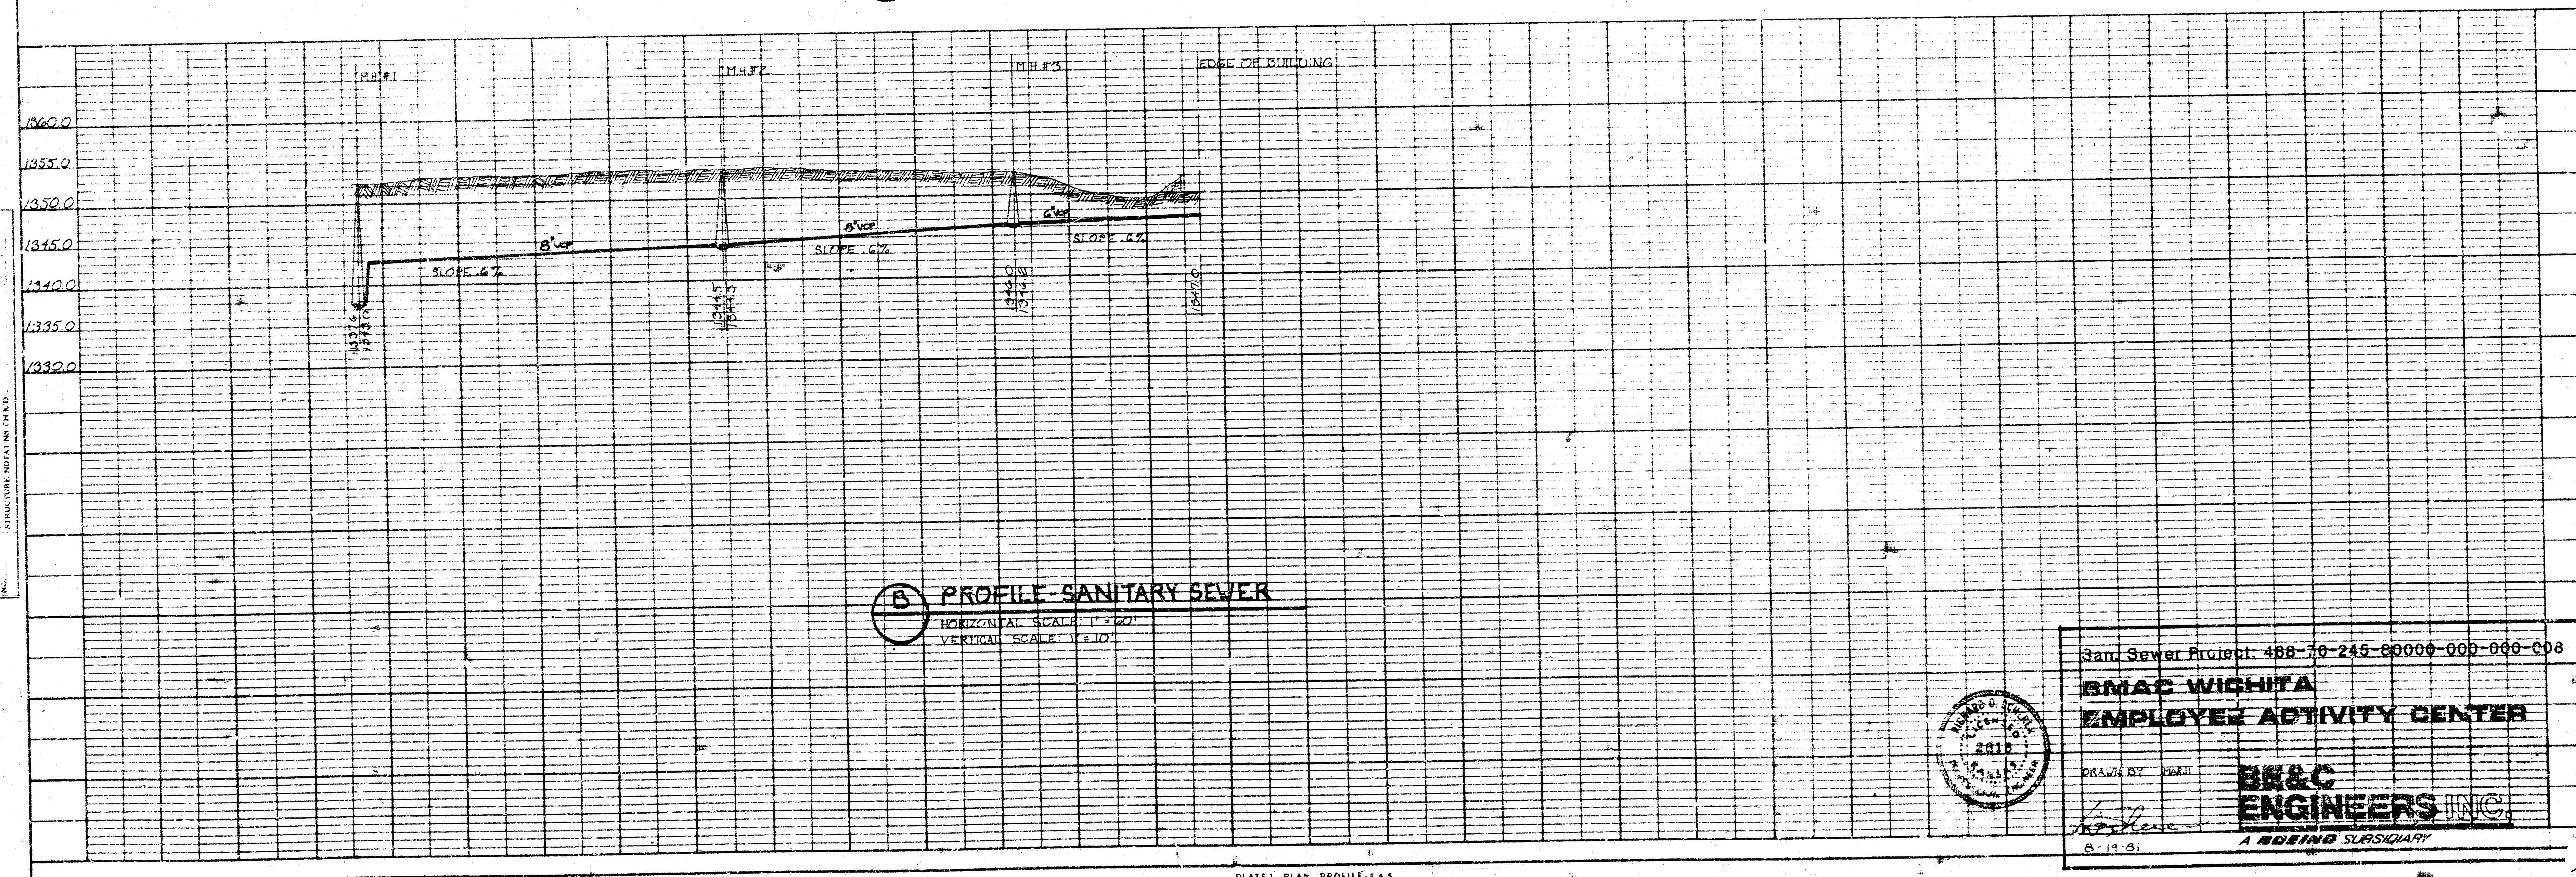

San. Sewer Project: 488-70-245-00000-000-000-008
BMAC WICHITA
EMPLOYEE ACTIVITY CENTER
 DRAWN BY: *[Signature]*
 8-19-81
BMAC ENGINEERS INC.
 A BODINO SUBSIDIARY