


SANITARY SEWERS

AS CONSTRUCTED

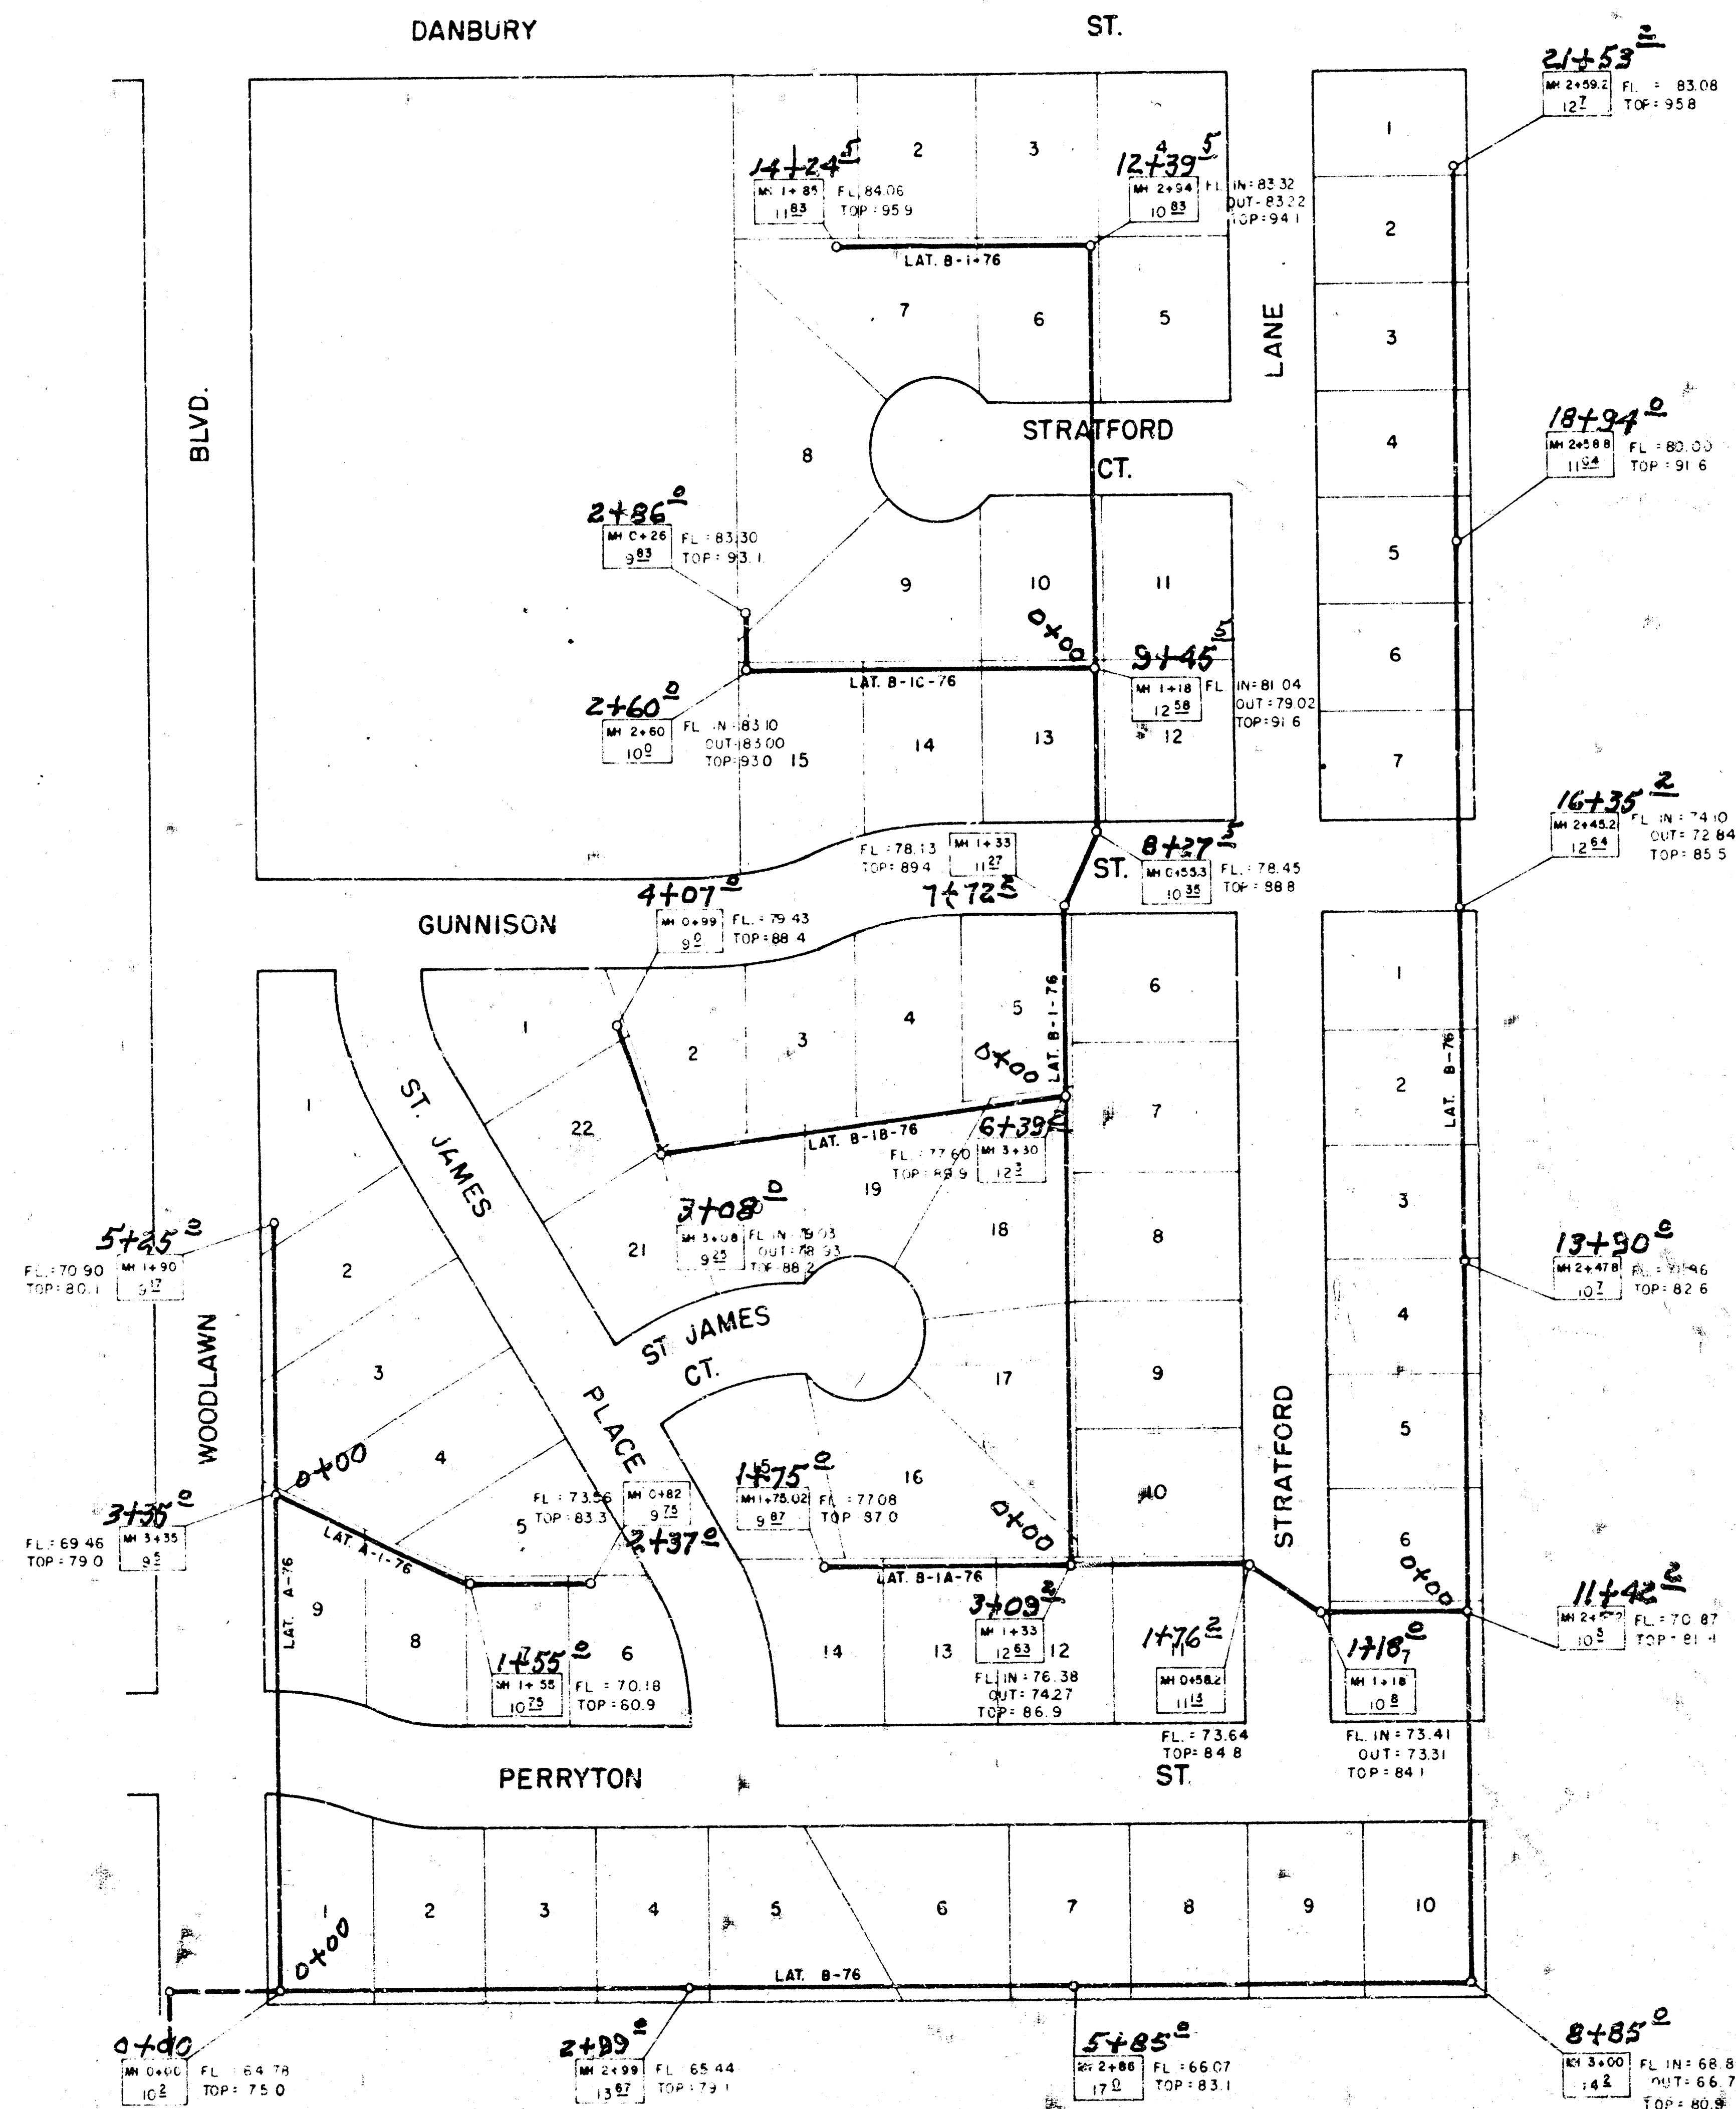

Stubs installed in manholes as shown by plan
All manholes type C

MH 3+45 — Distance from preceding downstream manhole
7.5 — Depth of manhole

Manhole

For U.S.G.S. Datum Add 1300.00 to Elevations Shown