





BENCH MARK: "X" cross at S.W. corner of Lot 25, Block 2, Brush Creek Addition
Elevation = 175.24 City Datum

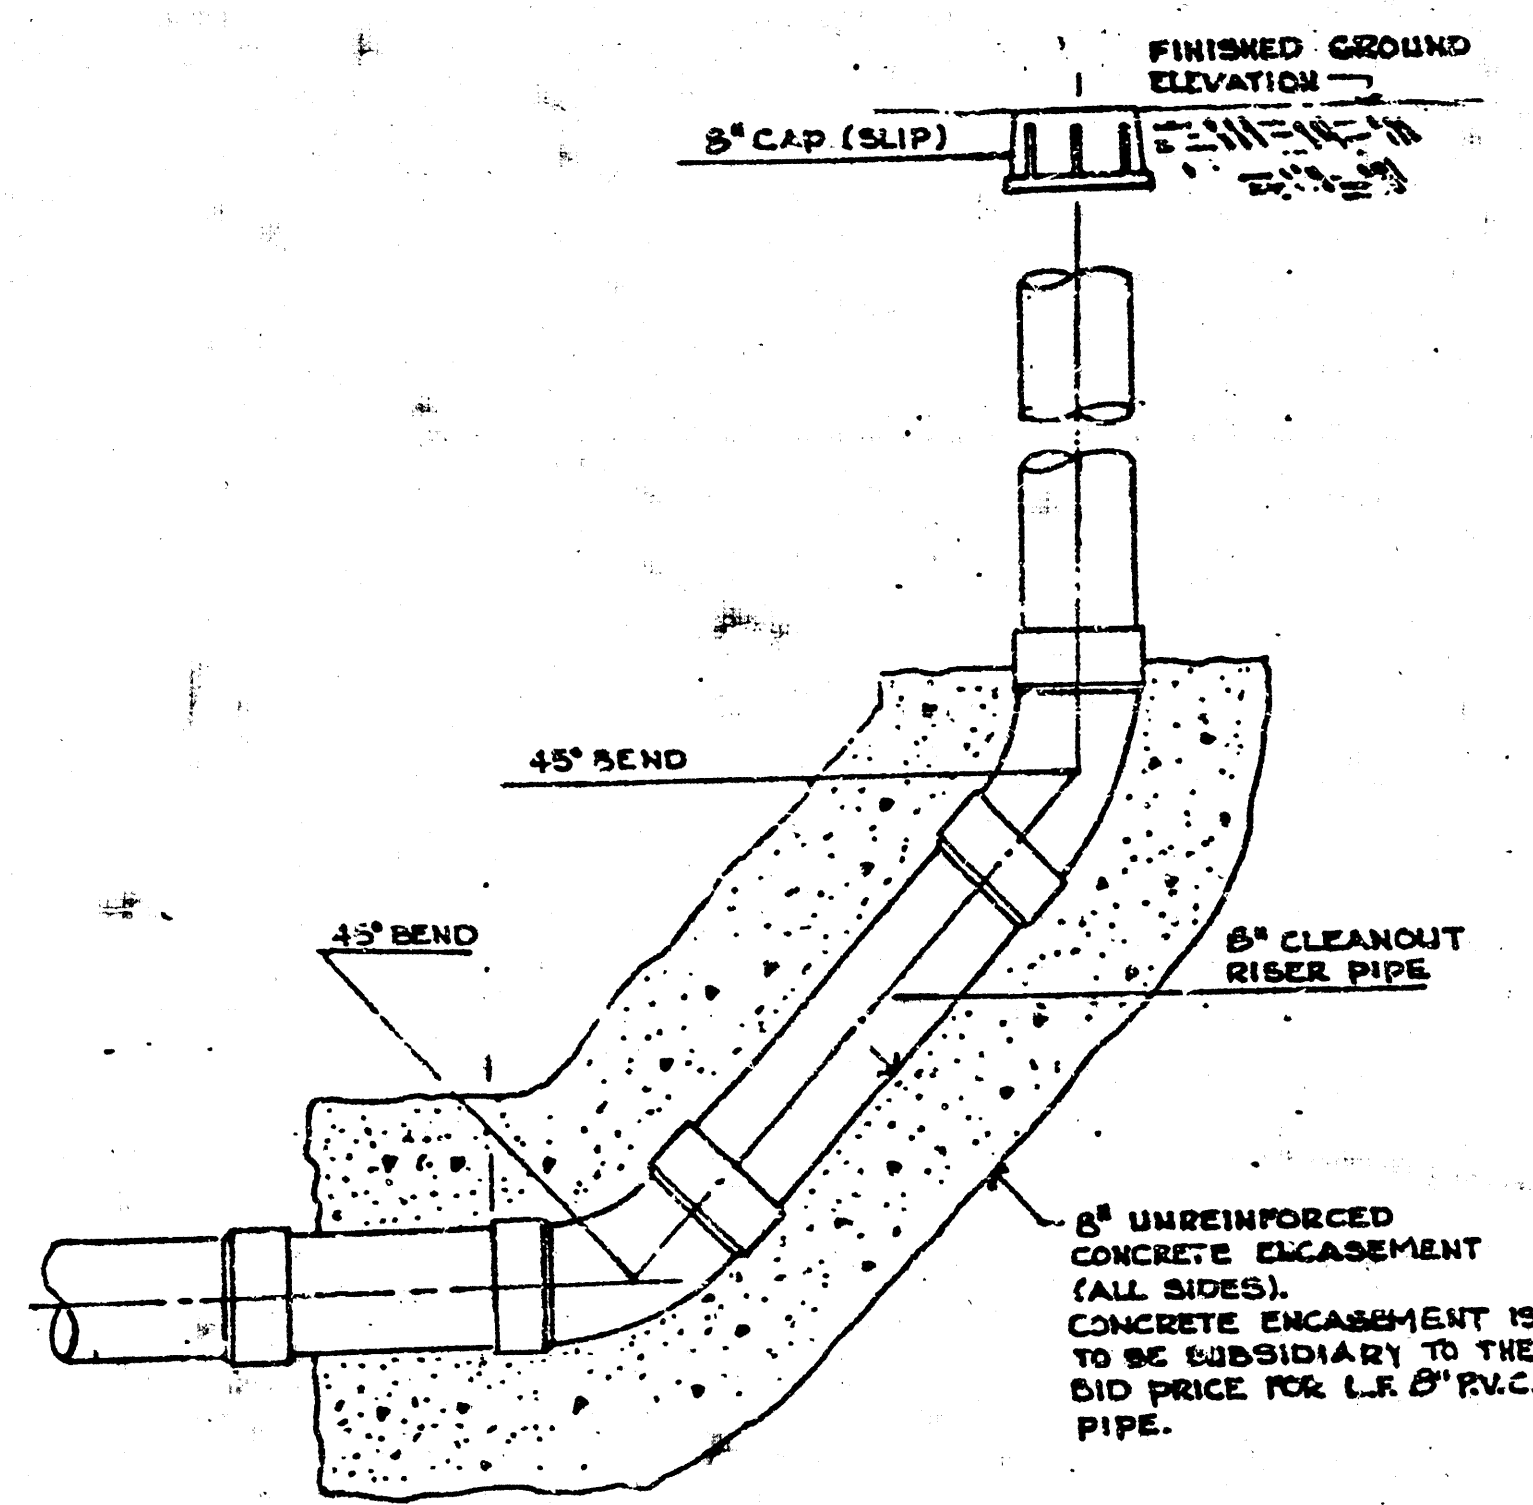

DETAIL 8" R.V.C. CLEANOUT RISER - END OF LINE-

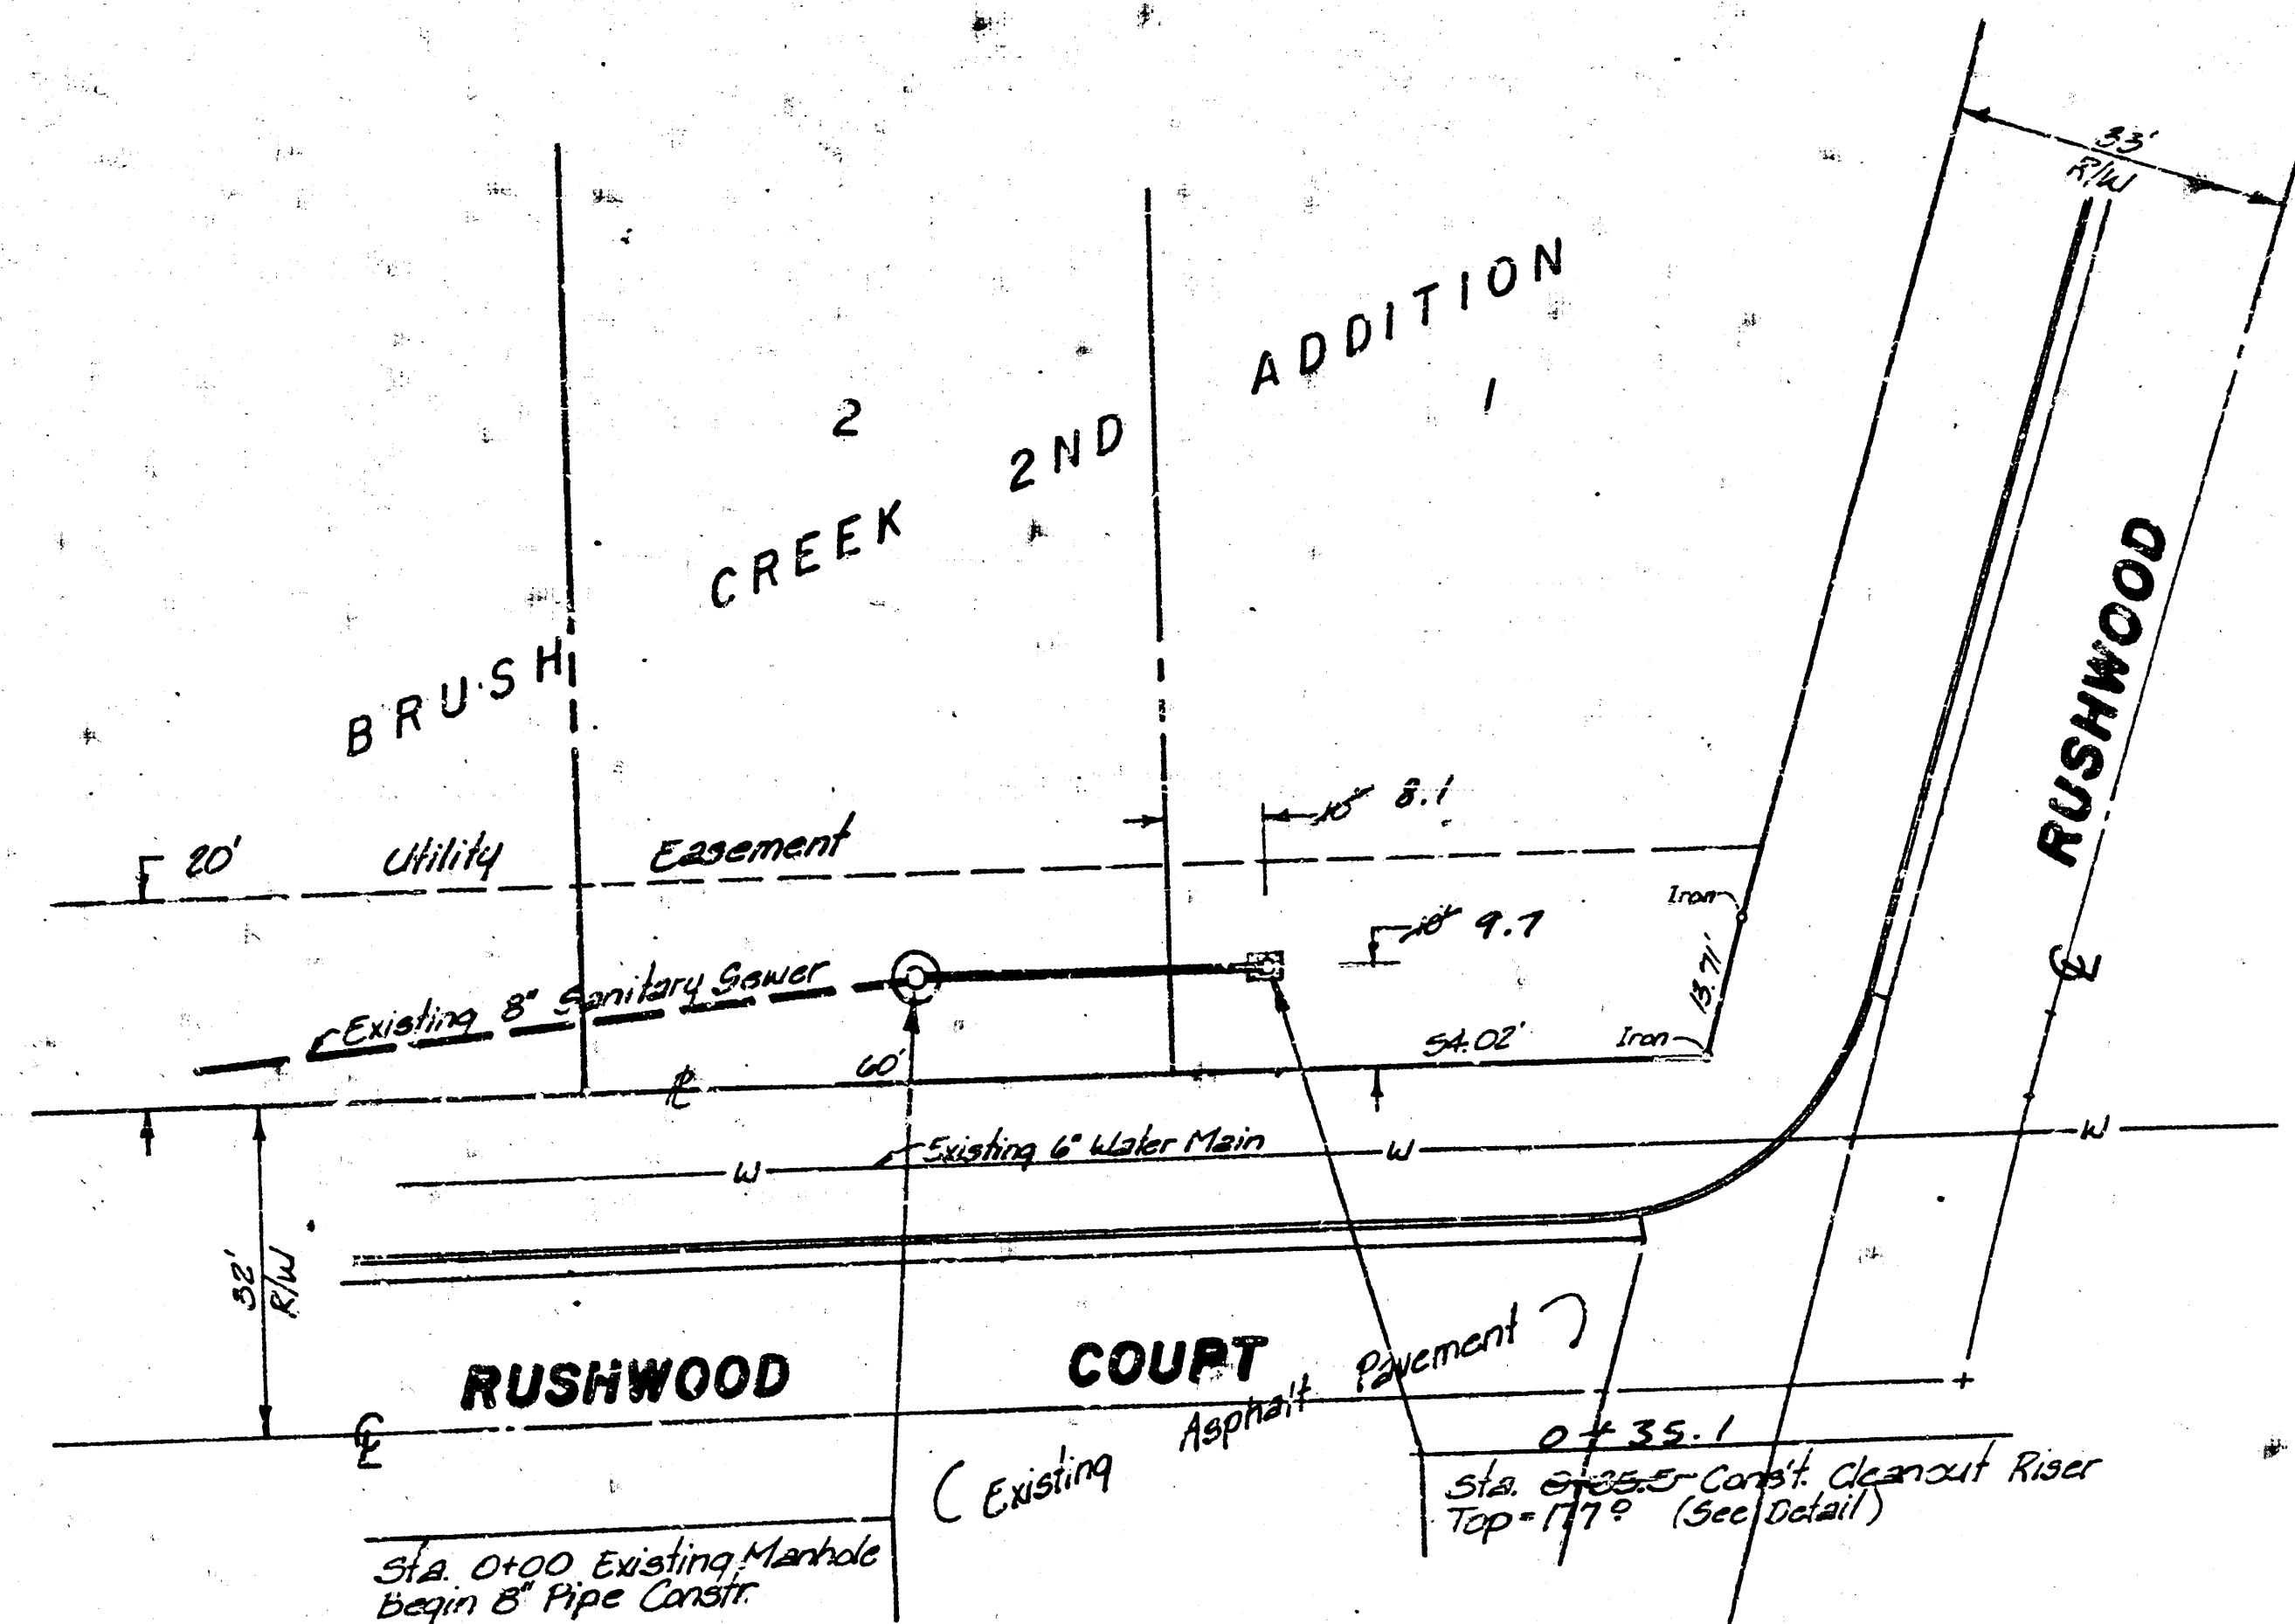

Scale: 1" = 20' Horiz.
1" = 5' Vert.

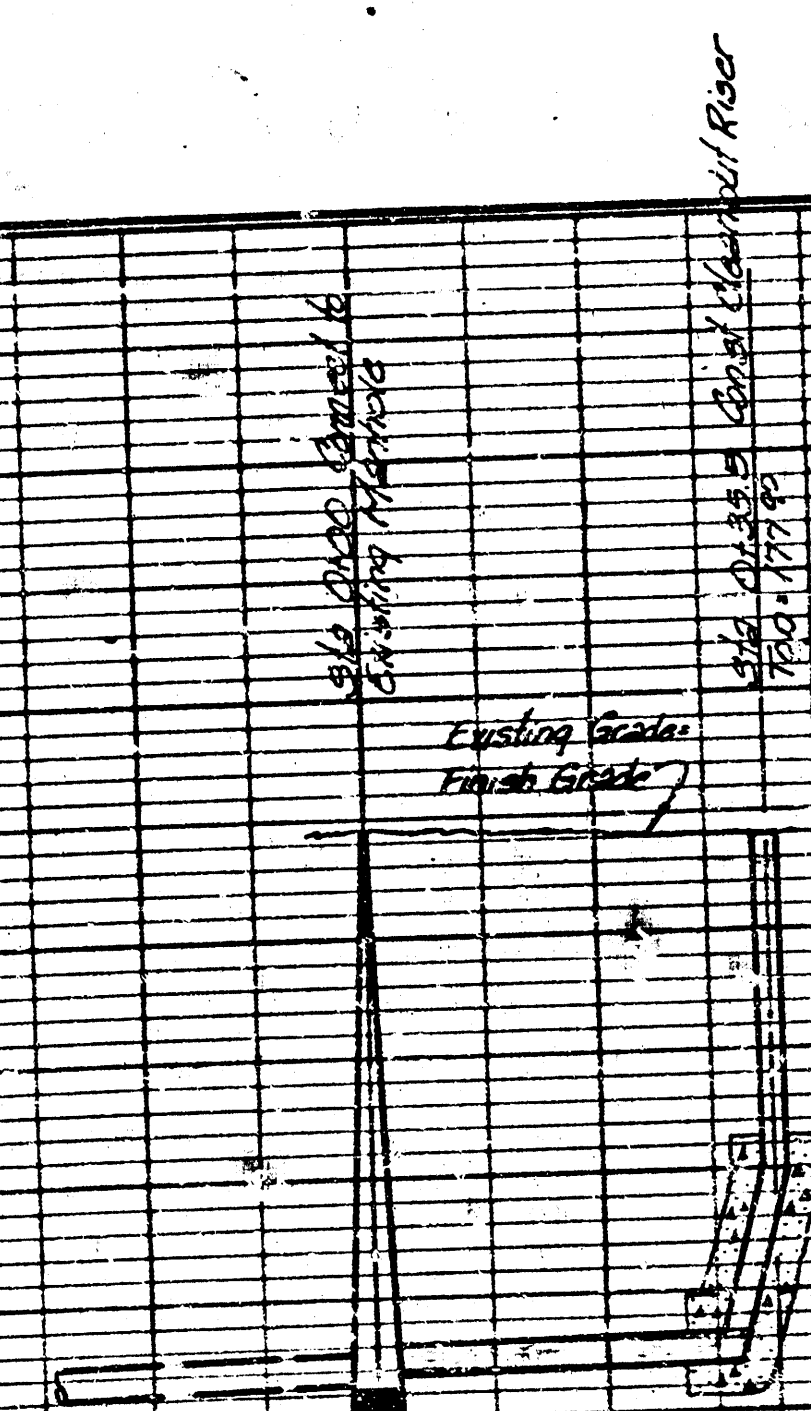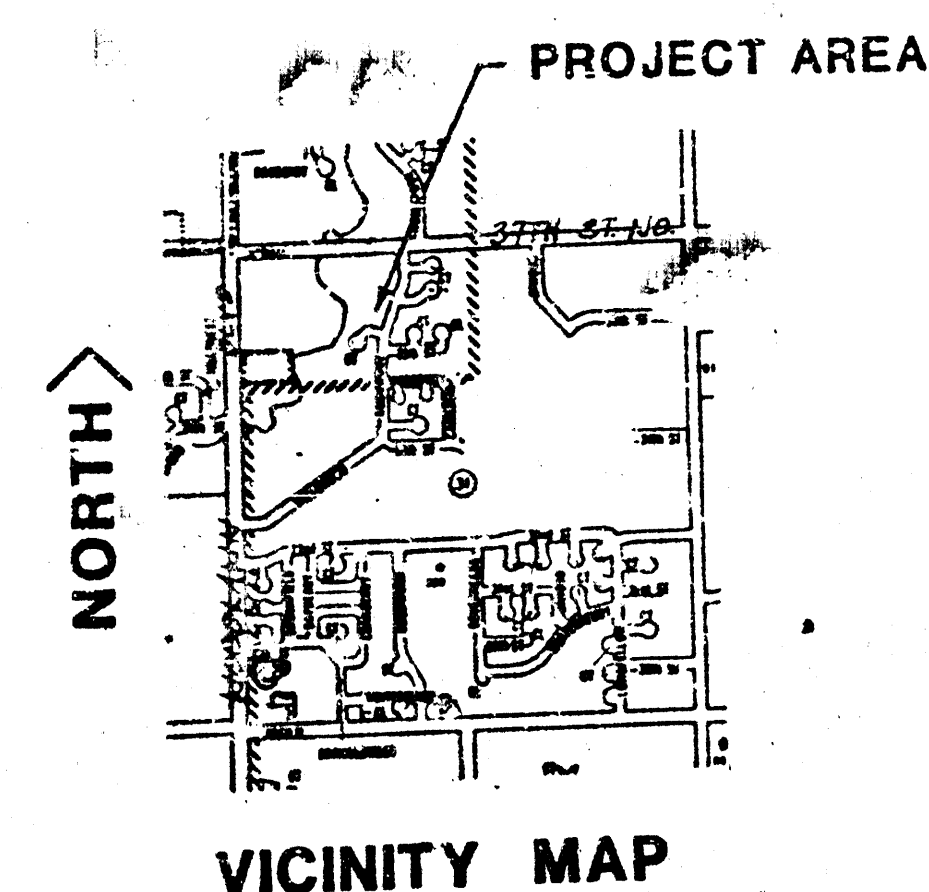

APPROVED AND
By CITY ENGINEER OF WICHITA

Sanitary Sewers
Storm Sewers
Driveway Approaches
Water Mains

NOTE TO CONTRACTOR
INSPECTION AND TESTING FOR THIS PROJECT IS TO BE PROVIDED BY THE LICENSED CIVIL ENGINEER, P.E. AND INSPECTION COMPANY, IN ACCORDANCE WITH THE CITY OF WICHITA STANDARDS. NO WORK SHALL BE PERFORMED BY THE CONTRACTOR WITHOUT THE SUPERVISION OF THE CITY ENGINEER. ANY WORK PERFORMED IN VIOLATION OF THE CITY STANDARDS SHALL BE AT THE CONTRACTOR'S RISK AND WITHOUT LIABILITY TO THE CITY ENGINEER.

AS BUILT 9-26-88 TCR
PRIVATE SANITARY SEWER EXTENSION
TO SERVE LOT 1,
BRUSH CREEK 2ND ADDITION
PROJECT NO. 468-76-245-80001-000-000-171
BAUGHMAN COMPANY, P.A.
SURVEYING & ENGINEERING
315-282-7271 • 315 ELLIS • WICHITA, KANSAS 67211
Scale: 1" = 1' 1"

FILMED FROM THE BEST
AVAILABLE COPY.....