



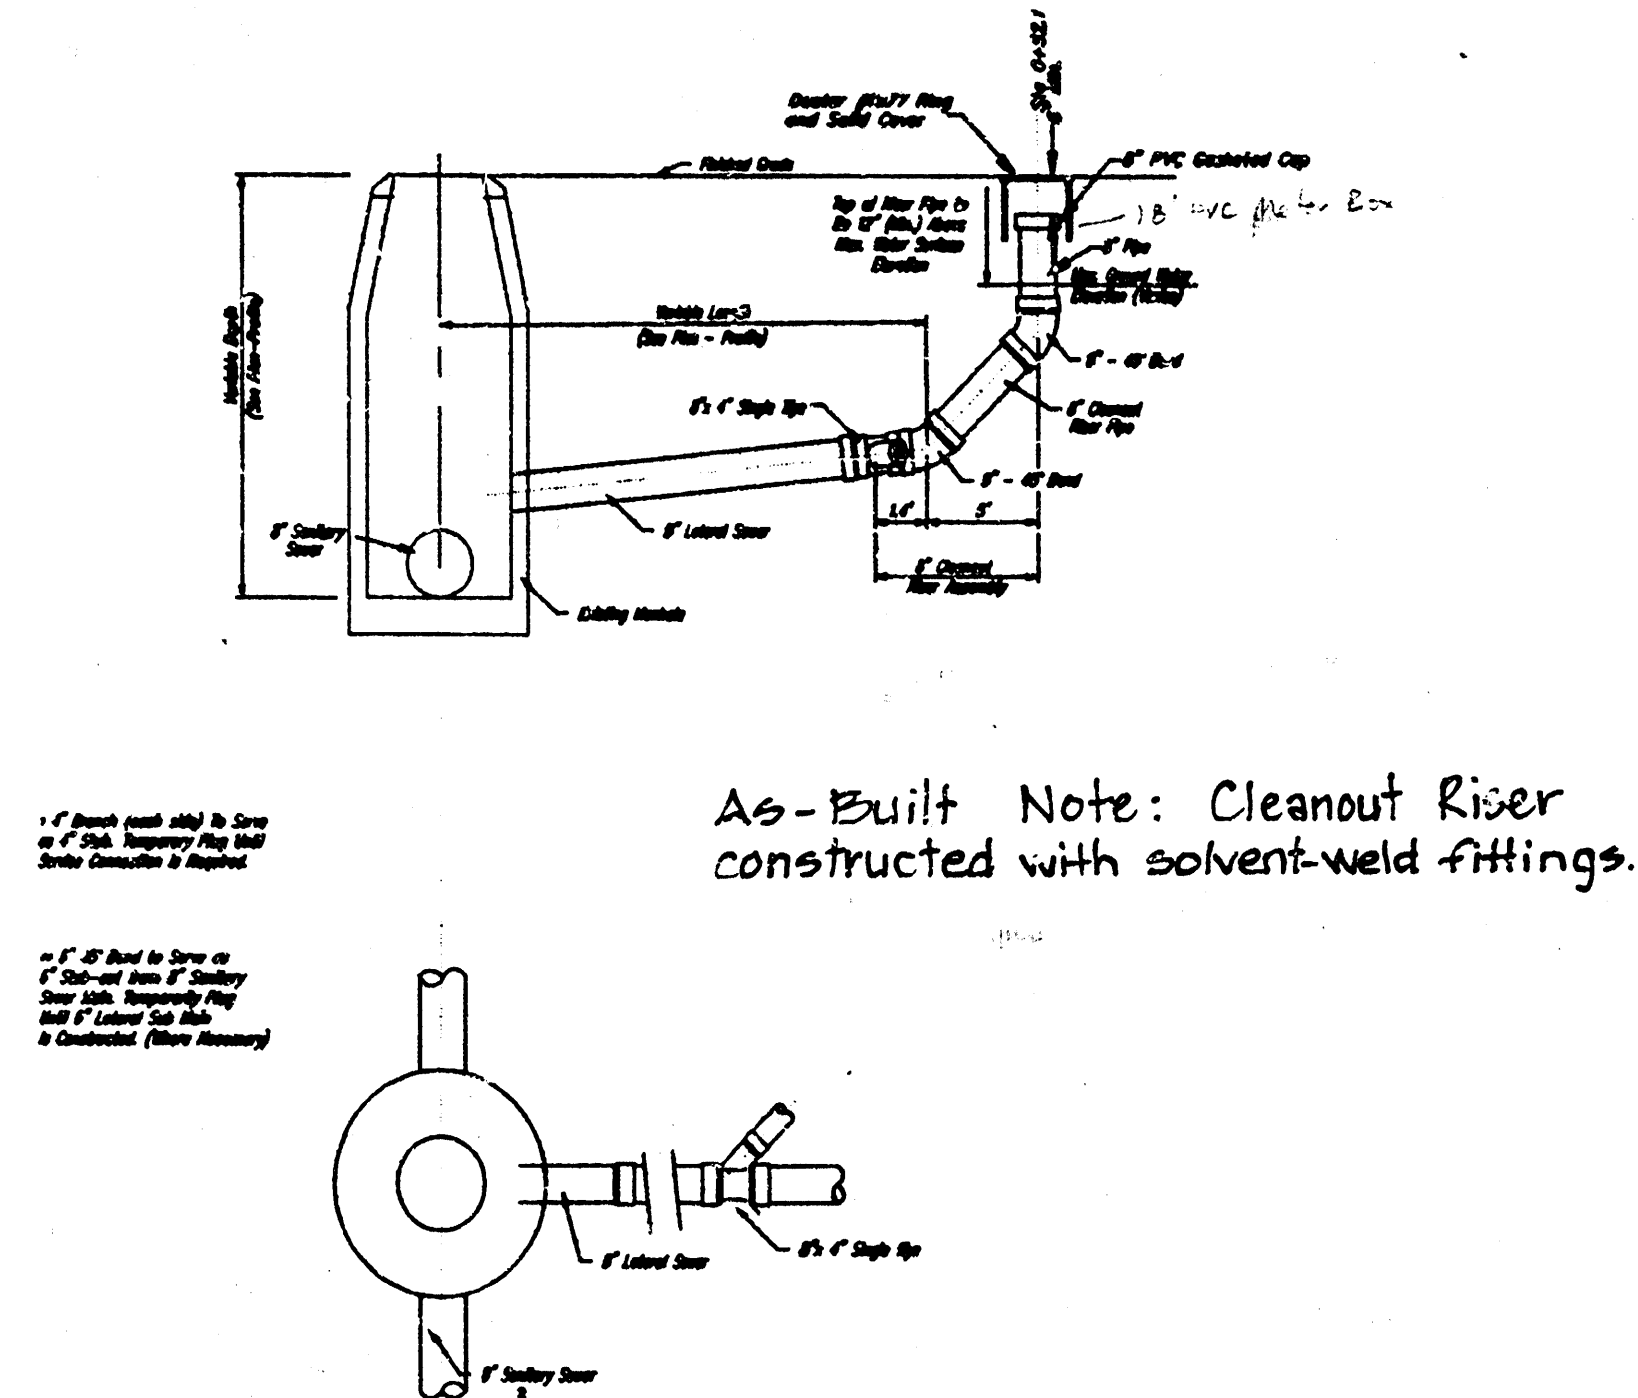

8" CLEANOUT RISER ASSEMBLY DETAIL

General Notes

1. The Contractor shall give all property owners and/or tenants of developed property directly abutting the construction of this project a minimum of ten (10) days advance notice prior to start of construction.
2. The Contractor shall be responsible for preserving property irons. The Contractor will be required to re-establish any property irons which are damaged or destroyed by his construction operations. Such irons shall be re-established by a licensed land surveyor in accordance with state laws.
3. The Contractor shall maintain one lane of traffic open during construction.
4. The Contractor shall be responsible for costs and arrangements for any necessary relocation of KG & E pole and/or guy.

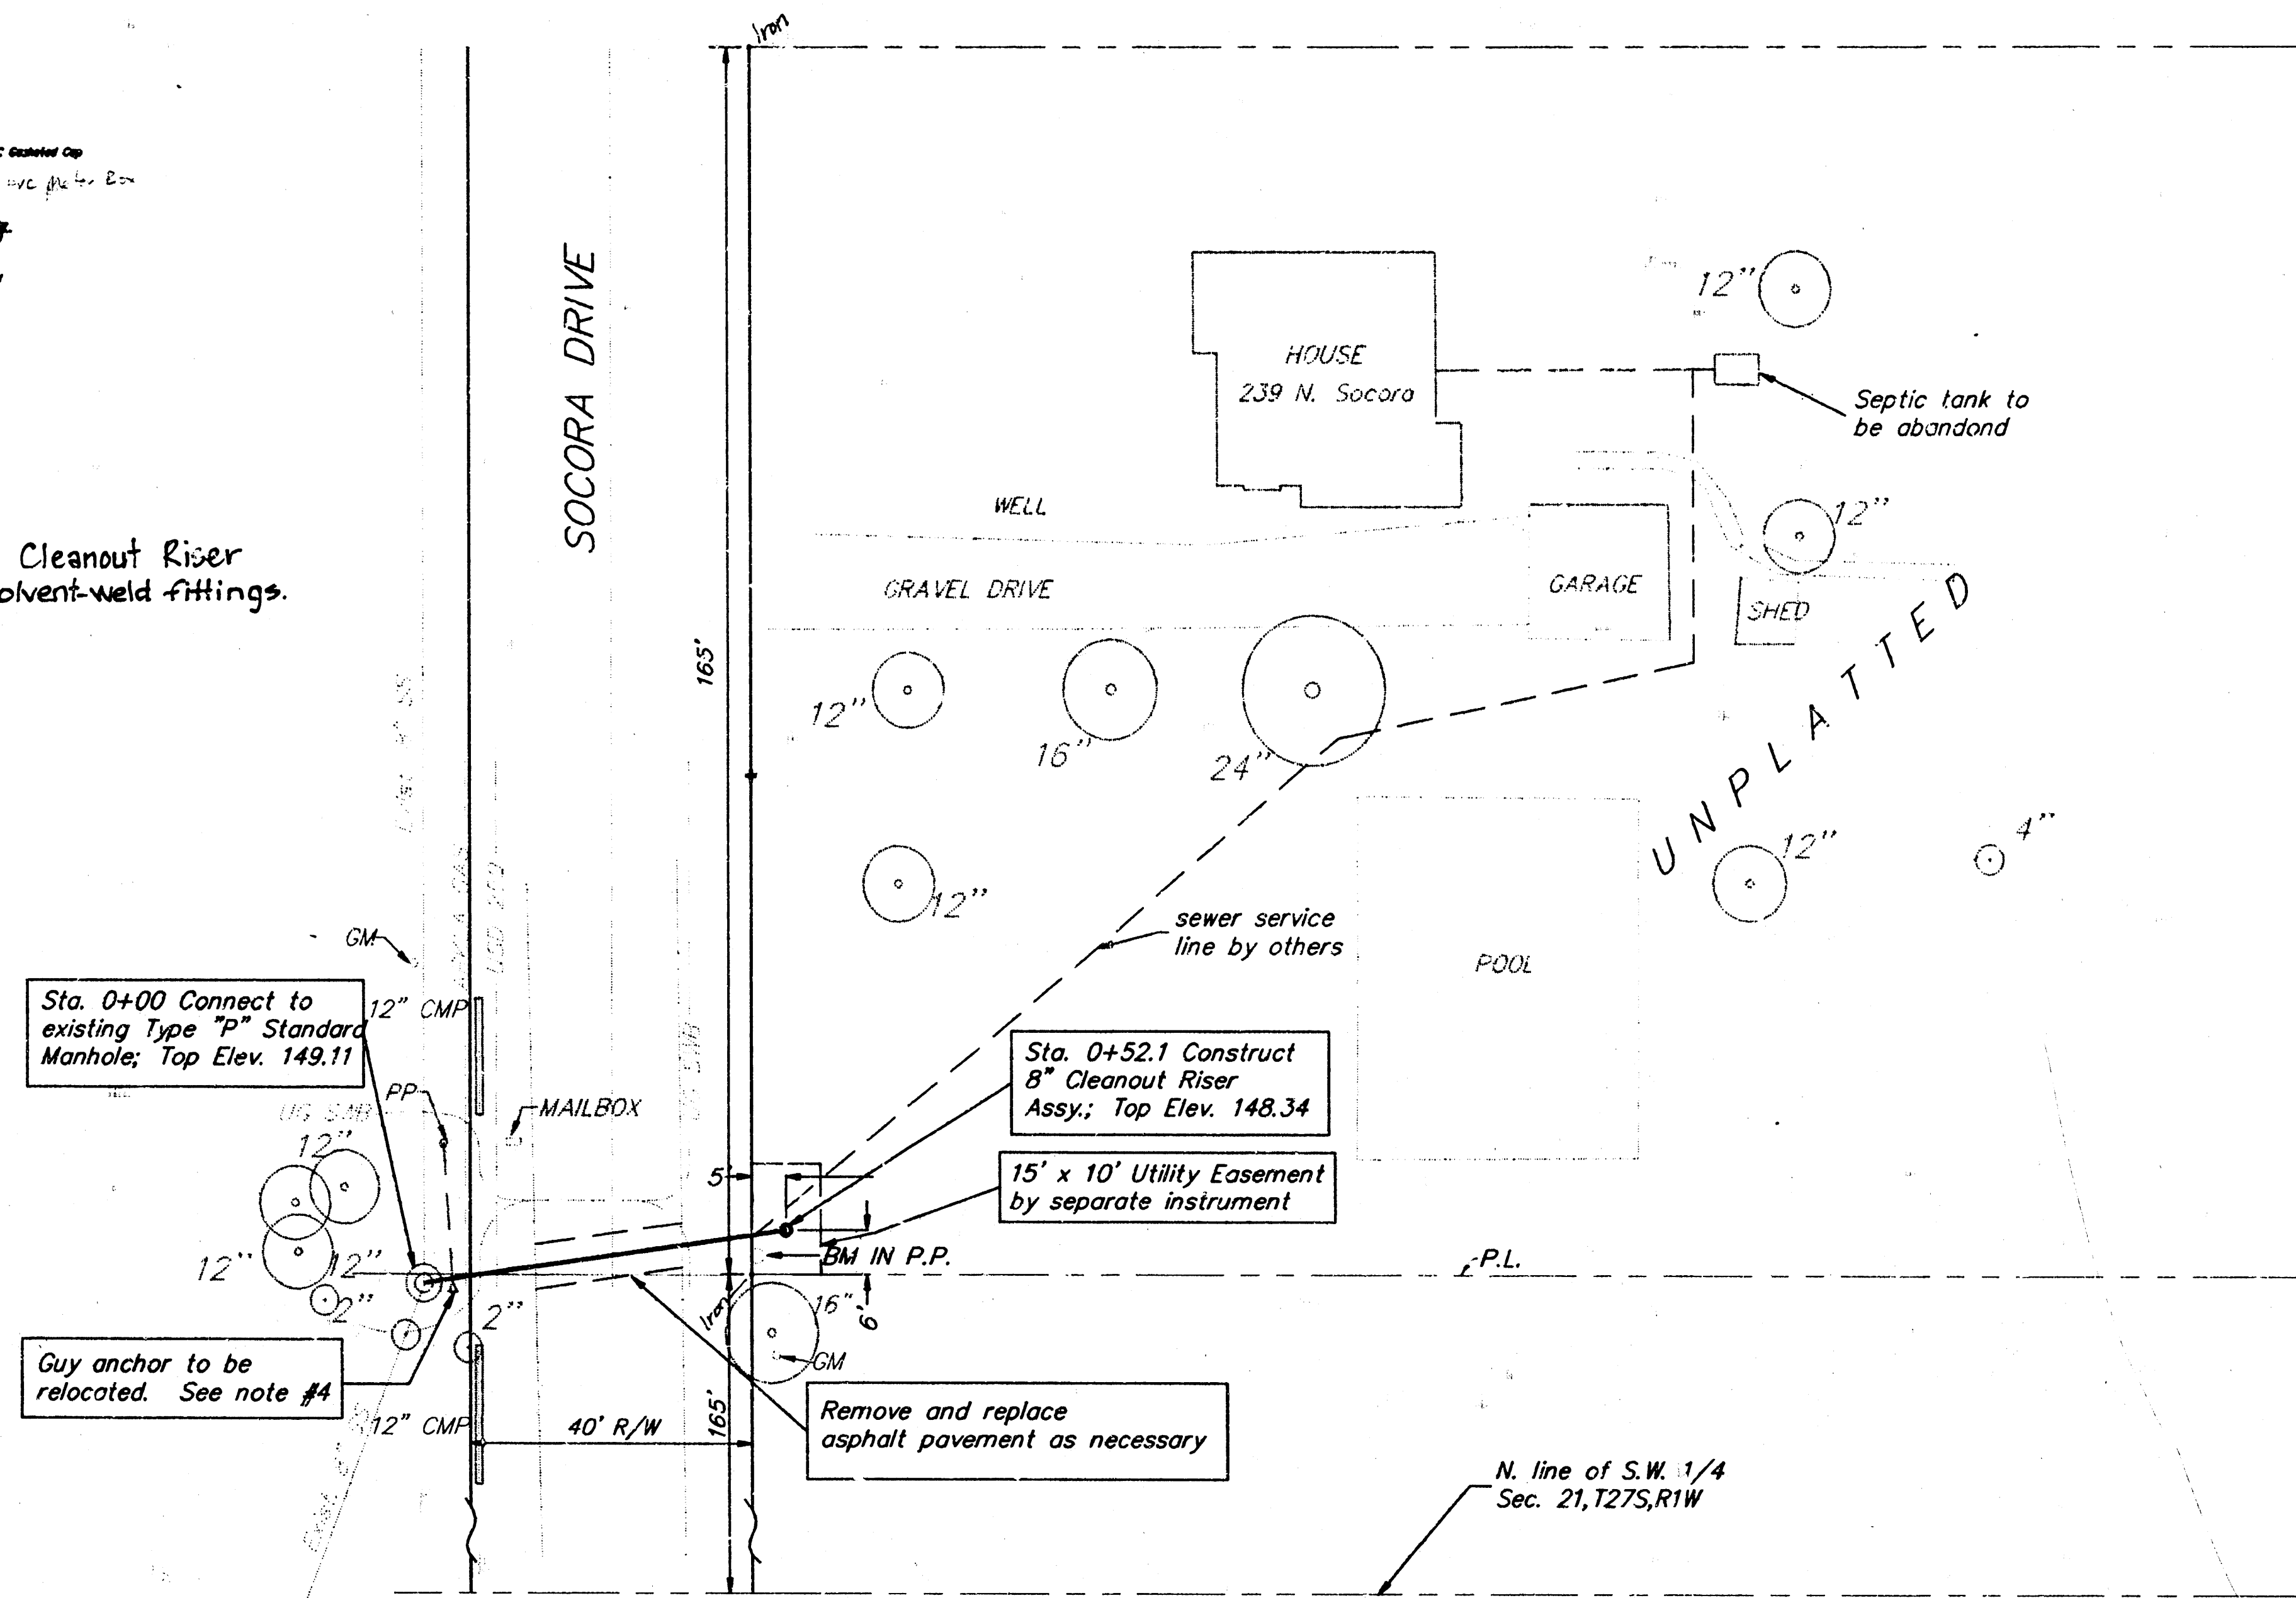


APPROVED AS NOTED
BY CITY ENGINEER OF WICHITA

Sanitary Sewer: 12\"/>


NOTE TO CONTRACTORS

Inspection and testing for this project is to be provided by a Licensed Consulting Engineer. The Engineer shall be responsible for the design and construction of the project. The Contractor shall be responsible for the construction and installation of the project. The Contractor shall be responsible for the maintenance and repair of the project.

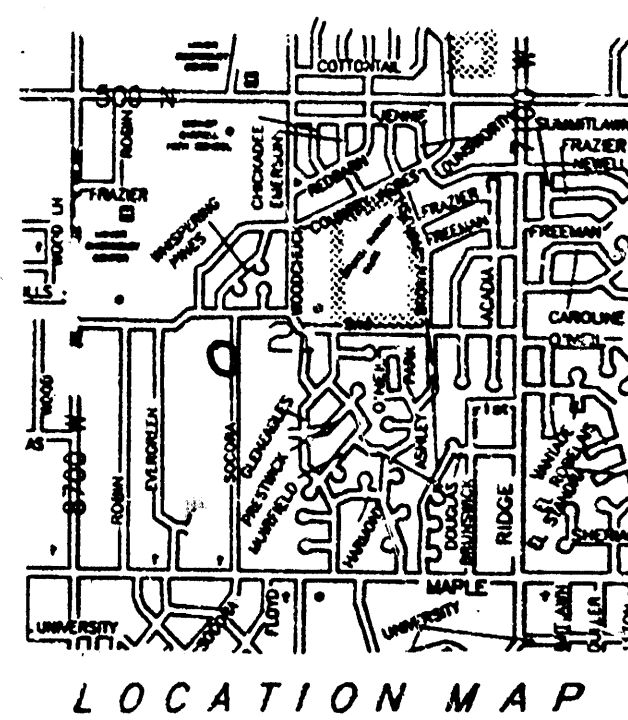


SCALE 1" = 20' Horiz.
1" = 5' Vert.

BENCH MARK: 60 D step bench East side H.L.P.
2.5' Side & 1.8' West of Northeast corner property.
B.M. ELEV. = 148.96

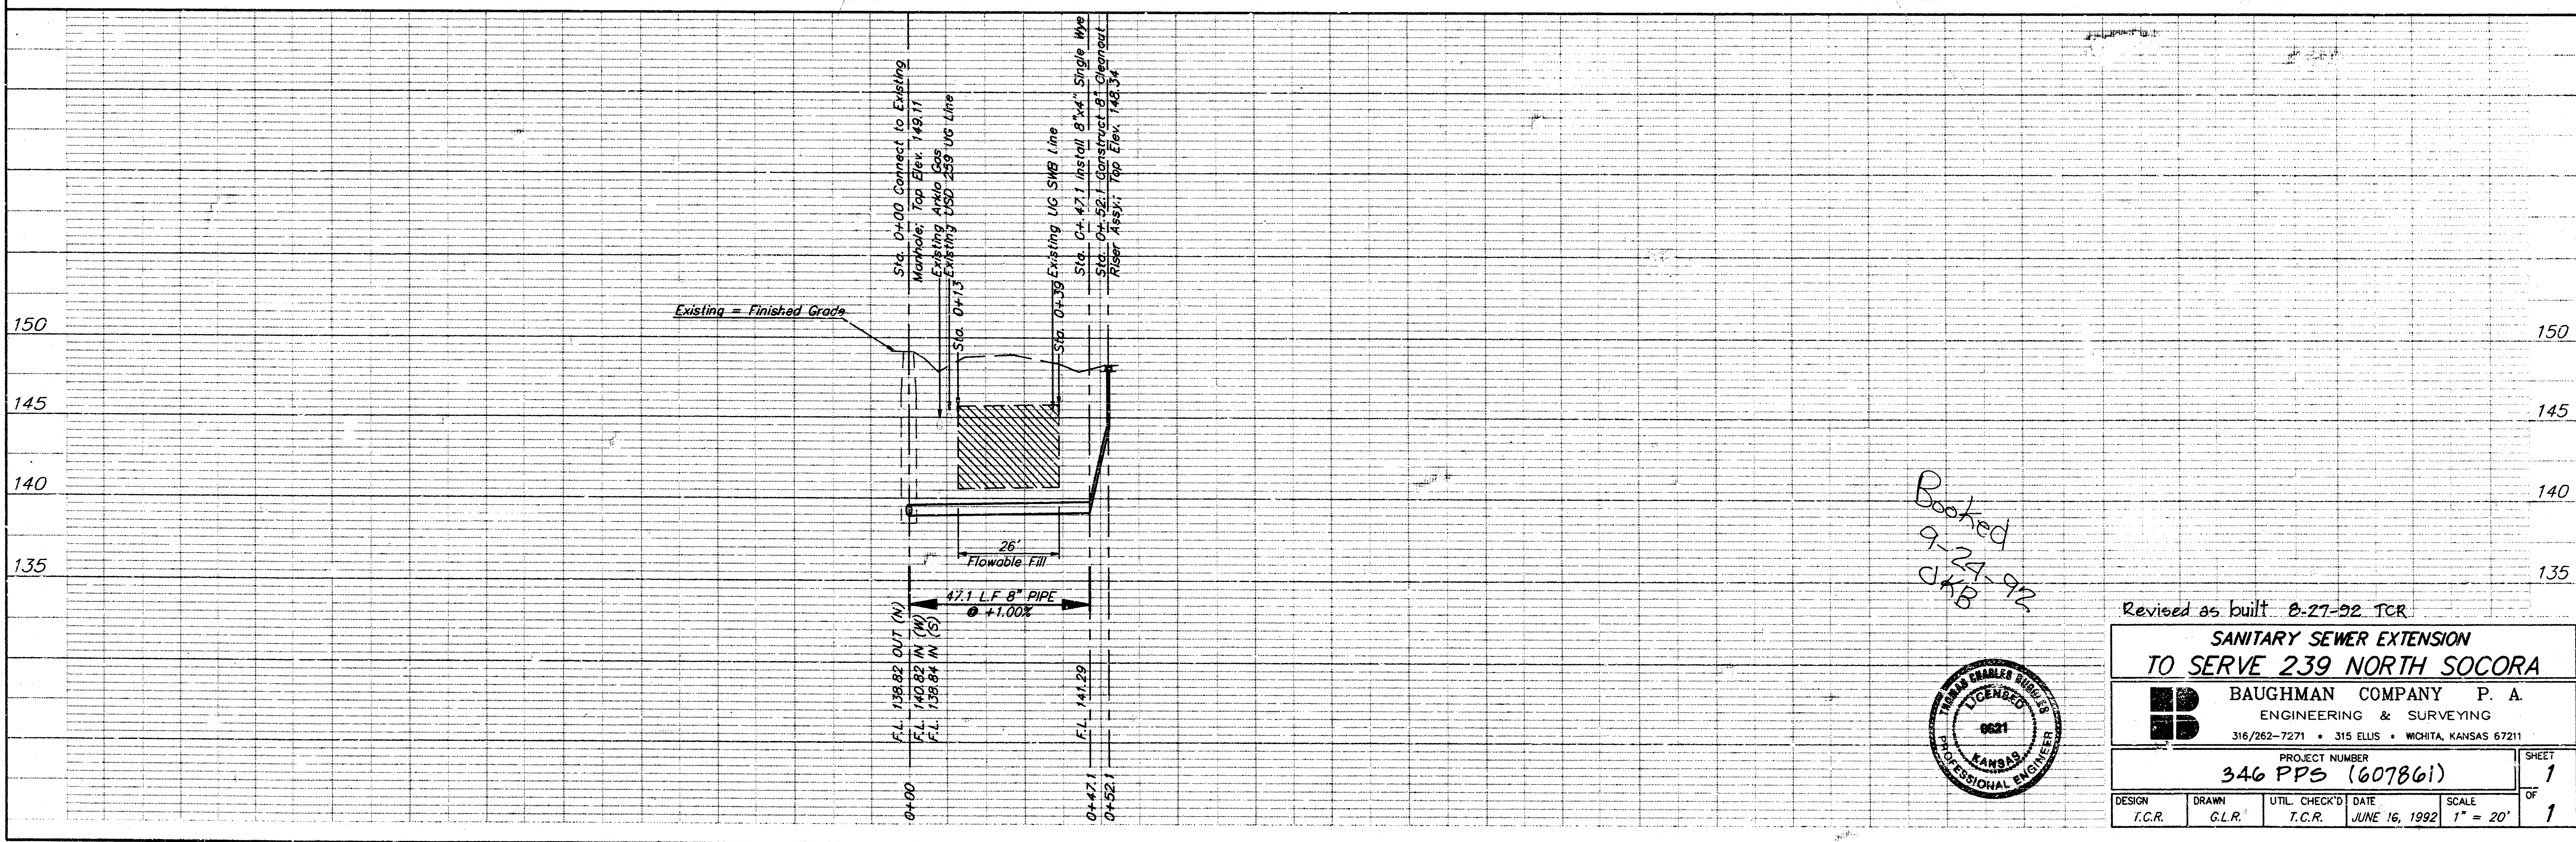

Booked
9-24-92
CAB

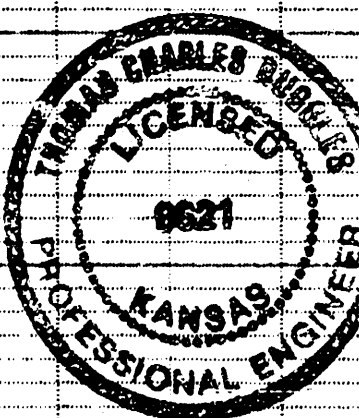

Revised as built 8-27-92 TCR

**SANITARY SEWER EXTENSION
TO SERVE 239 NORTH SOCORA**

BAUGHMAN COMPANY P.A.
ENGINEERING & SURVEYING
316/262-7271 • 315 ELLIS • WICHITA, KANSAS 67211

PROJECT NUMBER
346 PPS (607861)

DESIGN: T.C.R. DRAWN: G.L.R. UTIL. CHECK'D: T.C.R. DATE: JUNE 16, 1992 SCALE: 1" = 20'

SHEET 1 OF 1