



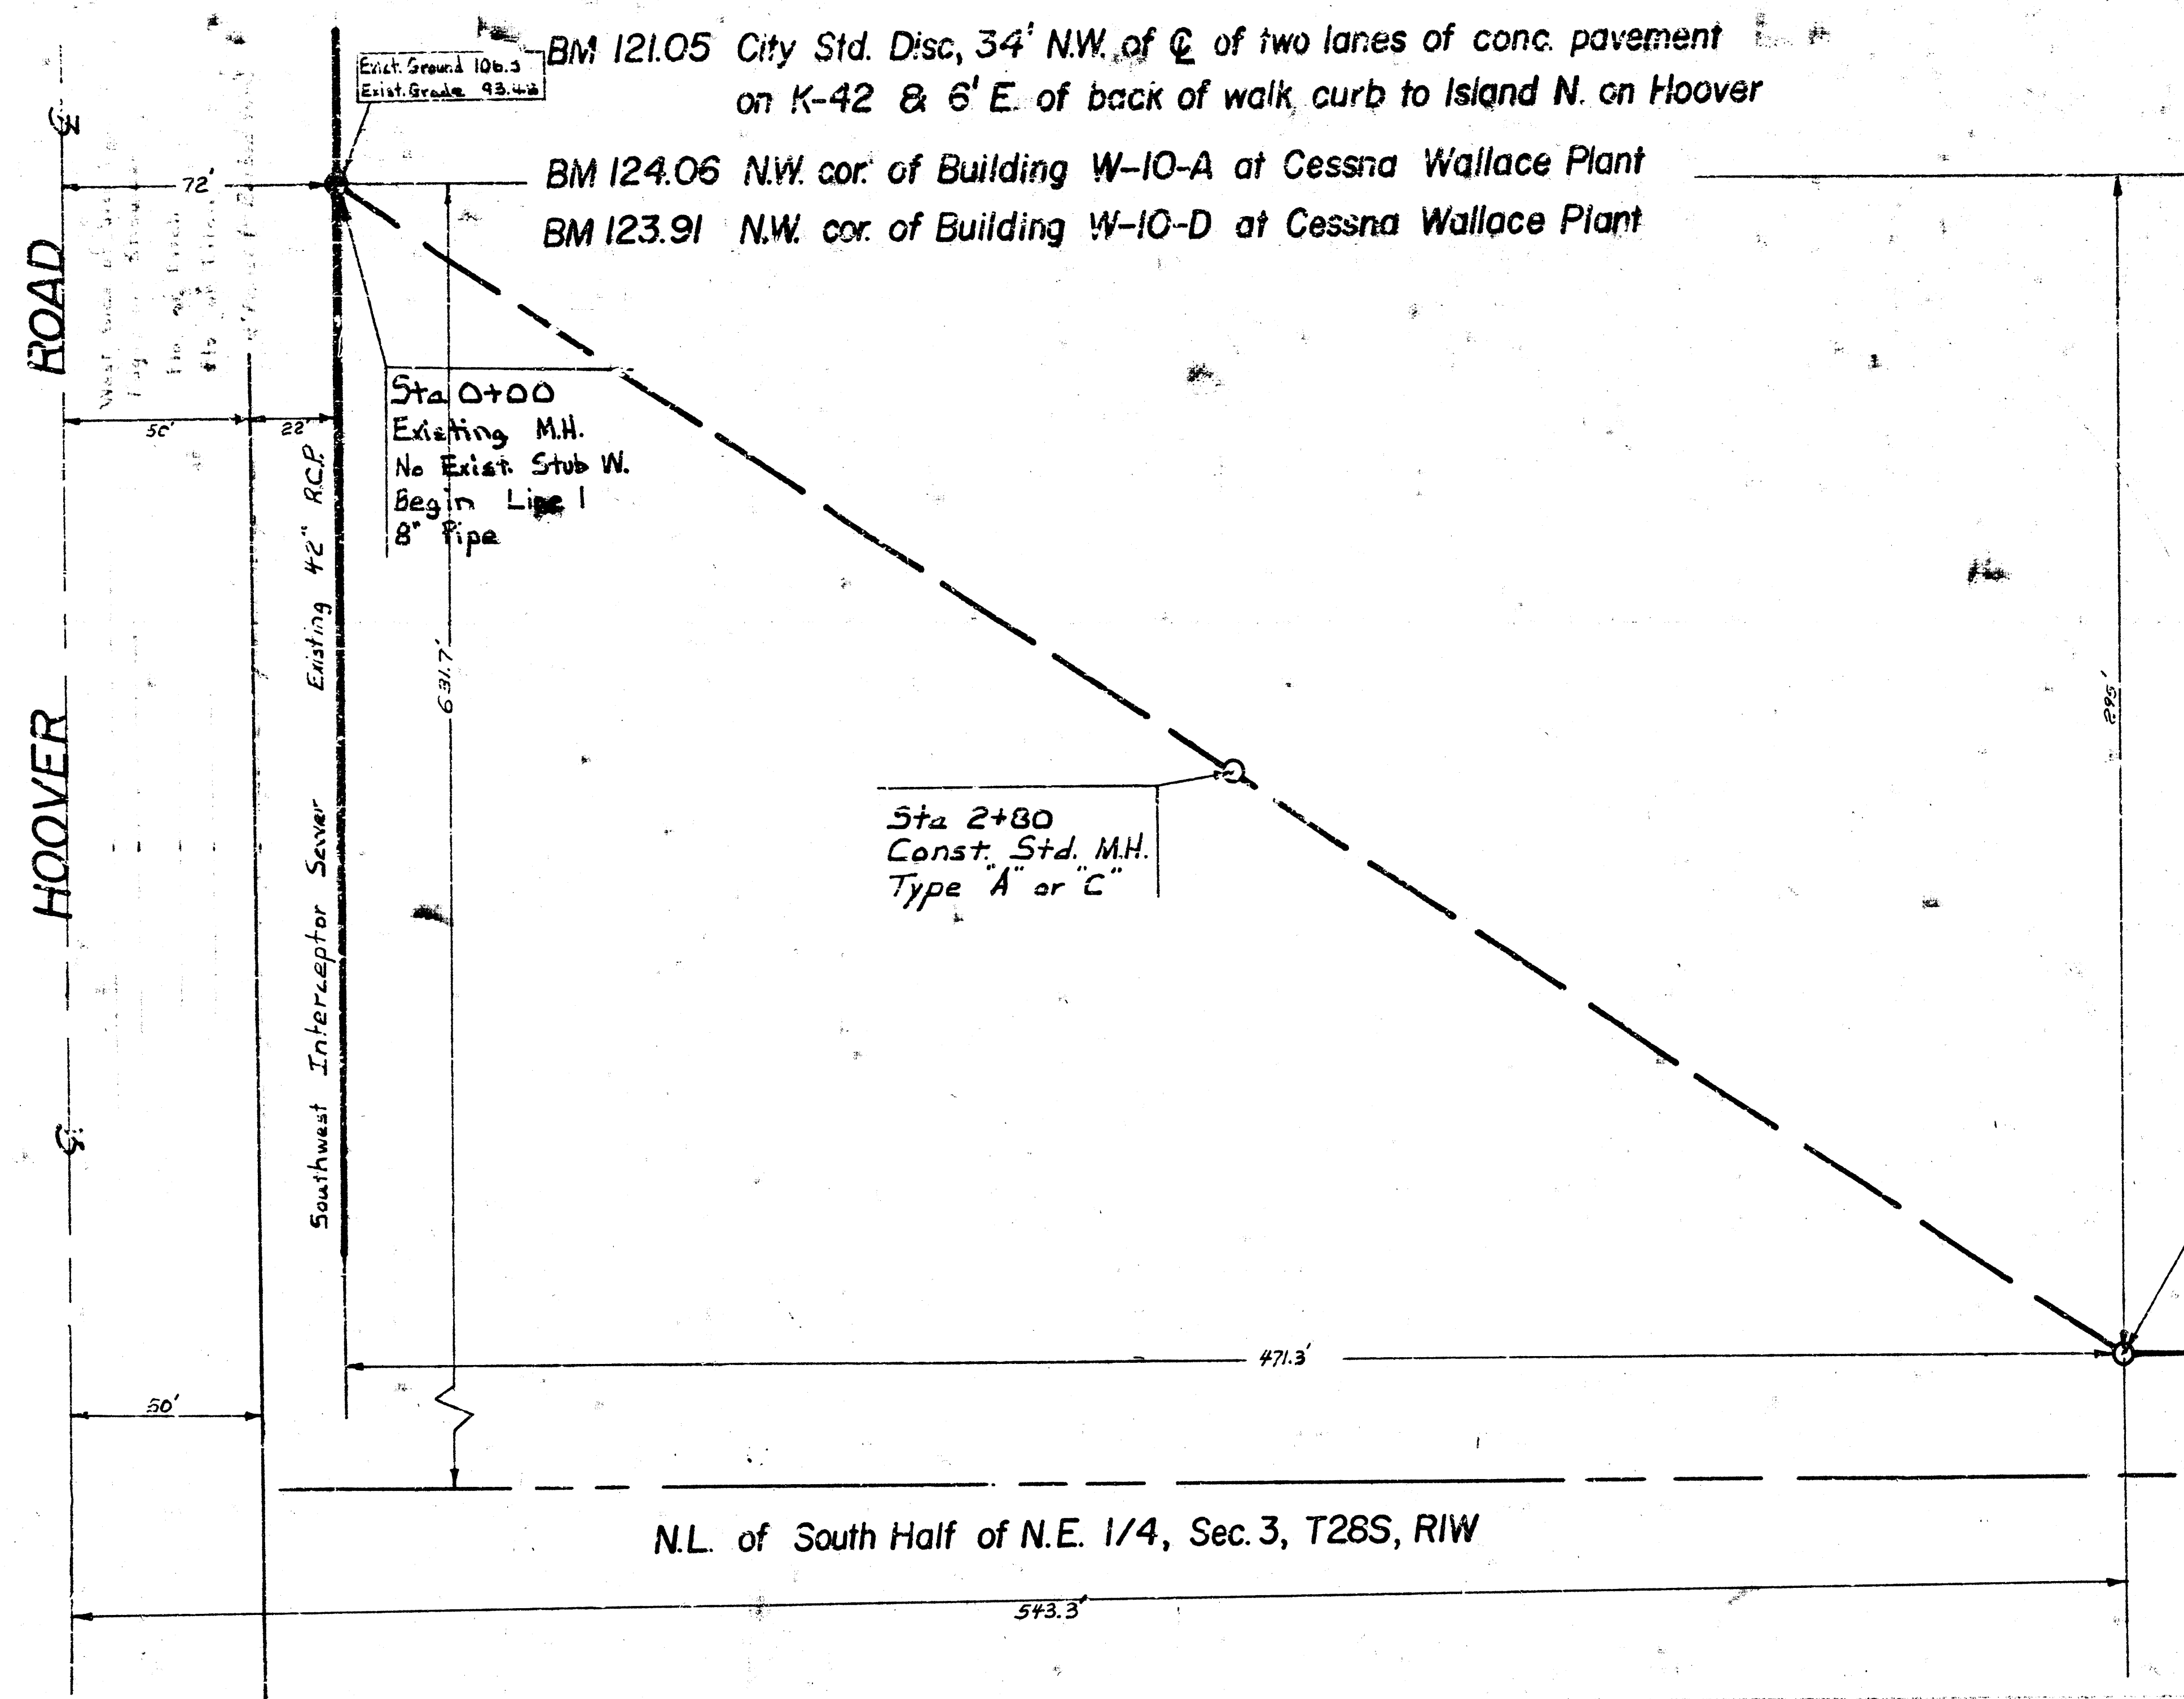




Plan Scale 1" = 40'



Profile Scale 1" = 40' Hor.
1" = 5' Vert.

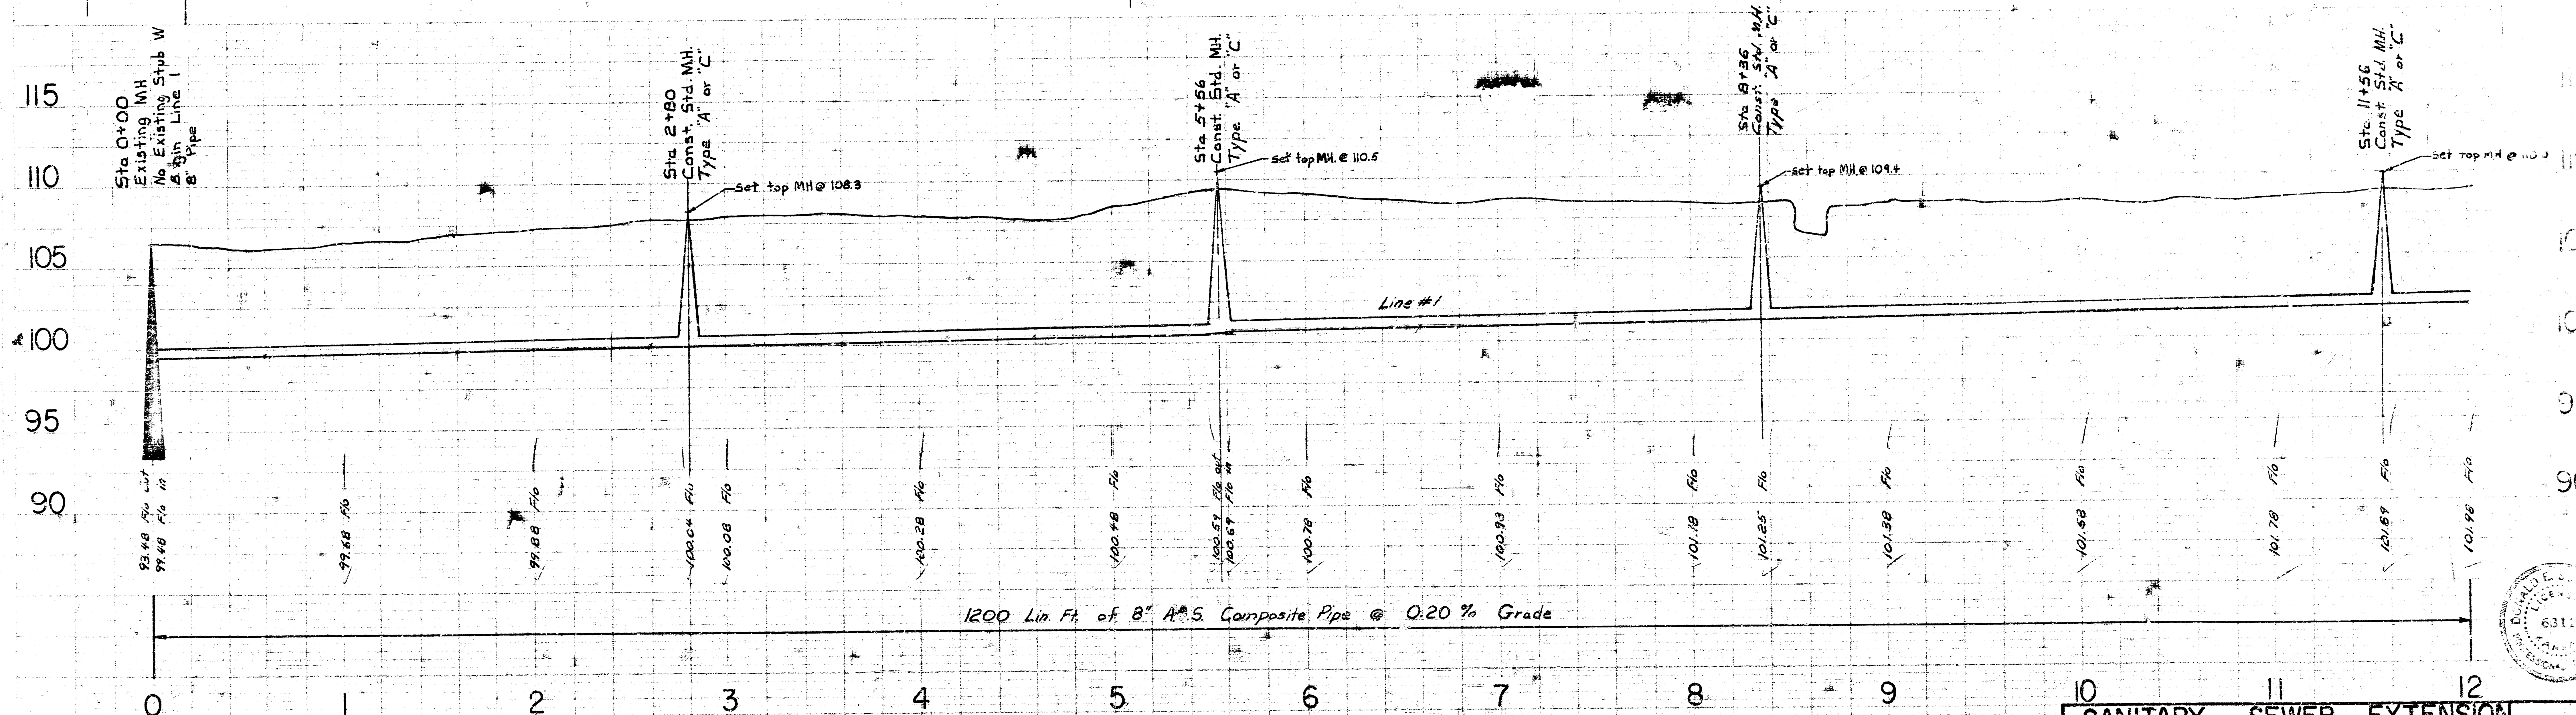



SANITARY SEWER EXTENSION
CESSNA WALLACE PLANT
 West of Hoover Rd. & North of K-42 Highway
 CITY OF WICHITA, KANSAS
 R. W. LINN — CITY ENGINEER
 Private Project No. DBKW706053

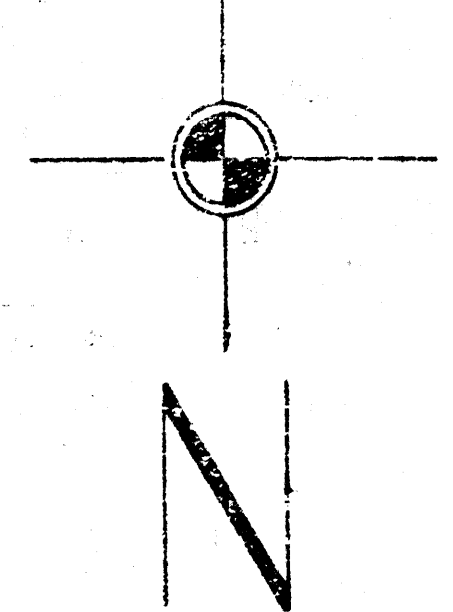

 Plan Scale 1" = 40'
 Profile Scale 1" = 40' Hor.
 1" = 5' Vert.

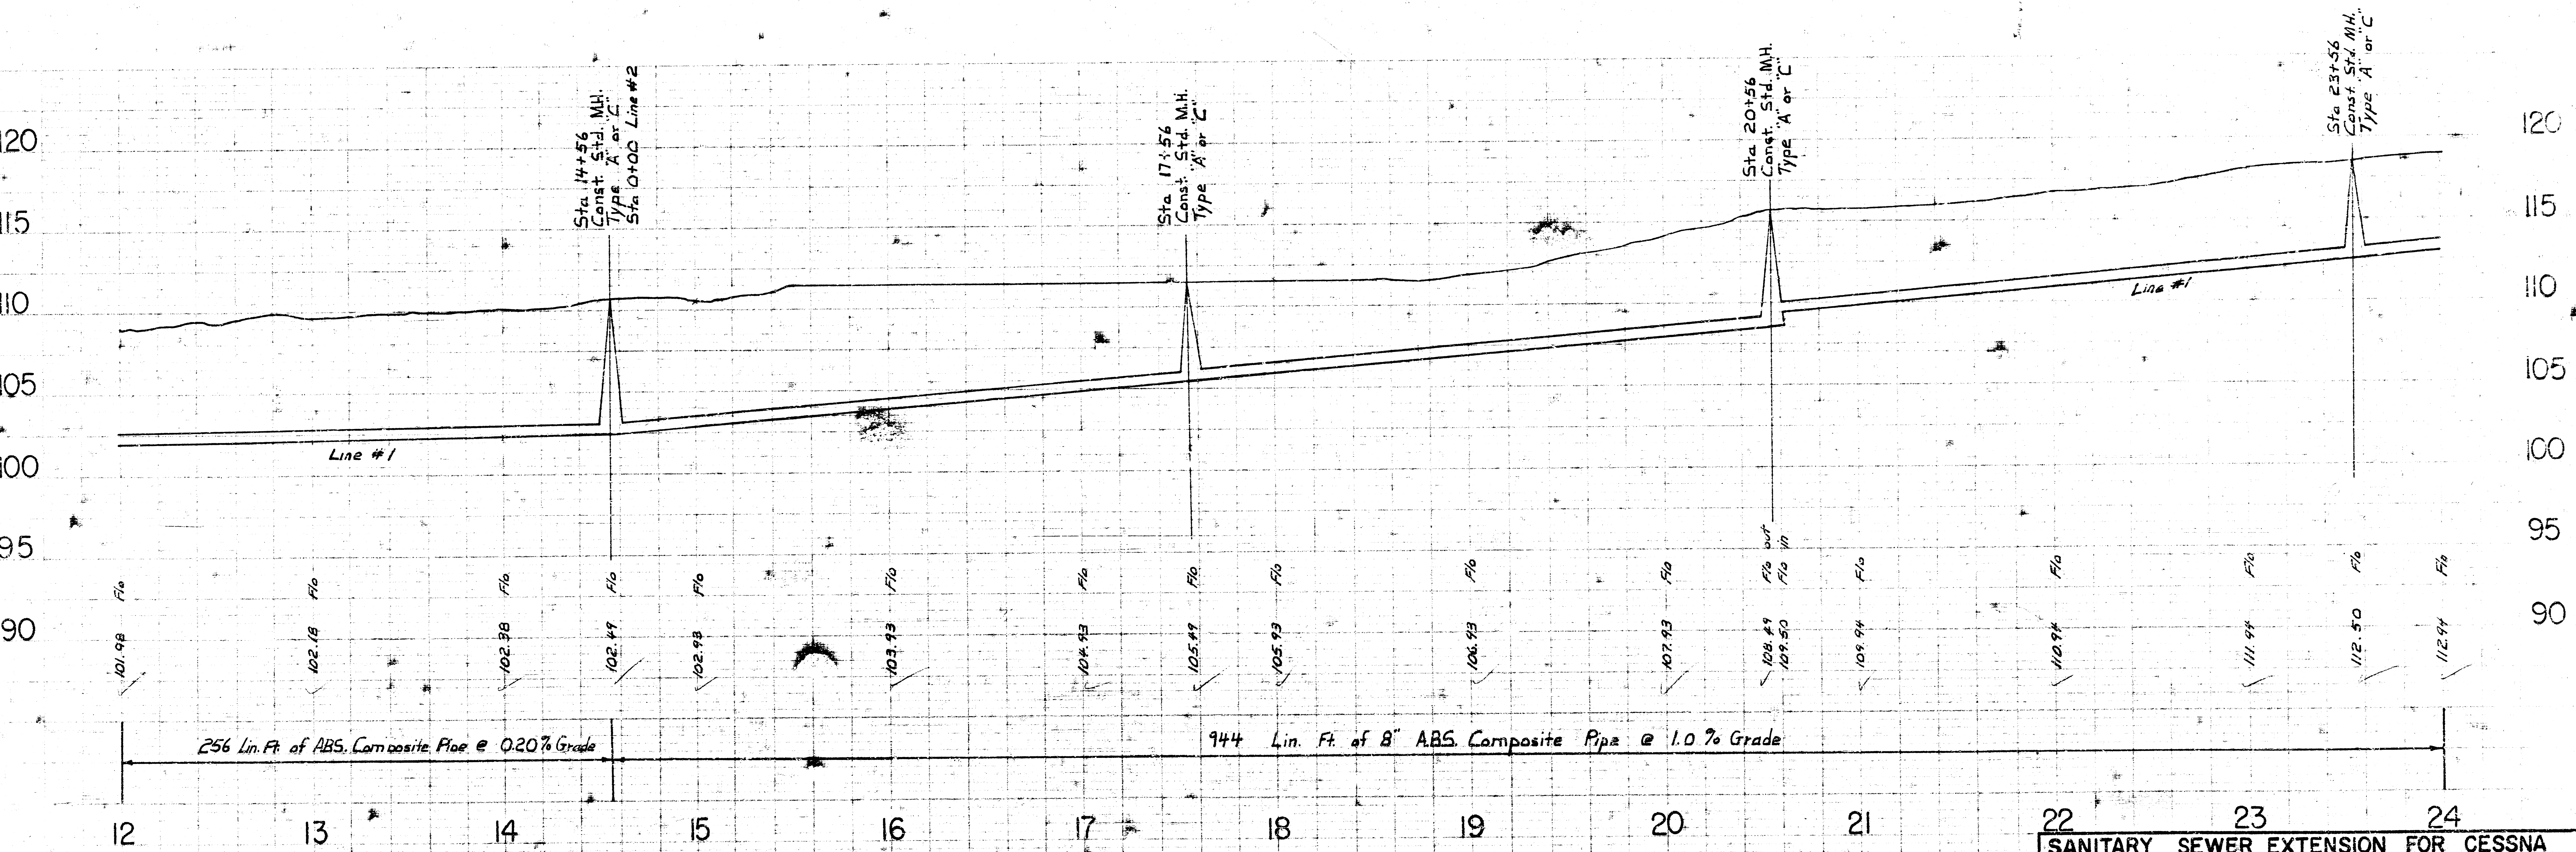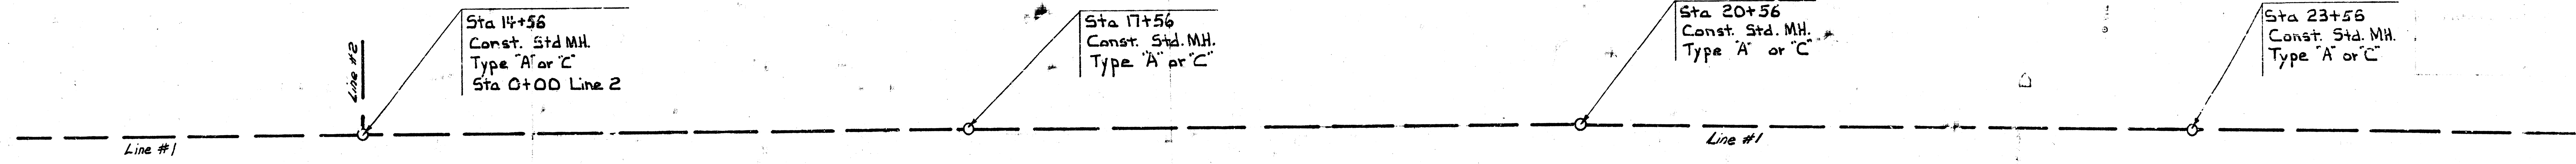

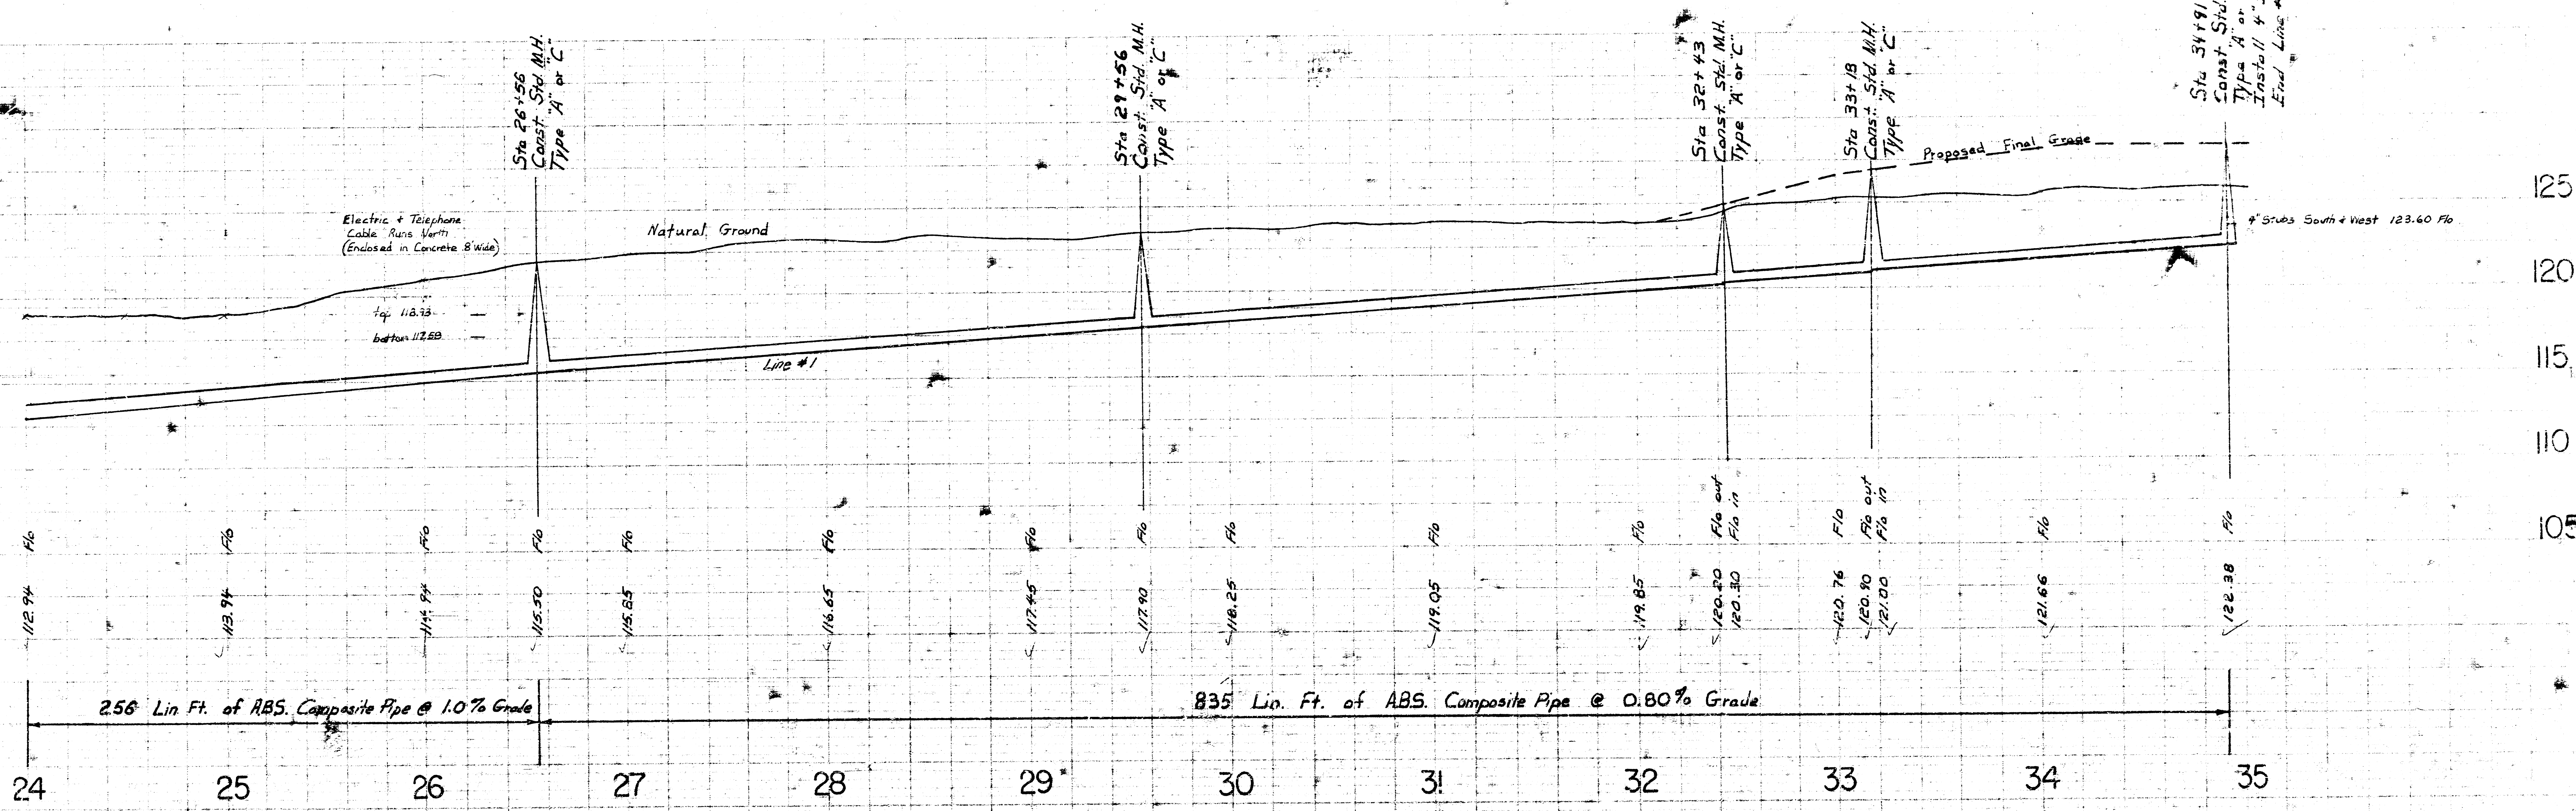
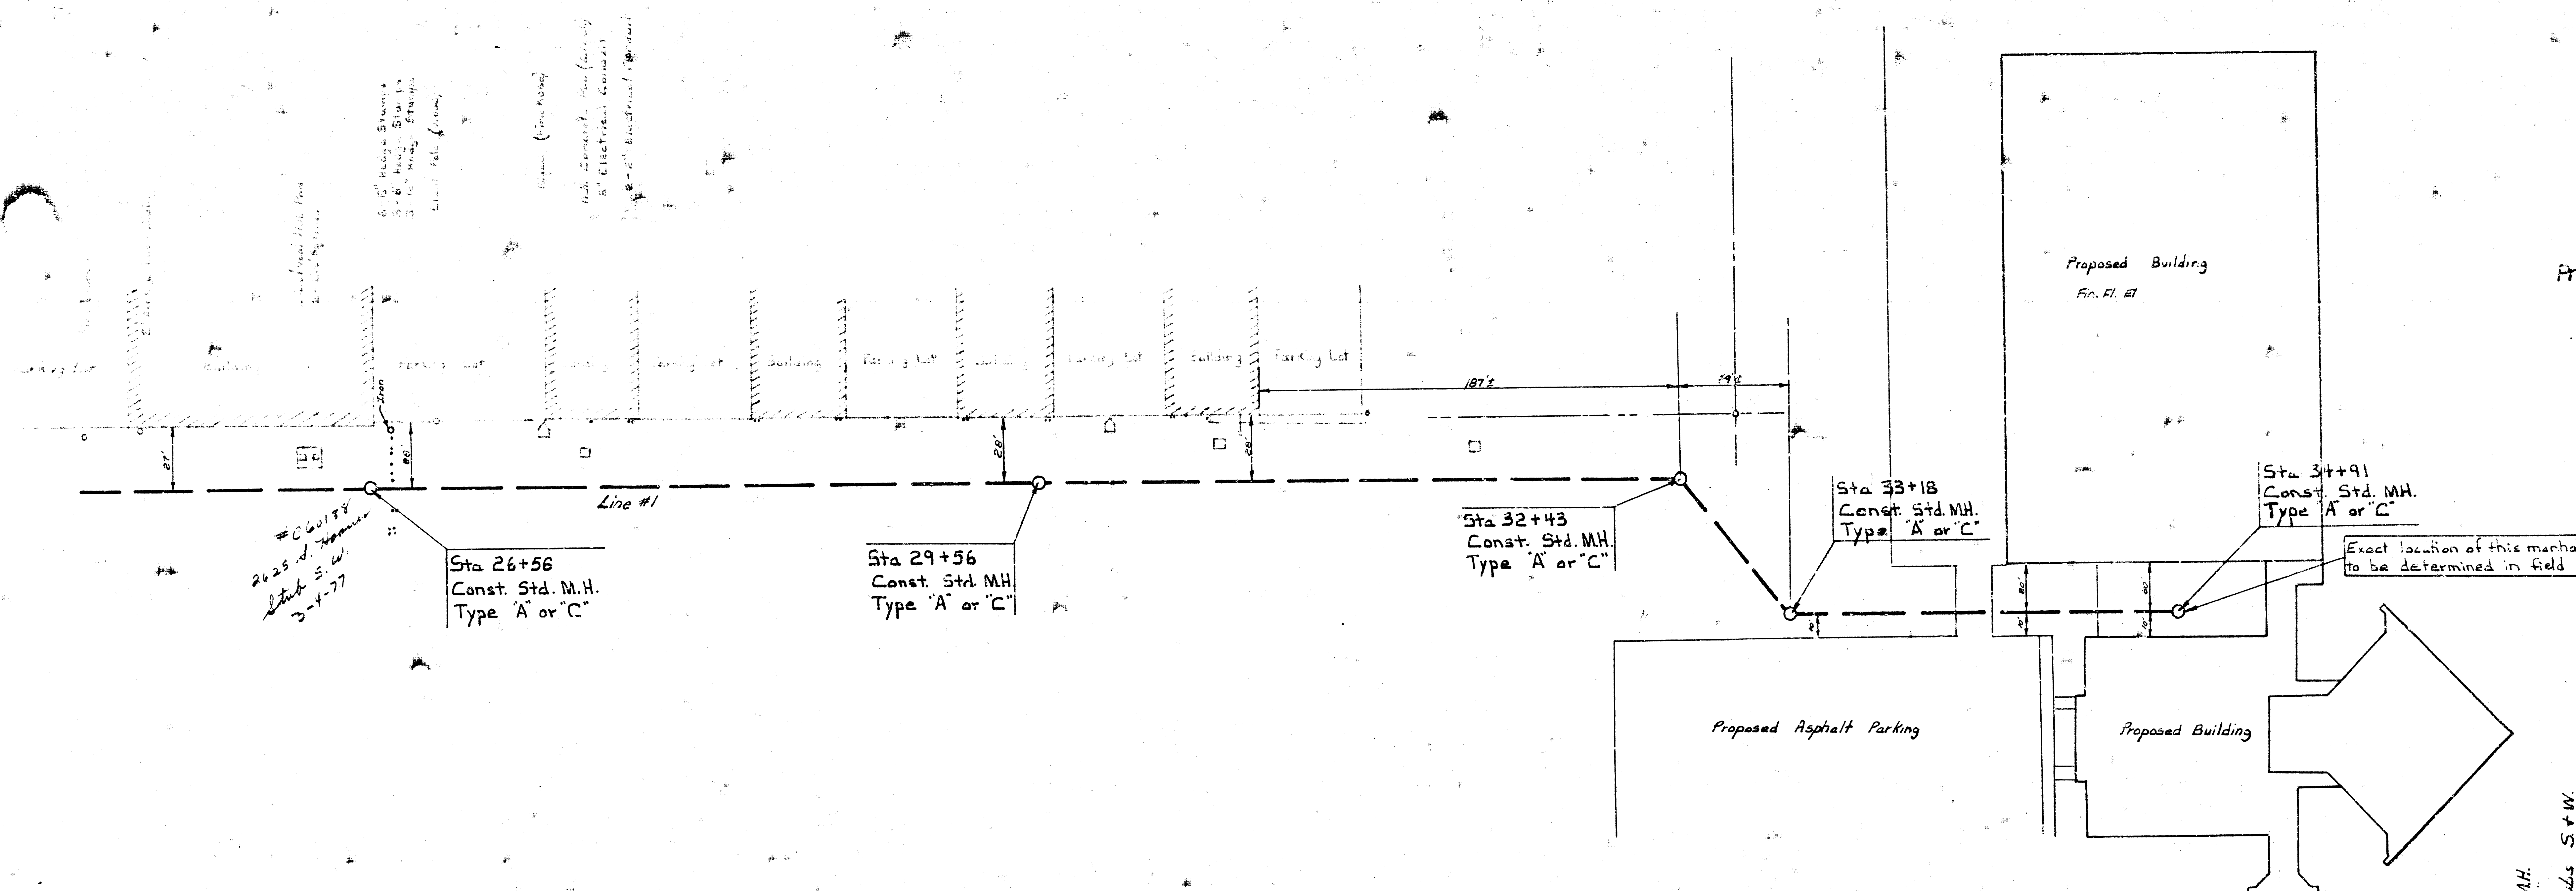


N
 Plan Scale 1" = 40'
 Profile Scale 1" = 40' Hor.
 1" = 5' Vert.

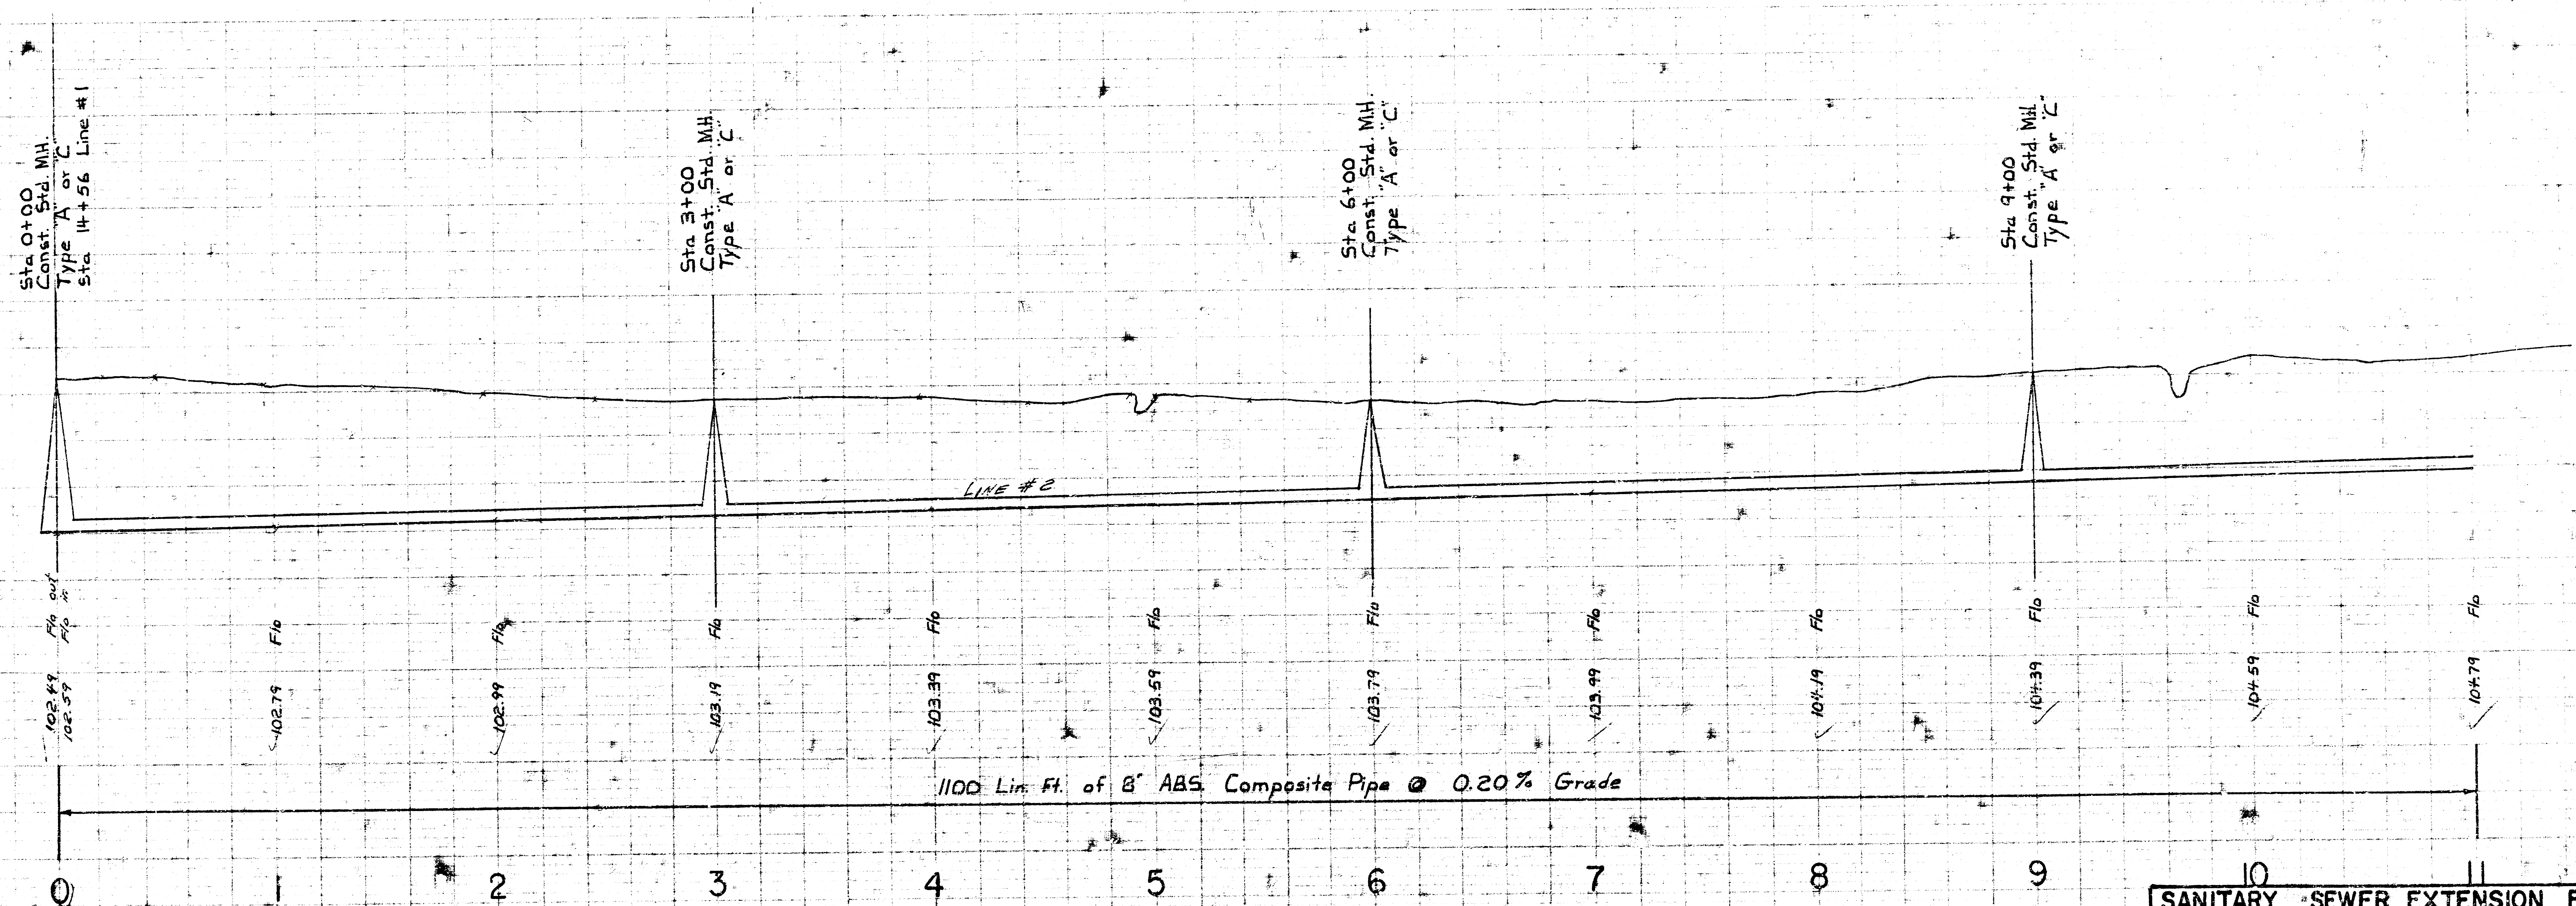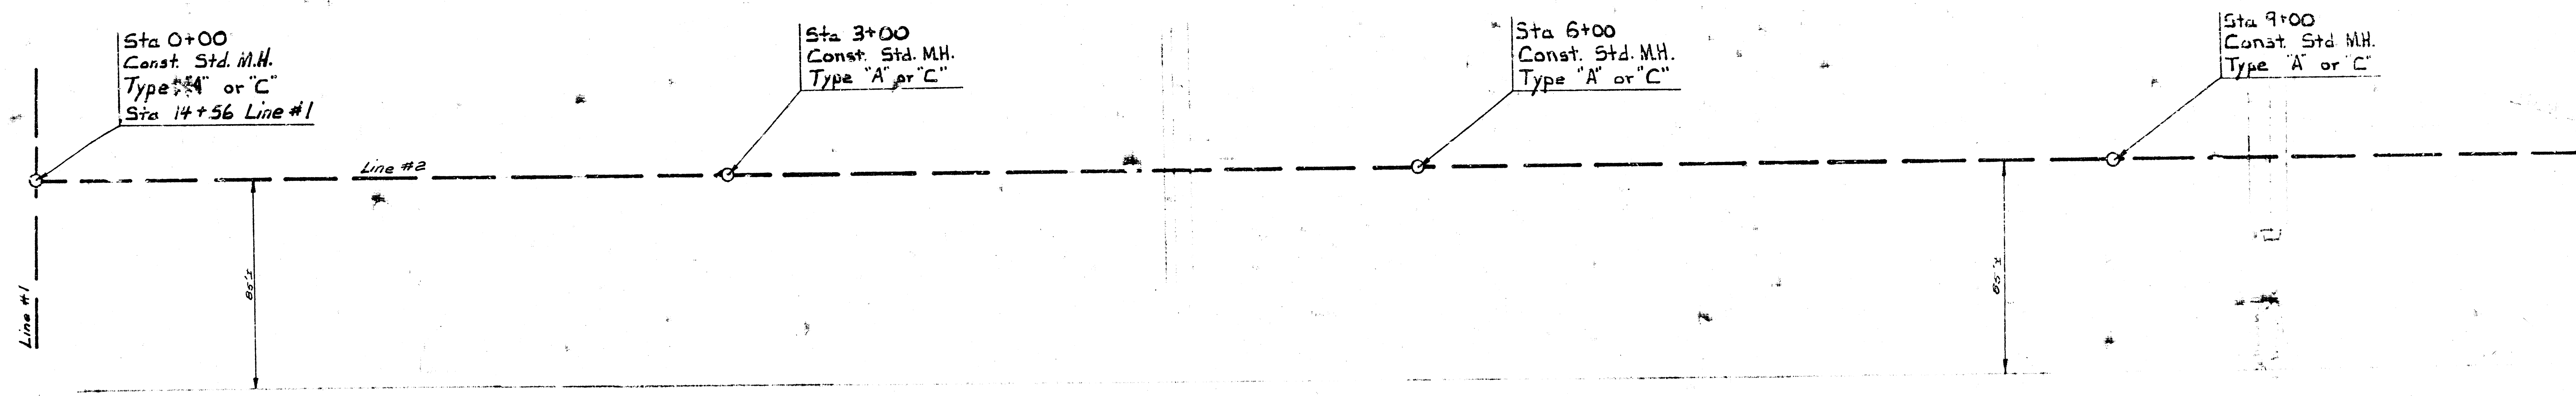

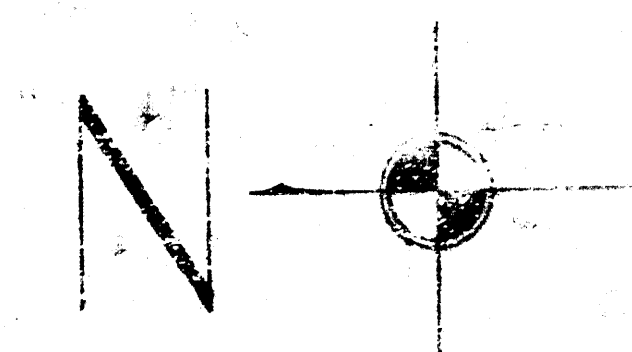



Plan Scale 1" = 40'
Profile Scale 1" = 40' hor
1" = 5' vert

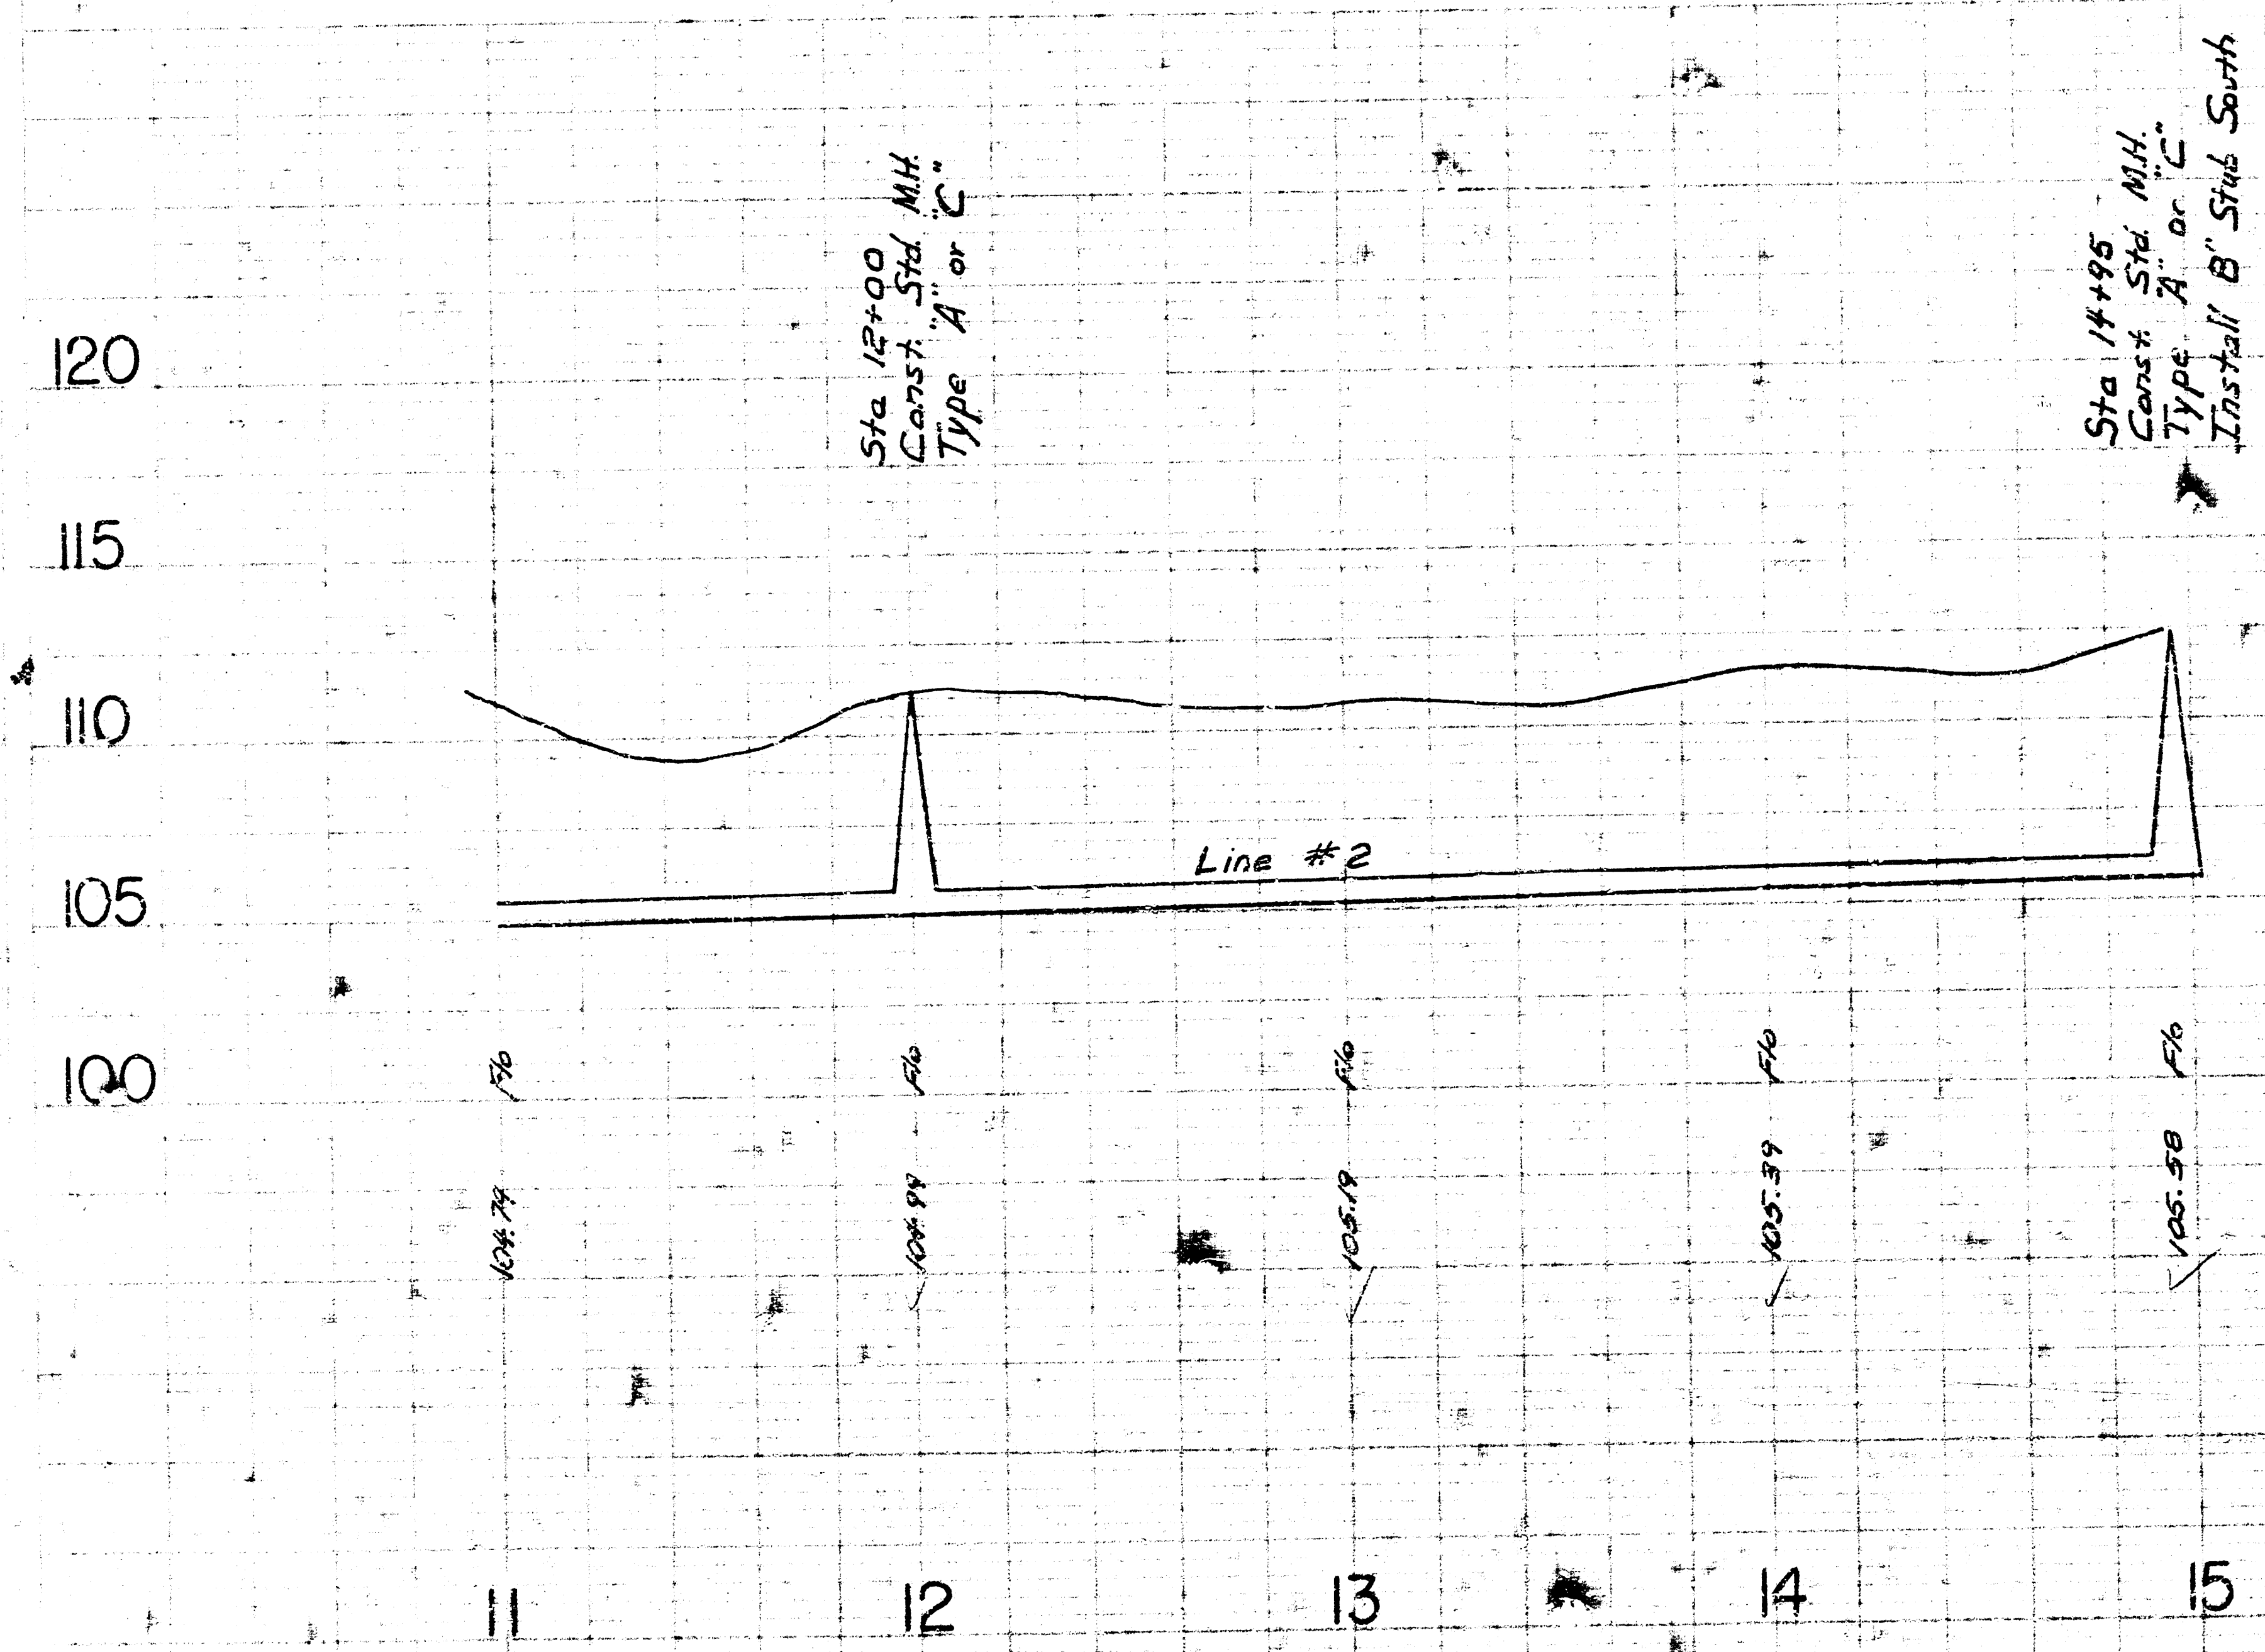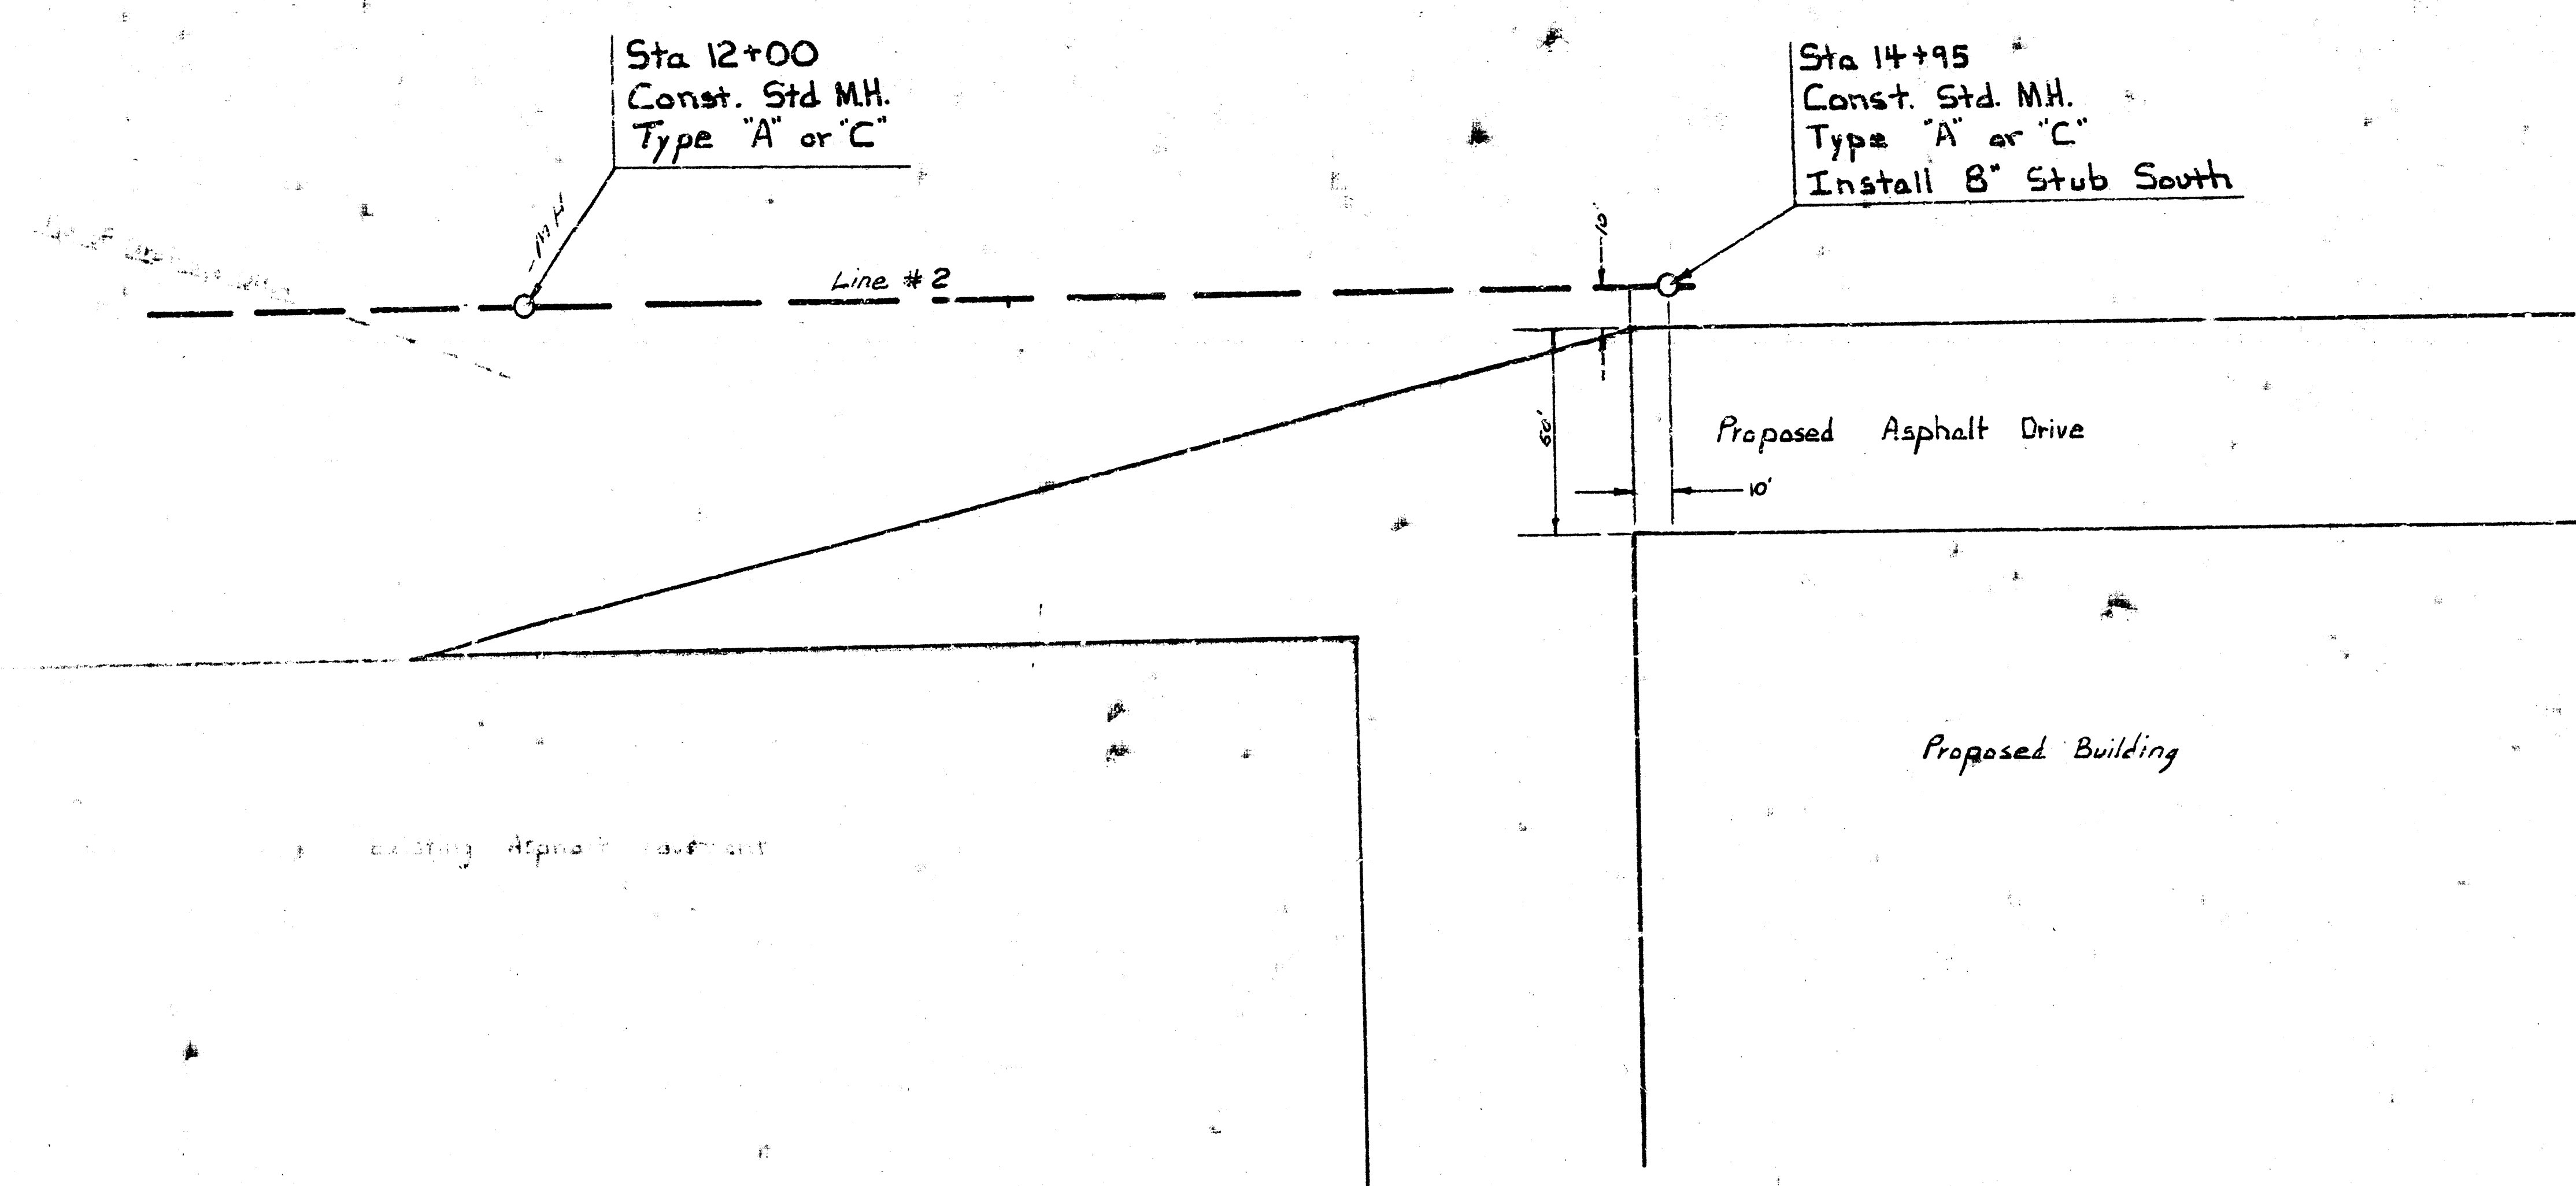

**EXTENSION FOR CESSNA
SANITARY SEWER**
West of Howe Rd. & North of 14th St.
CITY OF WICHITA, KANSAS
R. W. LINN - CITY ENGINEER
Private Project No. 141-11-1


NOTE TO CONTRACTOR
The sewer line to be installed under the driveway shall be 12" diameter and shall be installed at a depth of 48" below finished ground. The sewer line shall be installed in a trench 24" wide and 48" deep. The trench shall be backfilled with sand and gravel. The sewer line shall be tested with water before being covered.

APPROVED AS NOTED
BY CITY ENGINEER OF WICHITA
R. W. LINN
2-1-78

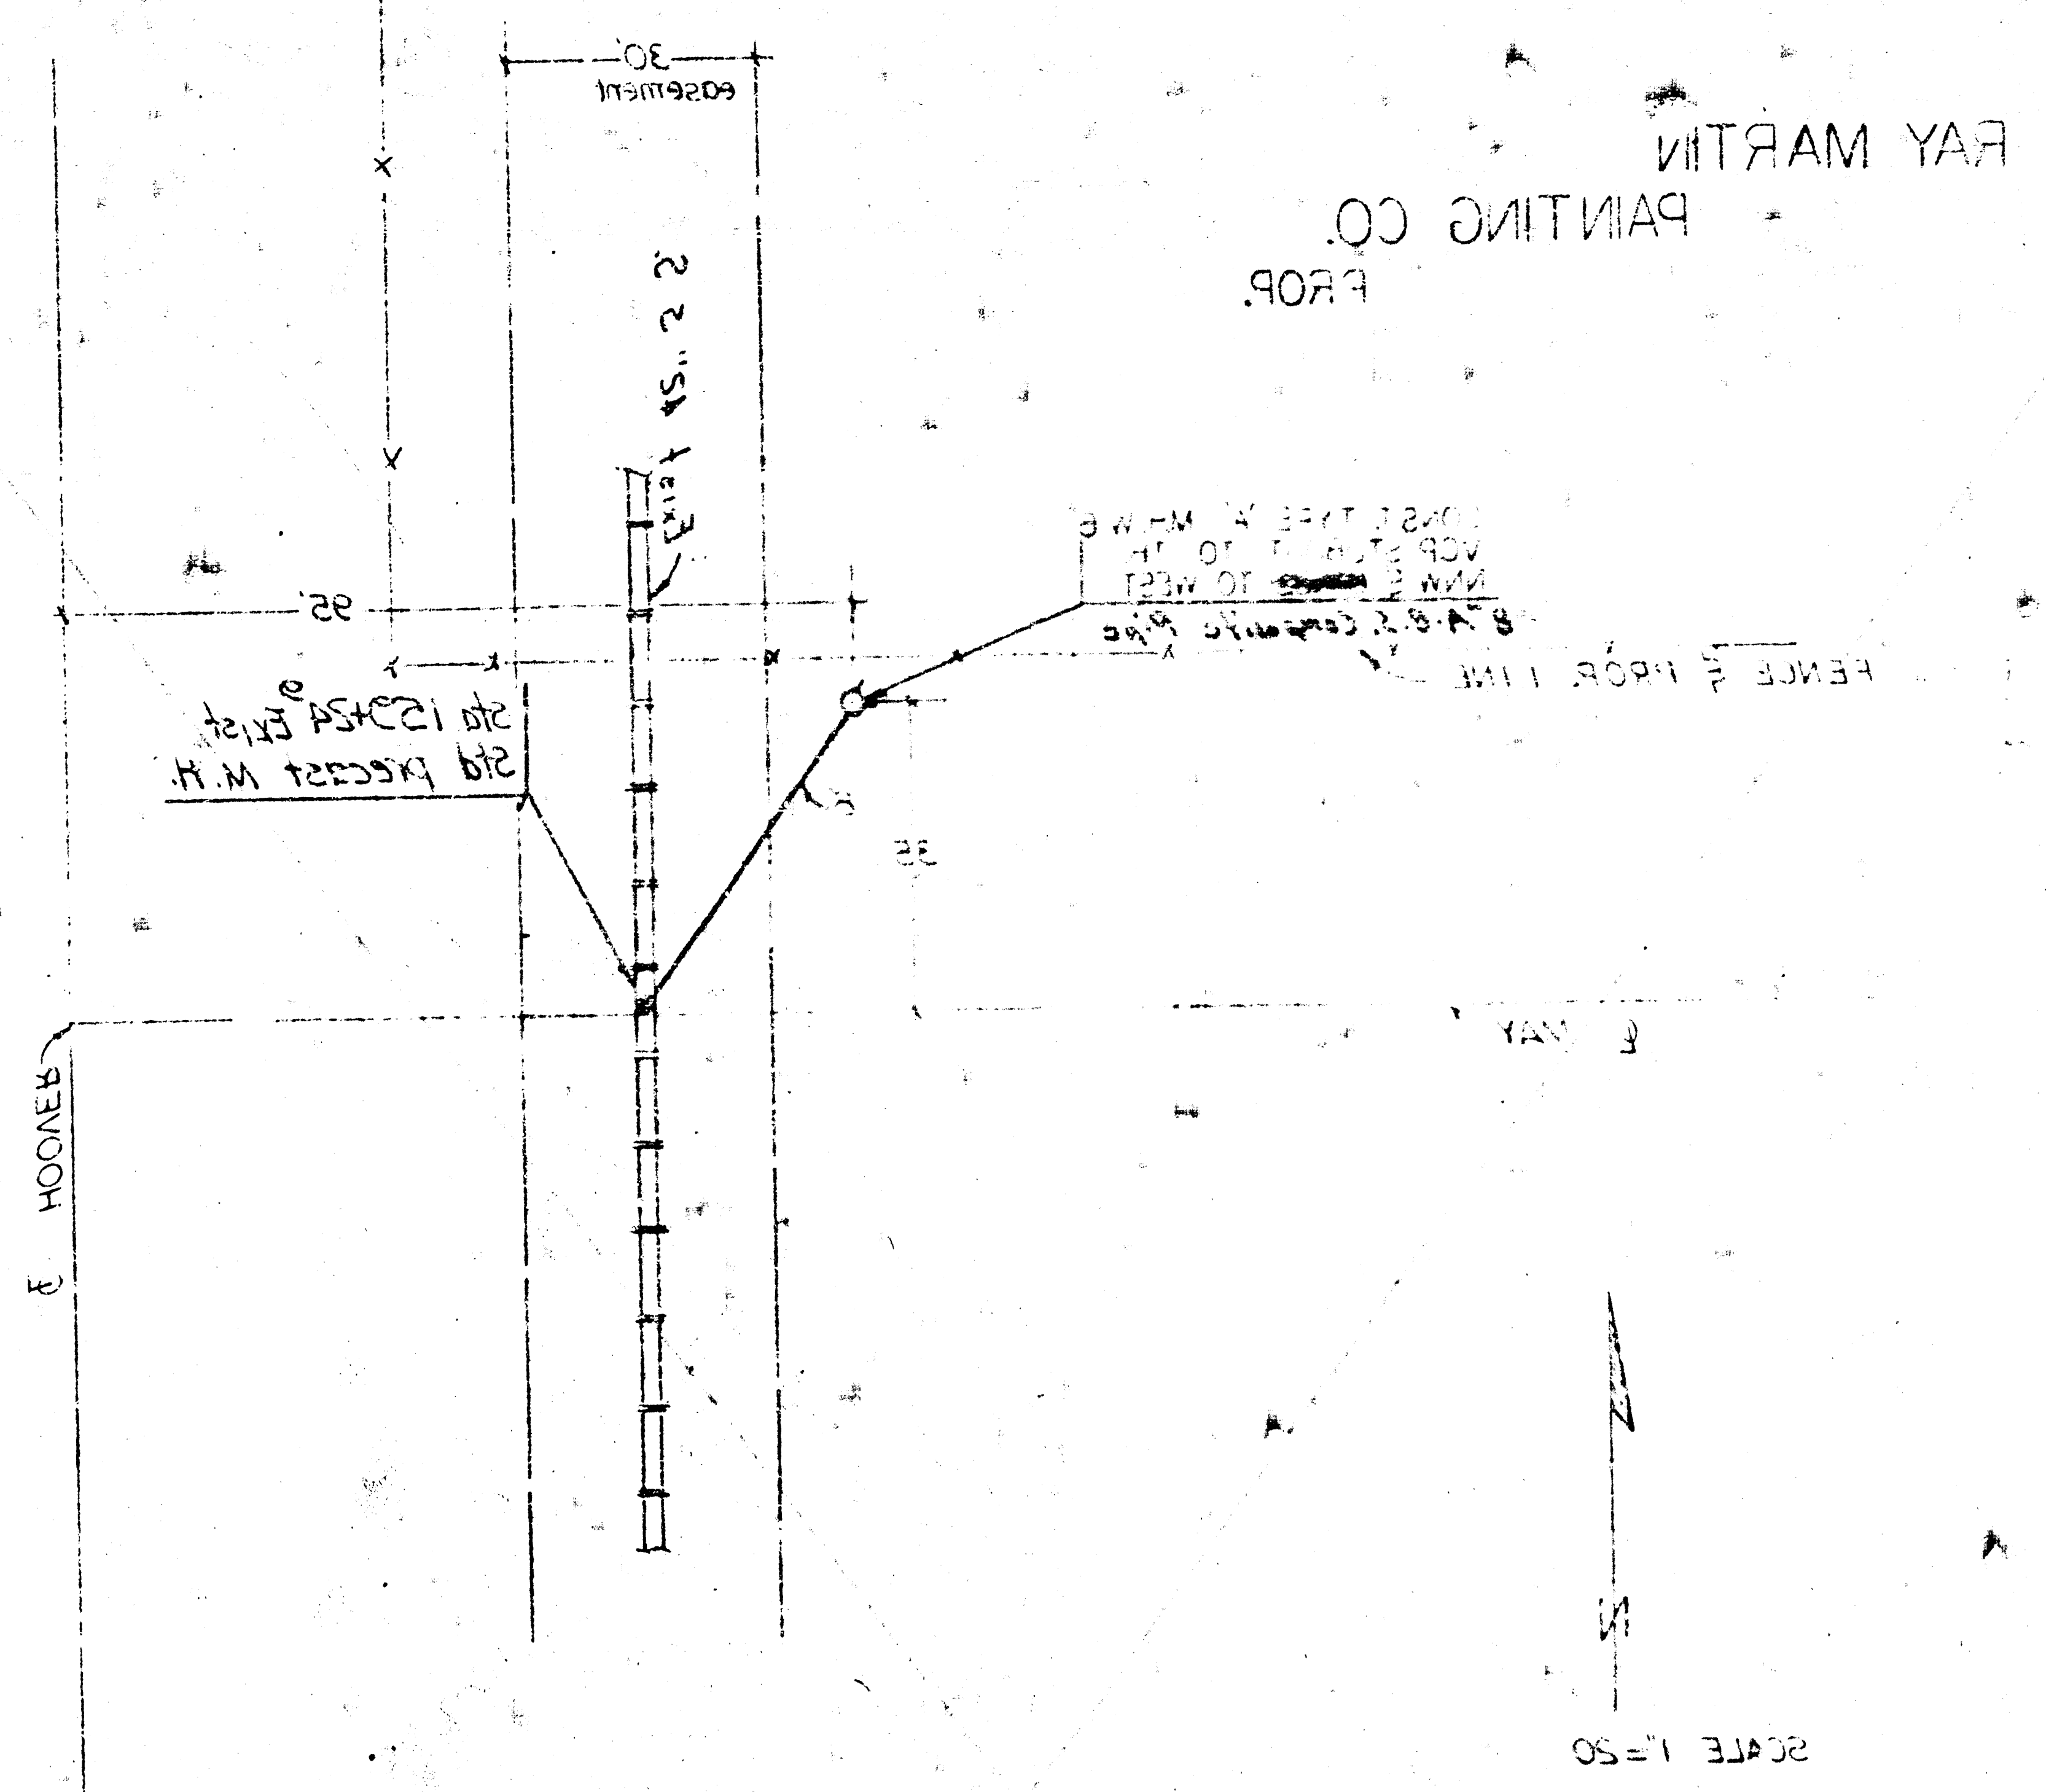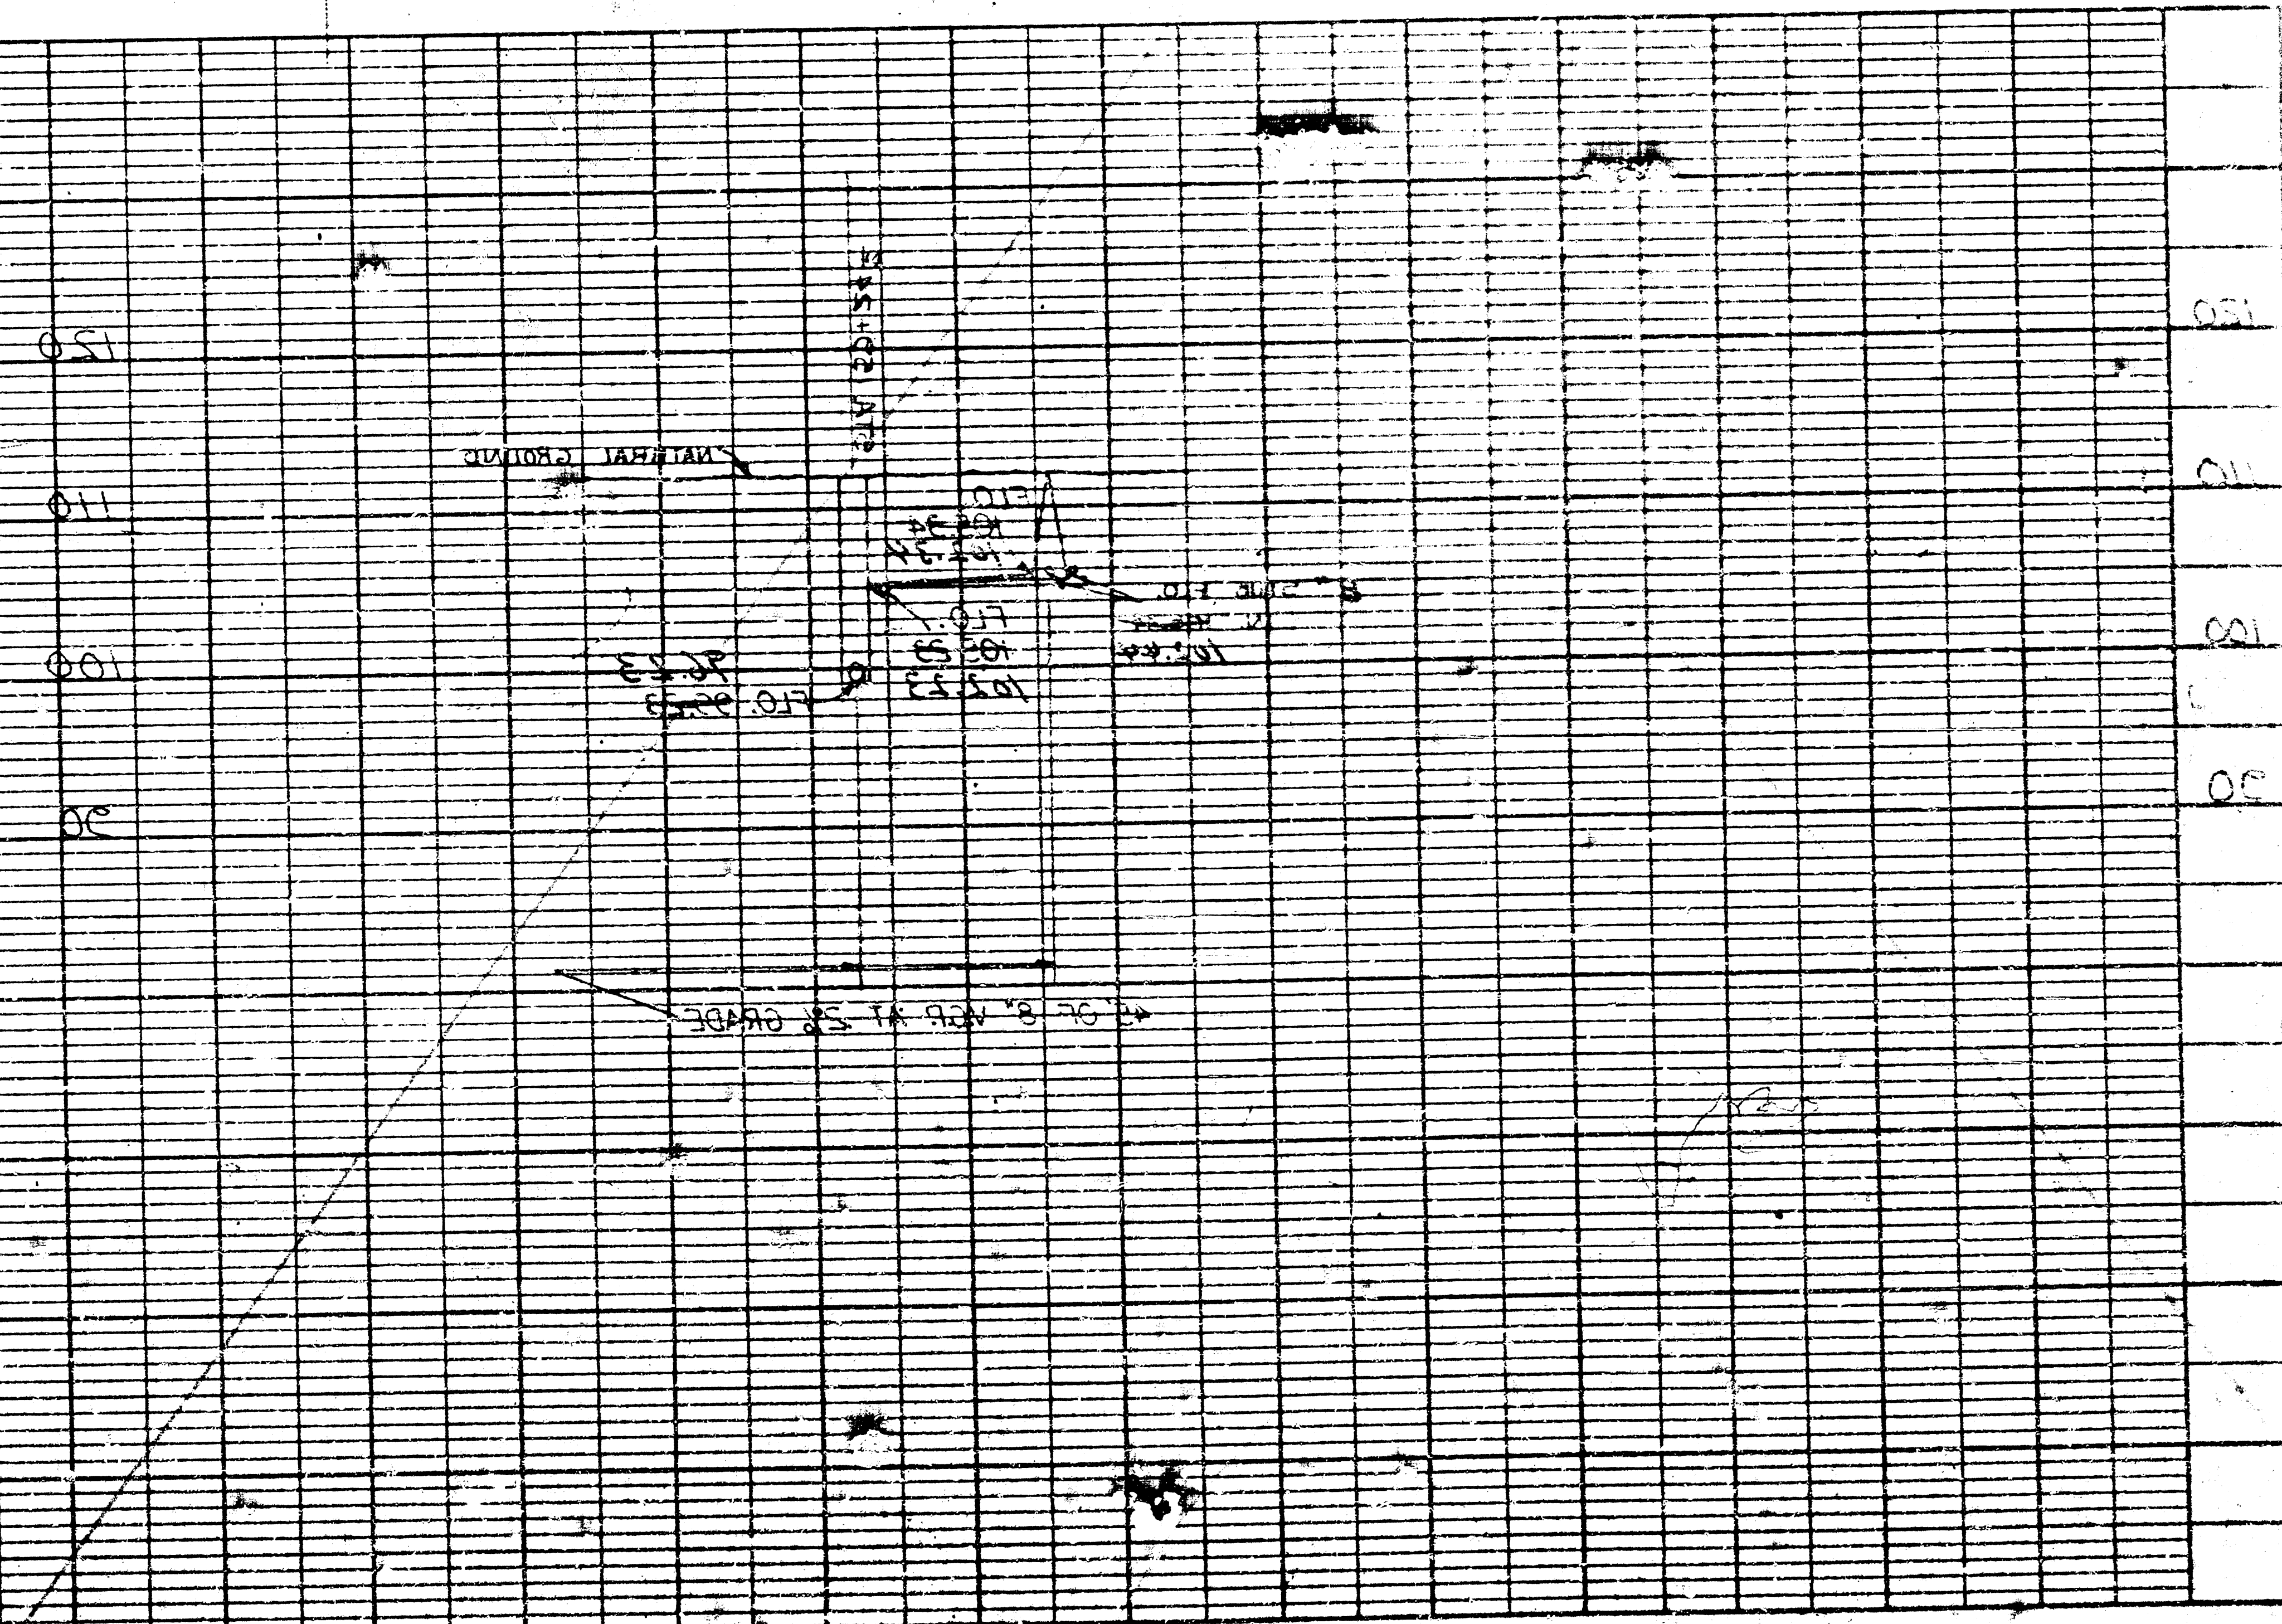

RAY MARTIN
PAINTING CO.
PROP.

**CONNECTION FOR
PRECAST MAN-HOLE**
NO SCALE

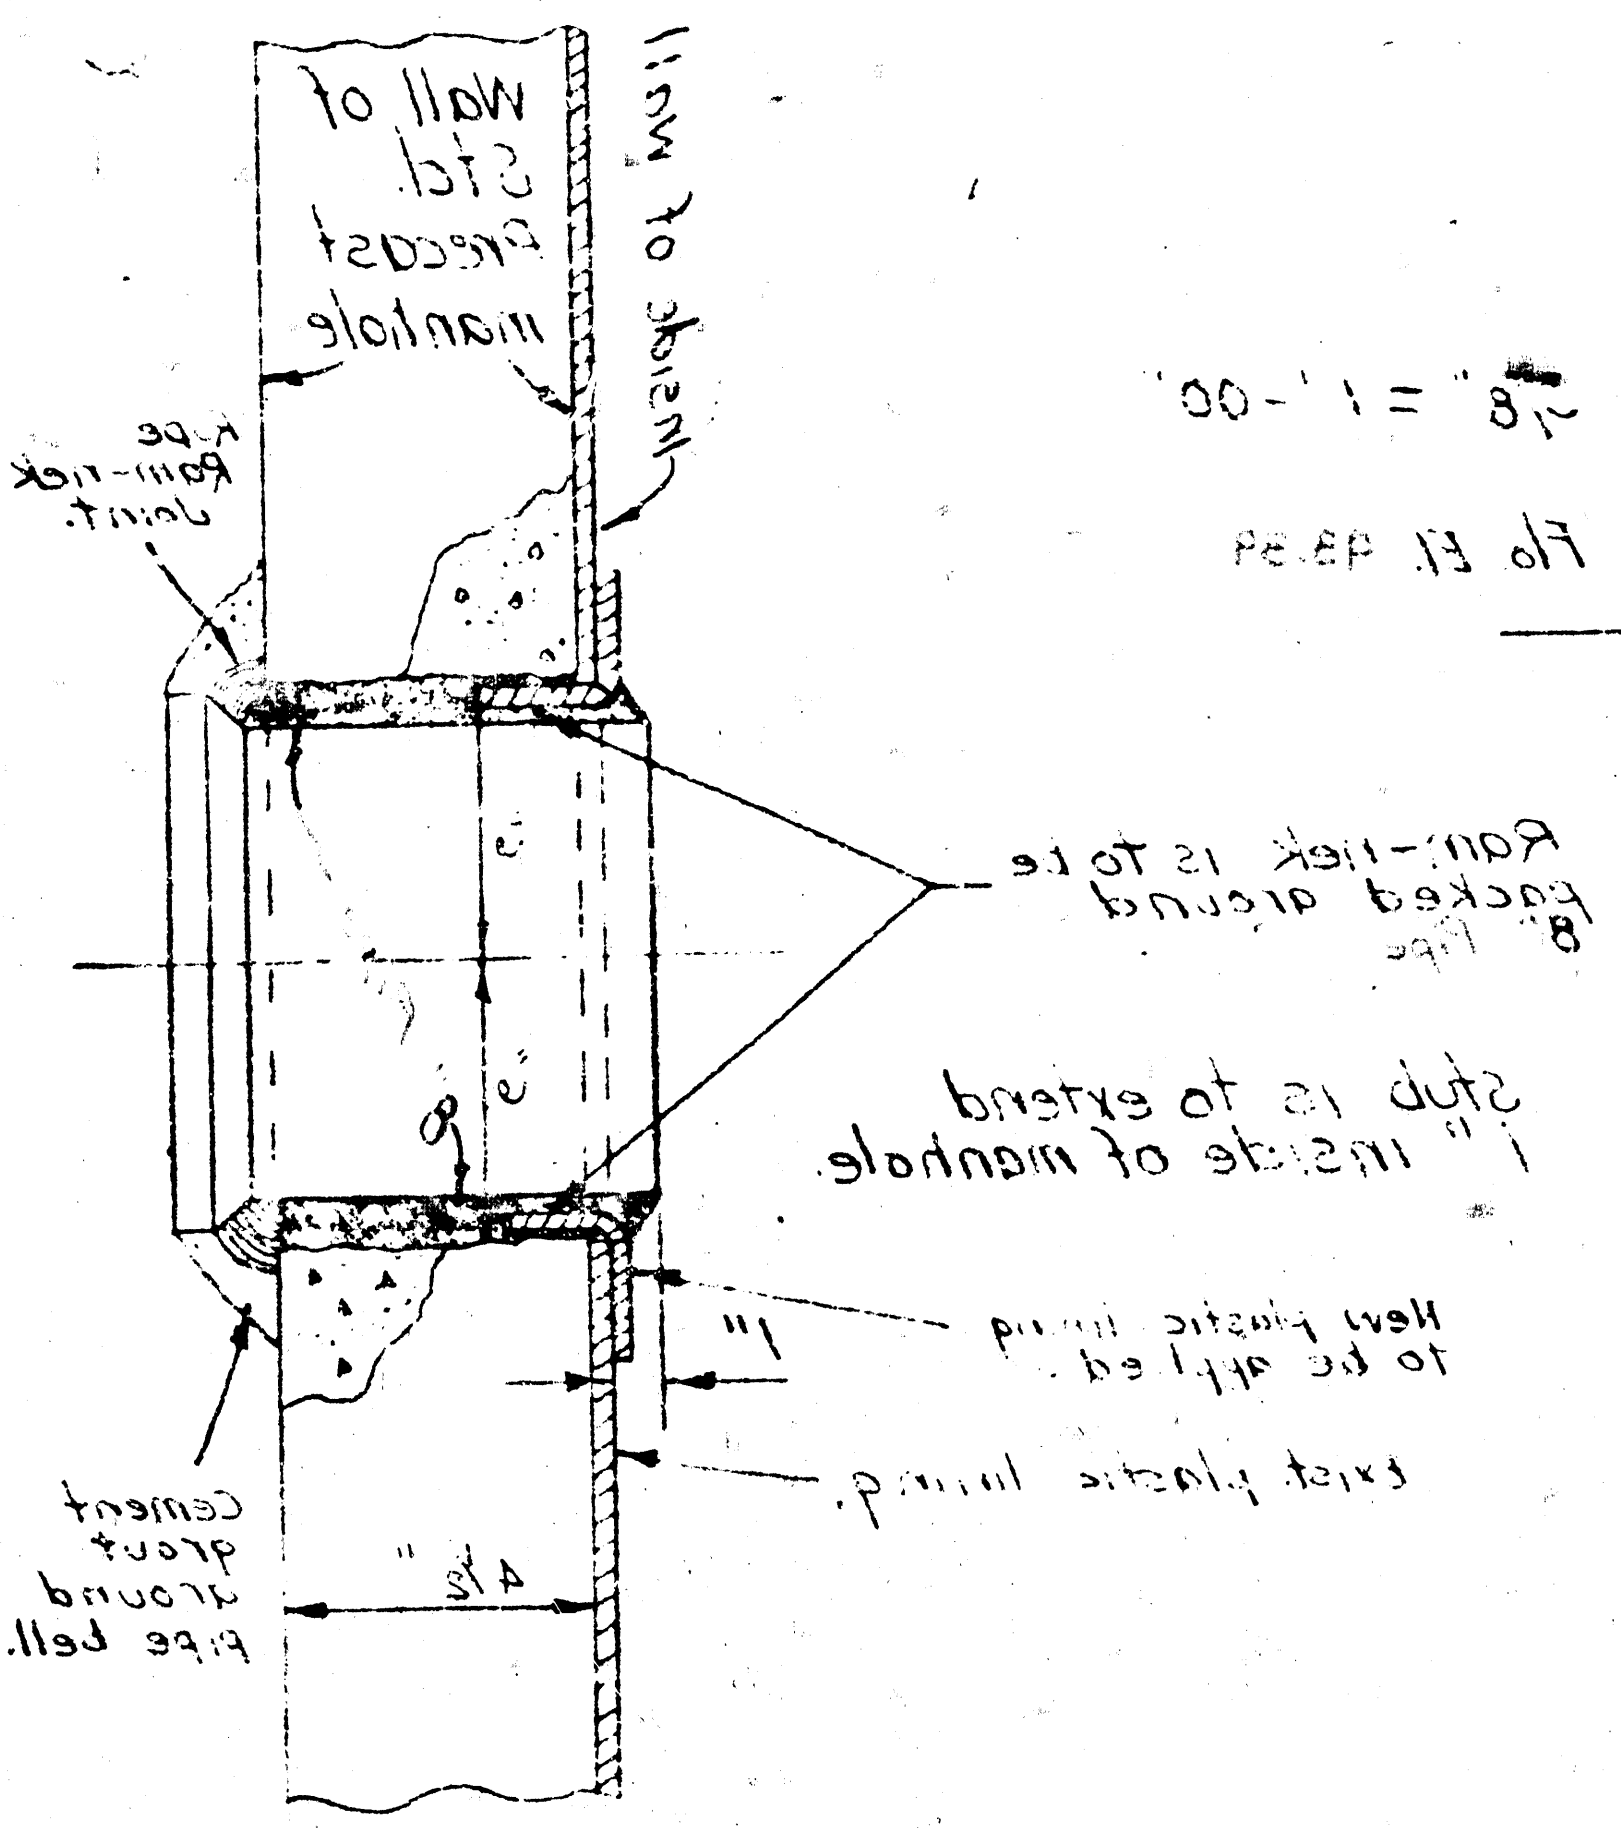

1" = 1'-00"

CAUTION:
Ventilate manhole
before drilling
holes into wall.

Standard Precast
Manhole
Sta. 0+00.00 Exist

