

LOT 1, CHISHOLM CREEK CENTER ADDITION

LOT 1
NORTH BRANCH Y.M.C.A. ADDITION


STA. 9+61.86-CONST. STD.
TYPE "A" OR "C" MANHOLE

STA. 13+11.86-CONST. STD.
TYPE "A" OR "C" MANHOLE

STA. 6+56-CONST. STD.
TYPE "A" OR "C" MANHOLE

STA. 3+50-CONST. STD.
TYPE "A" OR "C" MANHOLE


STA. 0+00-CONST. STD.
TYPE "D" INSIDE DROP
MANHOLE ON EXISTING
36" SANITARY SEWER

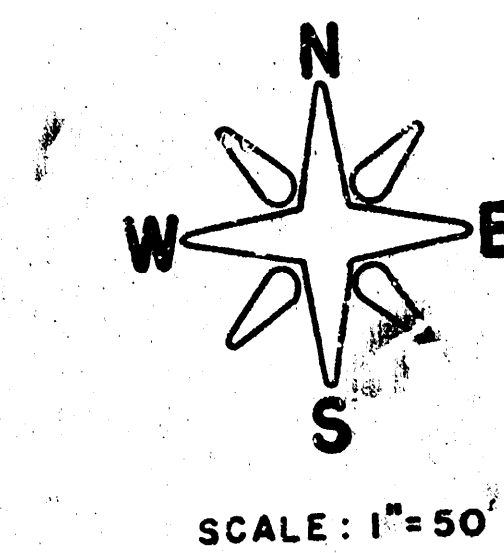

B.M. - CITY DISC 32' N. & 44' E. 1
29TH & HILLSIDE, EL. 147.67
B.M. - RR SPK. IN PP 15.5' S. & 3.5' W.
STA. 0+00, EL. 151.28

NOTE TO CONTRACTOR
This project will be constructed under the supervision of the CITY ENGINEER and conforming to the SPECIFICATIONS of the CITY OF WICHITA. The CONTRACTOR will prepay the City of Wichita for all costs of inspection.

APPROVED AS NOTED
By CITY ENGINEER OF WICHITA
Sanitary Sewer *[Signature]* 10/14/82
Storm Sewer _____
Driveway Approaches _____

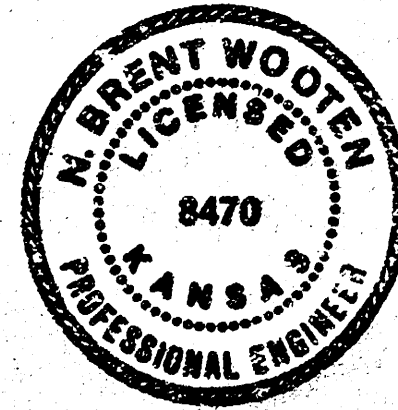


**PRIVATE SANITARY SEWER EXTENSION TO
SERVE LOT 1, CHISHOLM CREEK CENTER
ADDITION**

CITY PROJ. NO. 468-76-245-80000-000-000-008

BAUGHMAN COMPANY, P.A.
SURVEYING & ENGINEERING
314/243-2271 • 330 LAURA • WICHITA, KANSAS 67211


SH. 1 OF 3

FILED FROM THE BEST

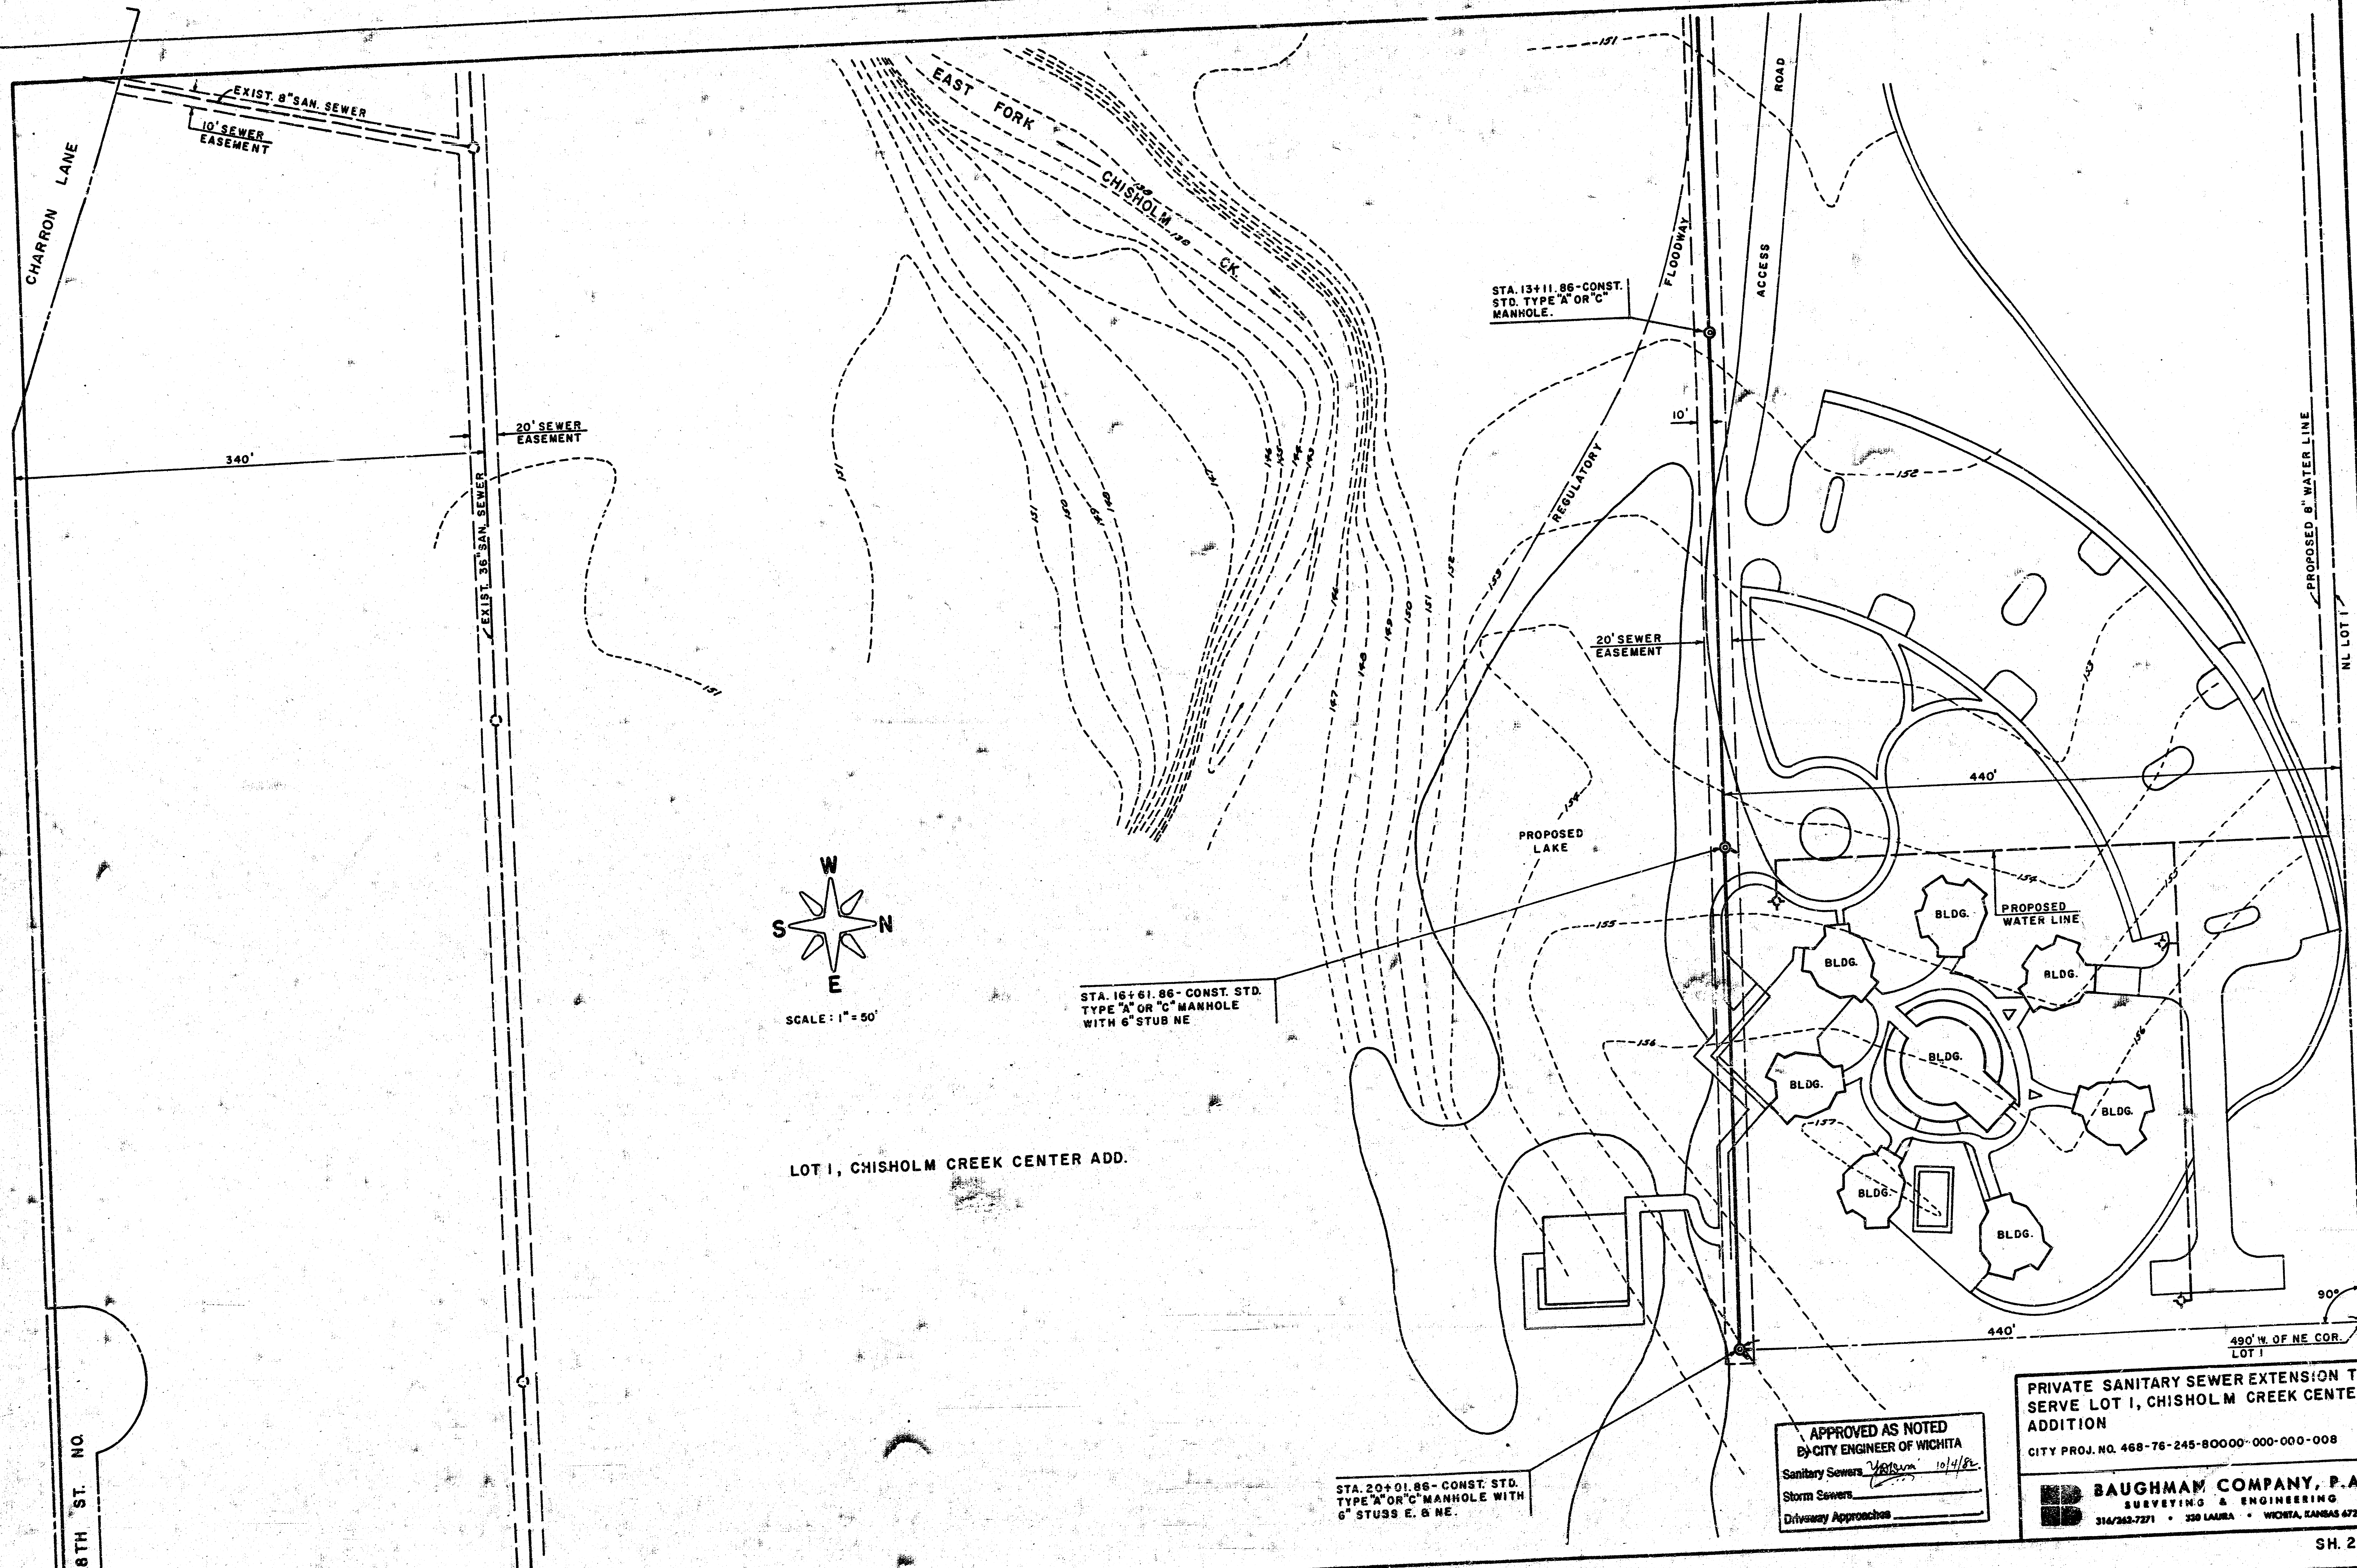

ORIGINAL SURVEY	DATE
SURVY	BY
NOTE BOOK	NO.
AREA	ACRES
NO.	ACRES

FINAL SURVEY	DATE
SURVY	BY
NOTE BOOK	NO.
AREA	ACRES
NO.	ACRES

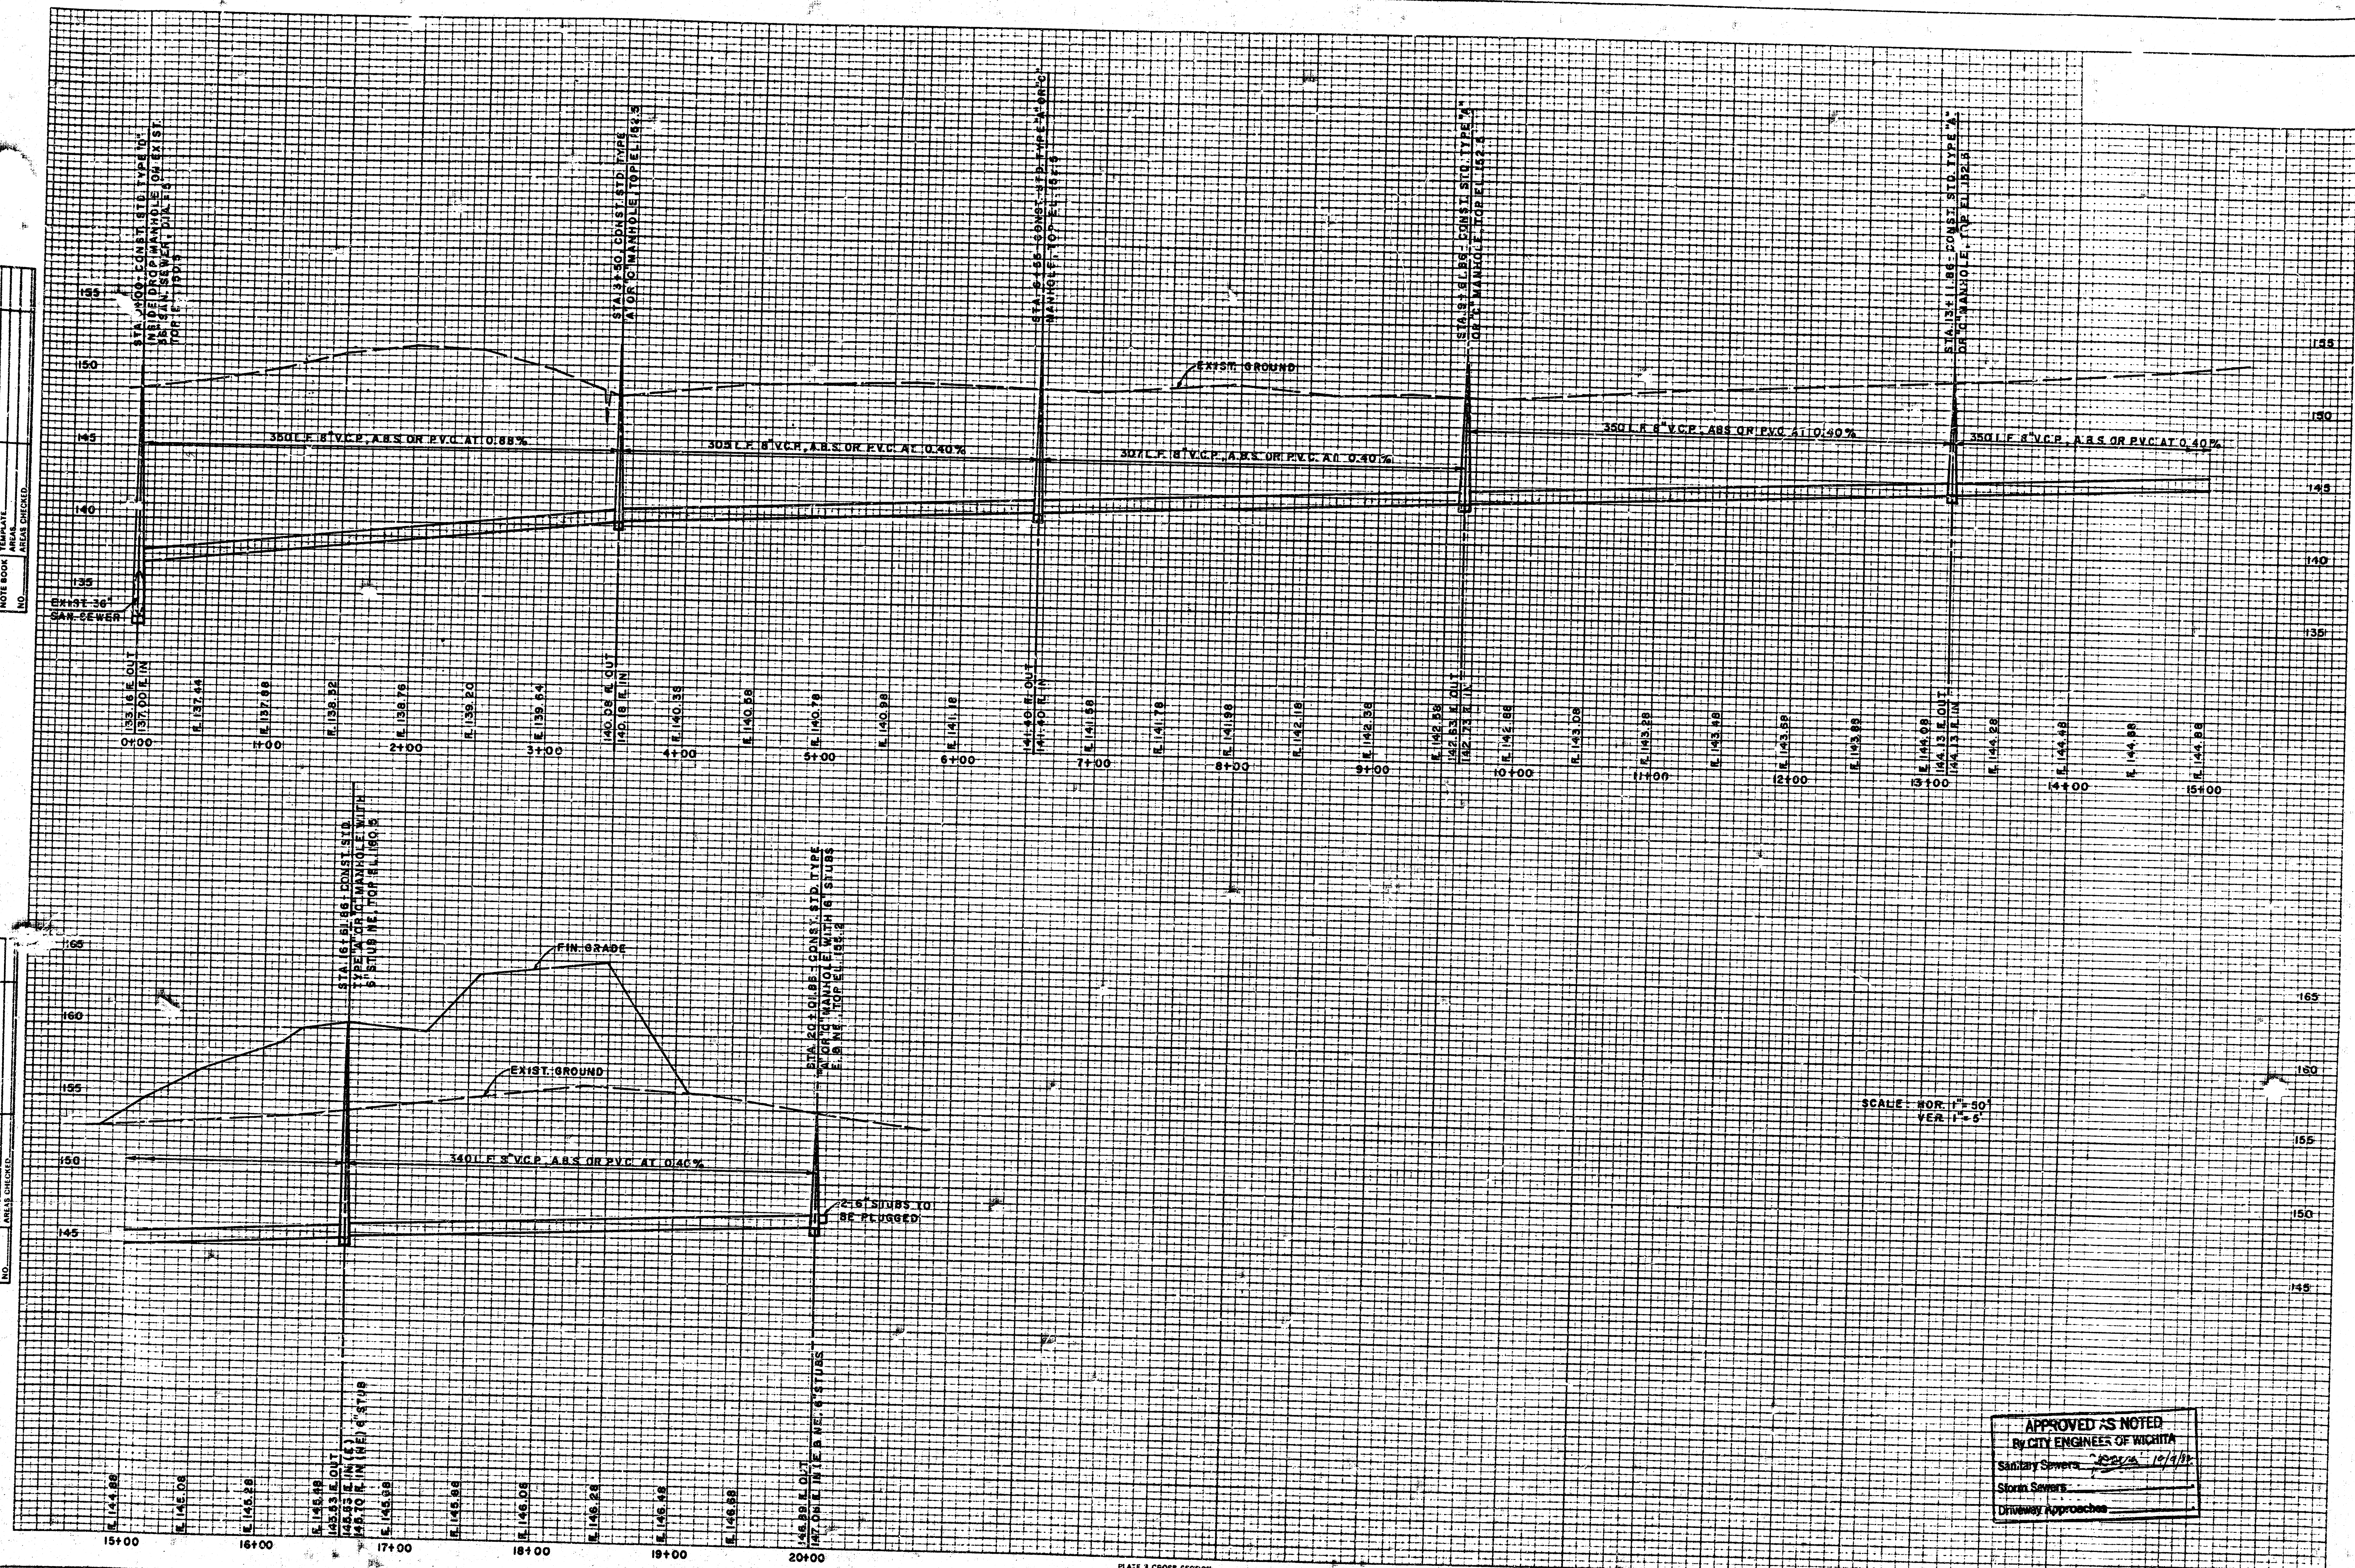

APPROVED AS NOTED
By CITY ENGINEER OF WICHITA
Sanitary Sewers
Storm Sewers
Driveway Approaches

PLATE 3 CROSS SECTION
CLEARPRINT PAPER CO., ST. CAL.
NO. 1000-3