

LOT 1

LOT 2

WEST ST

PEARL ST


CONST. TYPE A
MH W/1-4" VCP
STUB WEST
STA. 1+20

STA 1+00
EXIST
MH

EXIST 8"
SANITARY

10' EASEMENT

DEDICATED
EASEMENT

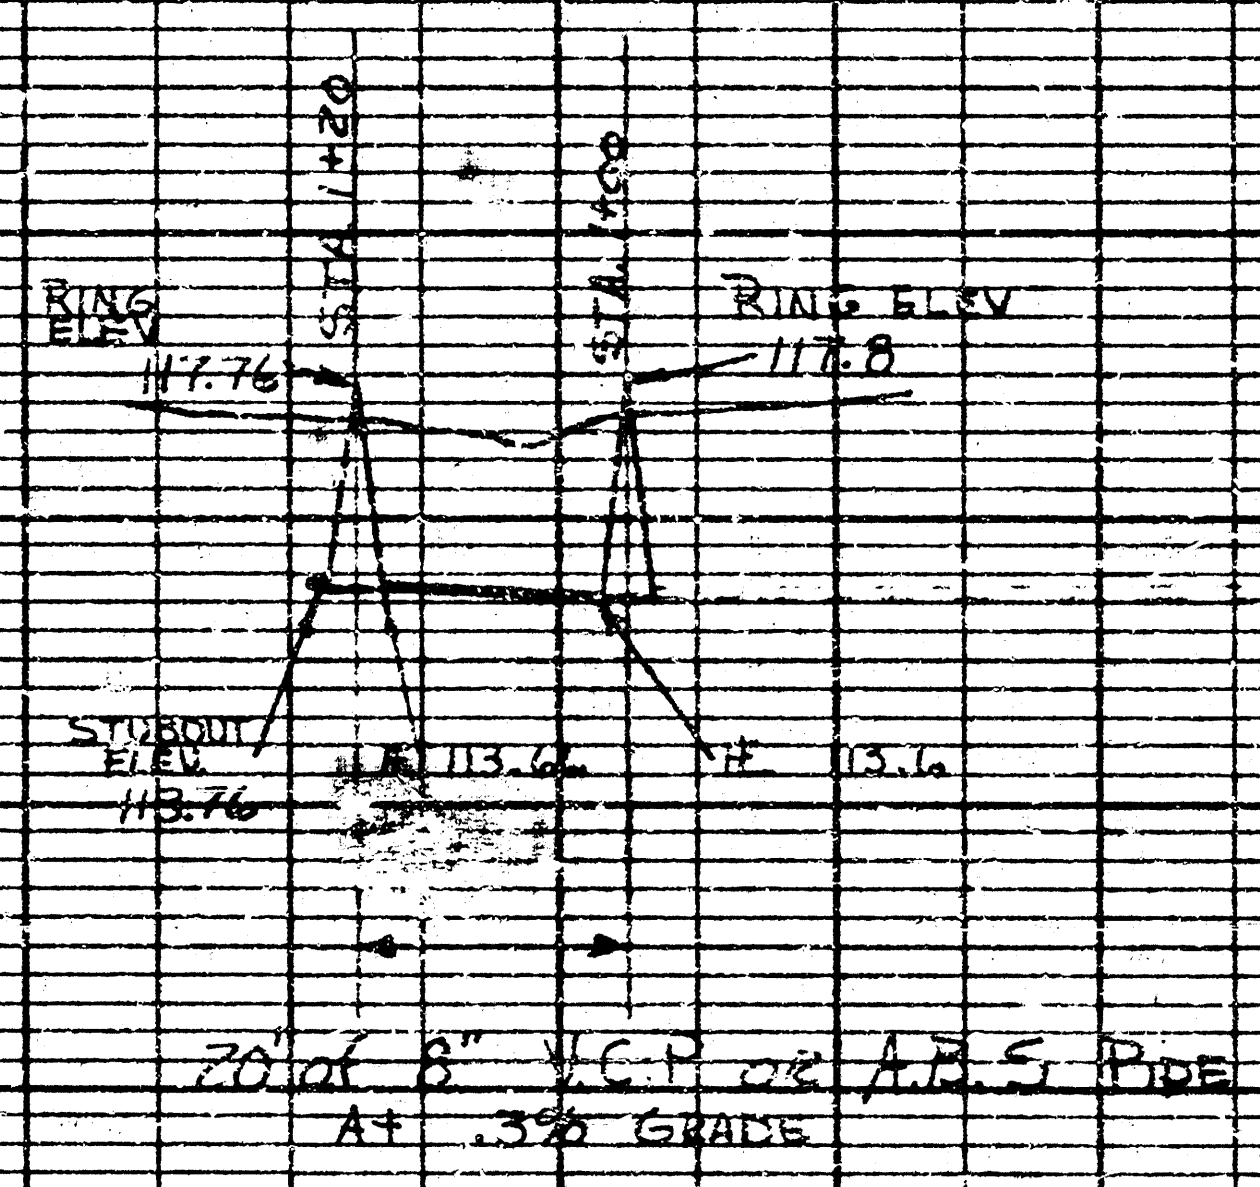

10-28-76

APPROVED AS NOTED
BY CITY ENGINEER OF WICHITA
Sanitary Sewers <i>J. P. S.</i>
Storm Sewers
Driveway Approaches

PROJ. NO. DBKW. 706060
SANITARY SEWER EXTENSION
FOR COMMERCIAL BLDG.
AT PEARL & WEST ST.
CHRISTLIEB ADD.
UTILITY CONTRACTORS
10-76