


CITY OF WICHITA, KANSAS  
 MICHAEL E. LINDEBAK, P.E., CITY ENGINEER  
**SANITARY SEWER AND  
 STORM SEWER IMPROVEMENTS**  
 IN  
**CROWN CHASE APARTMENTS**  
 PRIVATE PROJECT NO. 784PPS  
 INDEX CODE 607861

**LEGAL DESCRIPTION**

Lot 1, Block 1, & Reserve A, in Silver Springs, an addition to the City of Wichita, Sedgewick County, Kansas

**GENERAL NOTES**

- The Contractor is specifically cautioned that the location and/or elevation of existing utilities as shown on these Construction Drawings are based upon records of the various utility companies. This information is not to be relied upon as being exact or complete. It shall be the responsibility of the respective Contractor to notify ONE-CALL at (316) 687-2470, a minimum of 48 hours in advance of any excavation to request the exact field locations of the existing underground utilities. It shall be the responsibility of the respective Contractor to relocate all existing utilities which conflict with the proposed improvements as shown on the Construction Drawings.
- The Contractor must notify the following in case of an emergency:  
 Cablevision (316) 262-4270 or (316) 263-2061  
 KGE - Gas (316) 263-7511  
 KGE - Electric (316) 264-1141  
 Peoples Natural Gas (316) 942-8350 or (316) 263-8161  
 Southwestern Bell Telephone Co. 1-(316) 571-2611  
 City of Wichita Water Department (316) 268-4908  
 City of Wichita Sewer Maintenance (316) 268-4071
- City of Wichita Benchmark:  
 Brass Cap in Northeast corner of Concrete Headwall  
 Approximately 675' North of Intersection of Silver  
 Spring Blvd. and Ridge Road.  
 Elevation: 1317.54 (U.S.G.S. Datum)  
 130.14 (City of Wichita Datum)
- Preliminary Surveys: ROSS ENGINEERING, INC.
- Trench excavation and backfill shall be mechanically tamped and tested. Compaction requirements shall be in accordance with the Sitework Specifications.
- Cost of barricades, flashers and all items necessary for safe and efficient movement of traffic shall be considered subsidiary to the construction of the pavement and utilities.
- The Contractor shall use extreme caution in the area of existing trees which are to remain, existing manholes, power poles, fences, pavement and utilities, and shall be responsible for any damages.
- It will be the Contractor's responsibility to inform the Engineer of any control points including street centerline and lot corners that may be destroyed during construction so that these points may be offset. The cost of resetting points that have not been offset will be paid for by the Contractor. Requests for offsets must be made 48 hours in advance.

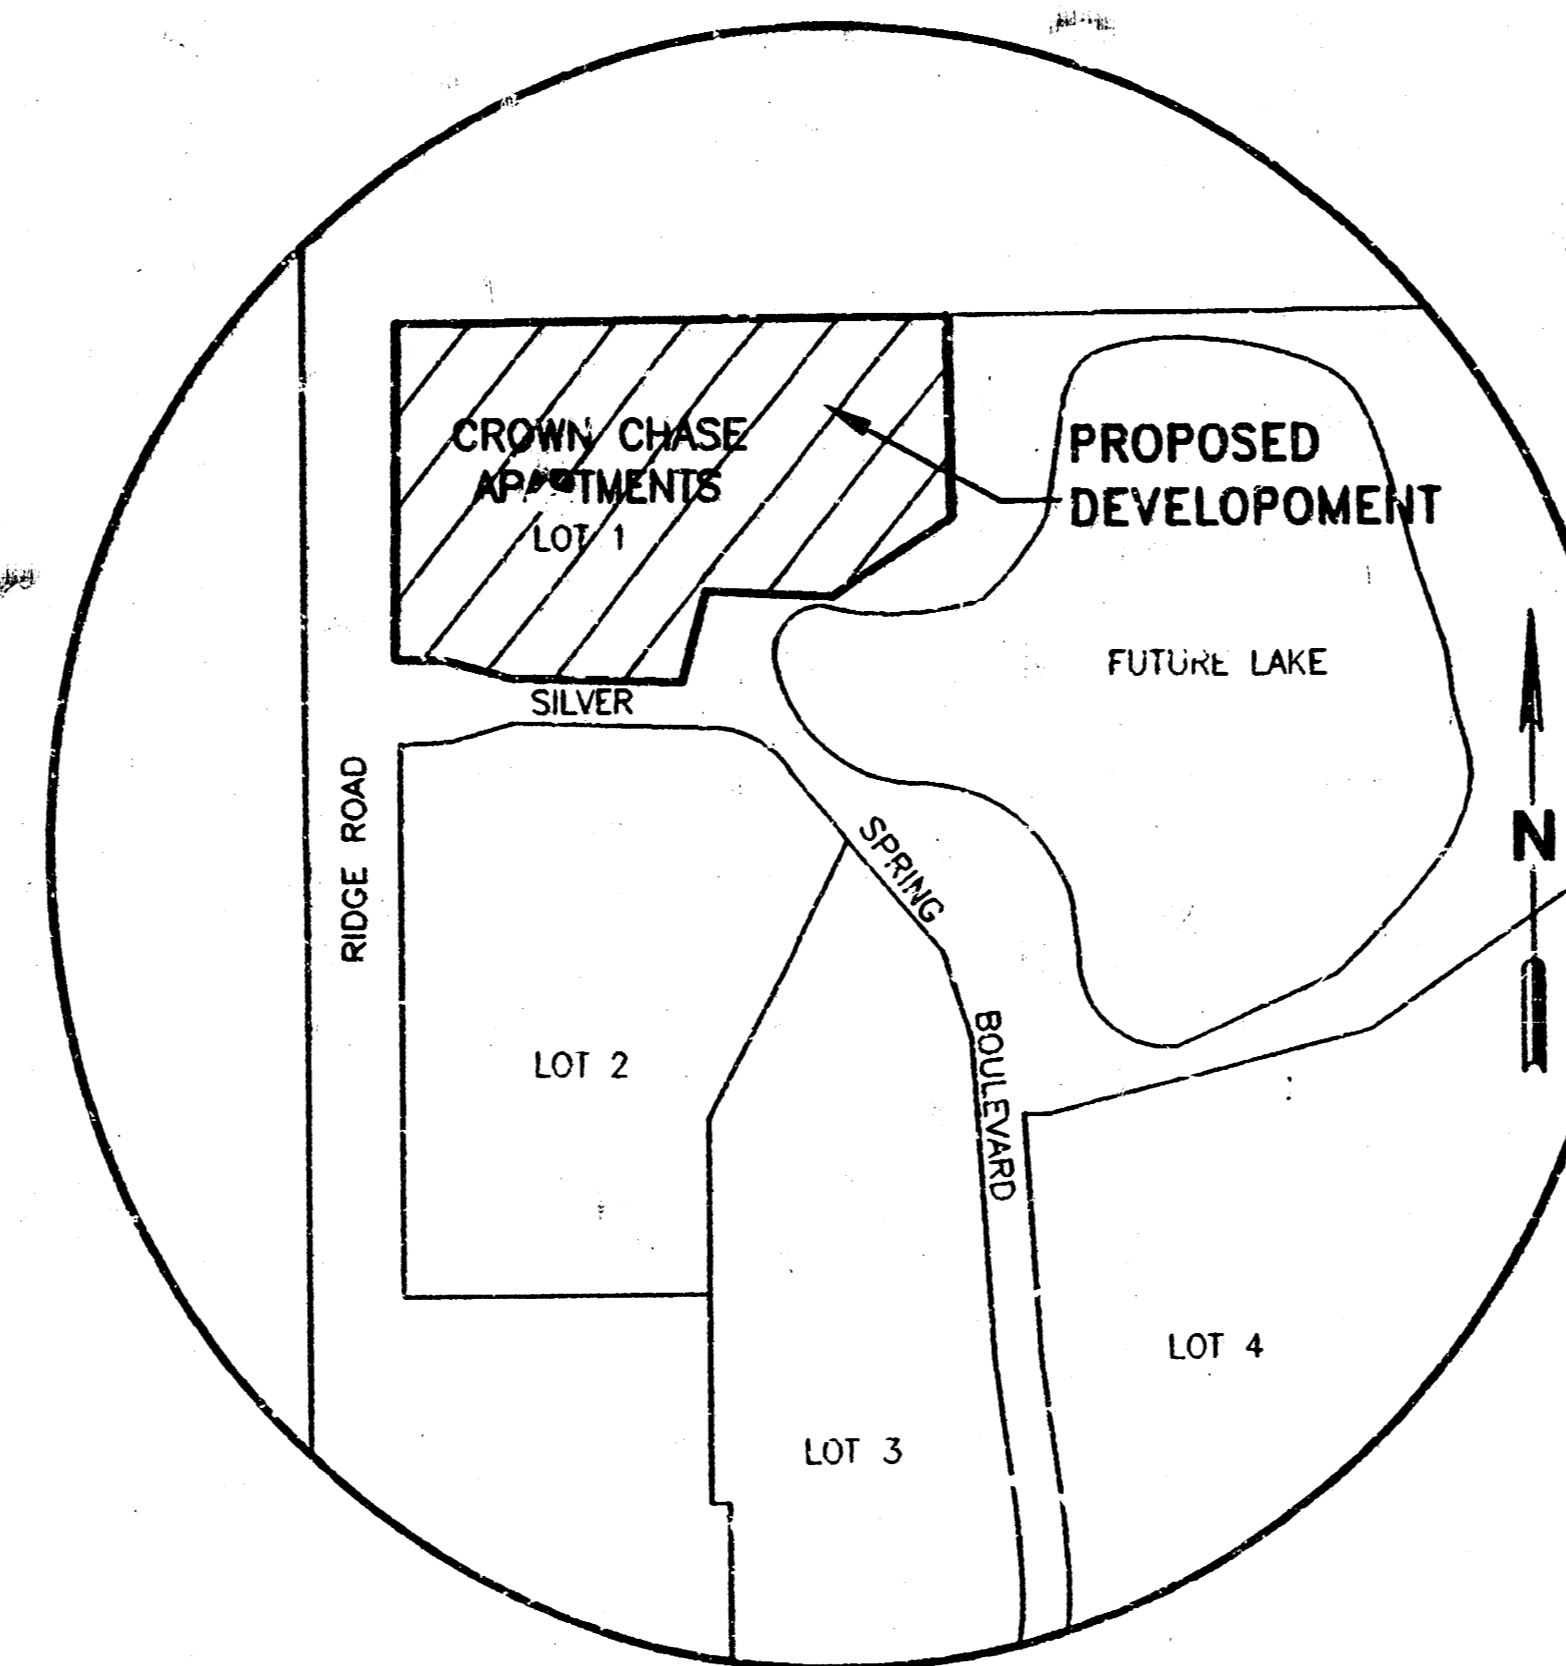

VICINITY MAP

**SHEET INDEX**

	NO.
Public Construction	COVER SHEET 1 of 9
	SANITARY PLAN 2 of 9
	SANITARY PROFILES 3 of 9
Private Construction	STORM SEWER PLAN 4 of 9
	STORM SEWER PROFILES 5 of 9
	TYPE "P" MANHOLE DETAIL 6 of 9
	DRIVEWAY GRATED INLET DETAIL 7 of 9
	STANDARD TYPE 1-A CURB INLET DETAIL 8 of 9
	MANHOLE FRAME AND COVER DETAIL 9 of 9

*San Sewer Booked 7/2/98 P-15 ROL*  
*STORM SEWER BOOKED 7/20/98 MEG D-395*

AS-BUILT  
 Date: 6/25/98  
 Signed: [Signature]

**ENGINEER'S CERTIFICATE**  
 I hereby certify that these Construction Drawings were prepared by me or under my direct supervision and that I am a Registered Professional Engineer under the laws of the State of Kansas. These Construction Drawings meet the requirements of subdivision approval and the City Engineer's Office design requirements as they apply to construction at the time of this certificate.  
 [Signature] 3/27/98  
 Date

APPROVED AS NOTED  
 BY CITY ENGINEER OF WICHITA

Sanitary Sewers VRH 3/27/98  
 Storm Sewers VRH 3/27/98  
 Driveways/Approaches \_\_\_\_\_  
 Water Mains \_\_\_\_\_  
 Paving \_\_\_\_\_

NOTE TO CONTRACTORS

**PUBLIC PROPERTY:**  
 Inspection and testing for the Waterline is to be provided by a Licensed Consulting Engineering Firm under contract with the records of the Owner/Developer. Said inspection to be in upon as accordance with the City of Wichita standard construction engineering practices and certified by a Licensed Professional Engineer. No work shall be performed in dedicated easements or public right-of-way by the Contractor without such inspection nor shall any work be commenced without written authorization by the City Engineer. All construction and materials shall comply with the City of Wichita Specifications and Standards (on file and available in the City Engineer's Office.

ROSS Engineering, Inc.  
 ENGINEERS • PLANNERS • SURVEYORS  
 446 N. Street  
 Suite 201  
 Lincoln, NE 68508  
 Phone 402-974-7077  
 FAX 402-974-7078


No. \_\_\_\_\_  
 Revision \_\_\_\_\_  
 Date \_\_\_\_\_

Scale \_\_\_\_\_  
 Drawn \_\_\_\_\_  
 Checked \_\_\_\_\_  
 Approved \_\_\_\_\_

Loop# 888-110  
 File# 88801032  
 Date 12/5/97  
 Page 3/23/98

CROWN CHASE  
 RIDGE ROAD & SILVER SPRING BOULEVARD  
 KANSAS  
 WICHITA

COVER SHEET  
 1 of 9

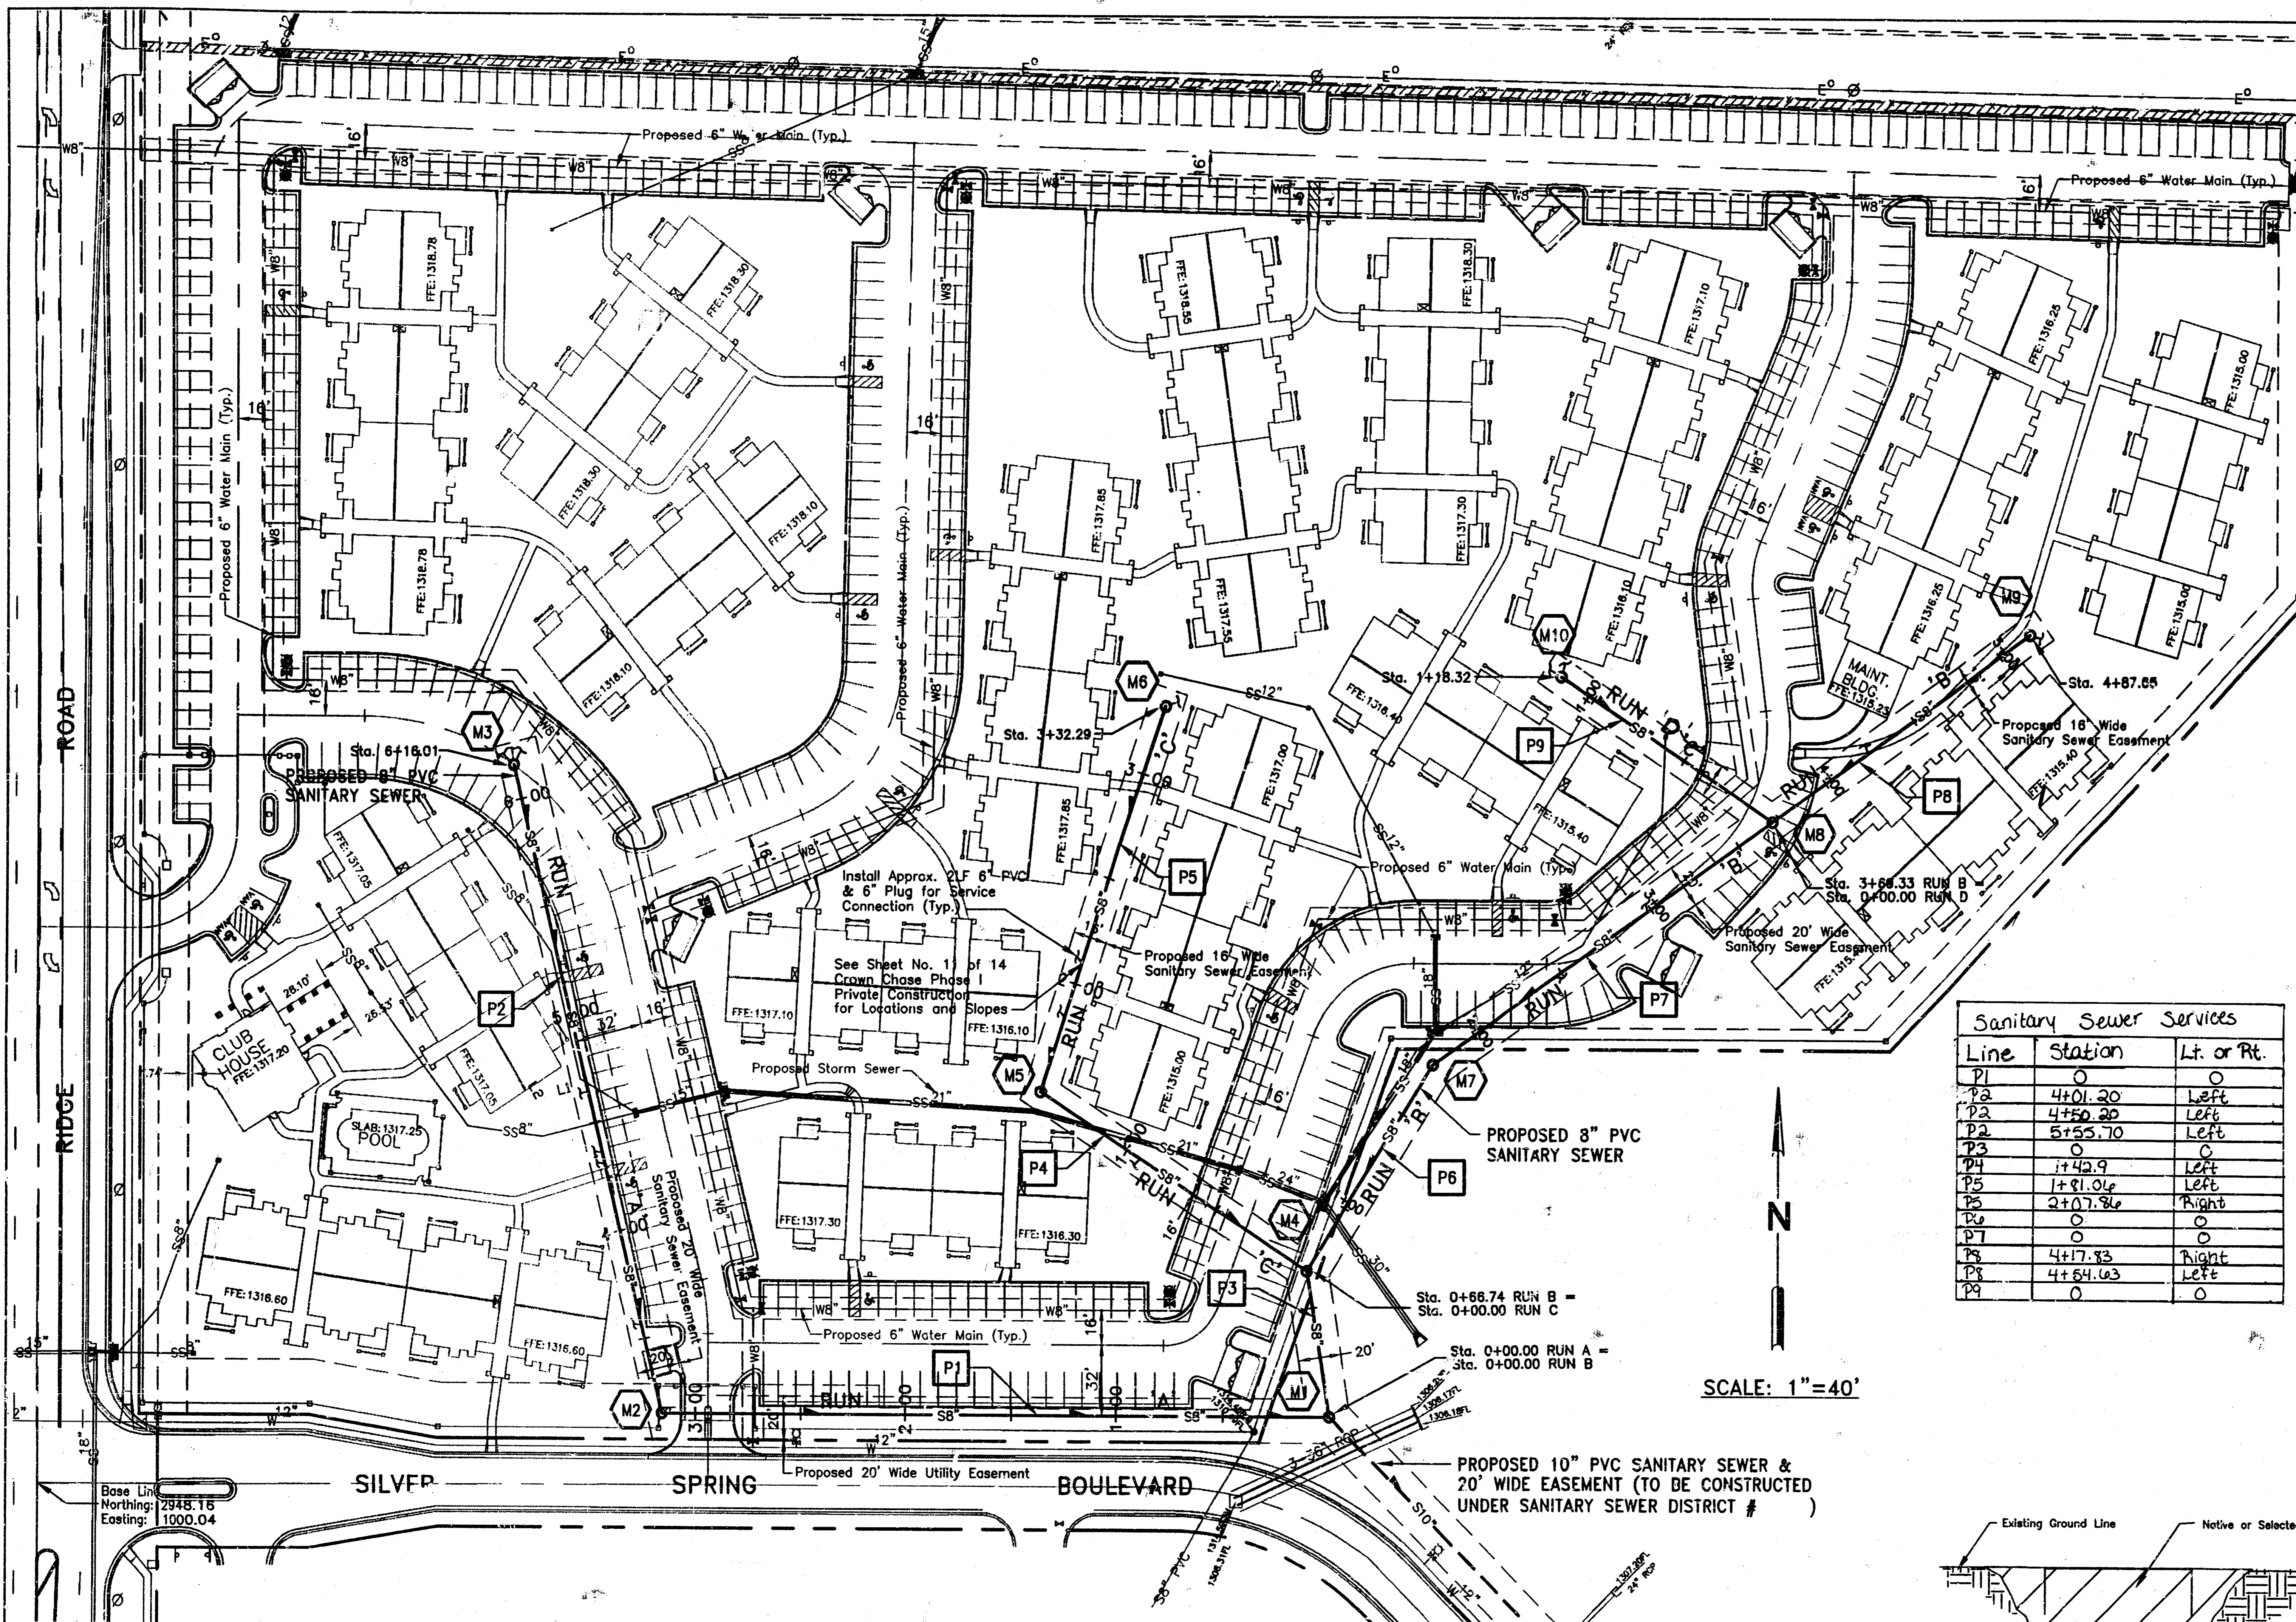

**SCHEDULE OF APPROX. QUANTITIES**

DESCRIPTION	UNITS	QUANT.
8" PVC Sanitary Sewer Pipe, SDR 35	LF	1585
Standard Sanitary Sewer Manhole, Type 'P'	Ea	10
Standard Sanitary Sewer Manhole, Type 'P'	VF	85
Foundation Material (In Place)	CY	240
6" Sanitary Sewer Service Pipe, Sch 40 PVC	LF	38
6" Plug	Ea	18

**BUILD 8" PVC SANITARY SEWER PIPE**

NO.	STATION	SIZE	LENGTH	SLOPE
P1	0+00 to 3+15.20 Run "A"	8"	315 LF	0.00400
P2	3+15.20 to 6+16.01 Run "A"	8"	301 LF	0.00400
P3	0+00 to 0+66.74 Run "B"	8"	67 LF	0.00400
P4	0+00 to 1+48.73 Run "C"	8"	149 LF	0.00400
P5	1+48.73 to 3+32.39 Run "C"	8"	184 LF	0.00400
P6	0+66.74 to 1+76.30 Run "B"	8"	110 LF	0.00400
P7	1+76.30 to 3+69.33 Run "B"	8"	193 LF	0.00400
P8	3+69.33 to 5+17.51 Run "B"	8"	148 LF	0.00400
P9	0+00 to 1+18.32 Run "D"	8"	116 LF	0.00400

**BUILD SANITARY SEWER MANHOLE**


NO.	STATION	VF	NORTHING	EASTING
M1	0+00.00 Run "A"	9.23	2981.6642	1812.4408
M2	3+15.20 Run "A"	10.45	2981.6642	1287.2356
M3	6+16.01 Run "A"	8.98	3273.8430	1225.7008
M4	0+66.74 Run "B"	8.17	3047.9646	1601.8997
M5	1+48.73 Run "C"	7.89	3127.3804	1476.3816
M6	3+32.39 Run "C"	9.63	3301.4356	1534.9208
M7	1+76.30 Run "B"	7.53	3140.0528	1660.6336
M8	3+69.33 Run "B"	7.85	3249.9800	1819.3069
M9	5+17.51 Run "B"	8.07	3335.3732	1940.0028
M10	1+18.32 Run "D"	7.59	3315.5204	1720.7965

**Sanitary Sewer Services**


Line	Station	Lt. or Rt.
P1	0	0
P2	4+01.20	Left
P2	4+50.20	Left
P2	5+55.70	Left
P3	0	0
P4	1+42.9	Left
P5	1+81.04	Left
P5	2+07.84	Right
P6	0	0
P7	0	0
P8	4+17.83	Right
P8	4+54.63	Left
P9	0	0

**BENCHMARK**  
Biggs Cap in Northeast corner of Concrete Headwall  
Approximately 675' North of Intersection of Silver  
Spring Blvd. and Ridge Road.  
Elevation: 1317.54 (U.S.G.S. Datum)  
130.14 (City of Wichita Datum)



SCALE: 1"=40'

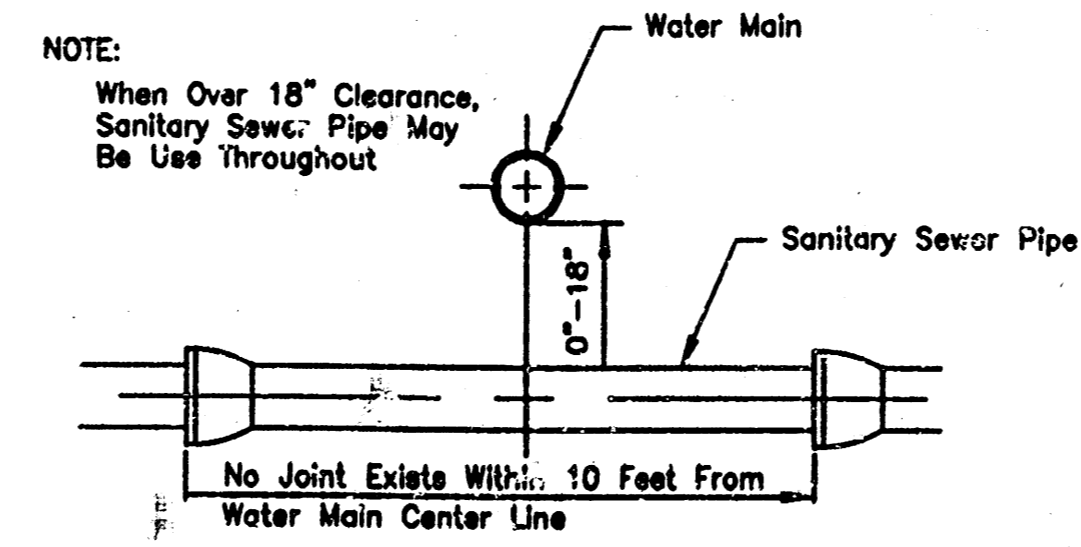




**SEWER-WATER CROSSING**  
NO SCALE

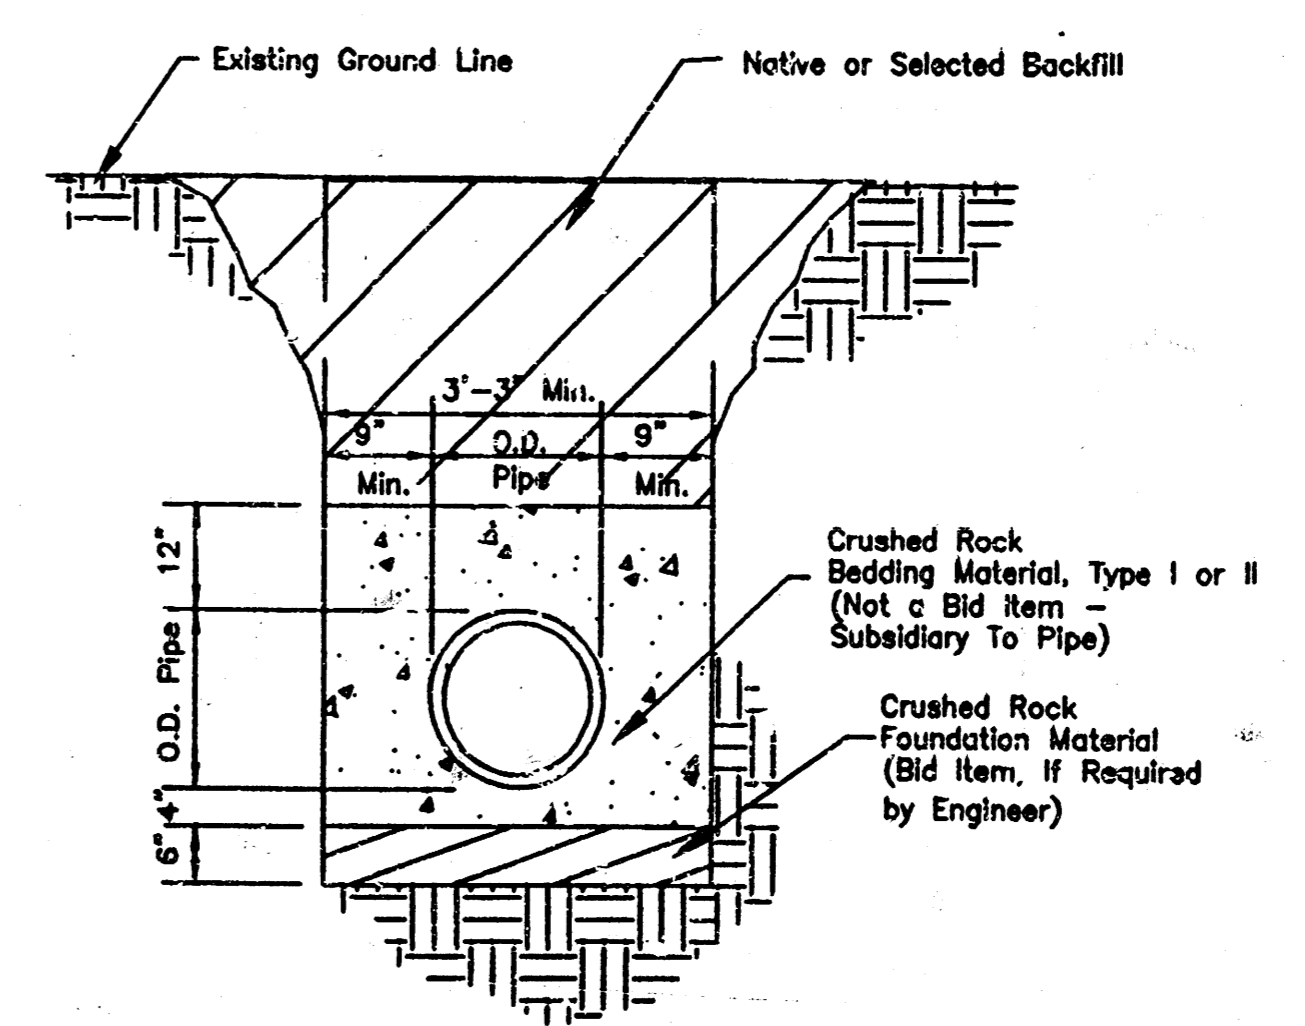

**SANITARY SEWER PIPE BEDDING AND FOUNDATION**  
NO SCALE

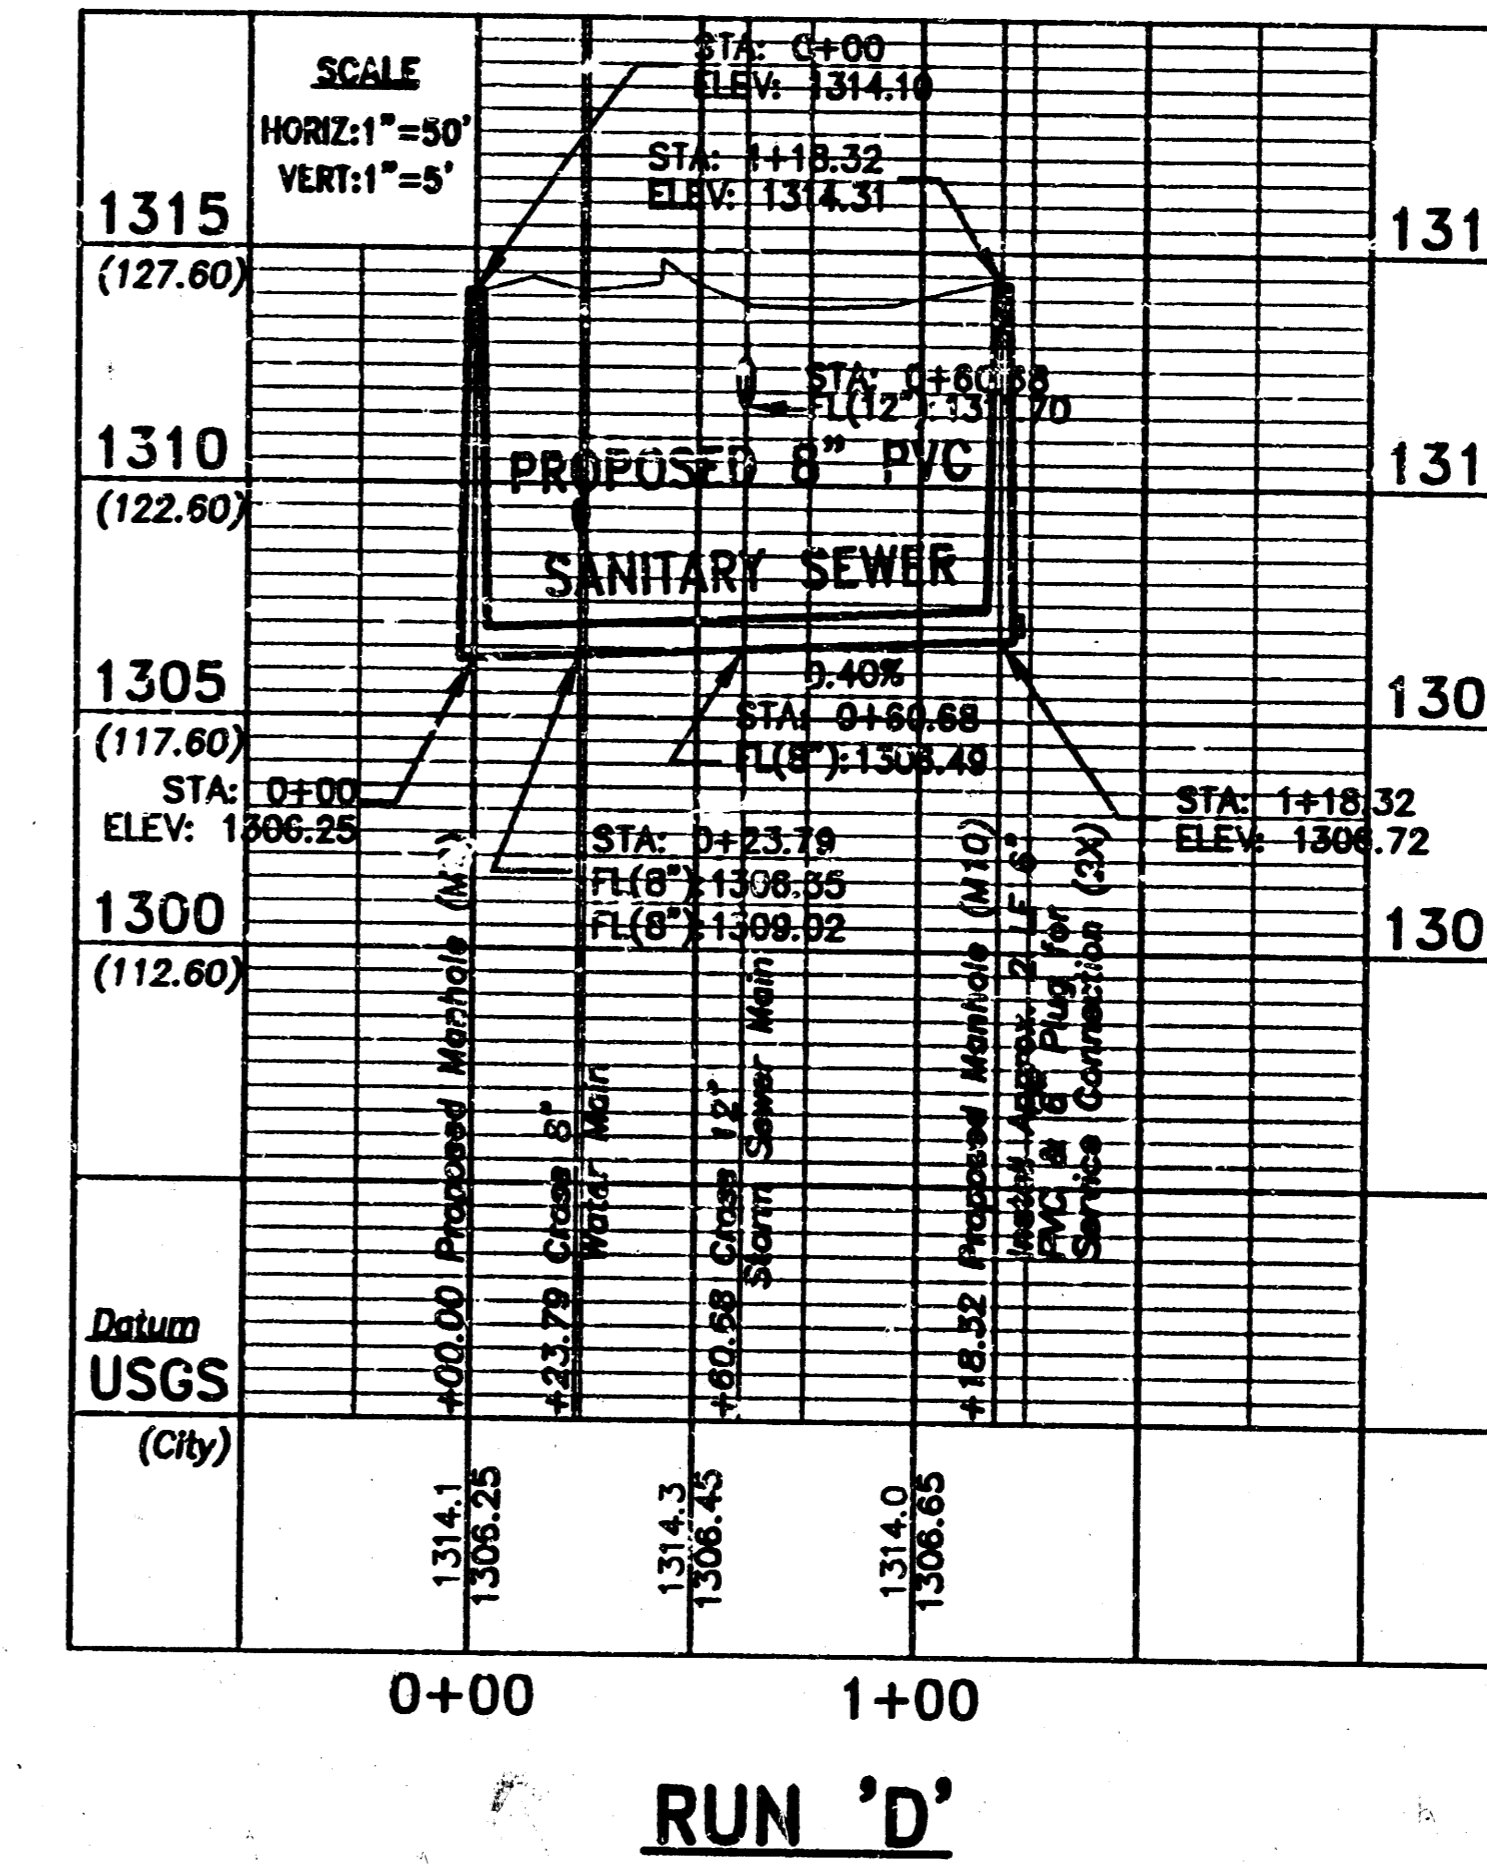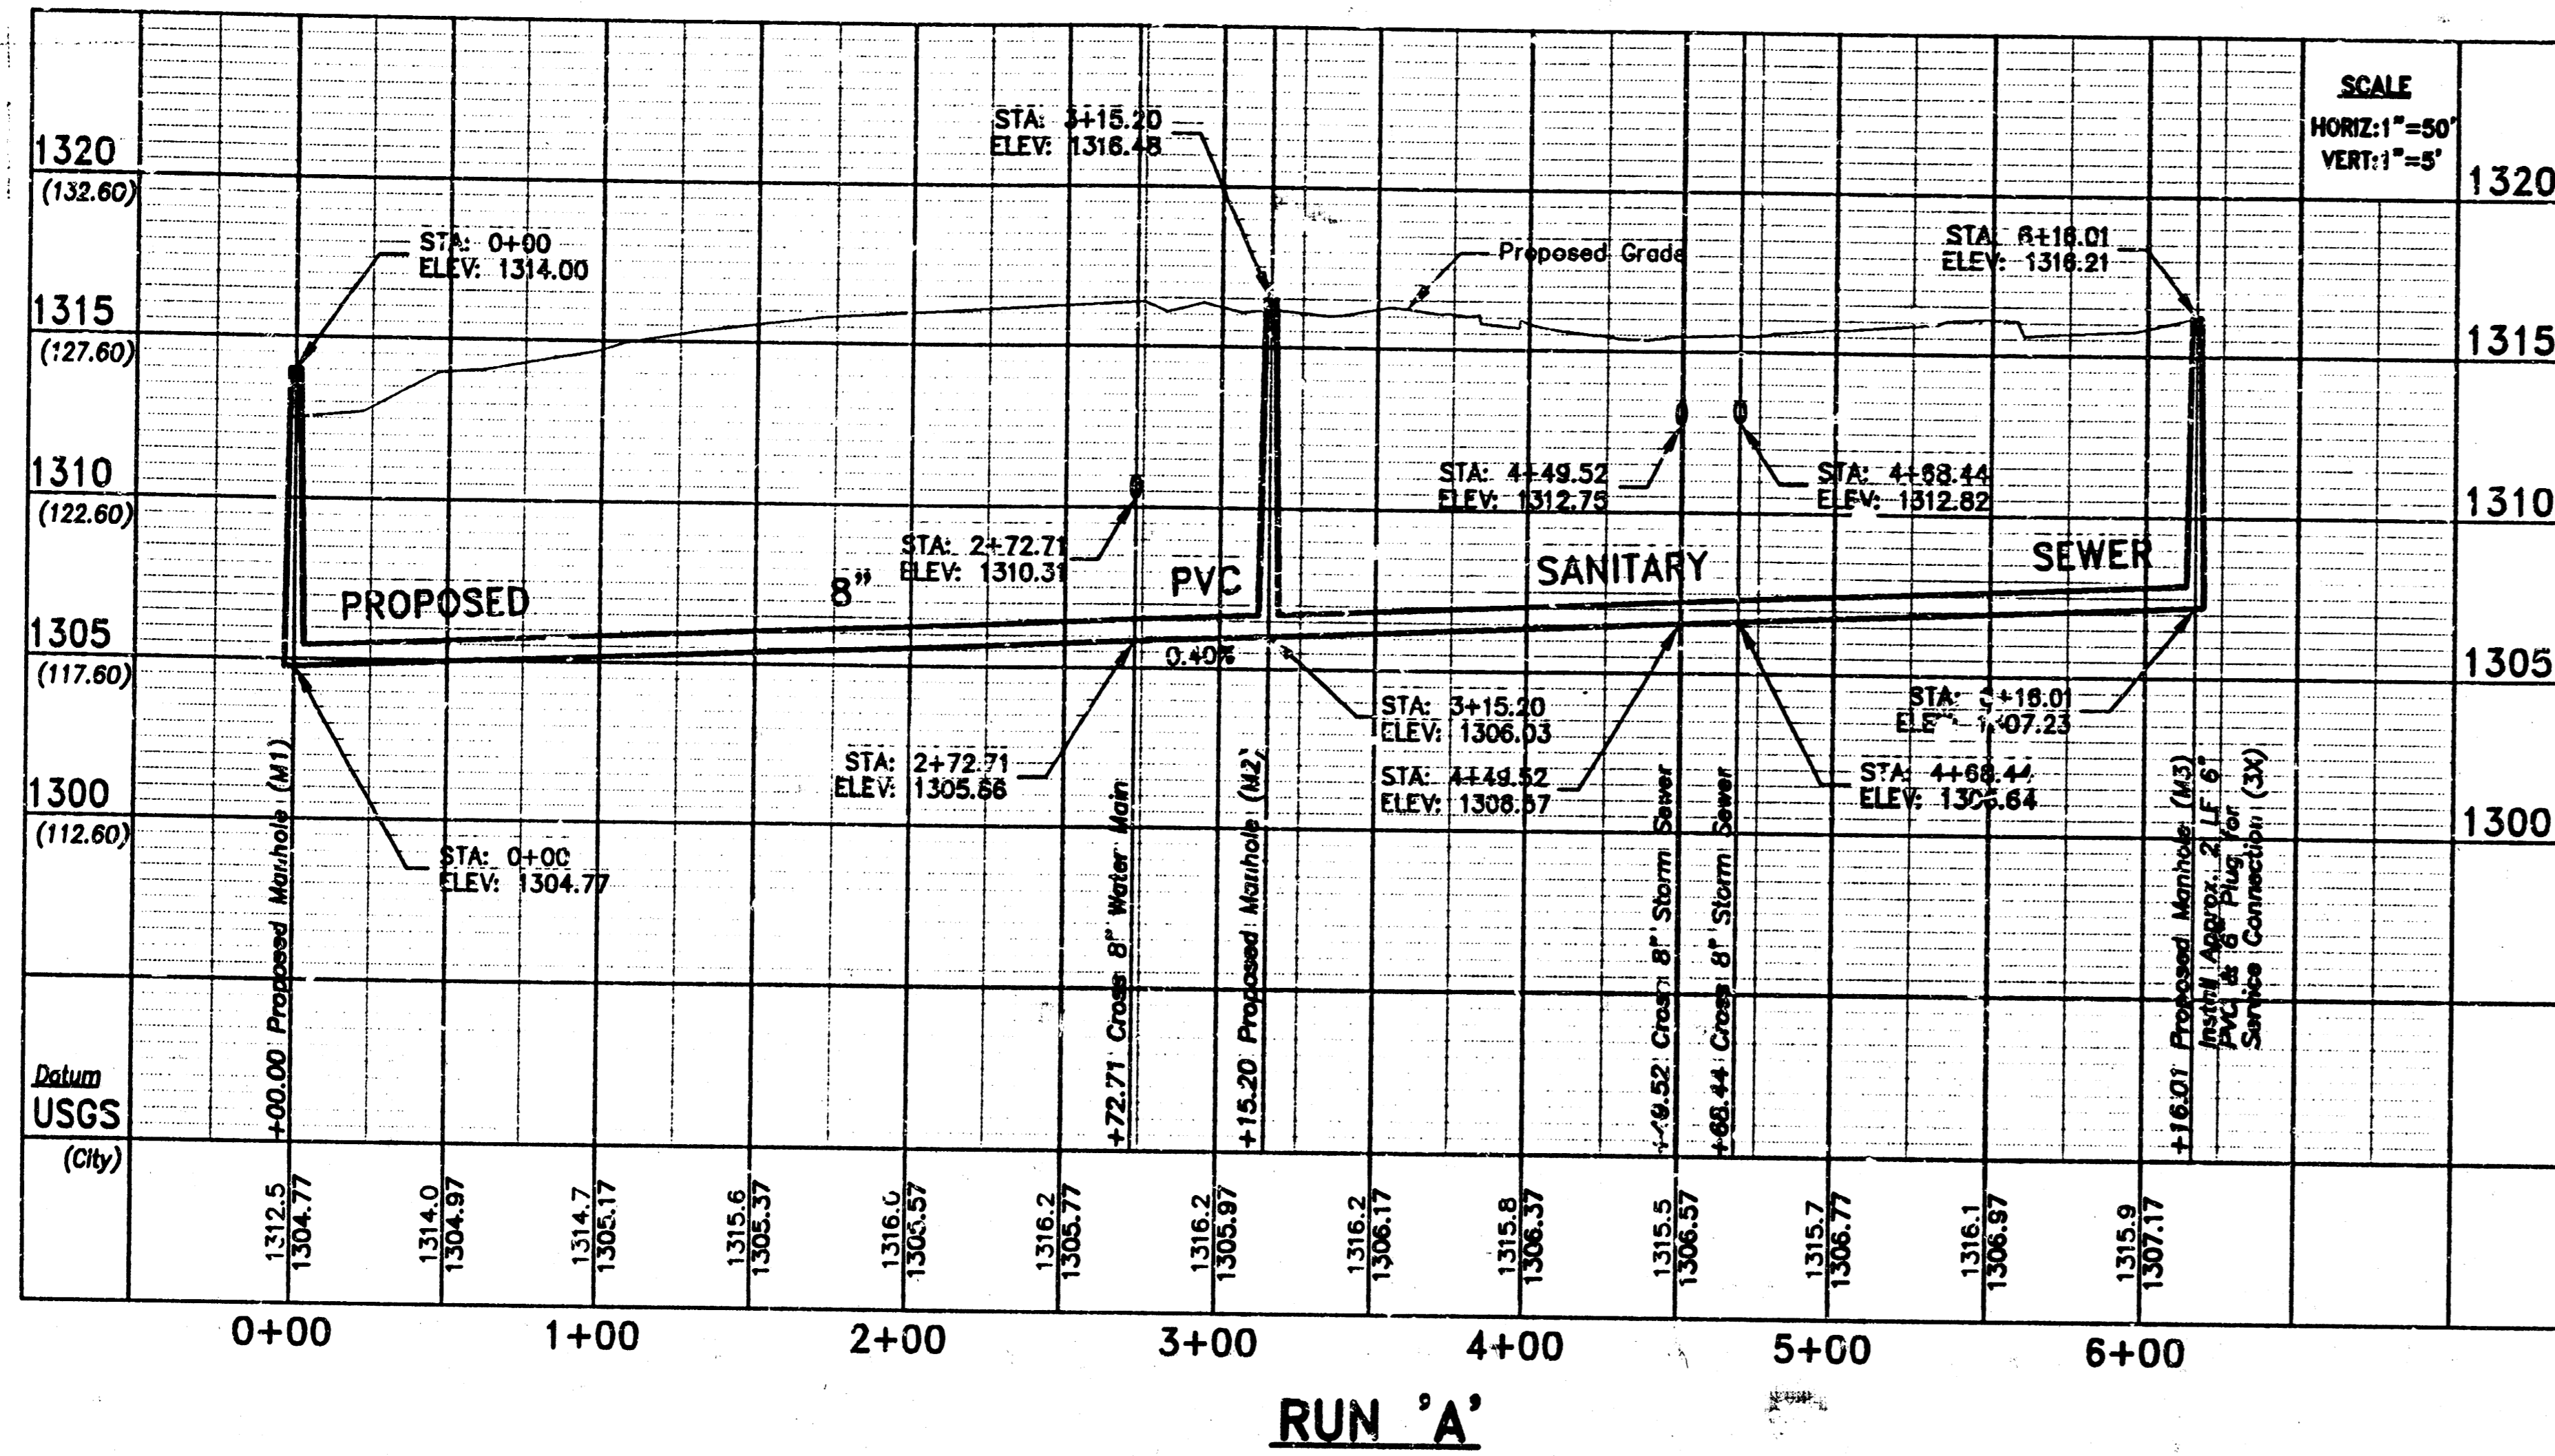

Elevations shown are in U.S.G.S. datum. Values in parentheses reference City of Wichita datum. City Datum = U.S.G.S. - 1187.40

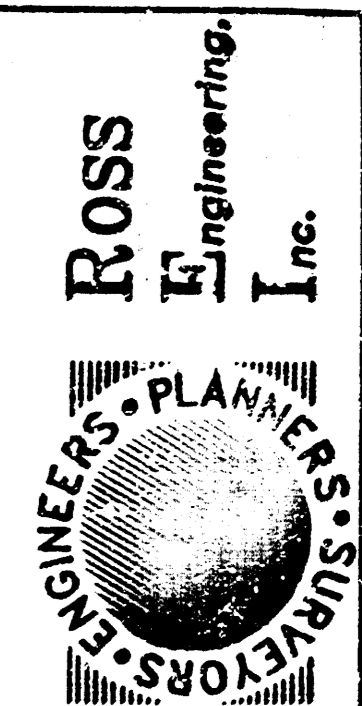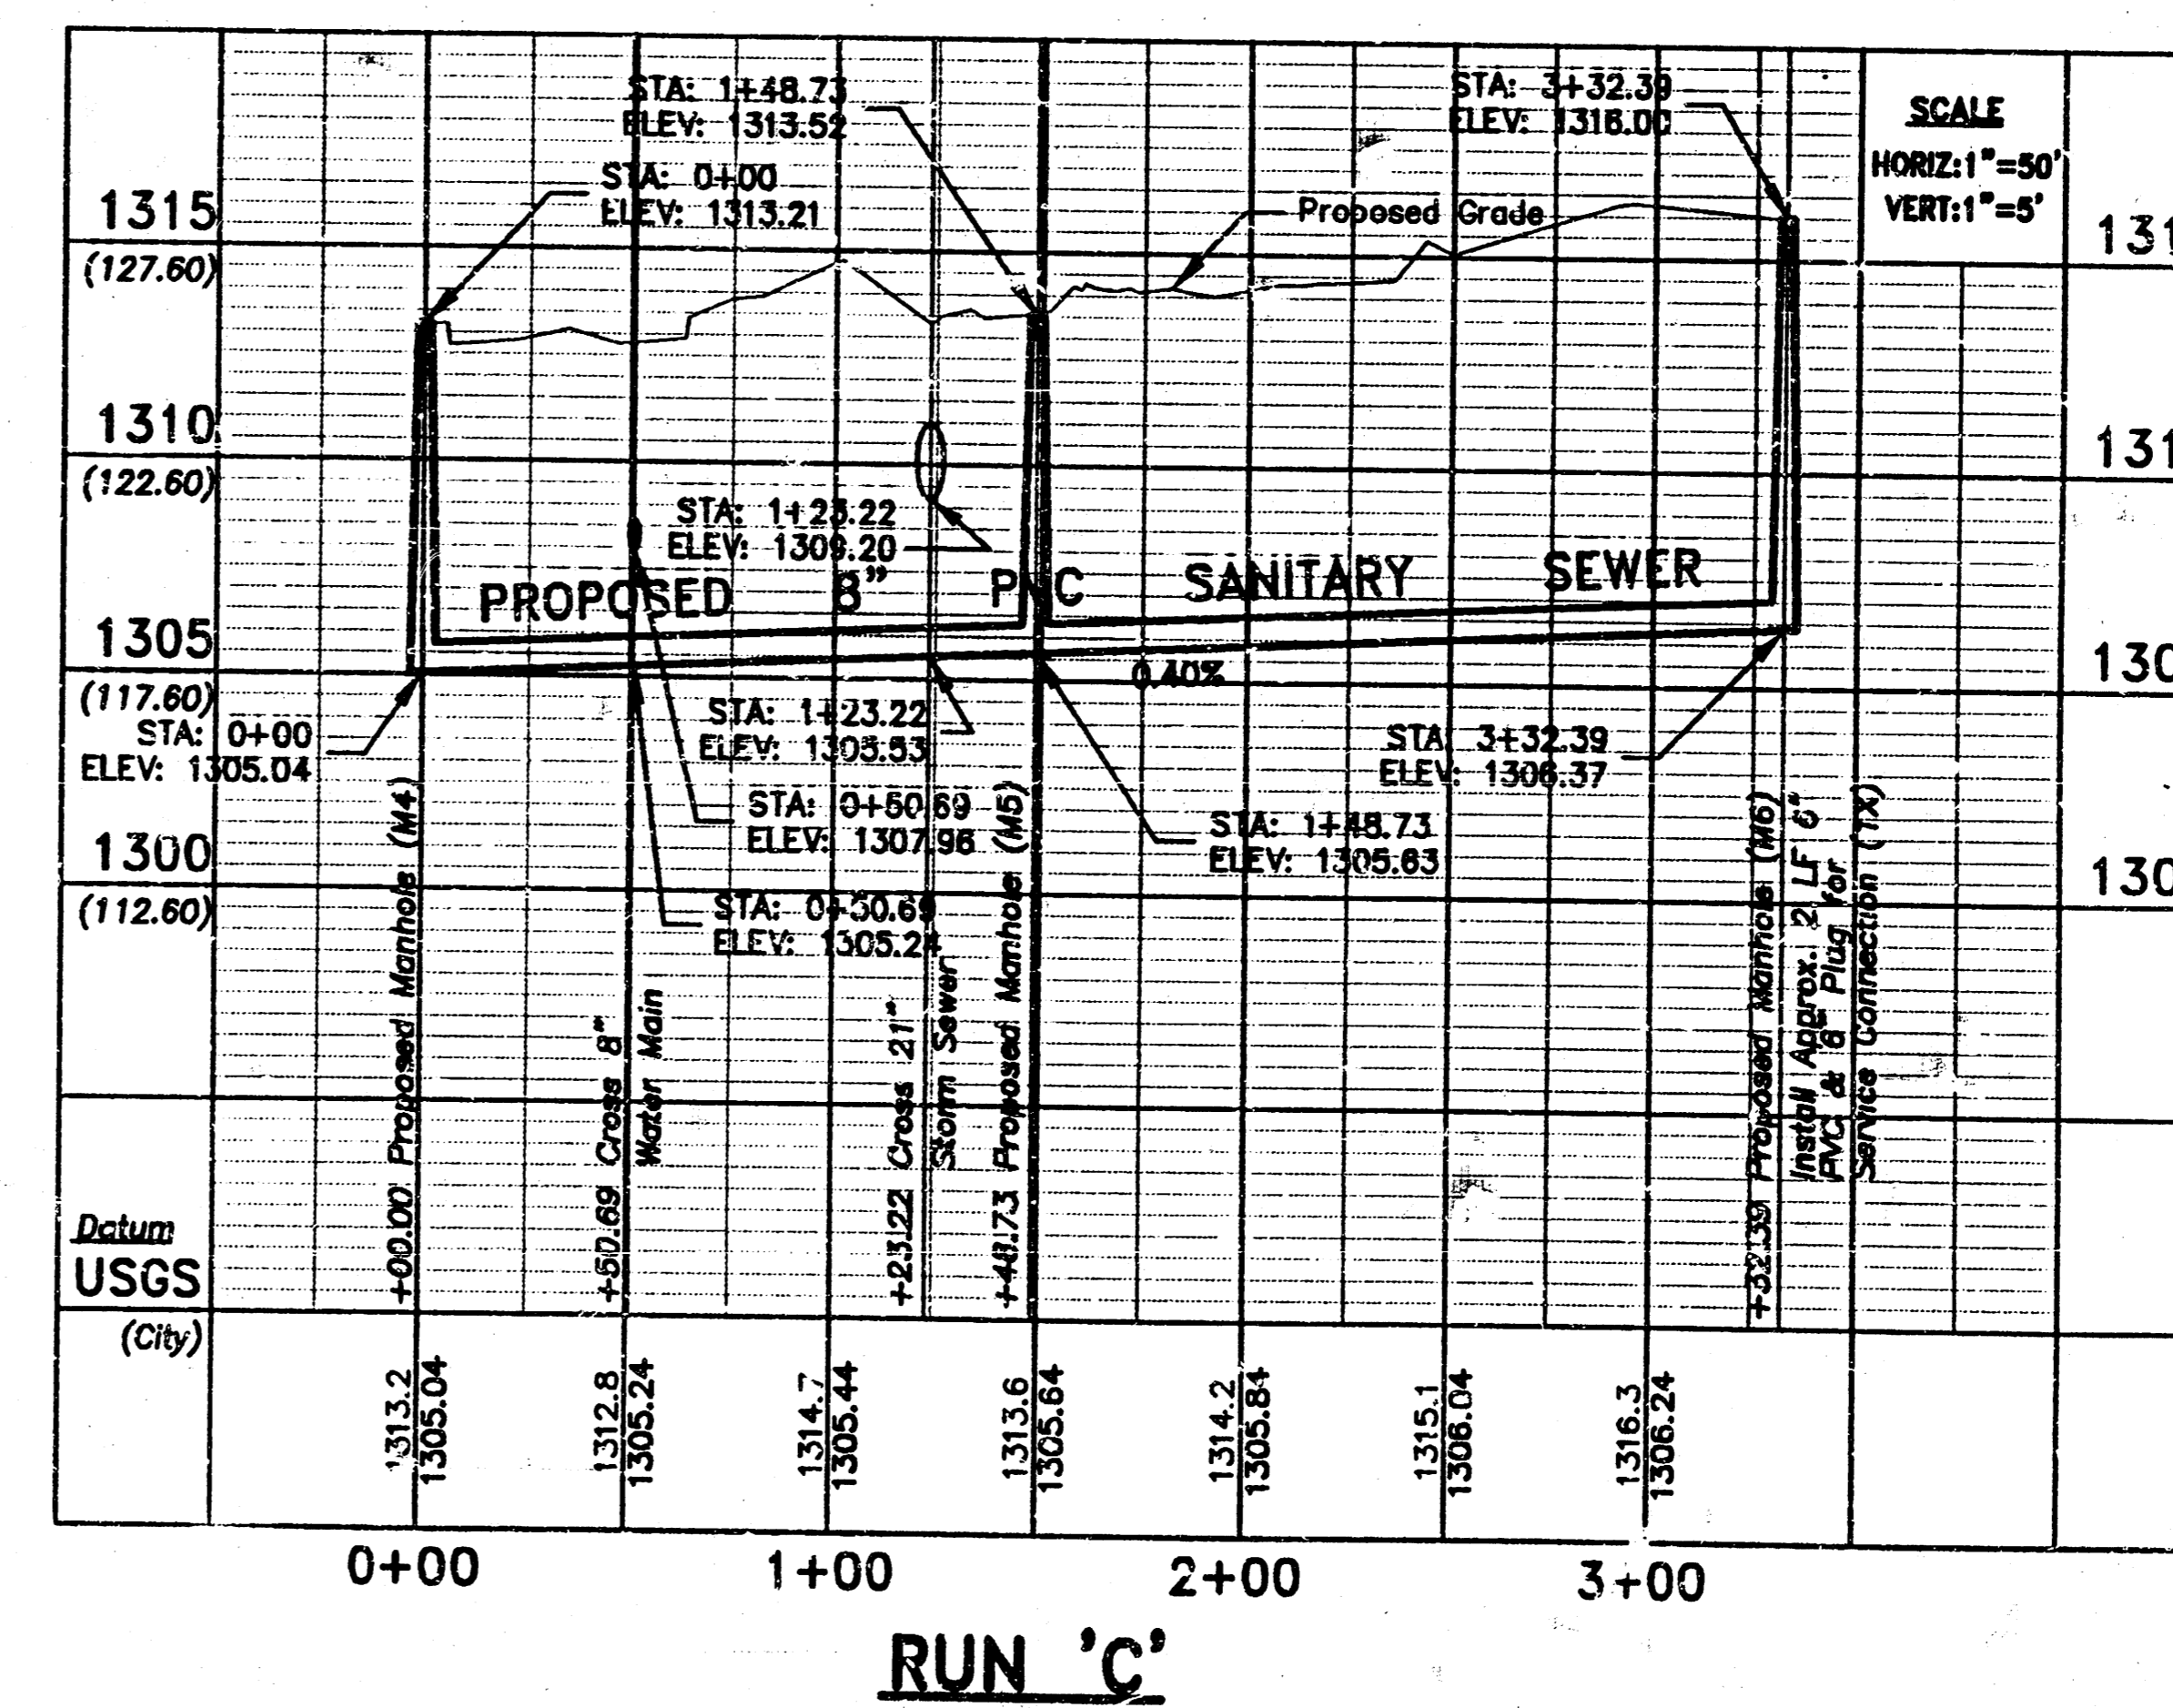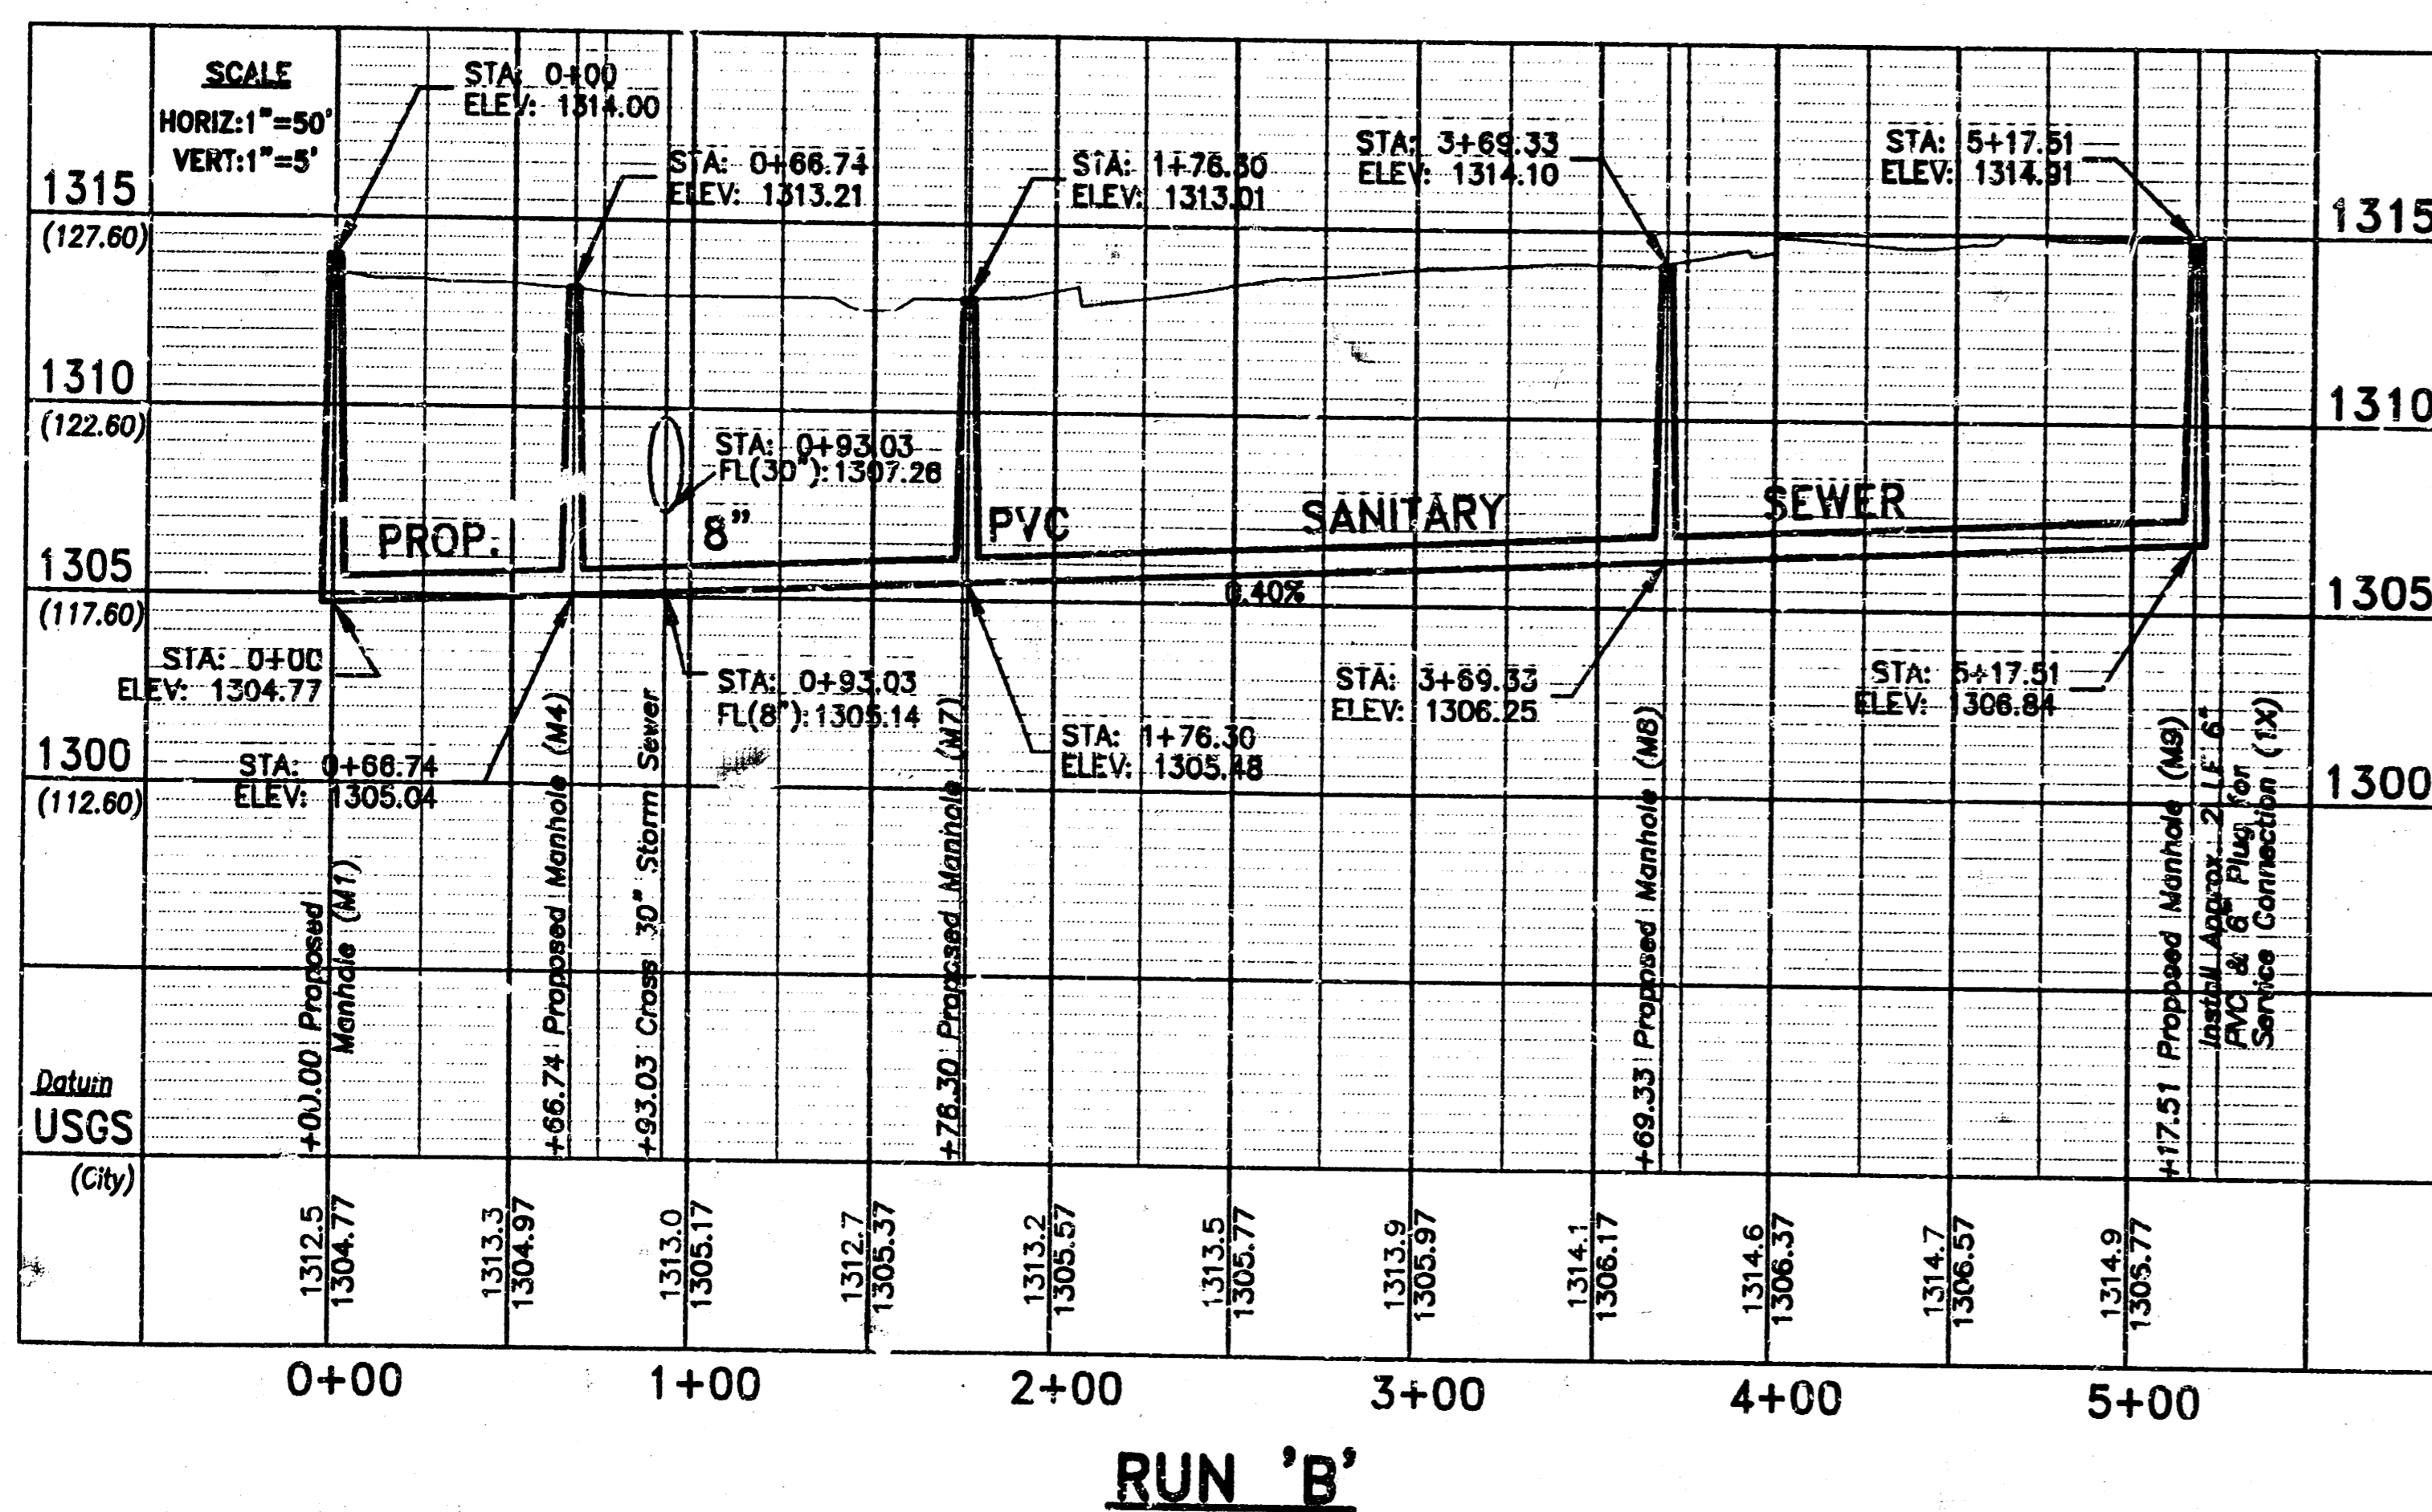

ROSS  
Engineers,  
Planners &  
Surveyors,  
Inc.

1415 M Street  
Suite 201  
Lincoln, NE 68502  
Phone 402-475-7977  
FAX 402-475-7028

Scale 1"=50'  
Drawn JH  
Checked JH  
Approved JH

Job# 888-10  
File 888013A  
Date 12/22/88  
Page 3/22/88

CROWNE CHASE  
RIDGE ROAD & SILVER SPRING BOULEVARD  
WICHITA  
KANSAS


SANITARY PROFILES

Sheet No.  
3  
OF  
9







# SEWER APPURTENANCES DETAILS

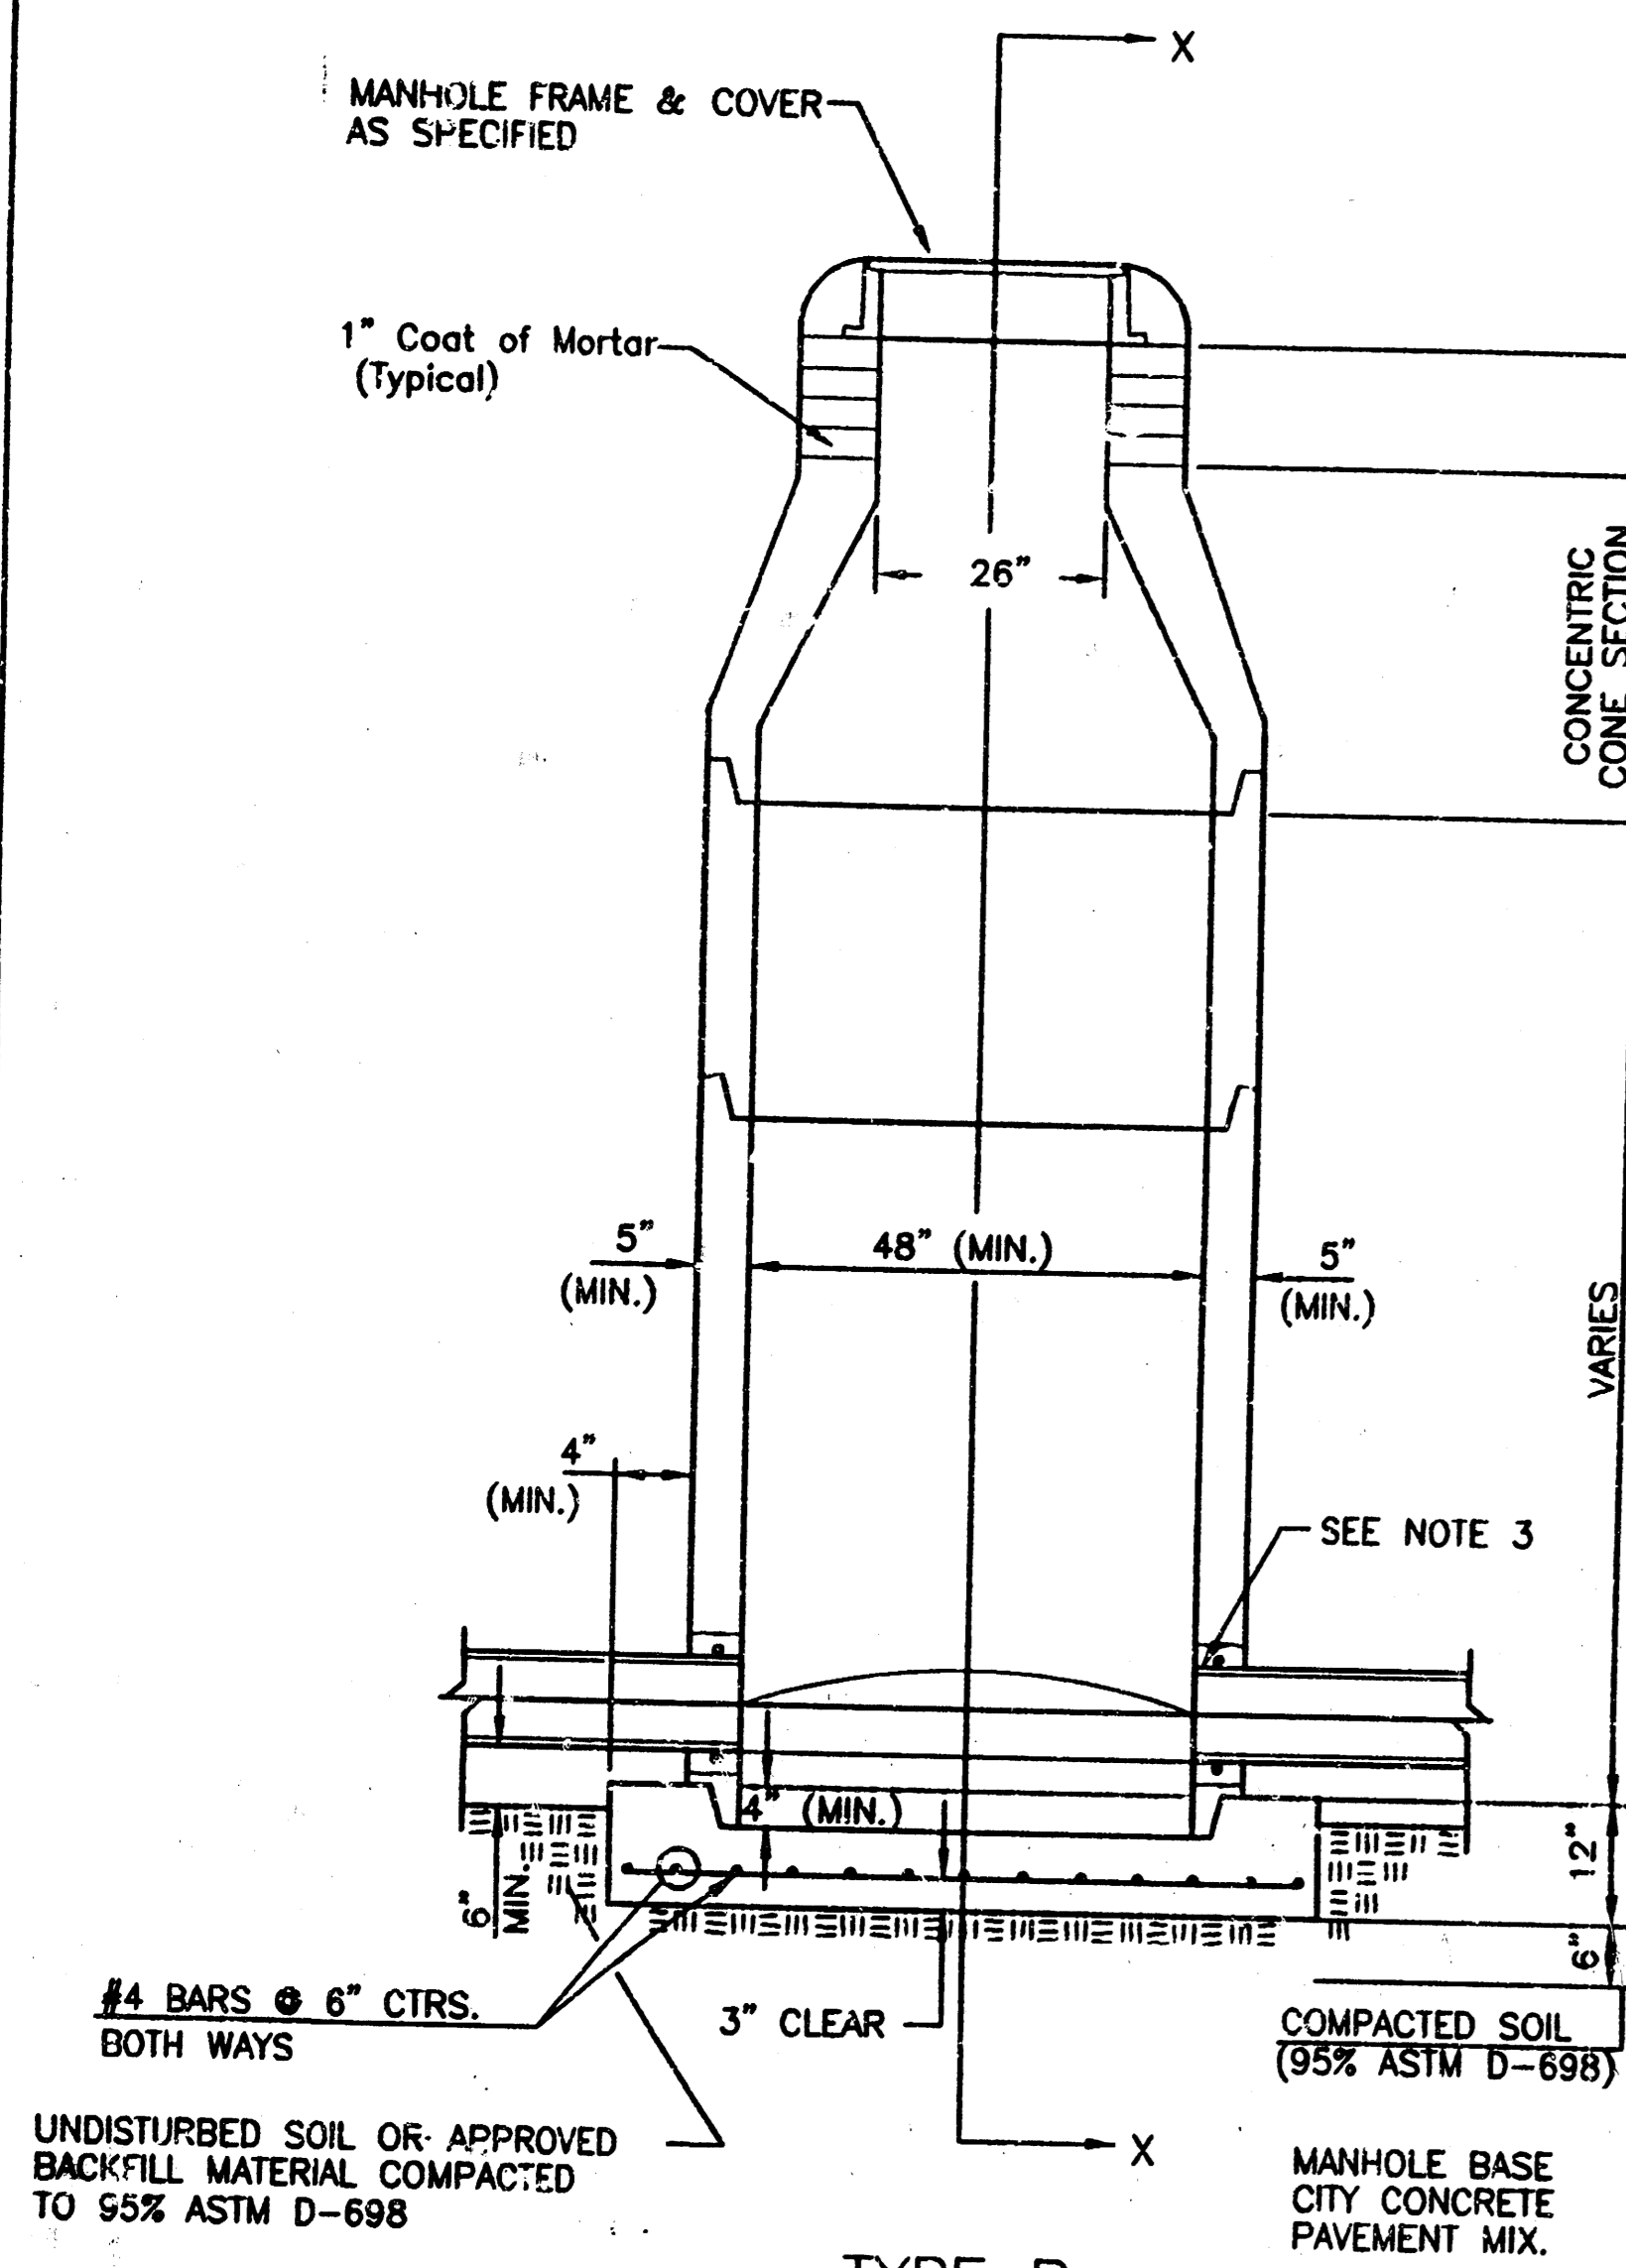


**TYPE P  
STANDARD MANHOLE**

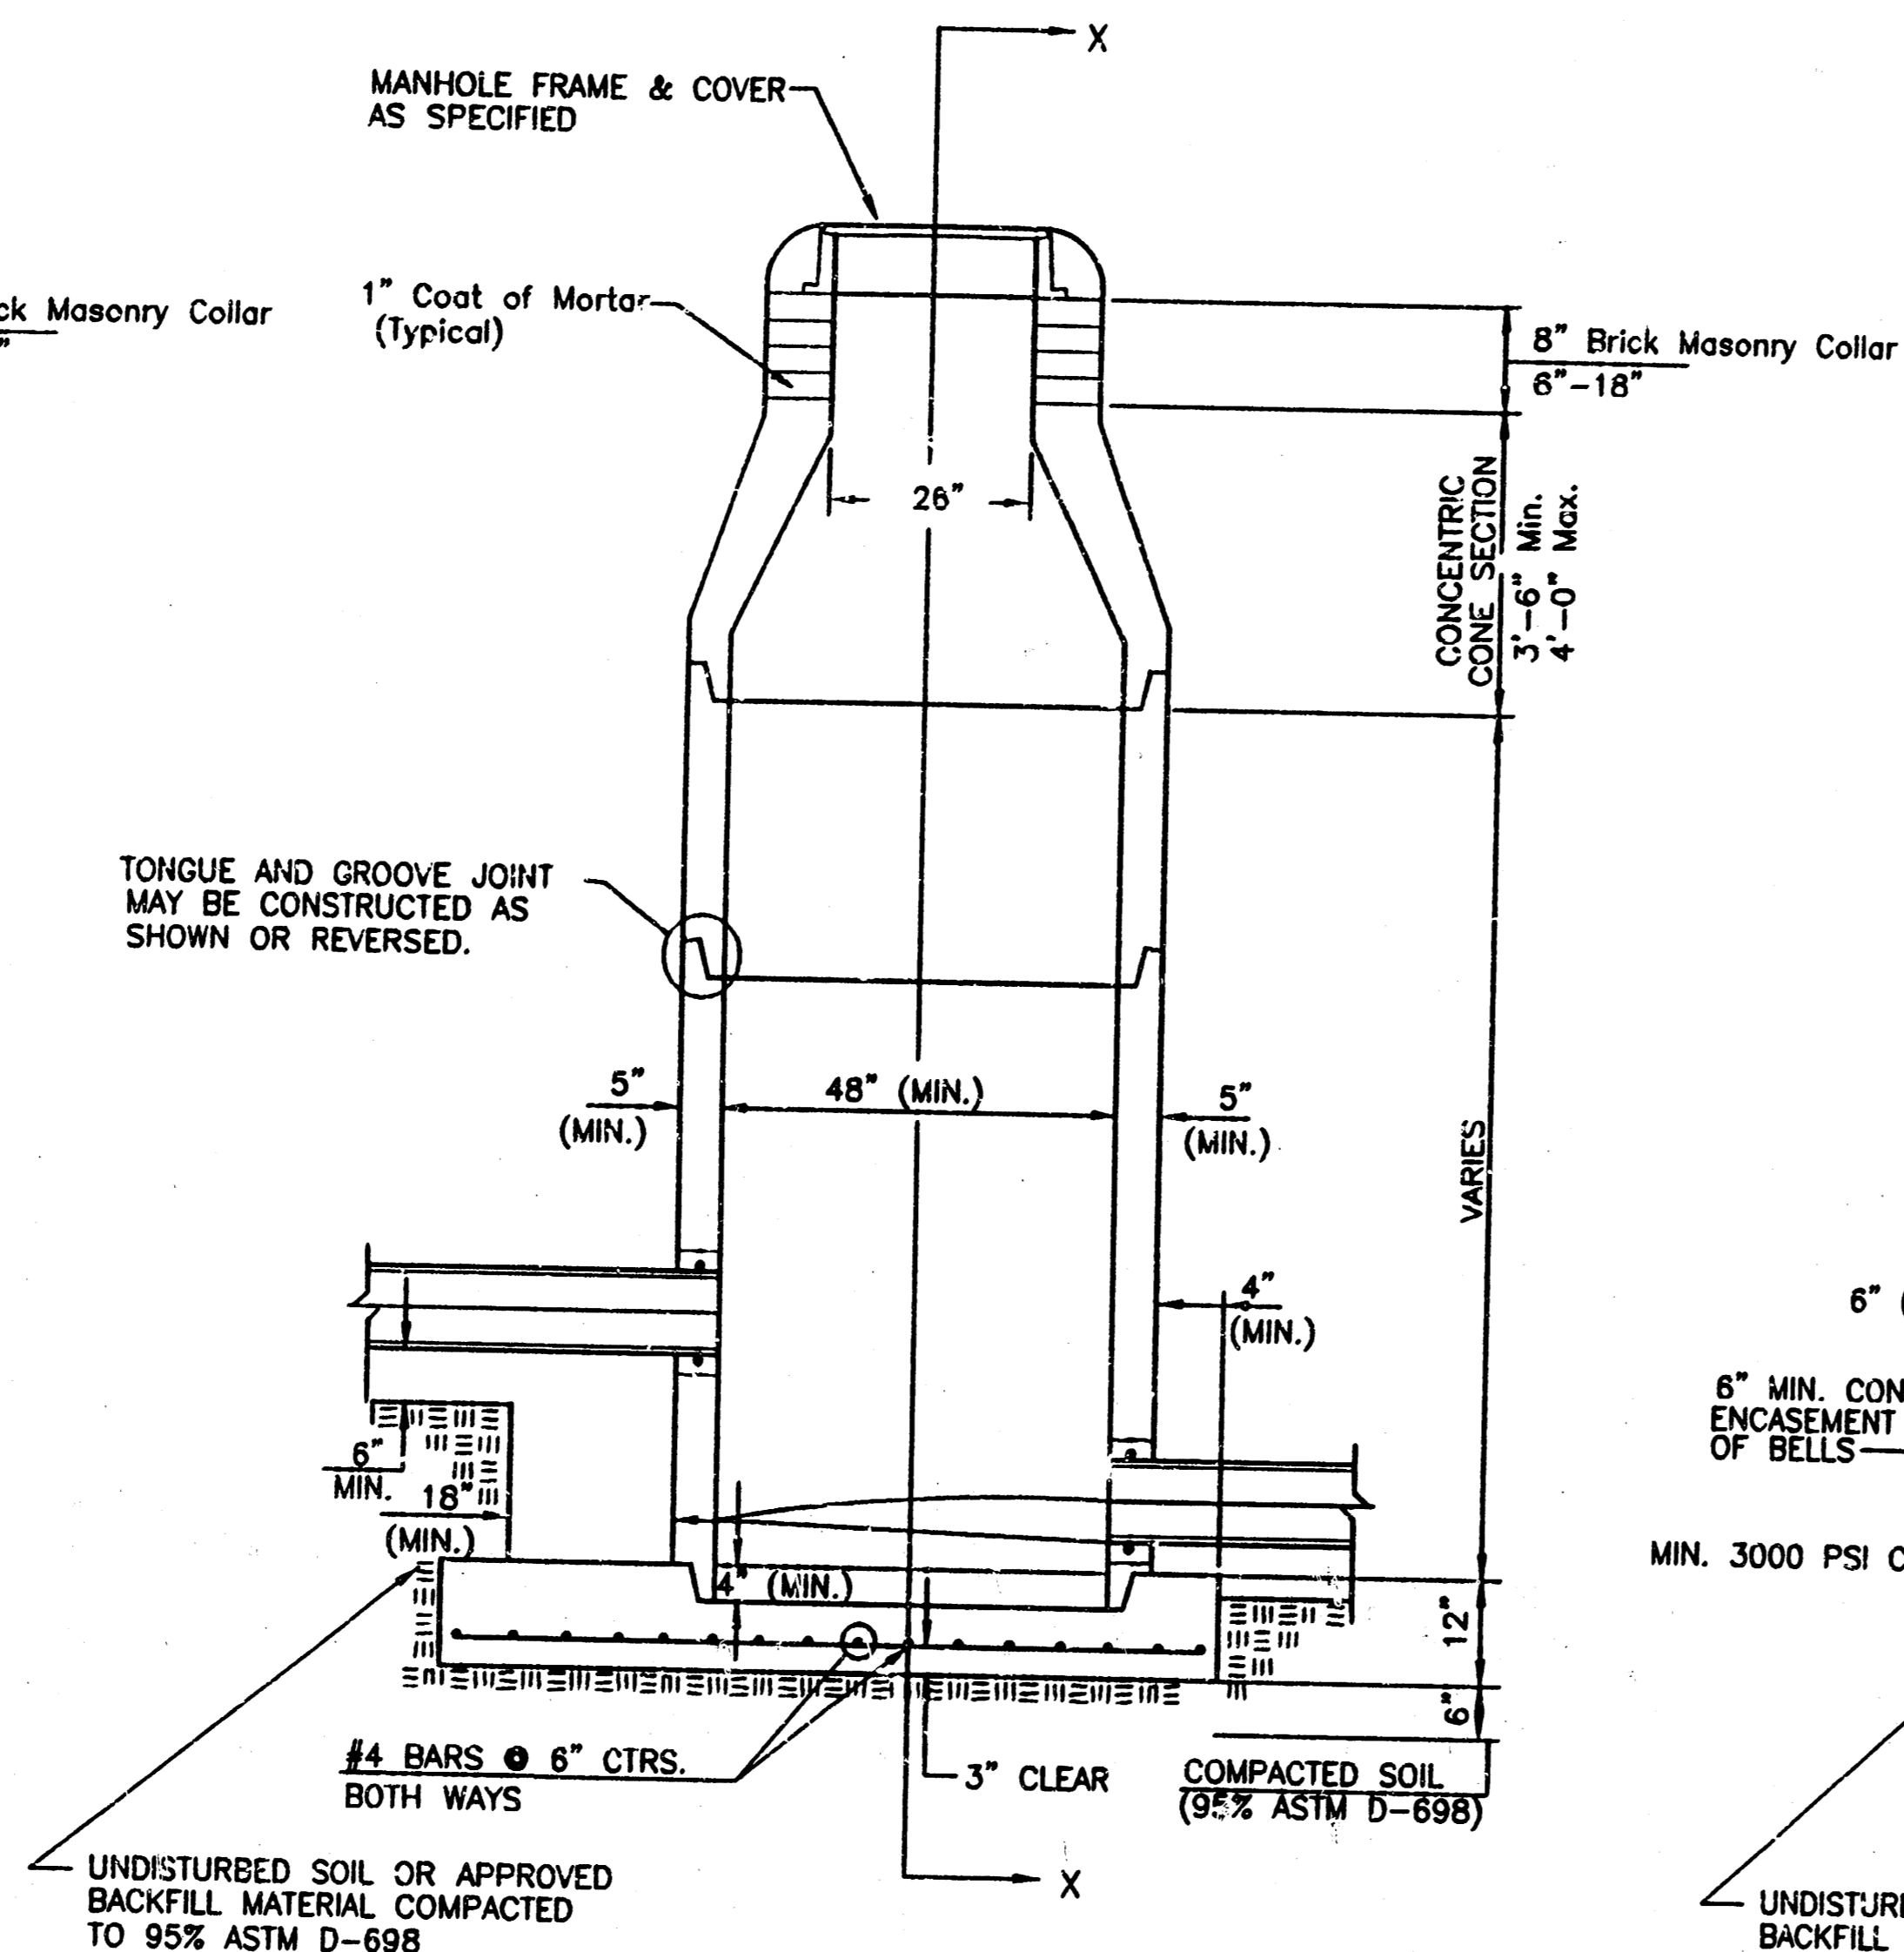

**TYPE P  
INSIDE DROP MANHOLE**

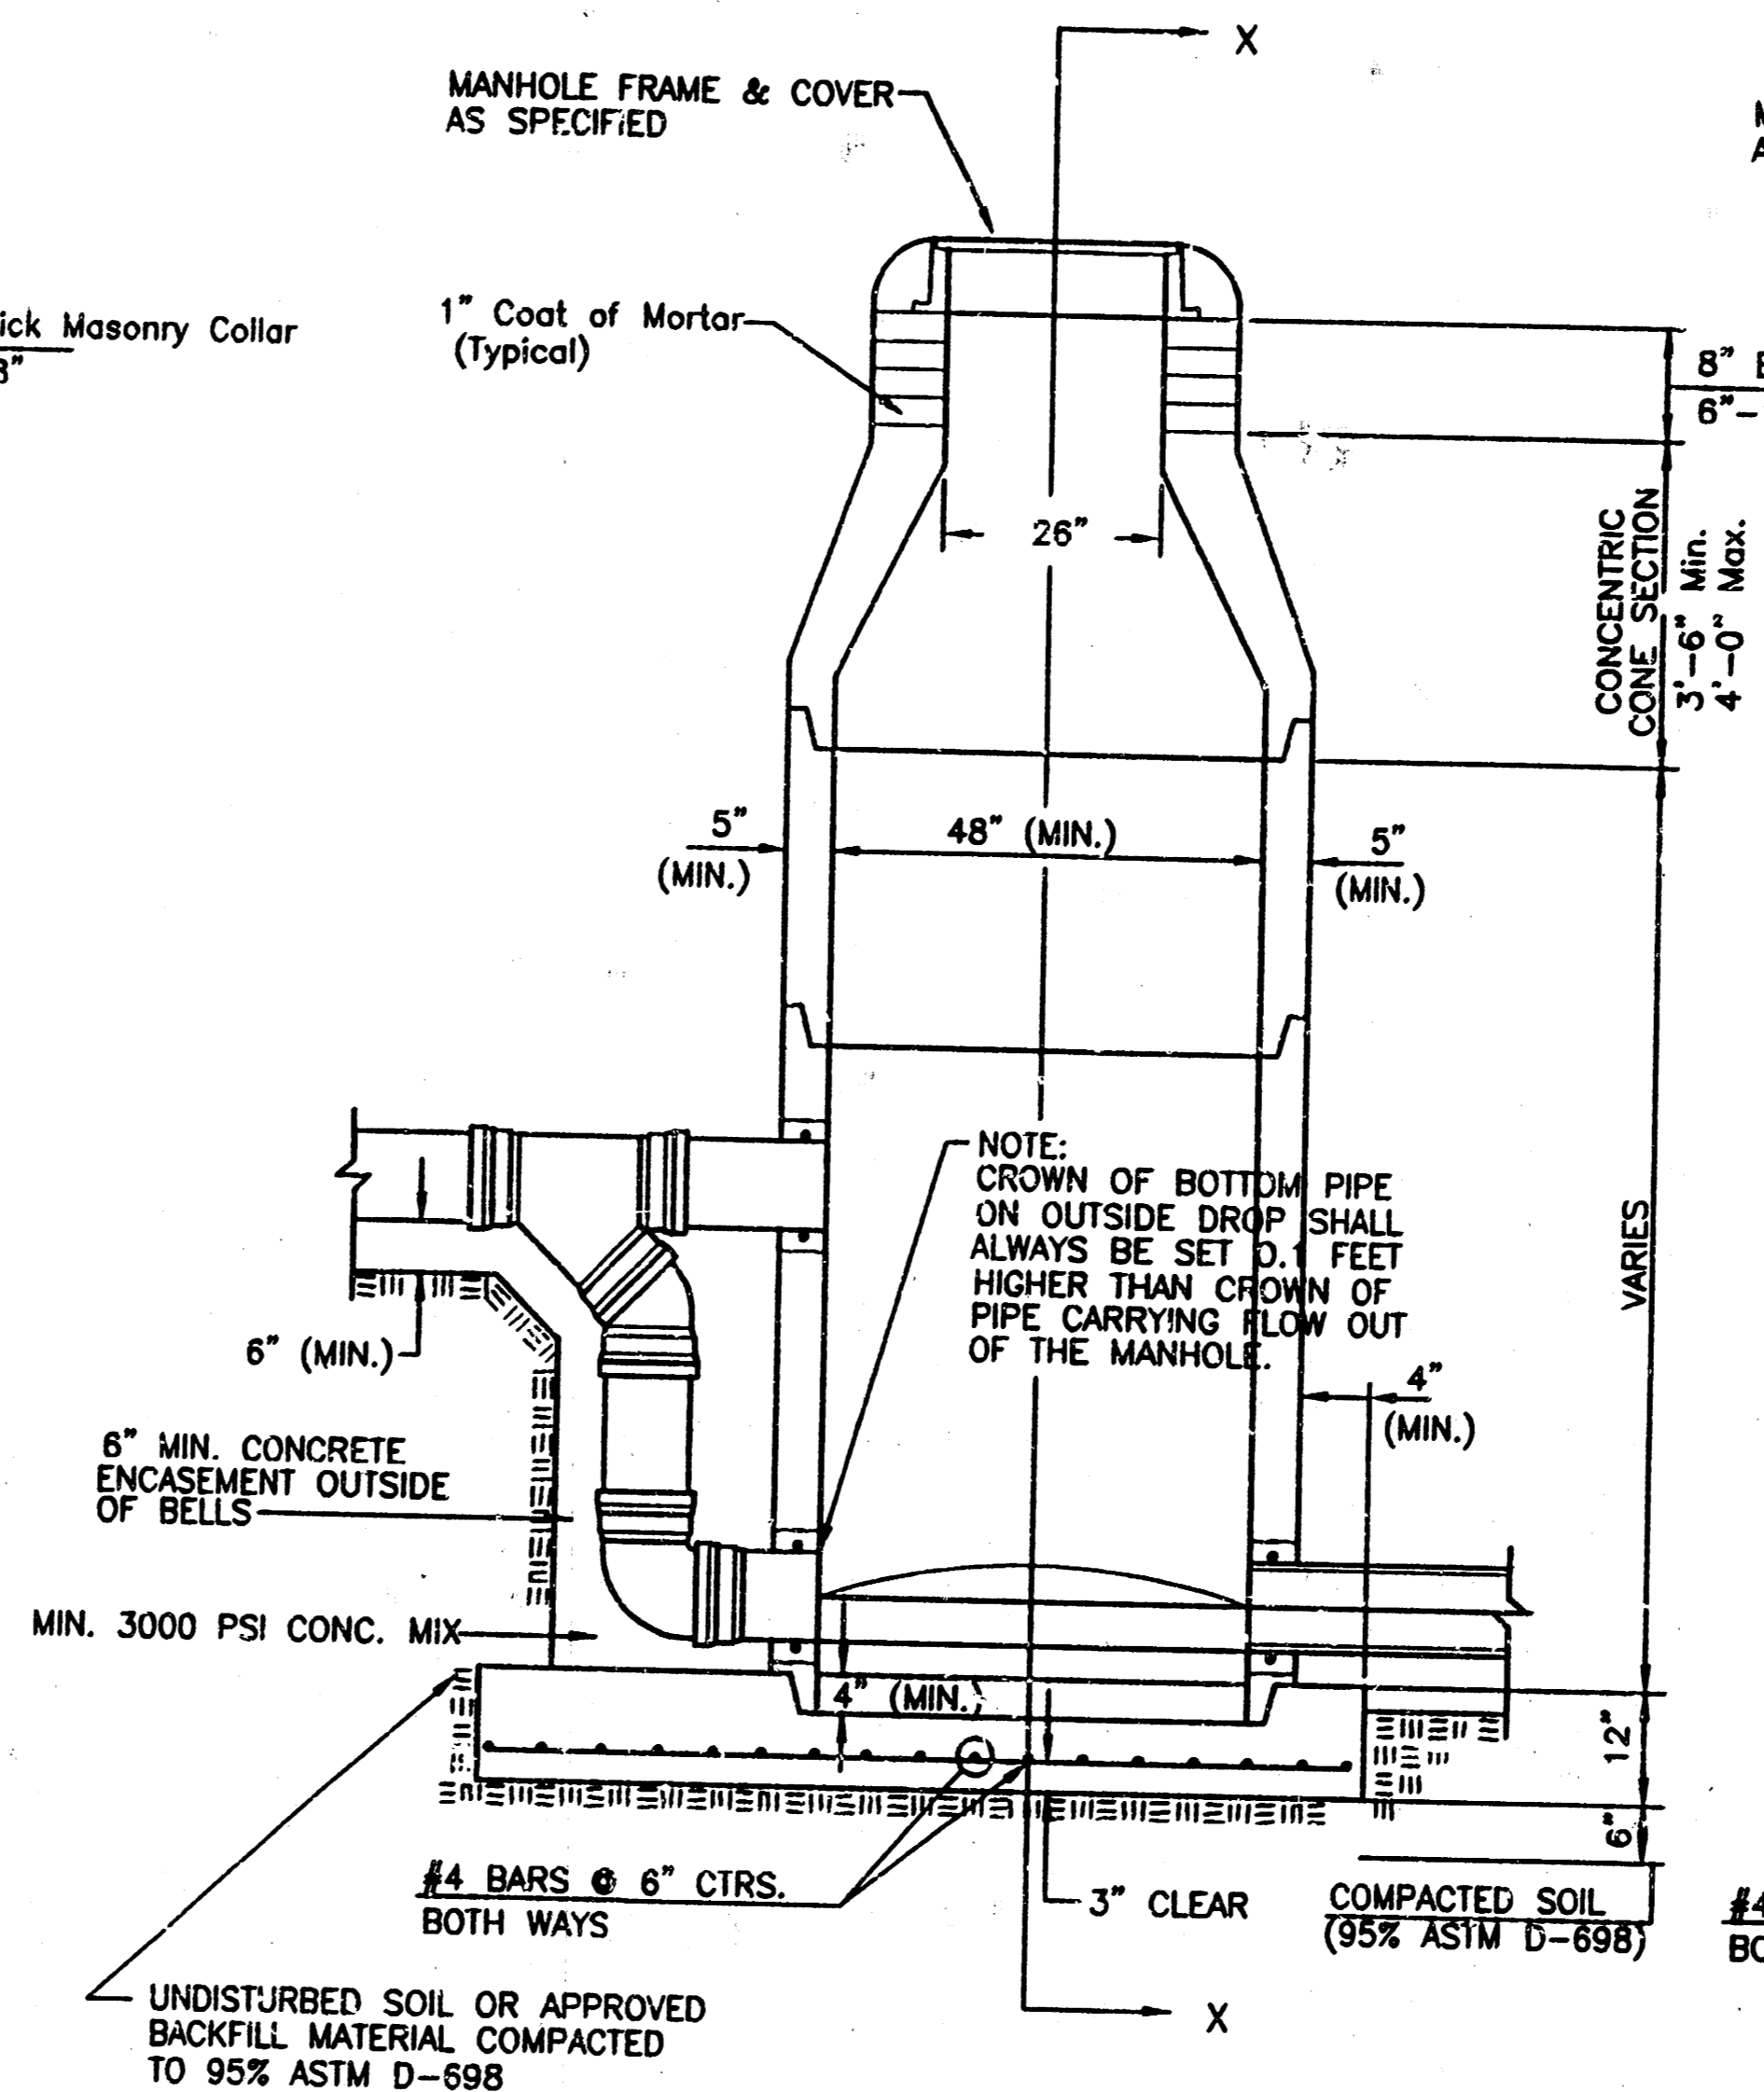


**TYPE P  
OUTSIDE DROP MANHOLE**

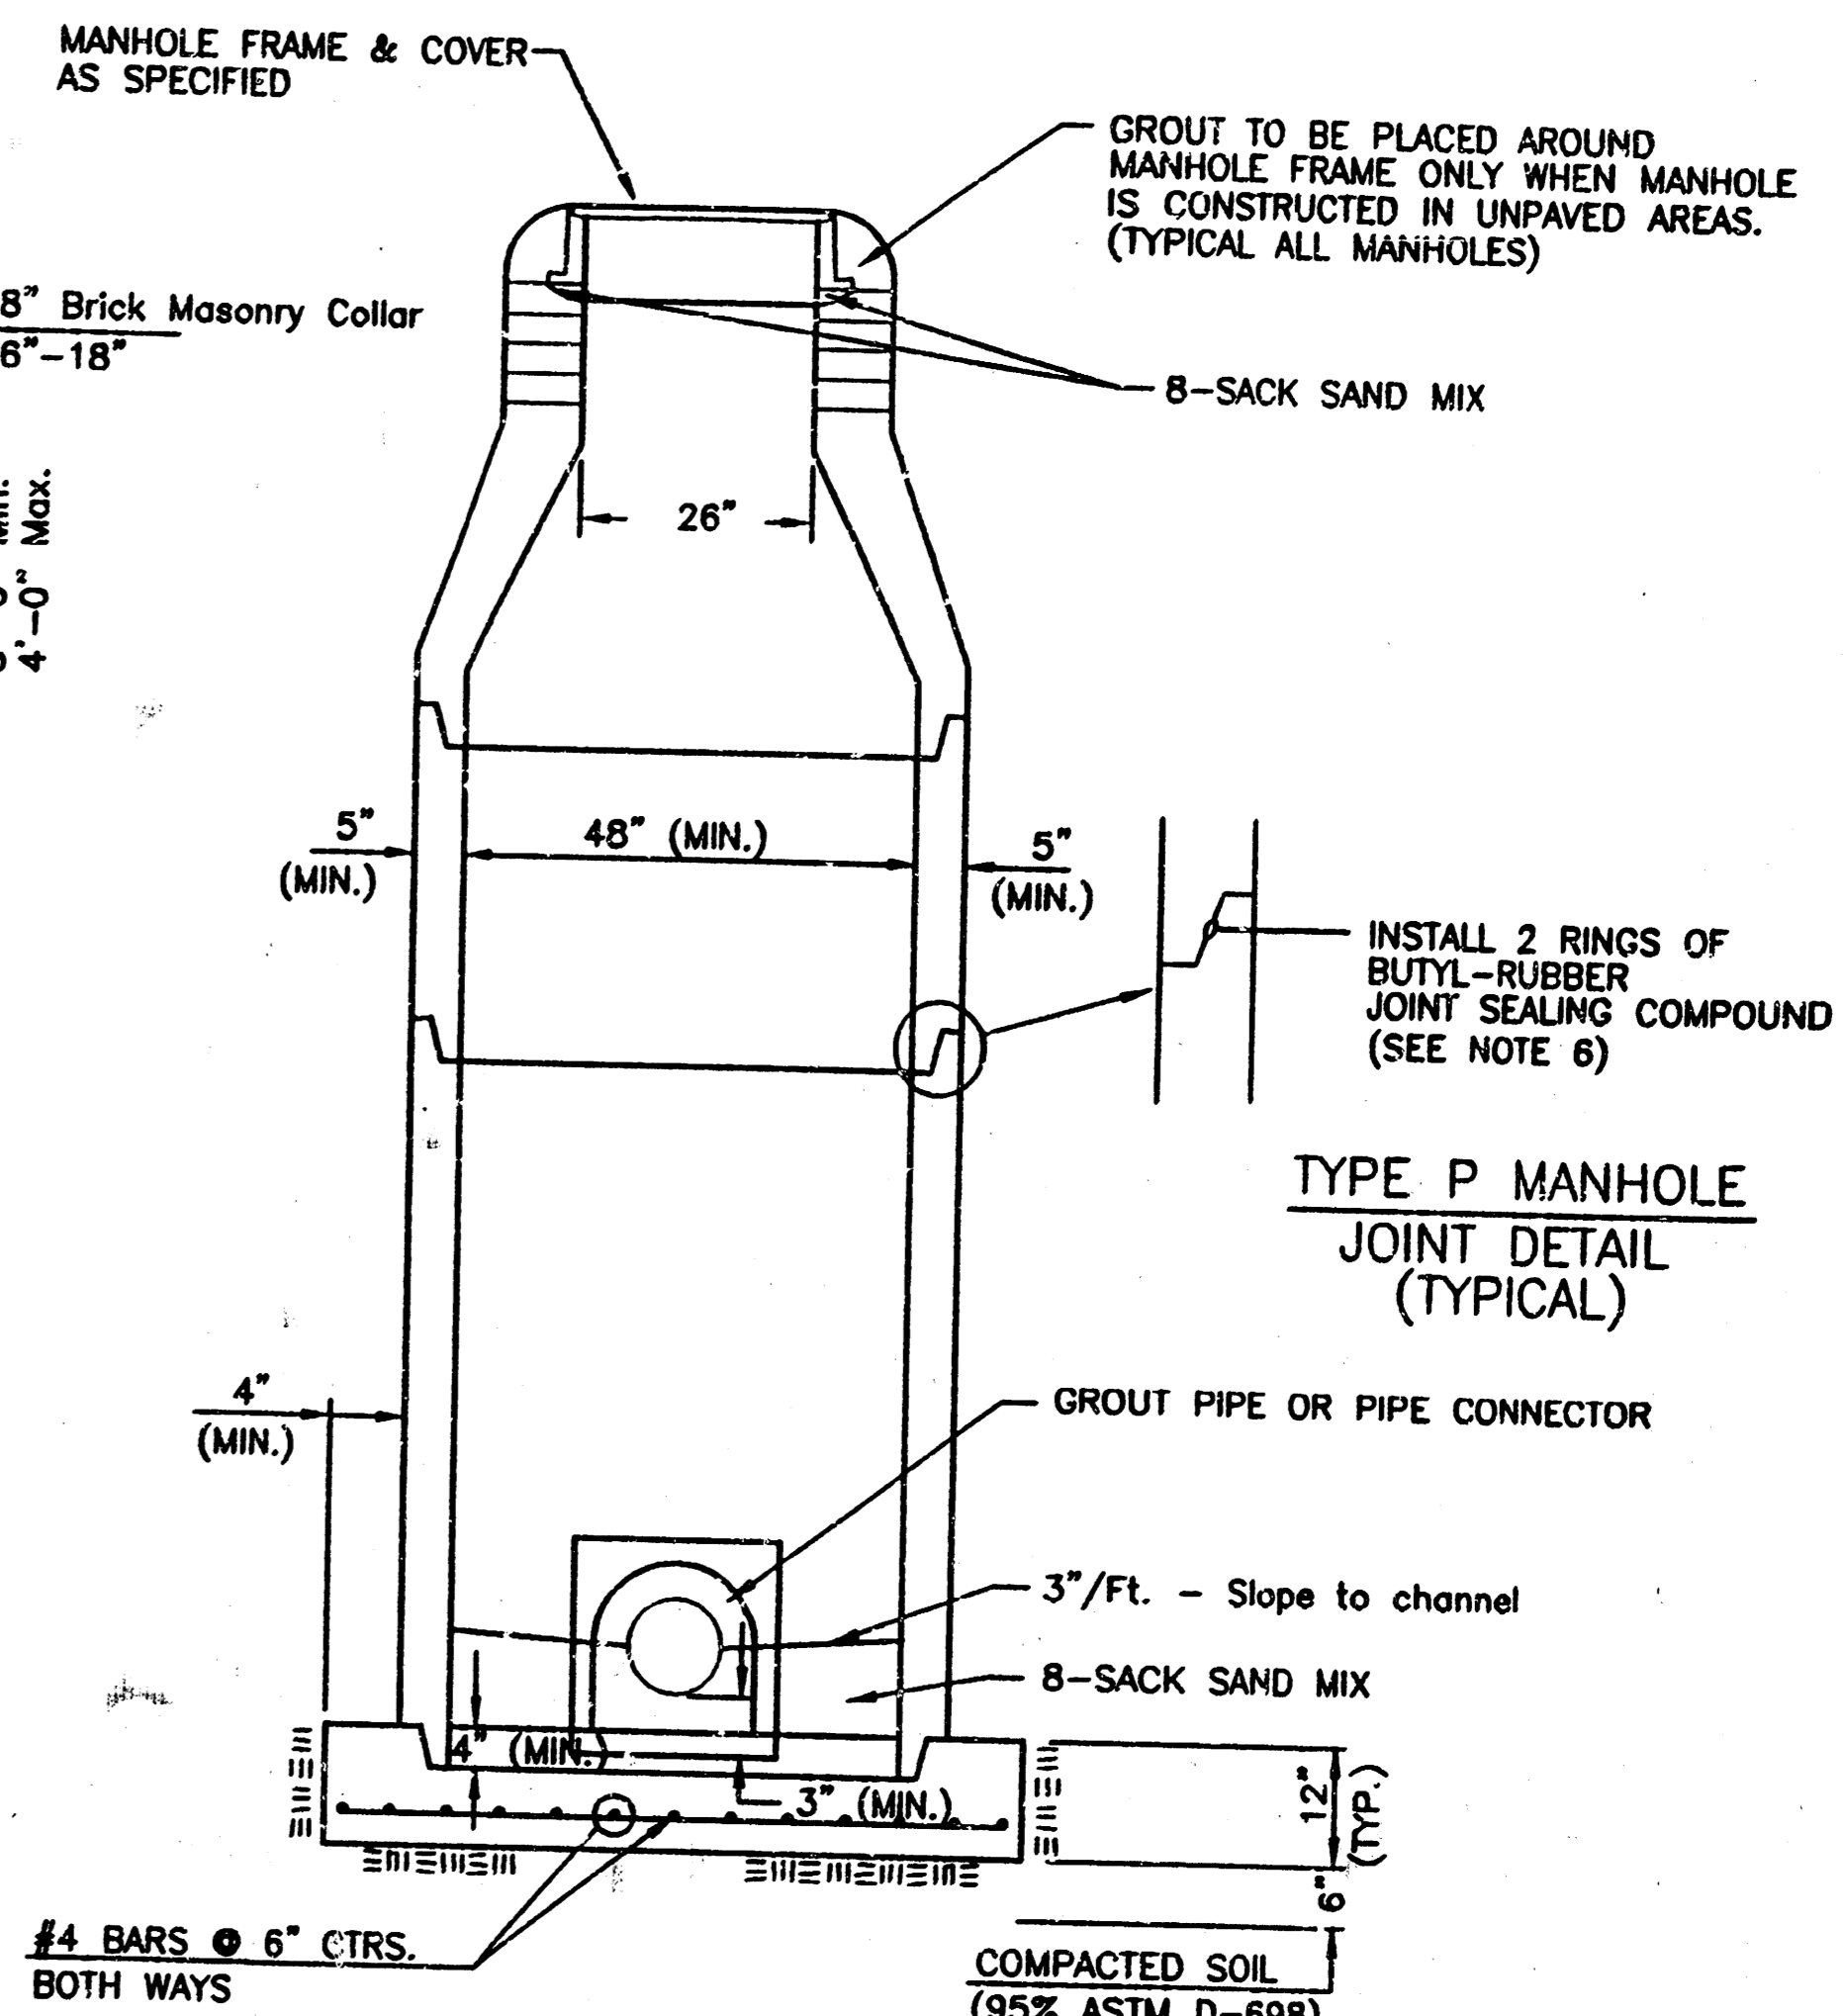


**SECTION X  
(TYPICAL)**

**GENERAL NOTES**  
**PRECAST MANHOLE NOTES**


- ALL PRECAST CONCRETE MANHOLE SECTIONS SHALL CONFORM TO THE LATEST REVISIONS OF A.S.T.M. C478 AS MODIFIED BY THE SPECIFICATIONS.
- NON-SHRINK GROUT SHALL BE NON-METALLIC TYPE.
- APPROVED FLEXIBLE WATERSTOP GASKETS SHALL BE INSTALLED TO JOIN THE SEWER TO THE MANHOLE WALL WHEN A.B.S. COMPOSITE PIPE OR P.V.C. PIPE IS USED. FOR OTHER TYPES OF PIPE THE SEWER PIPE SHALL BE GROUDED IN PLACE WITH NON-SHRINK GROUT. THE SEWER PIPE SHALL BE SUPPORTED WITH CONCRETE ENCASUREMENT A MINIMUM OF 3 FEET FROM THE MANHOLE WALL AND TO THE FIRST JOINT FOR V.C.P. SUCH THAT THE JOINT REMAINS FLEXIBLE.
- ALL INSIDE SURFACES OF THE CONCRETE MANHOLE WHICH WOULD BE EXPOSED TO SEWER GAS SHALL BE COATED WITH 2 COATS TNEMC SERIES 66 HI-BUILD EPOXYLINE, DRY THICKNESS OF 8 MILS (MIN).
- EXTERIOR MANHOLE WALLS SHALL BE COATED WITH 1 COAT MOBILARMA 633 BITUMINOUS COATING.
- JOINT SEALING COMPOUND SHALL BE KENT SEAL NO. 2 OR APPROVED EQUAL.
- PRECAST MANHOLES SHALL BE SET AT LEAST 4 INCHES INTO THE MANHOLE BASE.
- TOP OF MANHOLE FLOOR SLAB SHALL BE AT LEAST 3 INCHES BELOW THE FLOW LINE OF THE OUTLET PIPE TO INSURE SUFFICIENT MINIMUM THICKNESS OF SHAPED INVERT.
- LIFTING HOLES SHALL BE FILLED WITH NON-SHRINK GROUT AND THE INTERIOR SURFACE COATED AS SPECIFIED.
- MORTAR USED IN MASONRY CONSTRUCTION SHALL CONTAIN 8 SACKS OF CEMENT PER CUBIC YARD. CONCRETE USED IN MANHOLE BASES SHALL CONFORM TO THE REQUIREMENTS OF CONCRETE FOR CONCRETE PAVEMENT CONSTRUCTION AS SPECIFIED IN THE CITY STANDARD PAVING SPECIFICATIONS USING CITY CONCRETE PAVEMENT MIX WITHOUT AIR ENTRAINING ADMIXTURE. MORTAR SHALL BE PLACED AROUND THE MANHOLE RING AS SHOWN ON THE DRAWINGS WHEN MANHOLES ARE CONSTRUCTED IN UNPAVED AREAS. MANHOLES CONSTRUCTED WHERE PIPE SIZES ARE SMALLER THAN 24" SHALL HAVE AN INSIDE DIAMETER OF 4". MANHOLES CONSTRUCTED WHERE PIPE SIZES ARE 24" OR LARGER SHALL HAVE AN INSIDE DIAMETER OF 5". COMPLETED MANHOLE SHALL BE WITHOUT LEAKS AND WATER TIGHT.
- REINFORCING STEEL SHALL BE INSTALLED IN THE MANHOLE BASES AND SHALL CONSIST OF NO. 4 BARS PLACED ON 6" CENTERS IN BOTH DIRECTIONS. THE MANHOLE BASE REINFORCEMENT SHALL BE PLACED AT LEAST 3" ABOVE THE BOTTOM OF THE MANHOLE BASE. ALL COSTS FOR FURNISHING AND INSTALLING REINFORCING STEEL SHALL BE INCLUDED IN THE UNIT PRICE BID FOR THE MANHOLE.
- OPENINGS SHALL BE CUT INTO THE MANHOLE WALL WHEN OUTSIDE DROPS ARE CONSTRUCTED ON EXISTING MANHOLES. SUCH OPENINGS CUT INTO EXISTING MANHOLES SHALL BE AS SMALL AS PRACTICAL TO FACILITATE INSTALLING AND GROUDED THE NEW PIPE IN PLACE. WATERSTOP GASKETS SHALL BE USED WITH P.V.C. AND A.B.S. COMPOSITE PIPE. THE NEW PIPE SHALL BE GROUDED INTO THE OPENING USING AN APPROVED NONSHRINK GROUT FOR THE FULL MANHOLE WALL THICKNESS. THE EXTERIOR OF THE COMPLETED CONNECTION SHALL BE SEALED WITH AN APPROVED BITUMINOUS COATING SUCH THAT THE CONNECTION WILL BE WATER TIGHT. FLOOR OF MANHOLE SHALL BE MODIFIED TO FORM NEW FLOW CHANNEL FOR THE NEW CONNECTION AS INDICATED BY THE DRAWING. THIS WORK, INCLUDING MODIFICATION OF MANHOLE FLOOR, SHALL BE PAID FOR AT THE UNIT PRICE BID FOR OUTSIDE DROP STACK CONSTRUCTED ON EXISTING MANHOLE.
- THE FLOORS OF ALL MANHOLES SHALL BE SHAPED WITH FLOW CHANNELS SUCH THAT THE MANHOLES WILL BE SELF CLEANING AND FREE OF AREAS WHERE SOLIDS COULD BE DEPOSITED AS SEWAGE FLOWS THROUGH THE MANHOLE FROM ALL INLET PIPES TO THE OUTLET PIPE. FLOW CHANNELS SHALL BE FORMED TO MATCH THE BOTTOM HALVES OF THE INFLOWING PIPES AND THE OUTFLOWING PIPE AS SHOWN BY THE DRAWINGS EXCEPT FOR INSIDE DROP MANHOLES. FLOW CHANNELS FOR INSIDE DROP MANHOLES SHALL BE CONSTRUCTED AS INDICATED BY THE DRAWING. MANHOLE FLOORS SHALL HAVE SLOPES OF 3 INCHES PER FOOT IN THE AREAS OUTSIDE OF THE FLOW CHANNELS SLOPED TOWARD THE FLOW CHANNELS. PIPES LAID THROUGH MANHOLES SHALL HAVE THE TOP HALF REMOVED TO NEAT LINES FOR THE FULL INSIDE DIAMETER OF THE MANHOLE. MANHOLE FLOORS SHALL THEN BE SHAPED AROUND THE BOTTOM HALF OF THE PIPE WHICH FORMS THE FLOW CHANNEL.
- PIPES INSTALLED WITHIN THE EXCAVATION MADE FOR THE MANHOLE SHALL BE CRADLED WITH CONCRETE TO THE LIMITS OF THE MANHOLE EXCAVATION. WHEN CLAY PIPE IS USED, THE CRADLE SHALL EXTEND TO THE FIRST JOINT OUTSIDE THE MANHOLE. THE CRADLE SHALL BE TERMINATED AT THE CLAY PIPE JOINT IN A MANNER WHICH WILL MAINTAIN THE FLEXIBILITY OF THE JOINT. COST OF CRADLE WITHIN MANHOLE EXCAVATION OR TO CLAY PIPE JOINTS ADJACENT TO MANHOLE SHALL BE INCLUDED IN THE UNIT PRICE BID FOR THE MANHOLE.
- MANHOLE COVER CASTINGS AND MANHOLE FRAME CASTINGS SHALL CONFORM TO THE REQUIREMENTS AS INDICATED IN THE STANDARD SPECIFICATIONS AND AS SHOWN IN THE STANDARD DETAIL DRAWING.
- THE VERTICAL DROP IN INSIDE DROP MANHOLES SHALL NOT EXCEED 2' FOR INFLOWING PIPES SIZED 12" OR SMALLER AND 2' FOR INFLOWING PIPES LARGER THAN 12". THE CROWNS OF INFLOWING PIPES SHALL NEVER BE SET LOWER THAN THE CROWN OF THE OUTFLOWING PIPE.
- STANDARD MANHOLES AND STANDARD INSIDE DROP MANHOLES SHALL BE BID AS STANDARD MANHOLES FOR THE TYPE AND DIAMETER INDICATED. OUTSIDE DROP MANHOLES SHALL BE BID AS STANDARD OUTSIDE DROP MANHOLES FOR THE TYPE AND DIAMETER INDICATED. ALL MANHOLE DIAMETERS WILL BE 4' UNLESS INDICATED OTHERWISE.
- A BRICK MASONRY COLLAR SHALL BE INSTALLED BETWEEN THE CAST IRON FRAME AND THE CONCENTRIC CONE. THE COLLAR WILL HAVE 8" WALLS AND A VERTICAL HEIGHT OF 6" MINIMUM AND 18" MAXIMUM. A 1" COAT OF MORTAR WILL BE PLASTERED ON THE OUTSIDE OF THE COLLAR. THE USE OF PRE-CAST CONCRETE SPACERS FOR MANHOLE TOP ADJUSTMENT IS ALSO ALLOWED.

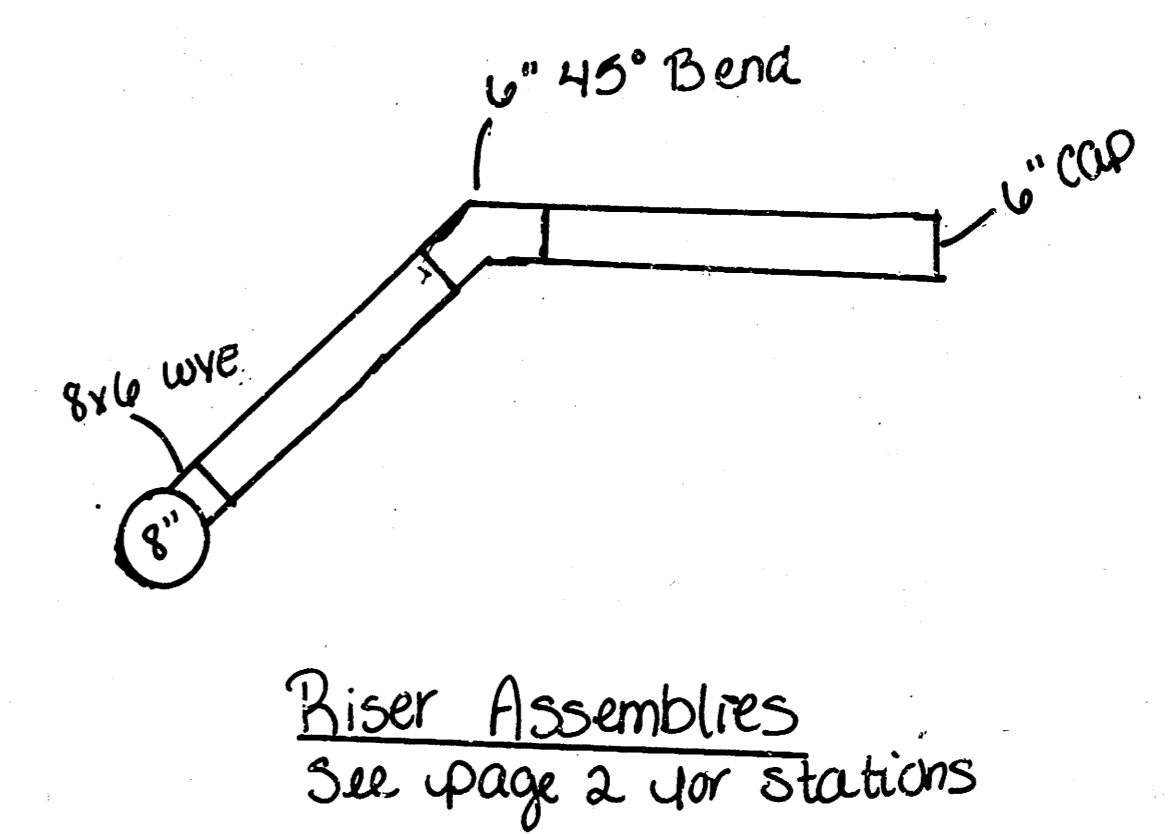


<p>THE CITY OF WICHITA</p> <p>CITY ENGINEER'S OFFICE CITY HALL - SEVENTH FLOOR ONE SOUTH WASHINGTON STREET WICHITA, KANSAS 67202 (316) 264-3112 FAX</p>	<p>STANDARD TYPE 'P' MANHOLES</p>	
	<p>M. E. LINDEBAK P.E. - CITY ENGINEER</p>	
	<p>PROJECT NUMBER 784-PPS</p>	<p>INDEX CODE G07861</p>
	<p>DATE MAR 98</p>	<p>SHEET 6 OF 9</p>

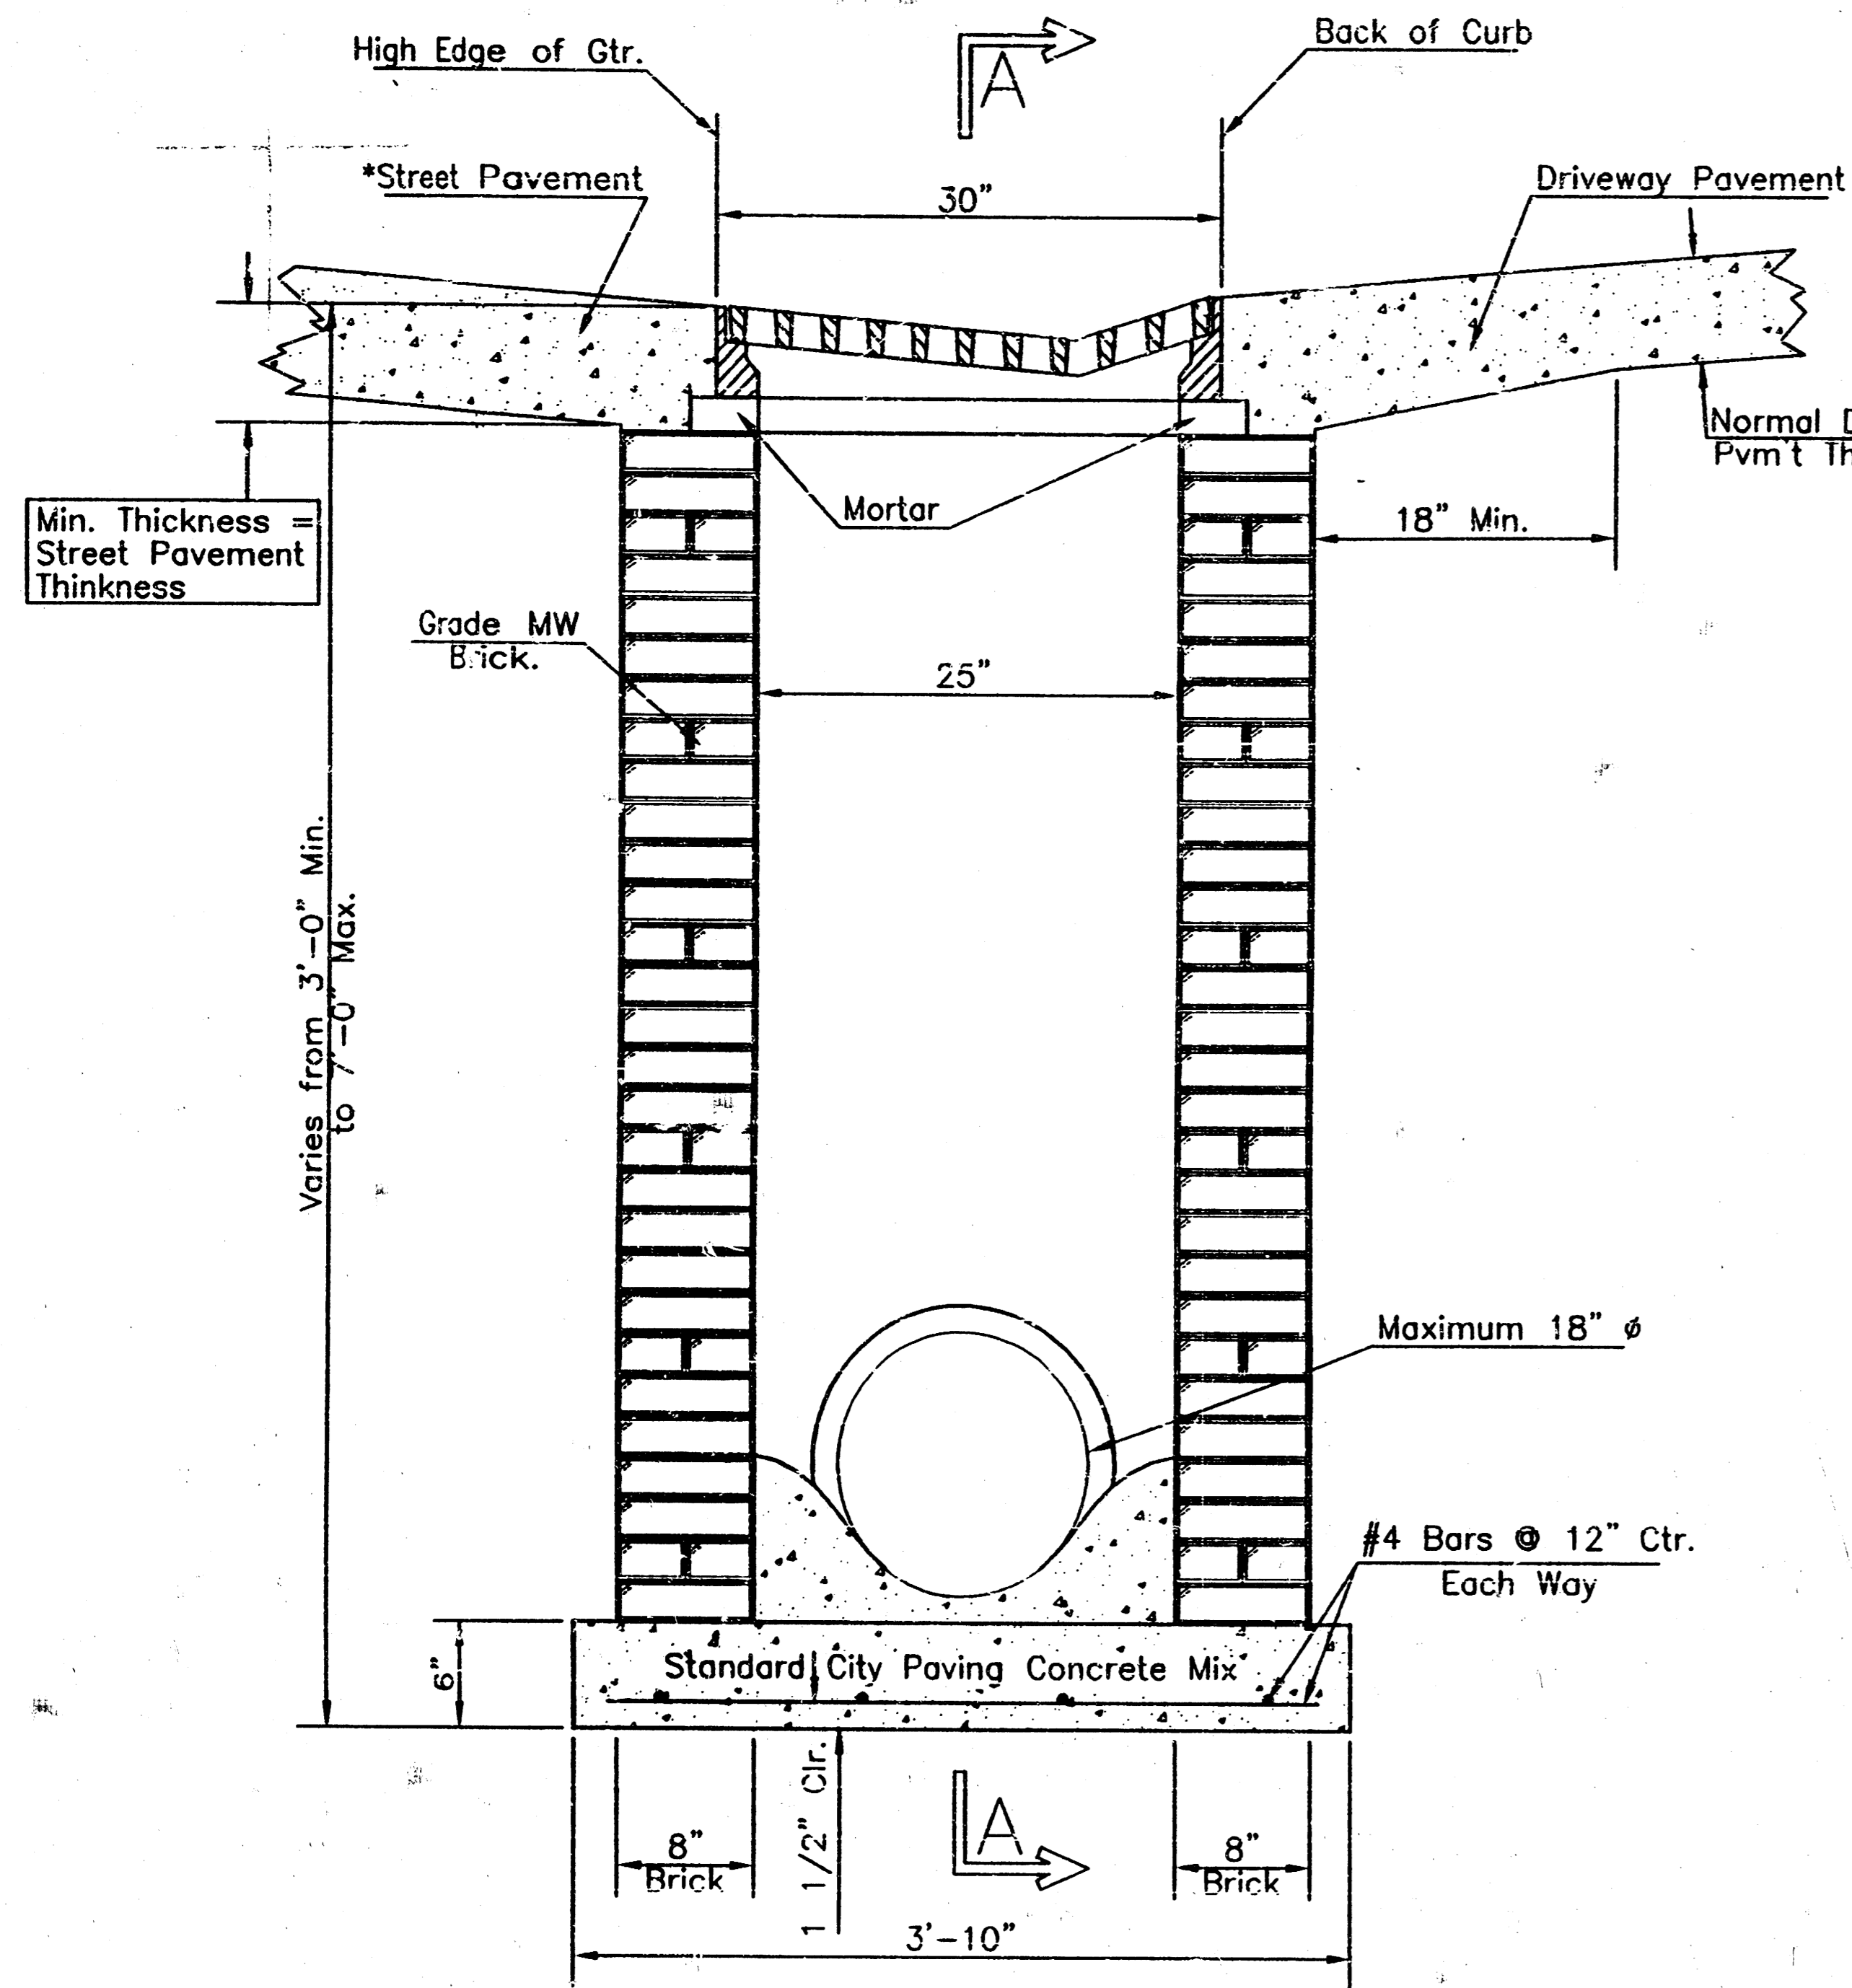


END OUTLET

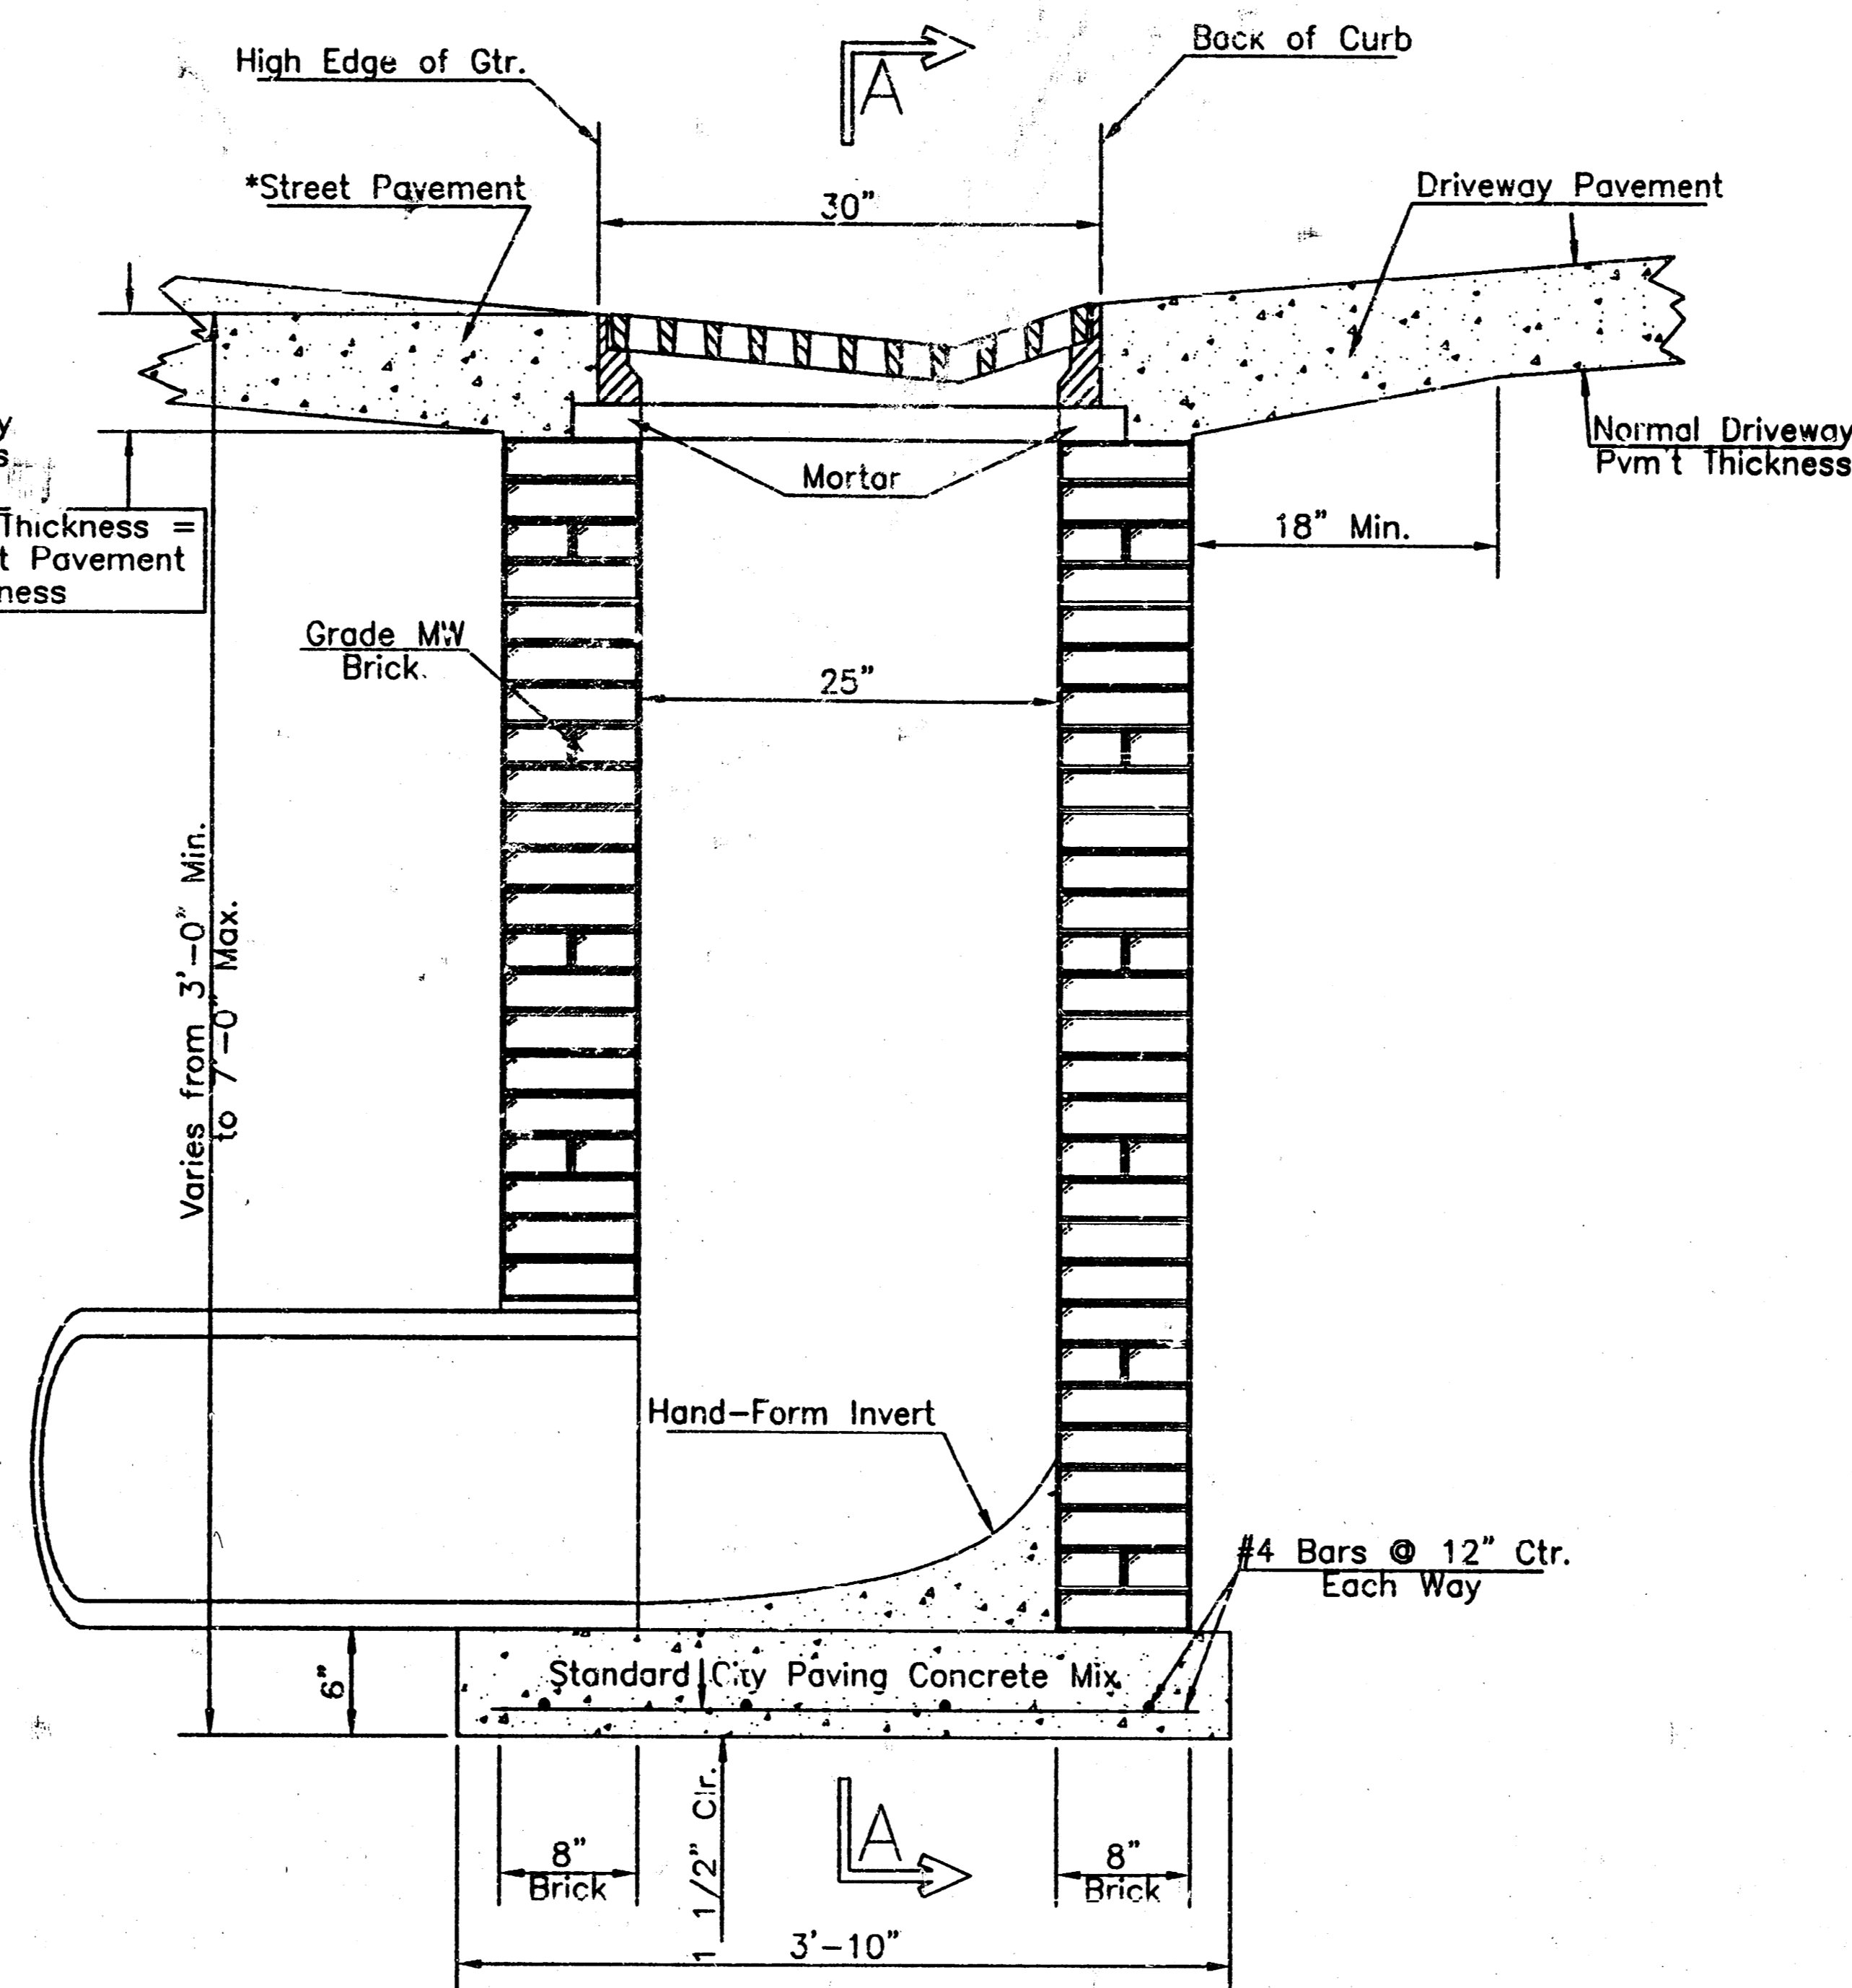

SIDE OUTLET

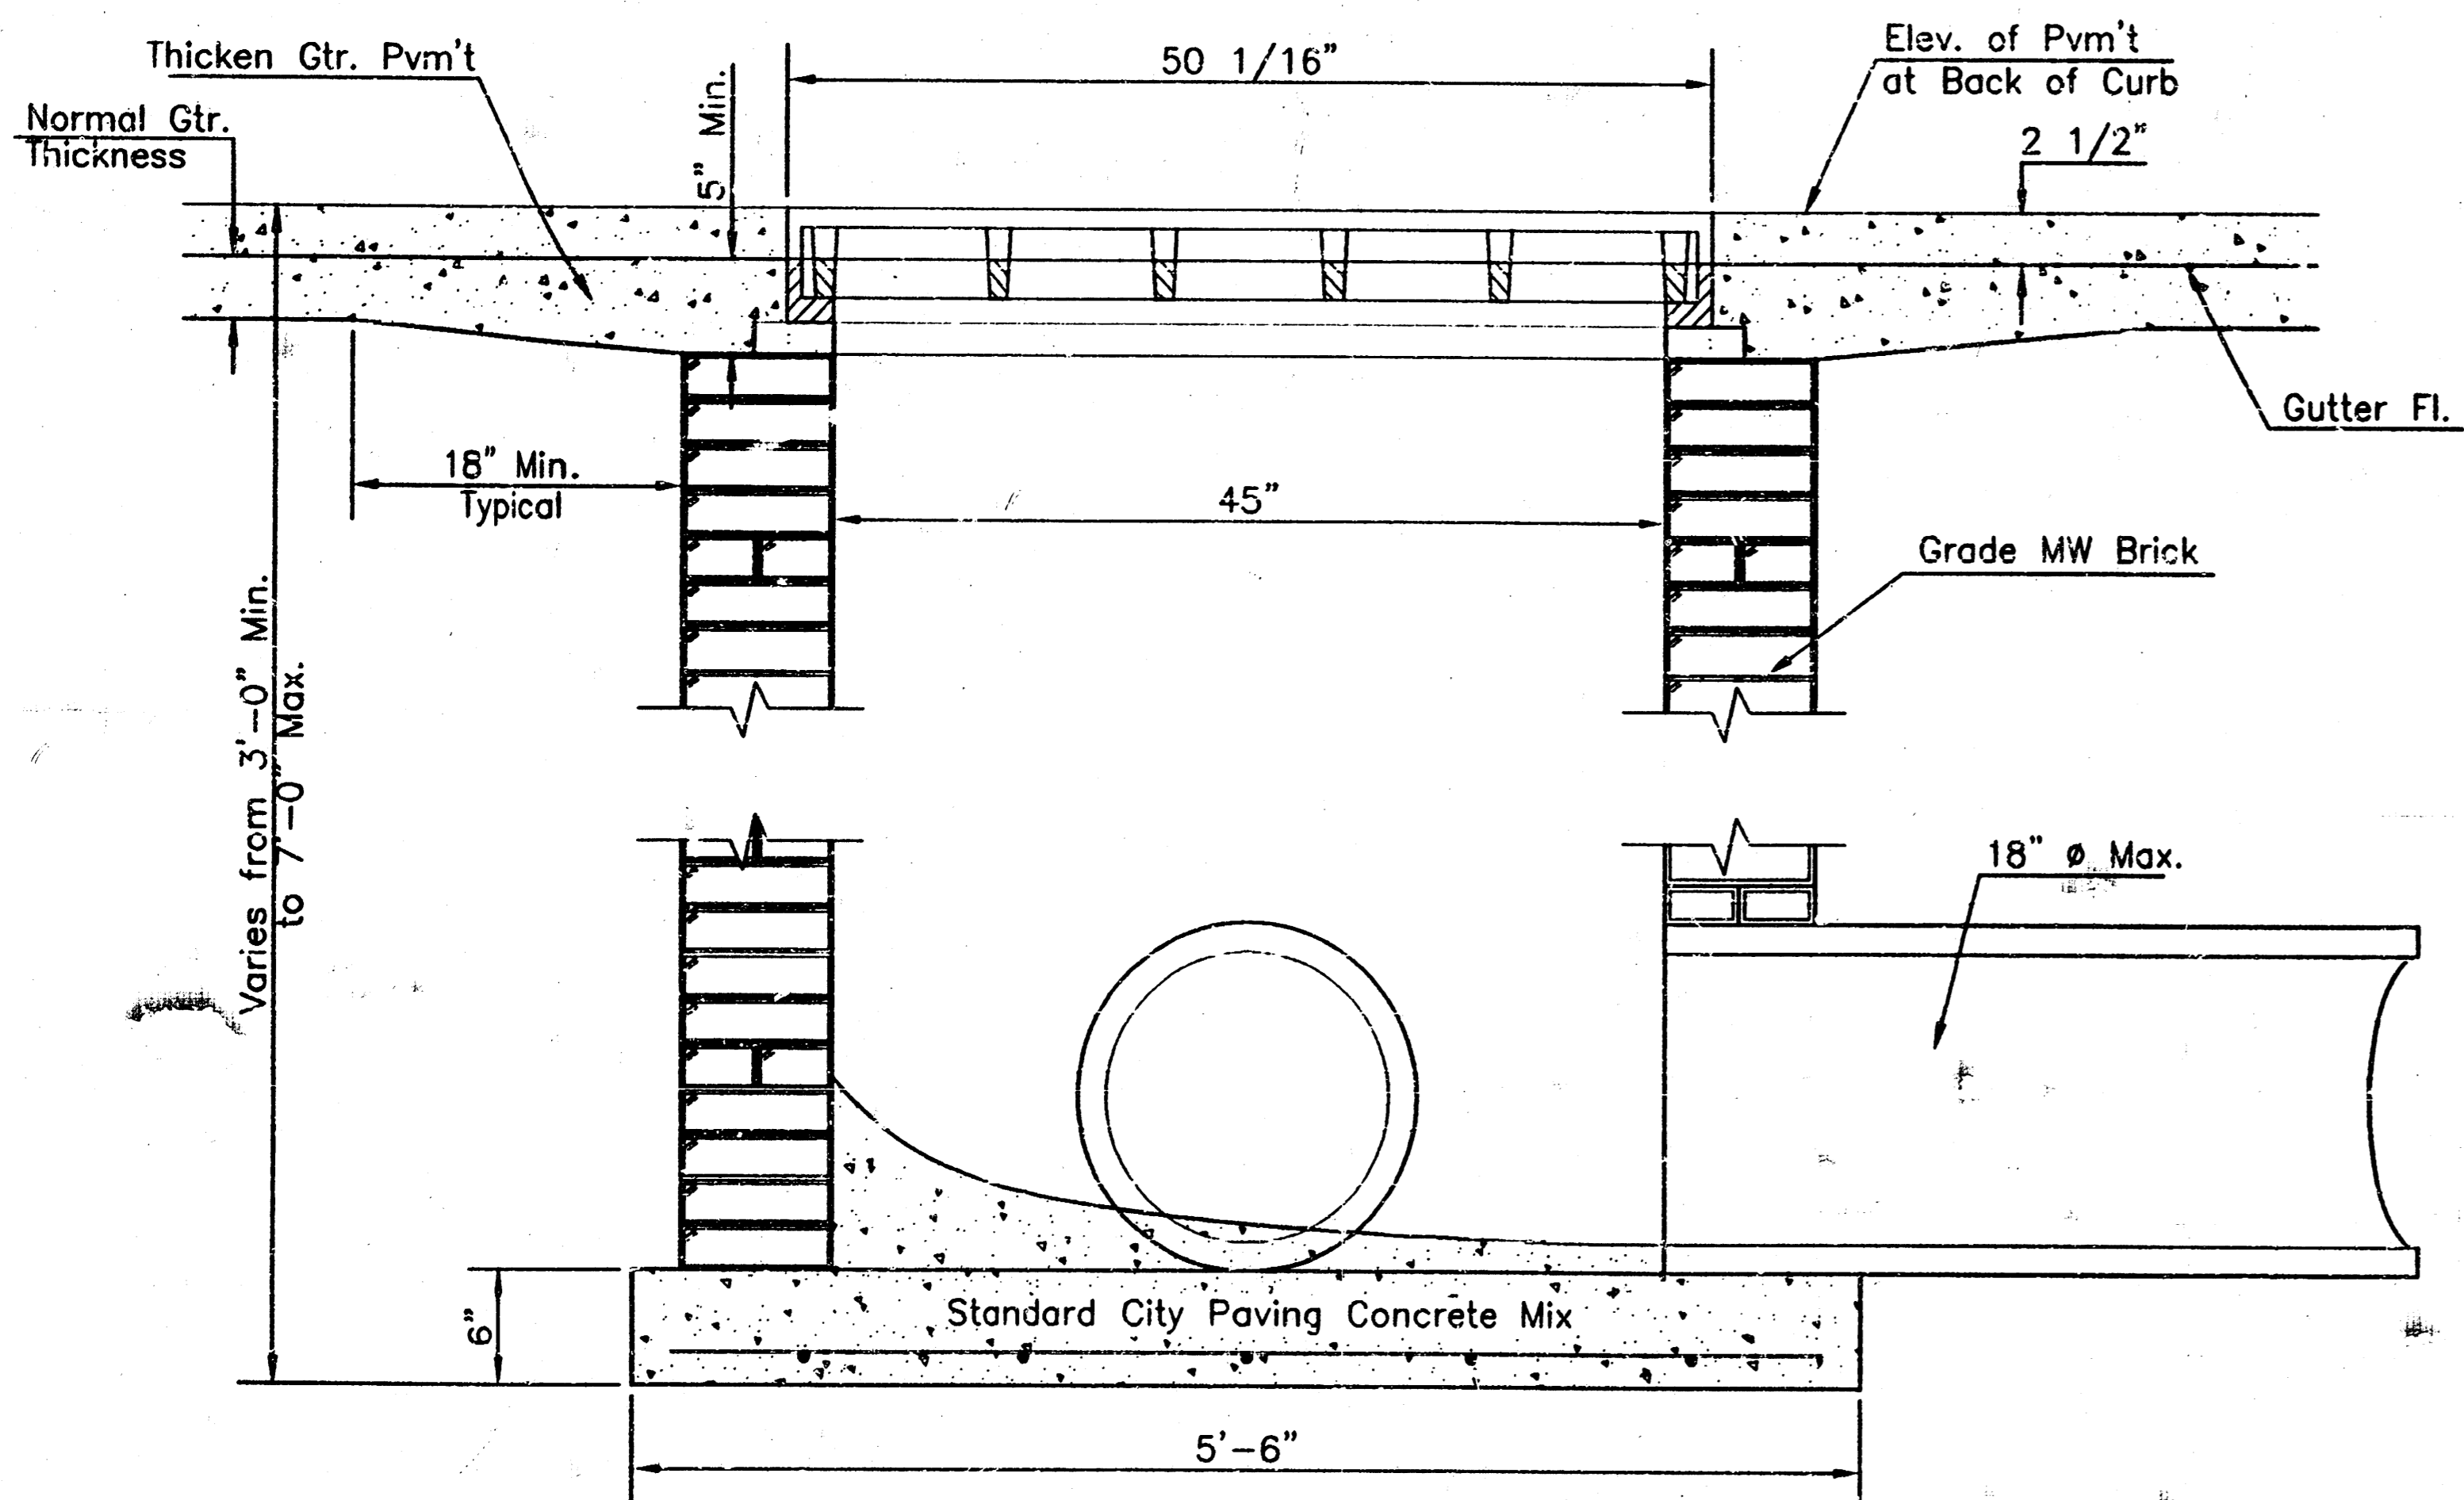

SECTION A-A

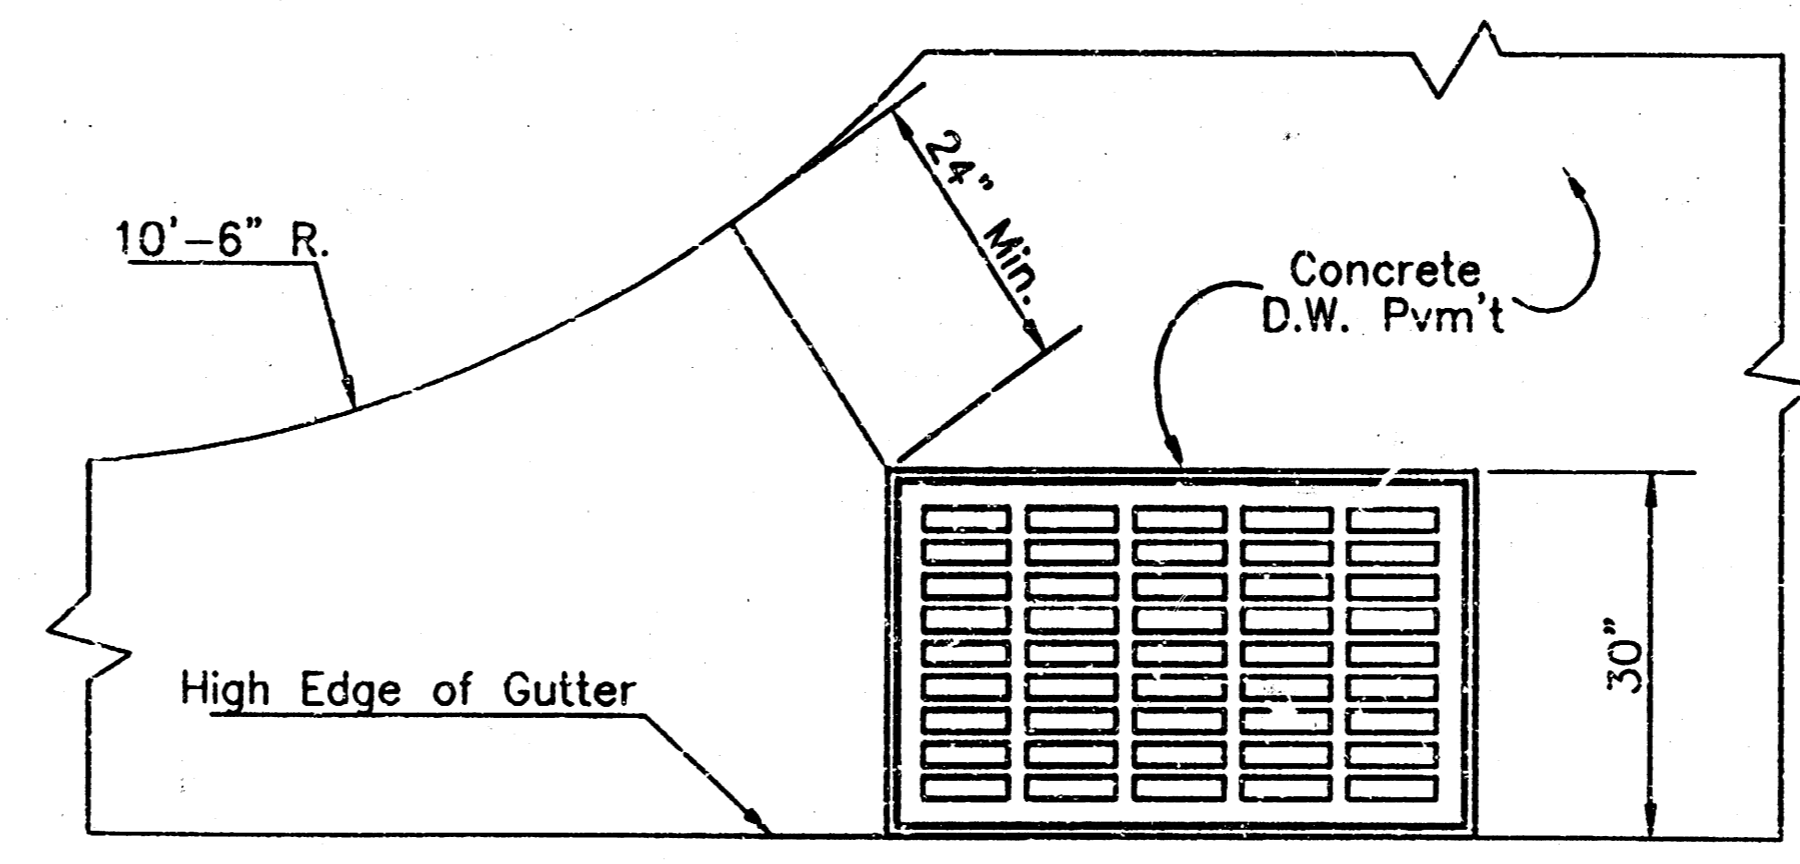


PLAN


Radius Ramp Drive to be Constructed  
On Lot 3, Block 2 per City Standard

GENERAL NOTES


1. Grate frame to be installed on thin mortar cushion to insure full support along brick walls. Concrete used for inlet construction shall be concrete pavement mix.
2. Inlet invert shall be shaped with 8 sack sand mix concrete to create flow channels and to increase hydraulic efficiency such that the inlet will be self cleaning between all inlet and/or outlet pipes.
3. The ends of all pipes installed in inlets shall be cut off flush with the inside face of the inlet wall.
4. Inlet Frame and Grate to be Deeter #2095 of approved equal

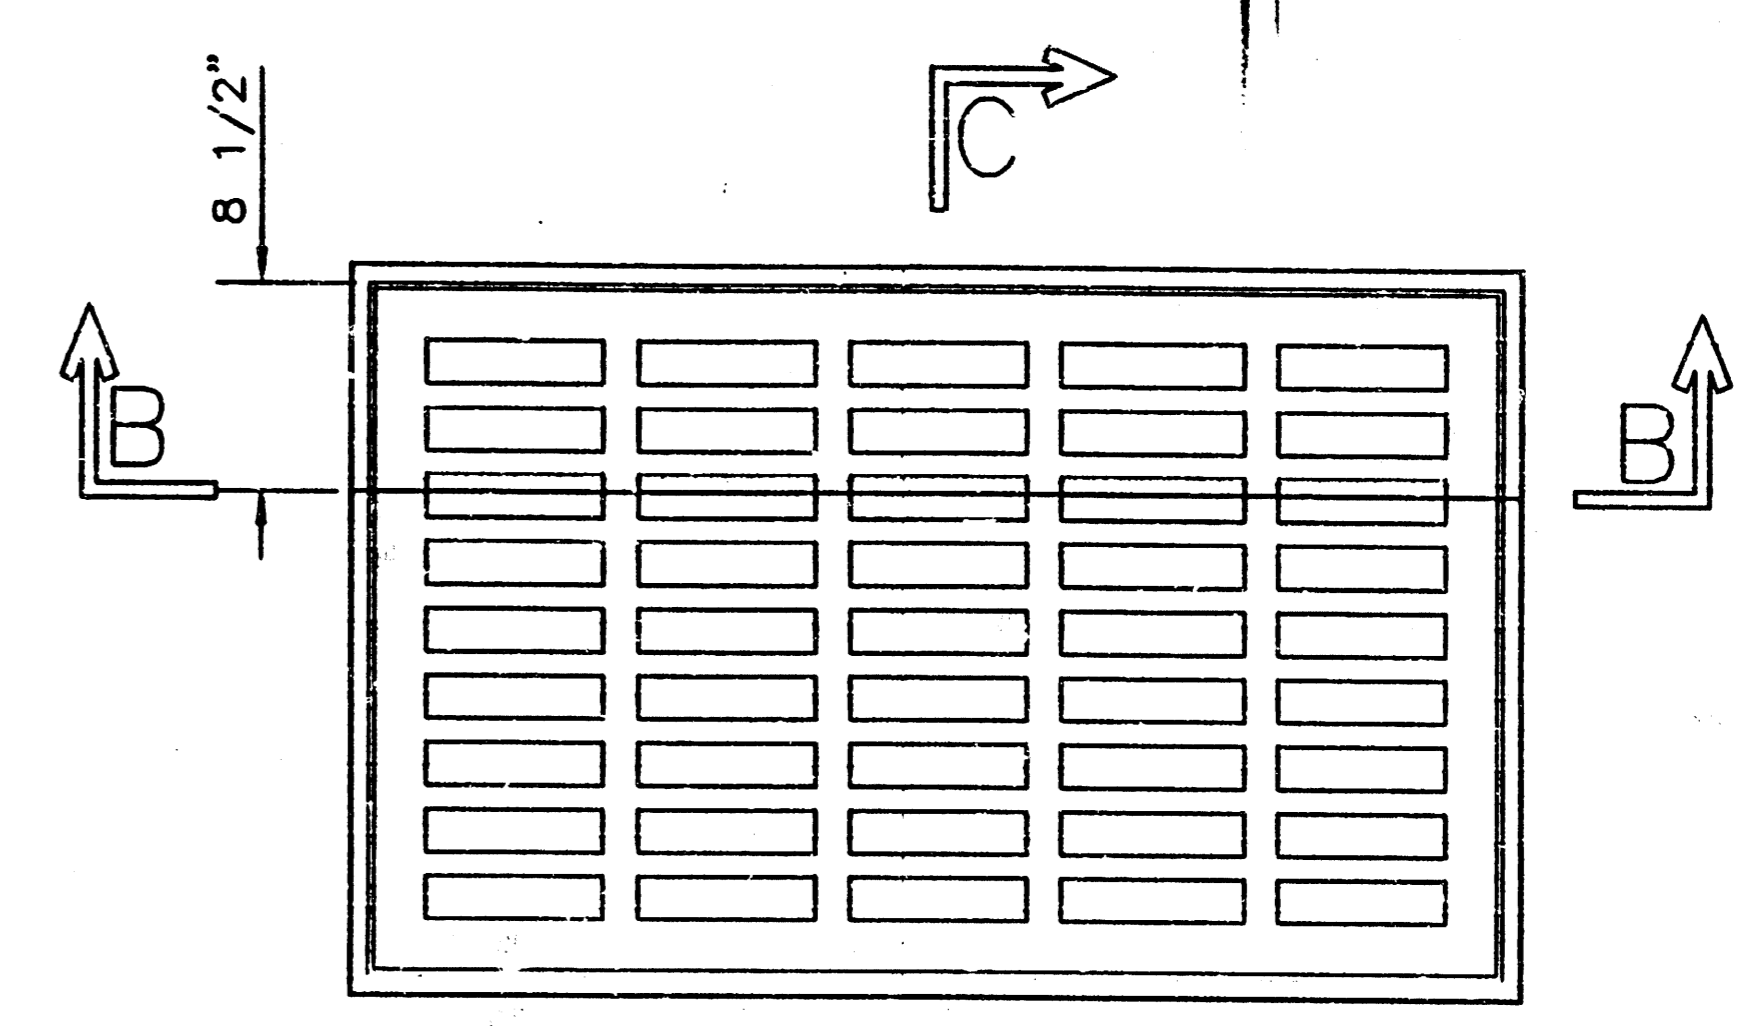

PLAN

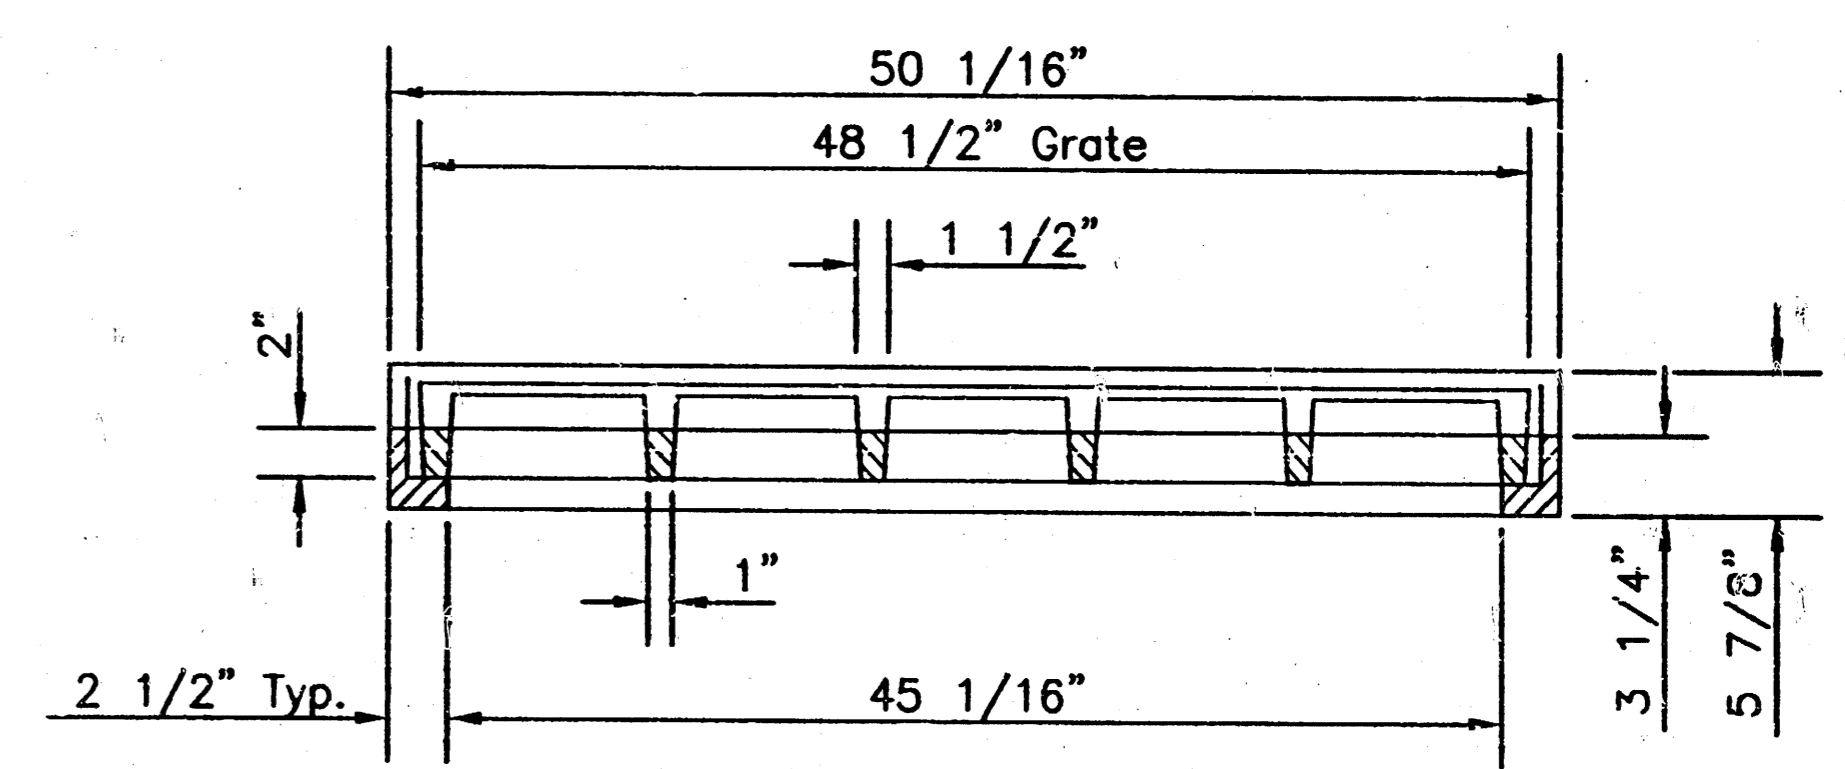


SECTION B-B

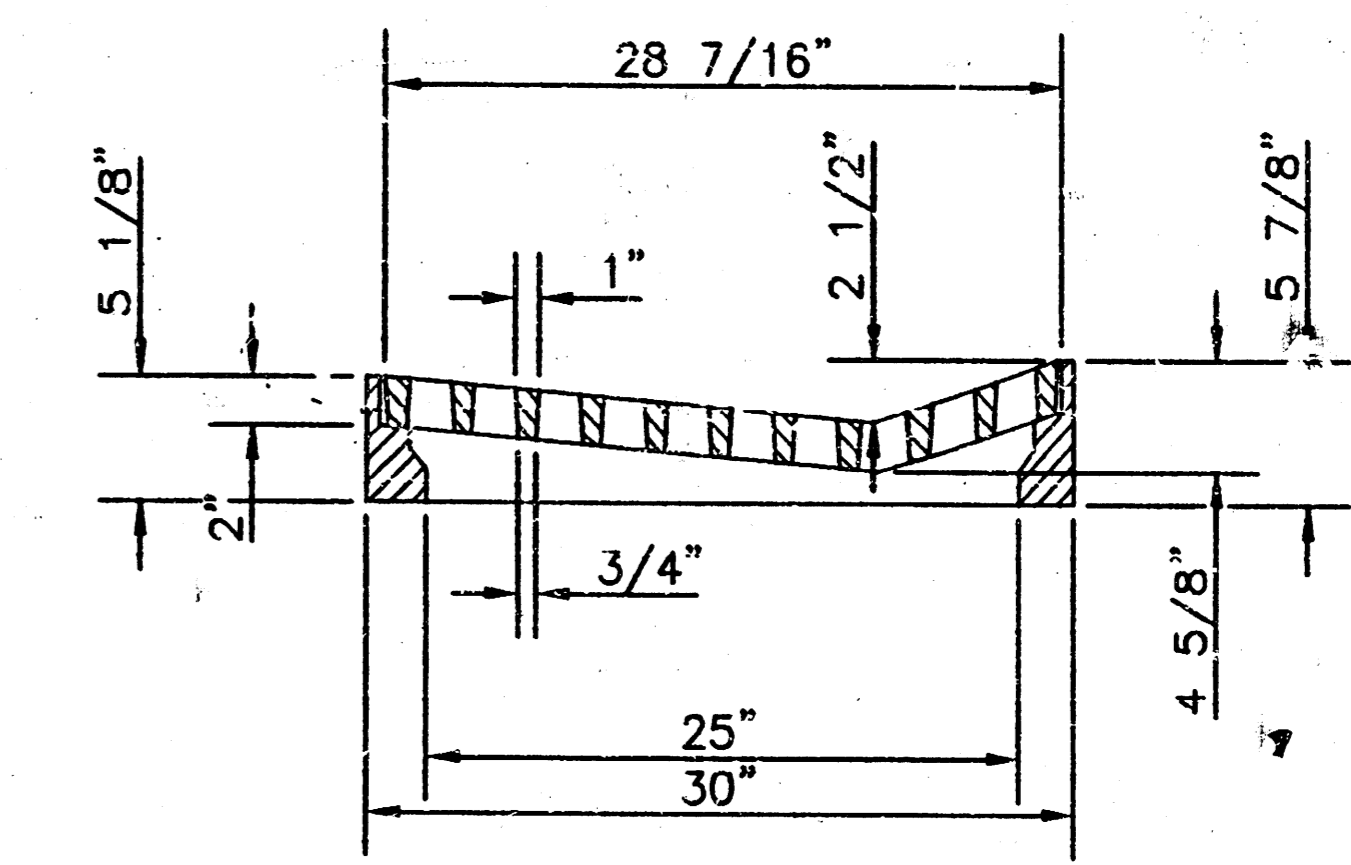

SECTION C-C


DEETER #2095 FRAME & GRATE  
TOTAL WEIGHT: 705 lbs.

<p>THE CITY OF WICHITA CITY ENGINEER'S OFFICE CITY HALL - SEVENTH FLOOR 655 NORTH WASH. STREET WICHITA, KANSAS 67202 (316) 266-4872 (316) 266-4114 FAX</p>	<p>DRIVEWAY GRATED INLET SINGLE</p>	
	<p>M. E. LINDEBAK P.E. - CITY ENGINEER</p>	
	<p>PROJECT NUMBER 784 PPS</p>	<p>INDEX CODE 607861</p>
	<p>DATE MAR 98</p>	<p>SHEET 7 OF 9</p>

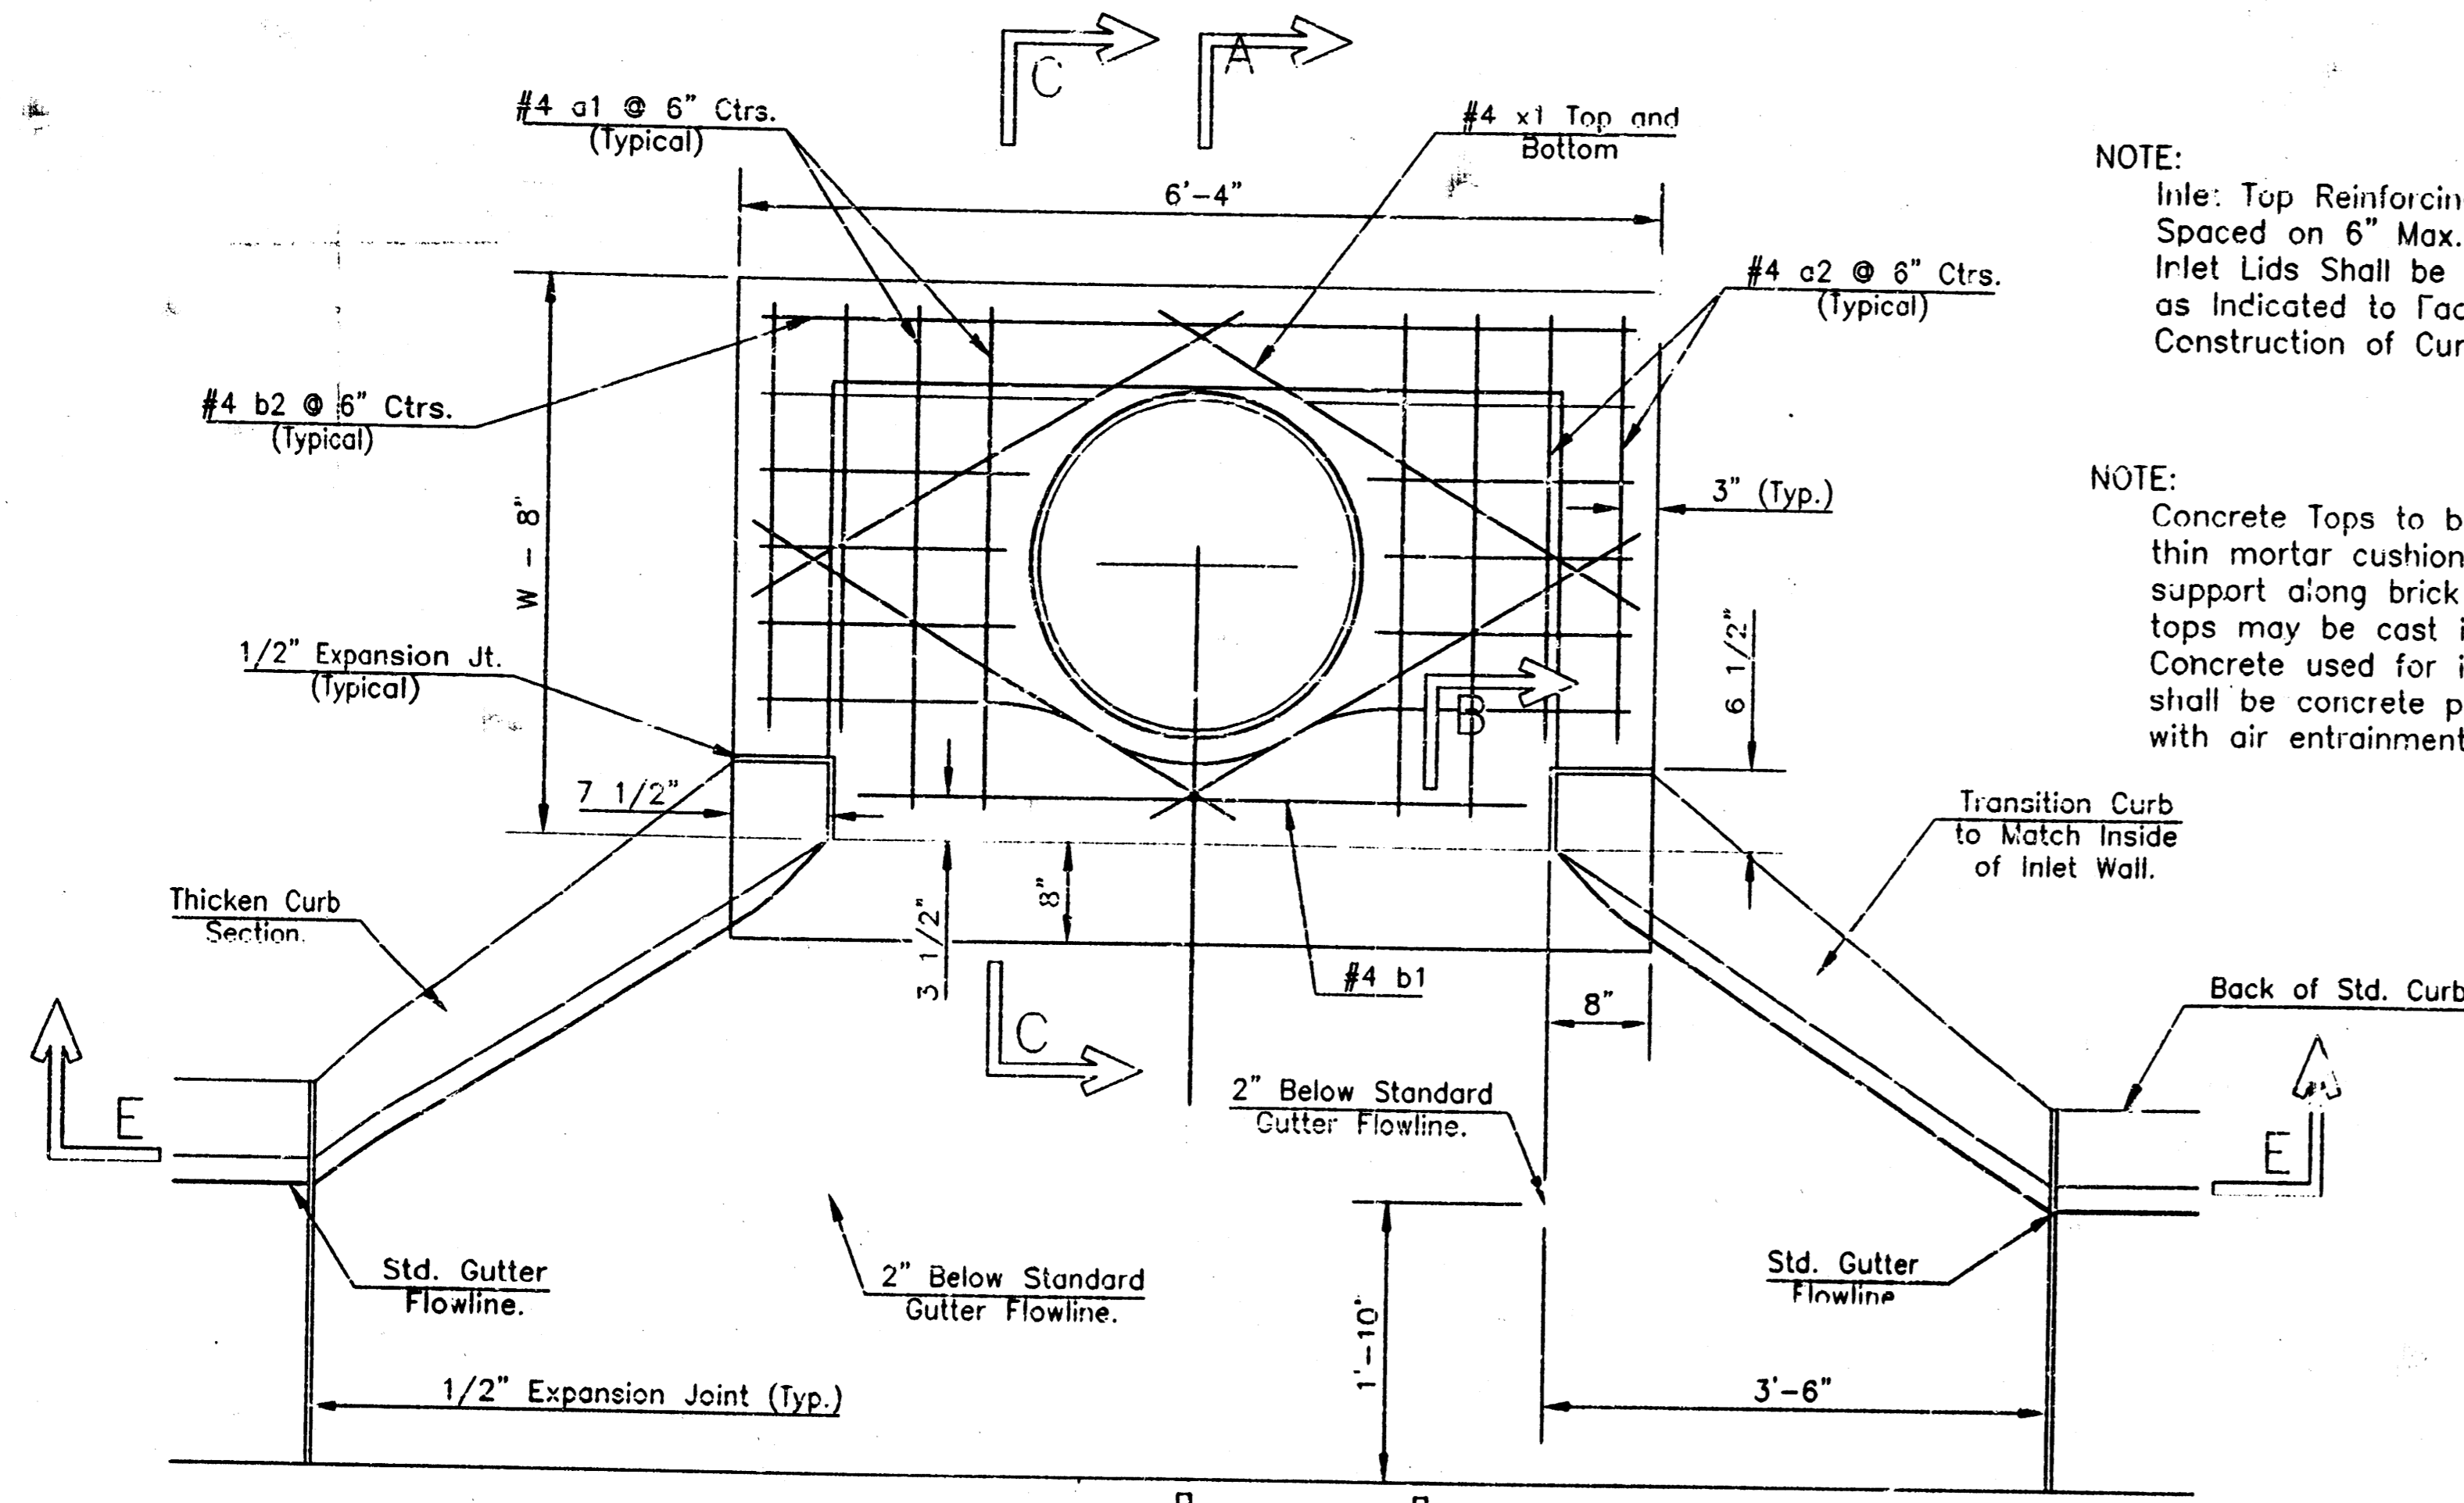


NOTE: Expansion Joint Only in Curb Area With Concrete Pavment.

PLAN

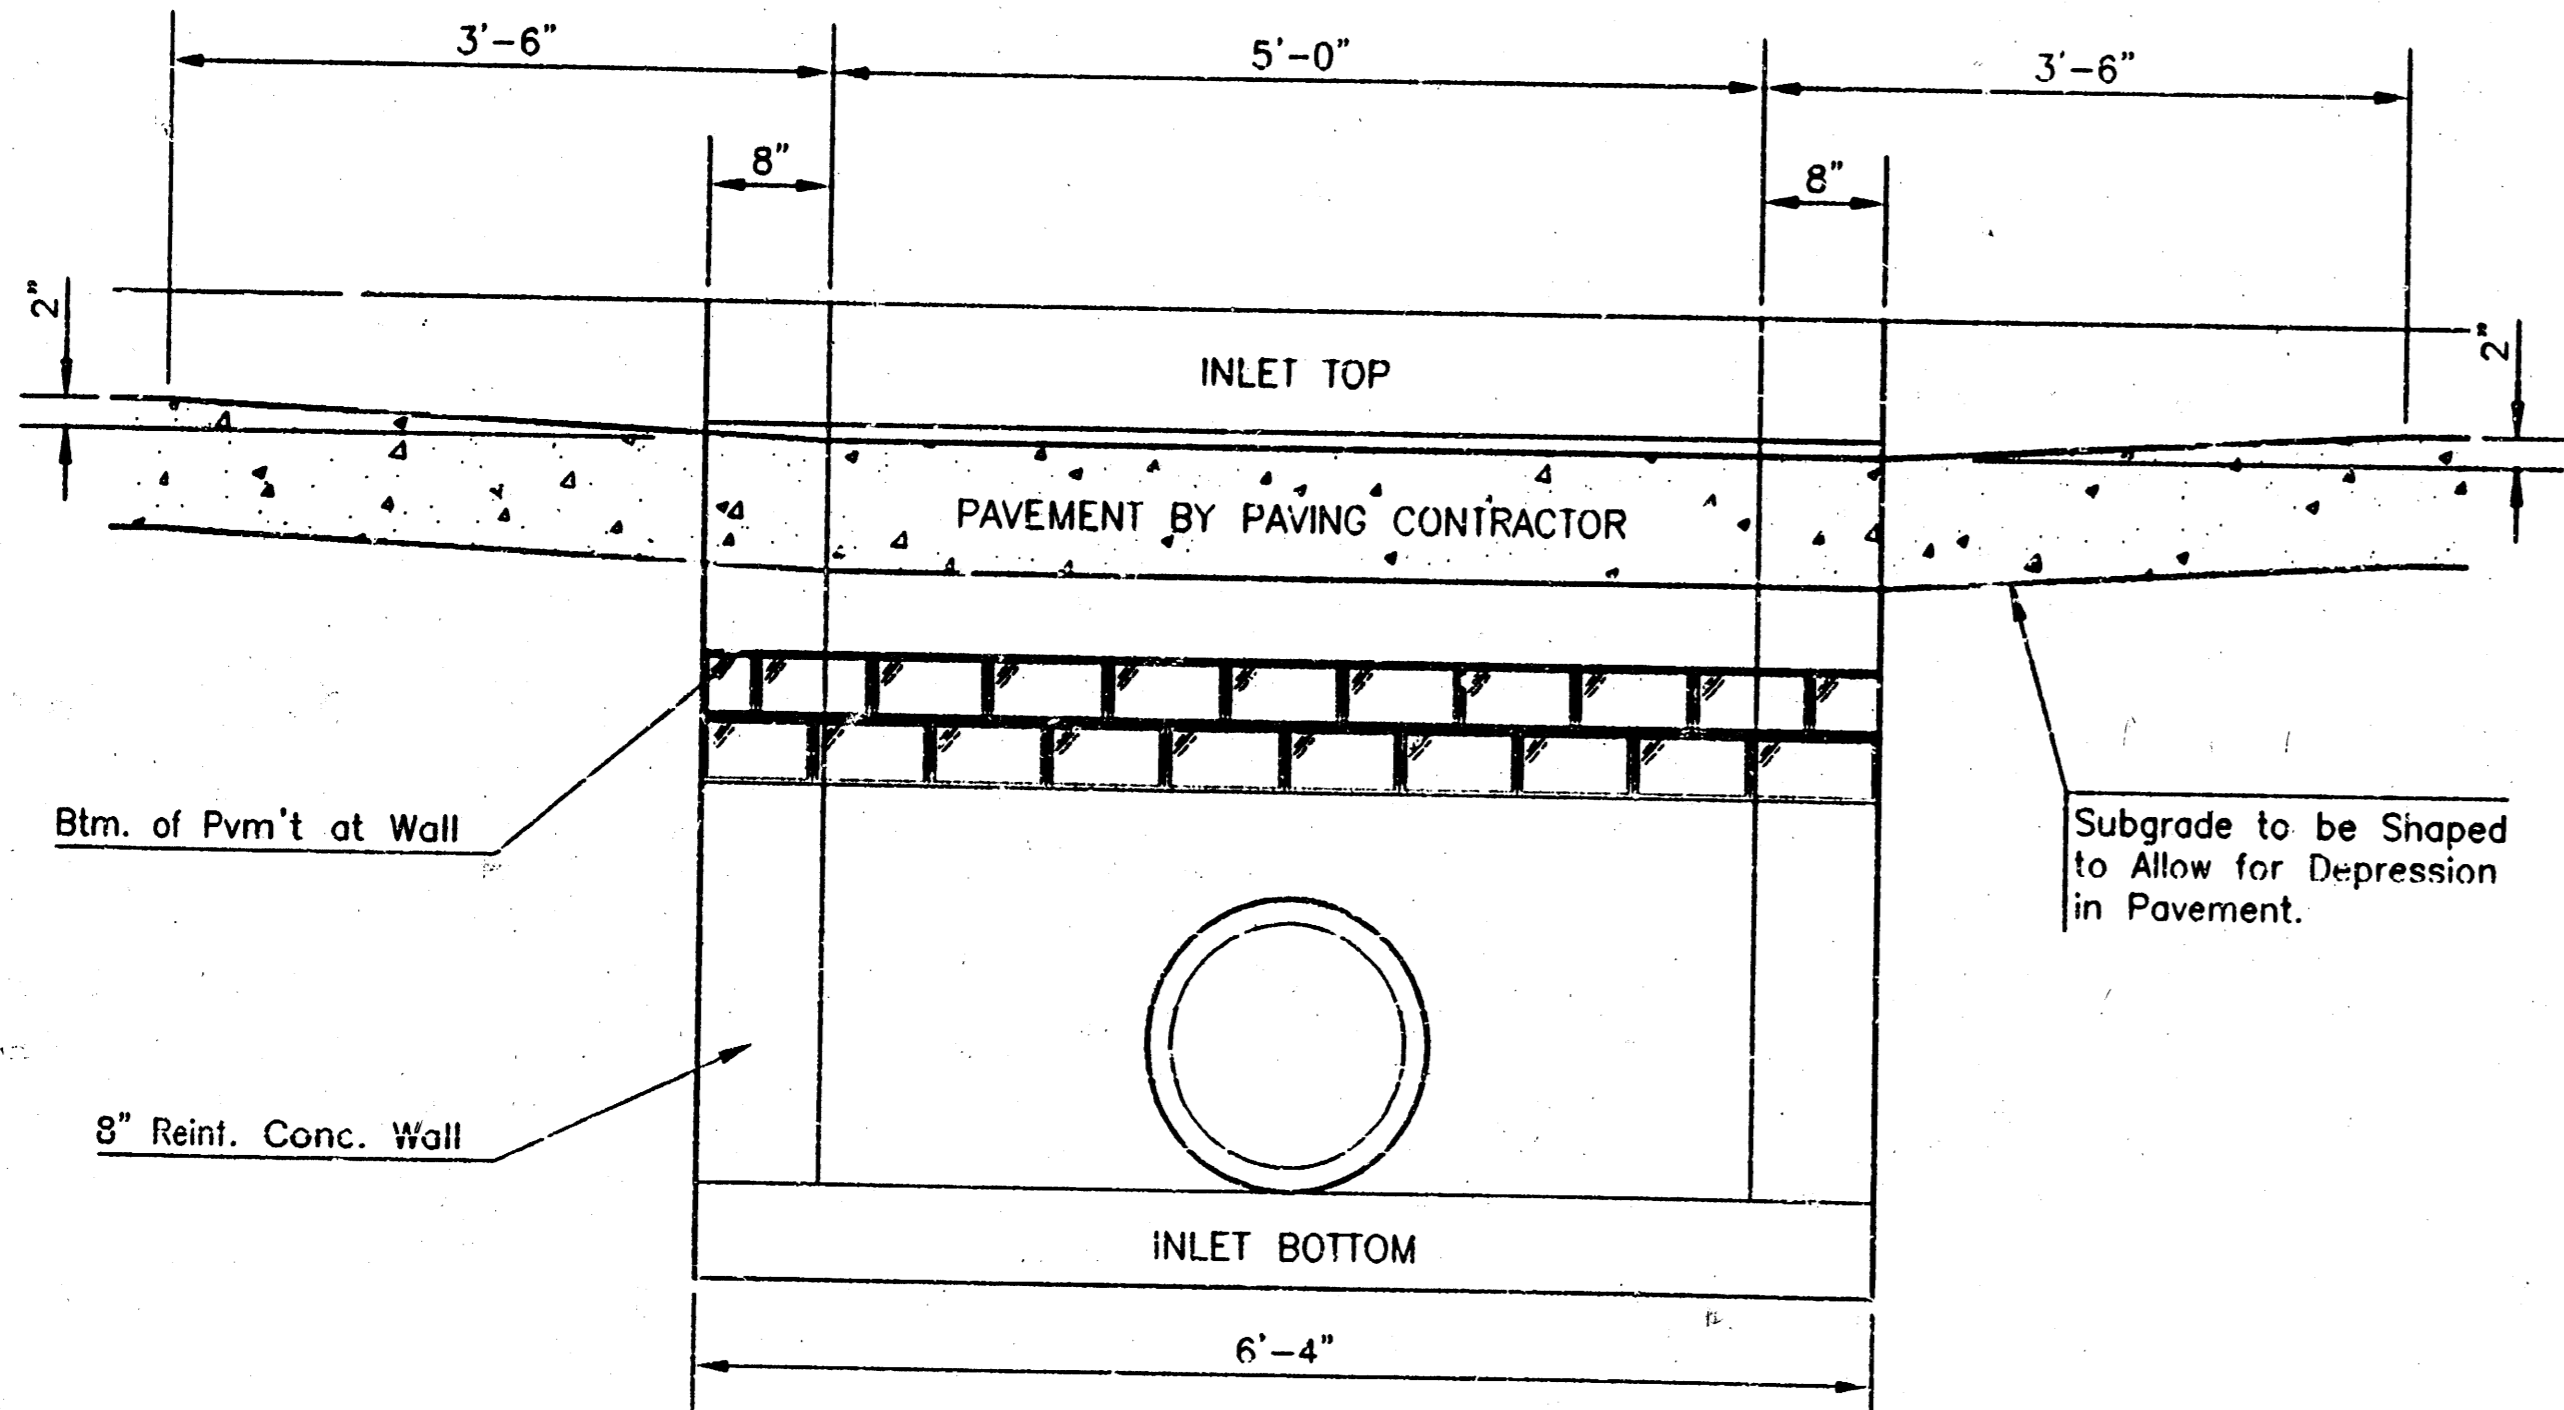

SECTION E-E

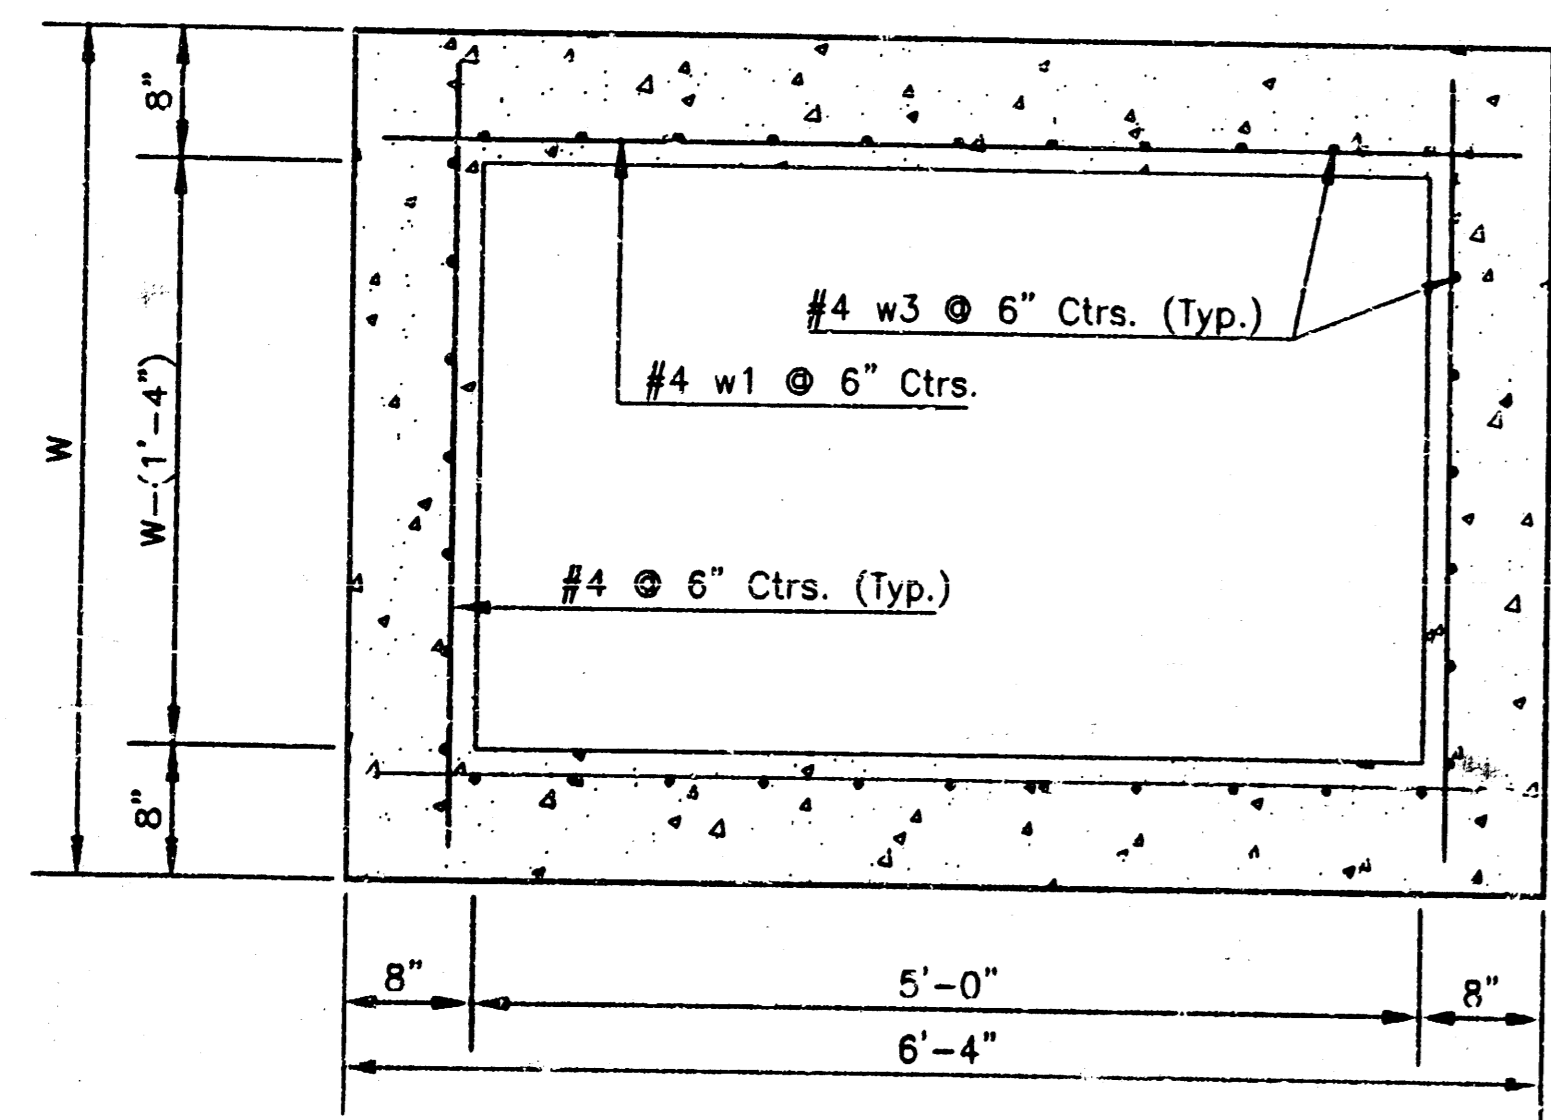

SECTION D-D

NOTE: Contractor shall have the option of constructing 8\"/>


Additional curb and gutter construction necessary to connect set-back inlet to pavement will be paid for at the unit price bid for each inlet hookup.

Inlet invert shall be shaped with 8 sack sand mix concrete to create flow channels and to increase hydraulic efficiency such that the inlet will be self-cleaning between all inlet and/or outlet pipes.

The ends of all pipes installed in inlets shall be cut off flush with the inside face of the inlet wall


NOTE: Inlet: Top Reinforcing shall be Spaced on 6\"/>

NOTE: Concrete Tops to be installed on thin mortar cushion to insure full support along brick walls. Concrete tops may be cast in place or precast. Concrete used for inlet construction shall be concrete pavement mix with air entrainment.

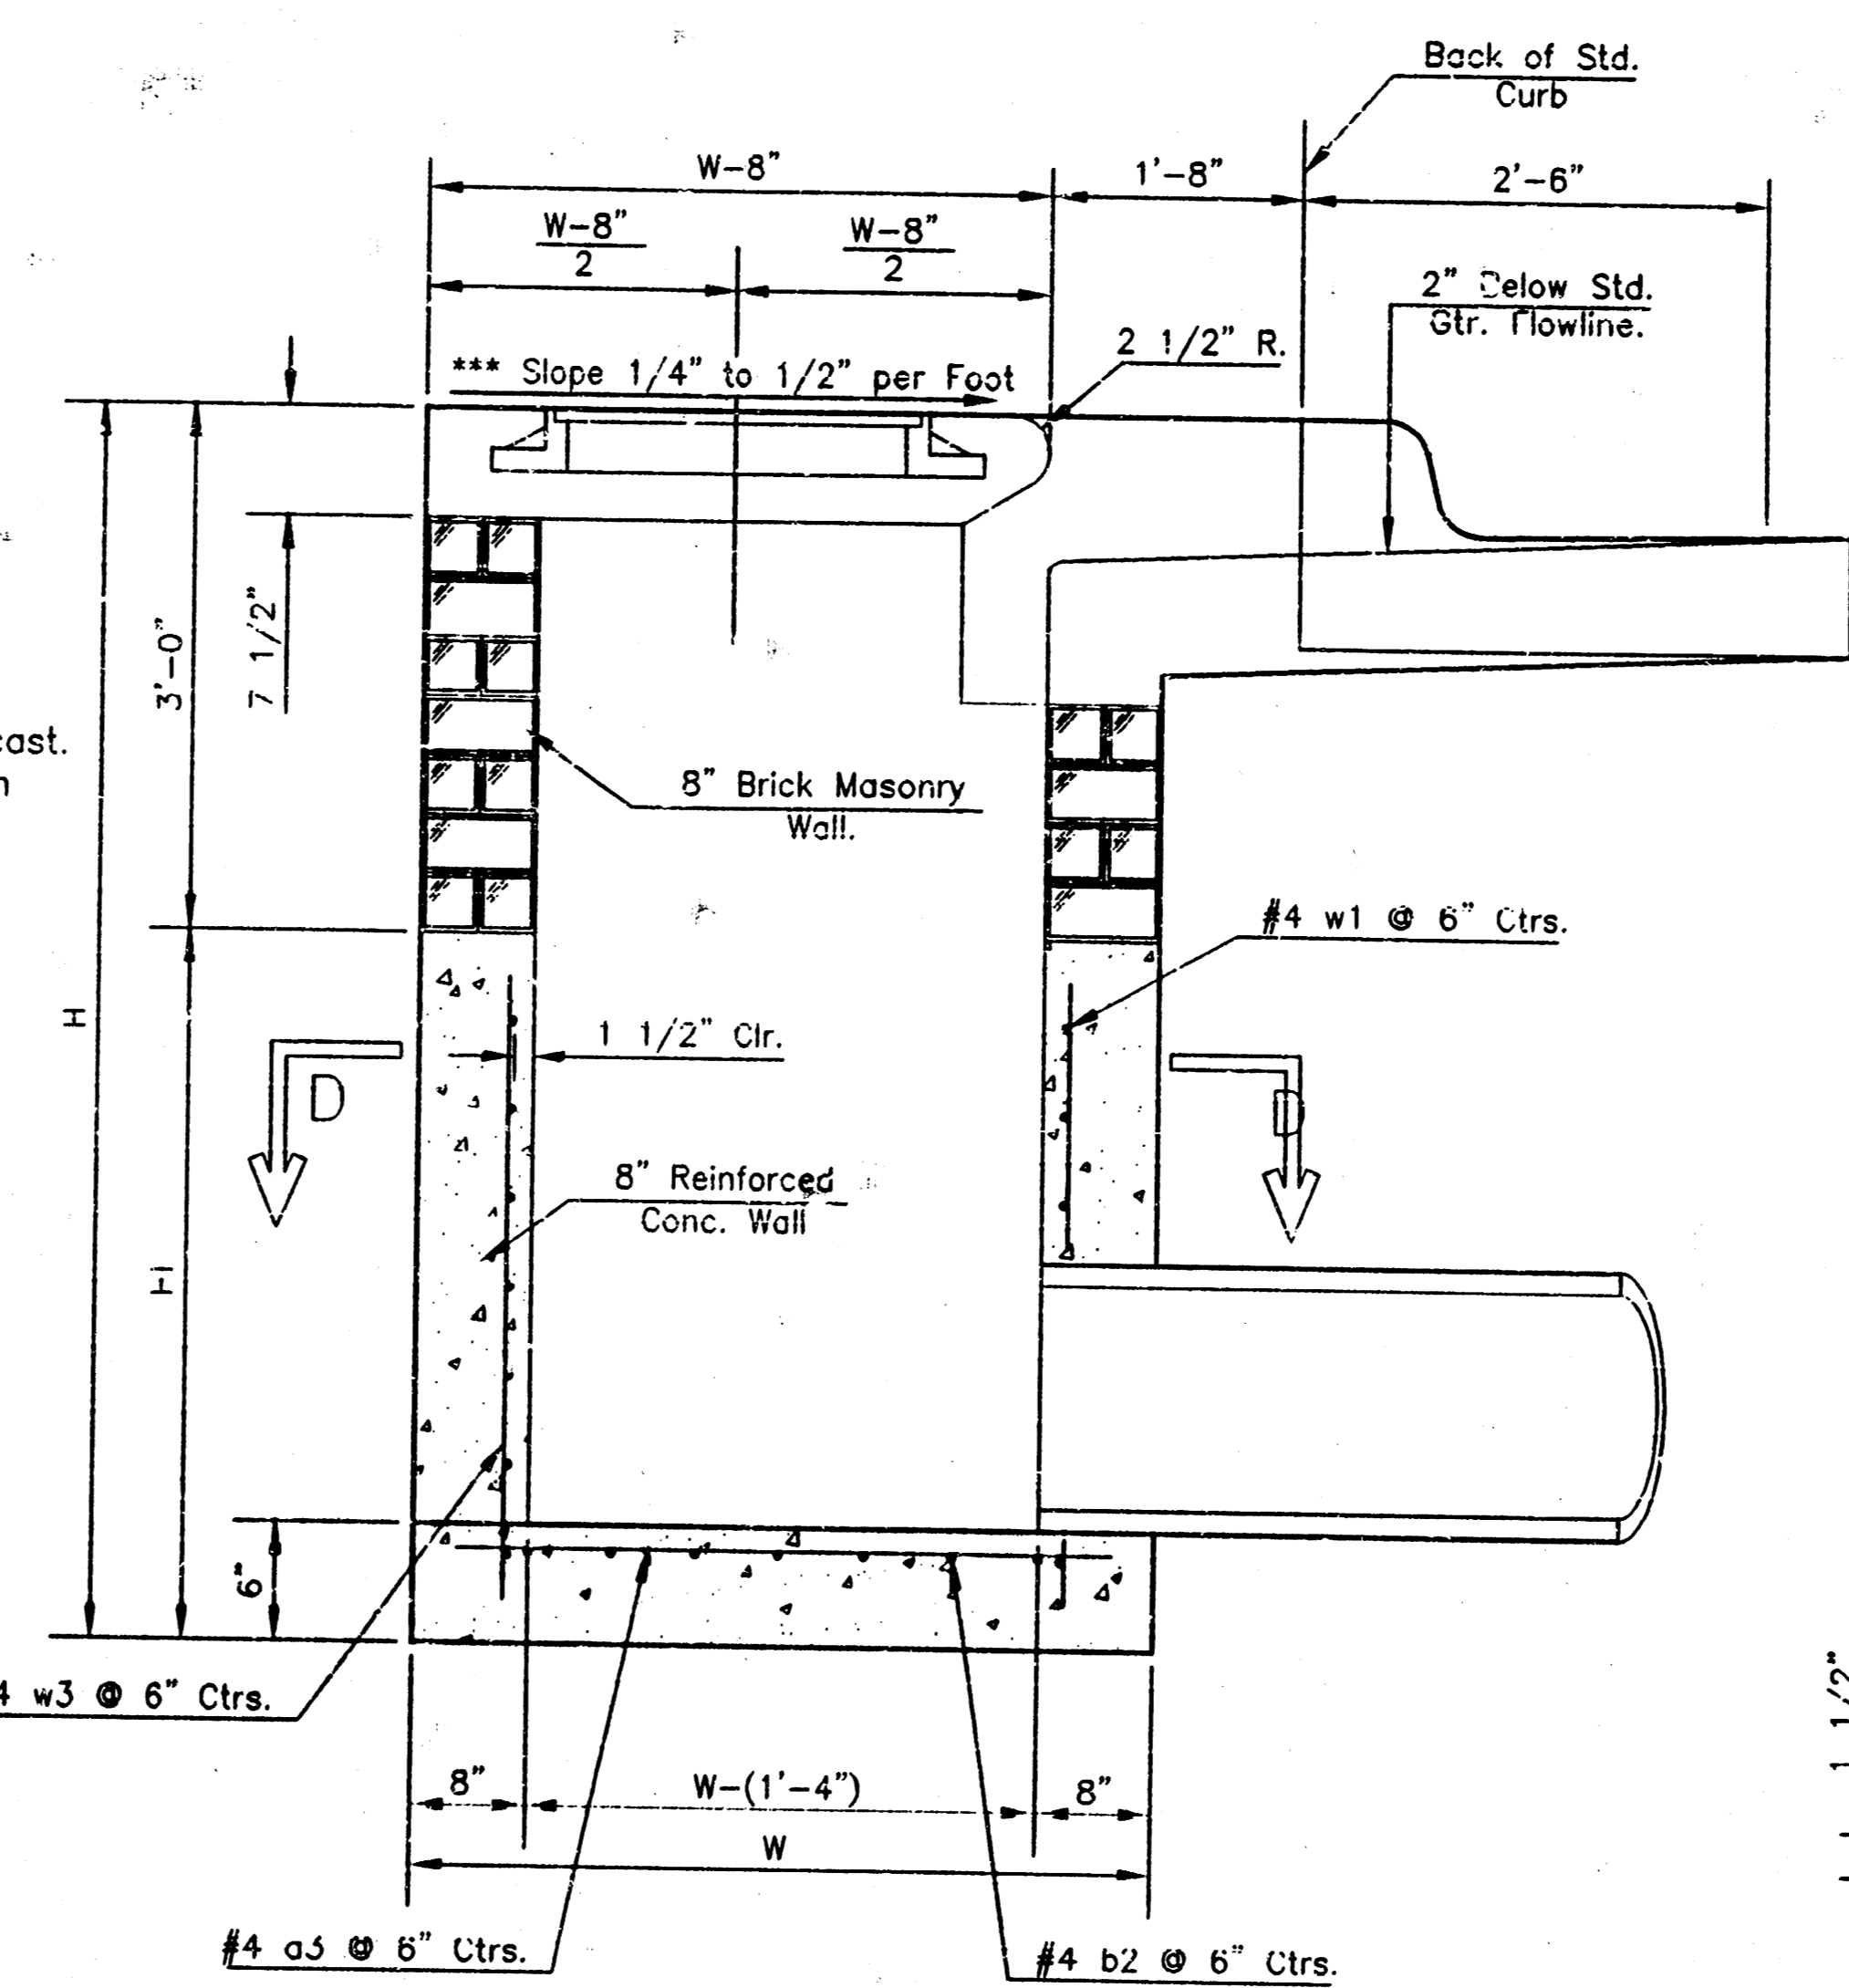


SECTION A-A

\*\*\*NOTE: Slope of Inlet tops to Match Sidewalk or Parking Slopes within Limits Indicated.

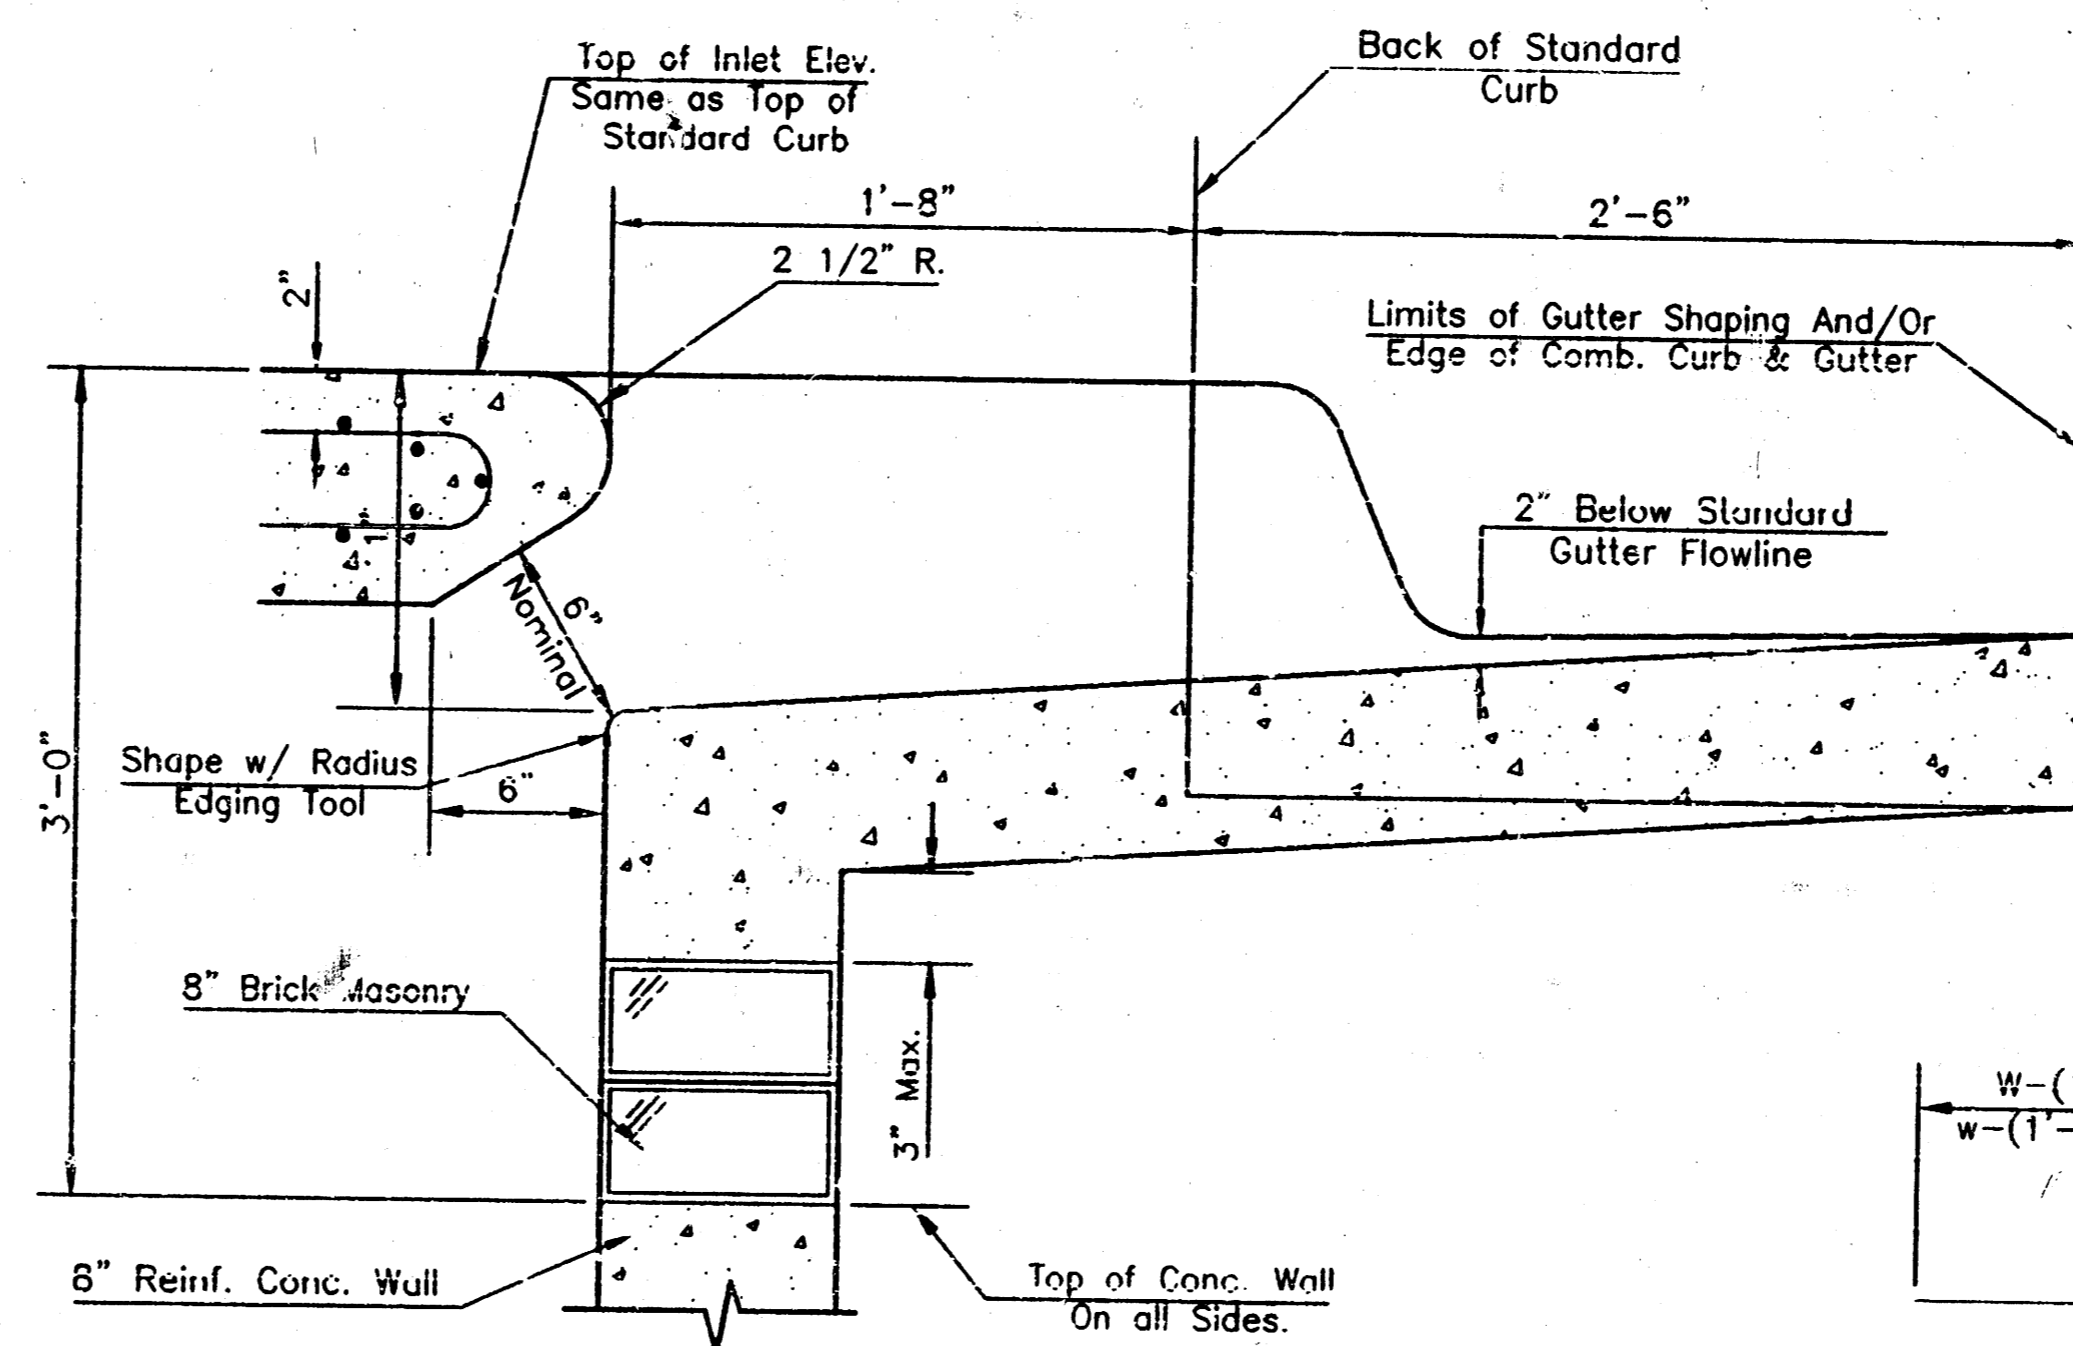

SECTION B-B

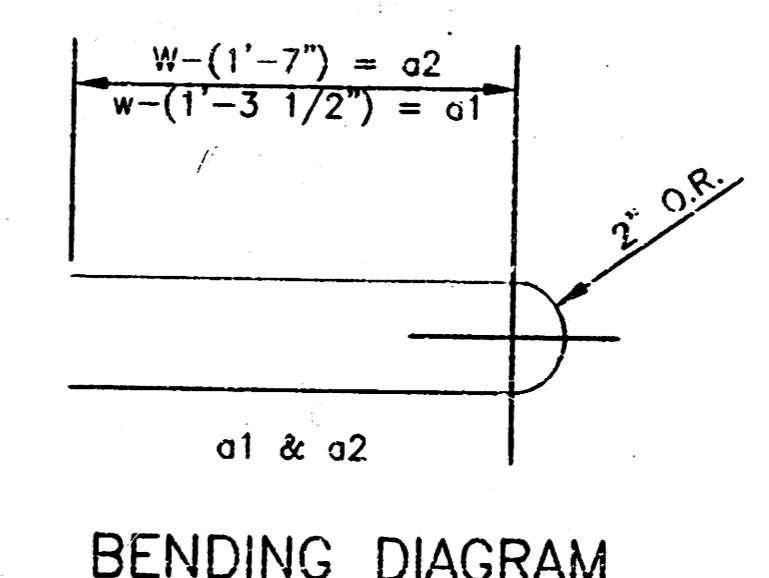


BENDING DIAGRAM

PRECAST SLAB AND FLOOR REINFORCING											
MARK	SIZE	W = 4'-4"		W = 5'-4"		W = 6'-4"		W = 7'-4"		W = 8'-4"	
		NO.	LENGTH	NO.	LENGTH	NO.	LENGTH	NO.	LENGTH	NO.	LENGTH
* a1	#4	6	8'-7"	6	8'-7"	6	10'-7"	6	12'-7"	6	14'-7"
a2	#4	4	6'-0"	4	8'-0"	4	10'-0"	4	12'-0"	4	14'-0"
a3	#4	13	4'-1"	13	5'-1"	13	6'-1"	13	7'-1"	13	8'-1"
b1	#4	1	4'-9"	1	4'-9"	1	4'-9"	1	4'-9"	1	4'-9"
* b2	#4	23	6'-1"	29	6'-1"	35	6'-1"	41	6'-1"	47	6'-1"
x1	#4	8	3'-10"	8	4'-2"	8	4'-6"	8	4'-10"	8	5'-2"


WALL REINFORCING											
MARK	SIZE	W = 4'-4"		W = 5'-4"		W = 6'-4"		W = 7'-4"		W = 8'-4"	
		NO.	LENGTH	NO.	LENGTH	NO.	LENGTH	NO.	LENGTH	NO.	LENGTH
w1	#4	1	6'-1"	1	6'-1"	1	6'-1"	1	6'-1"	1	6'-1"
w2	#4	1	4'-1"	1	5'-1"	1	6'-1"	1	7'-1"	1	8'-1"
w3	#4	32	2	36	2	40	2	44	2	48	2

\* Field Bend or Cut Reinforcing as Required for Clearance.  
 4 (12") (HI 21") Rounded down to nearest 0.5"  
 2HI - 3"

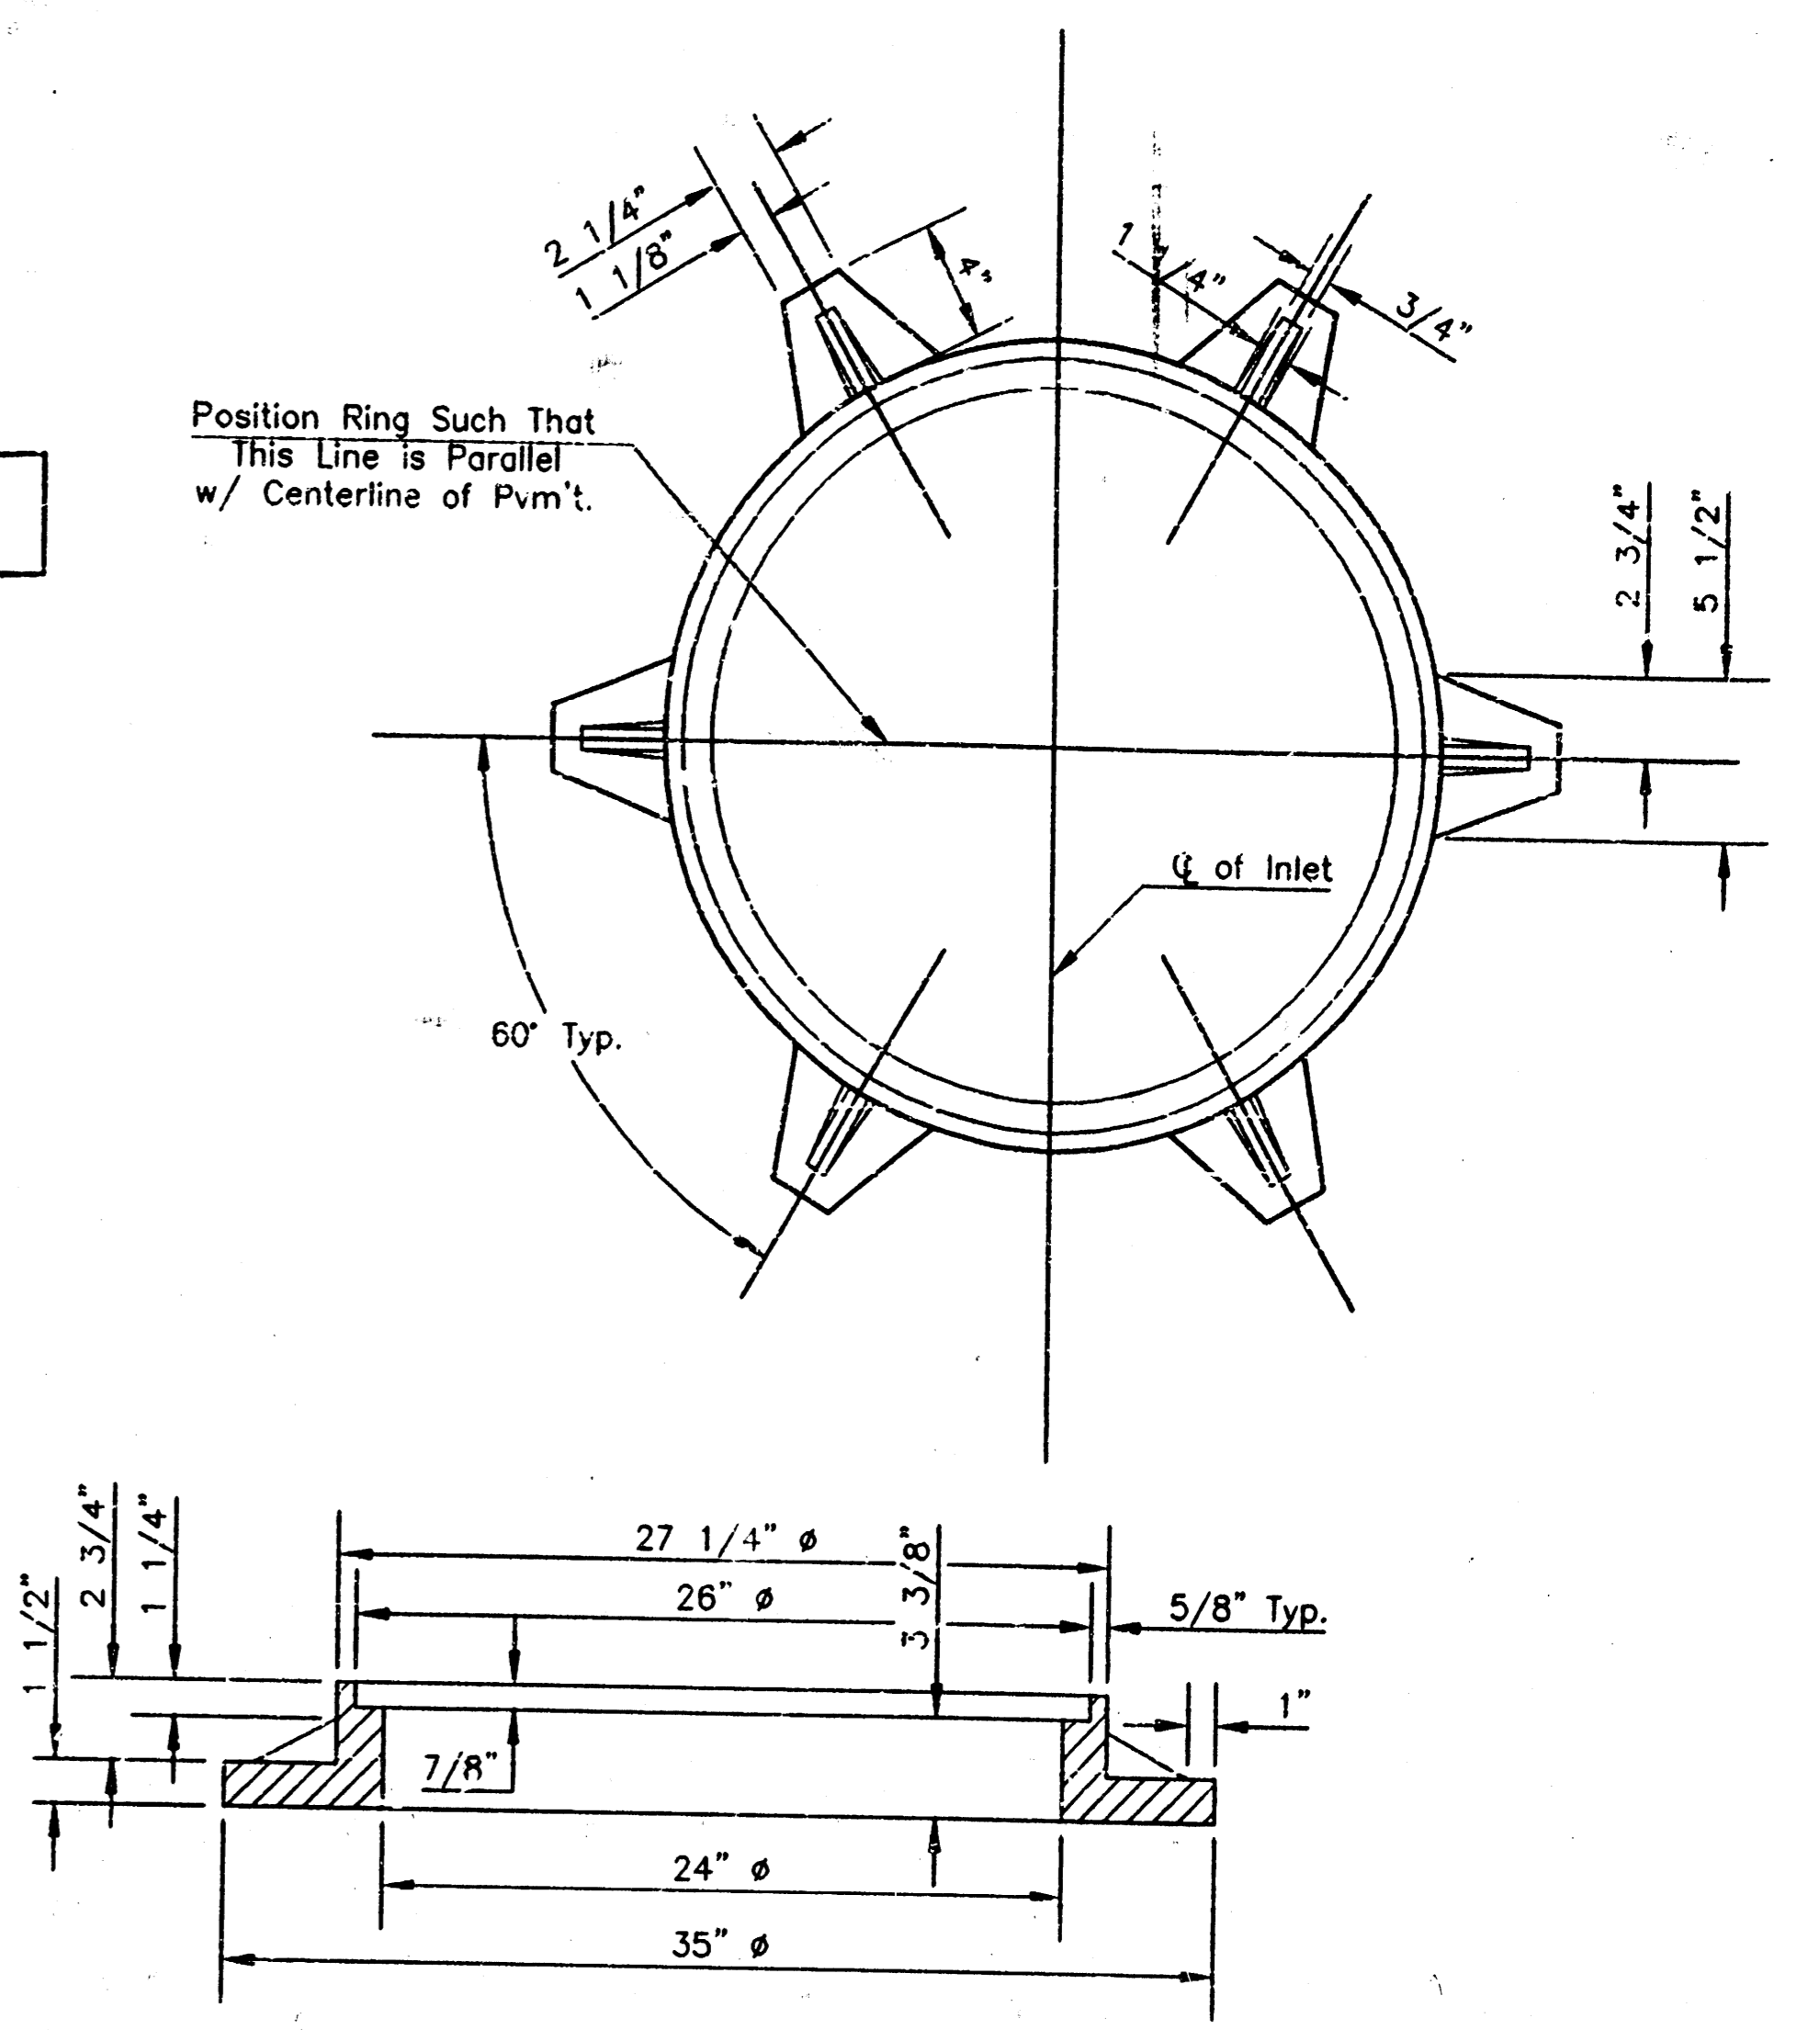

MANHOLE RING AND COVER

Weight = 180 Lbs.  
 \*See City of Wichita Standard Manhole Ring and Cover Detail Sheet for Cover Details to Be Used With Inlet Frame.

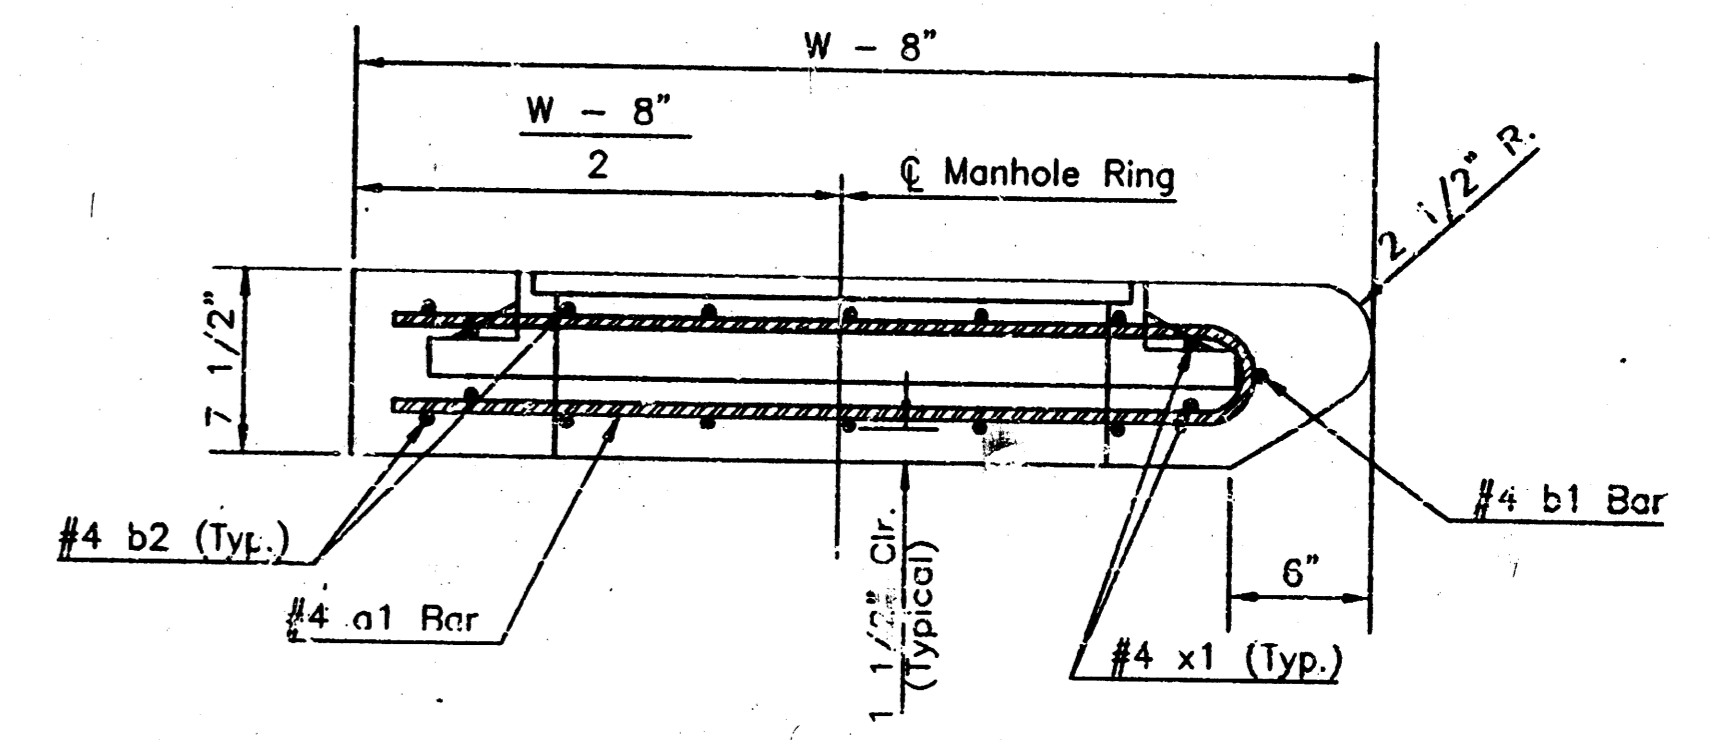

SECTION A-A

STANDARD CURB INLET PRECAST TOPS			
W	PRE-CAST TOP SIZE	PIPE SIZE	CU. YD. CONC.
4'-4"	3'-8" x 6'-4" x 7 1/2" 21" & SMALLER		0.38±
5'-4"	4'-8" x 6'-4" x 7 1/2" 24" & 30"		0.51±
6'-4"	5'-8" x 6'-4" x 7 1/2" 36" & 42"		0.64±
7'-4"	6'-8" x 6'-4" x 7 1/2" 48" & 54"		0.77±
8'-4"	7'-8" x 6'-4" x 7 1/2" 60" & 66"		0.90±

THE CITY OF WICHITA  
 CITY ENGINEER'S OFFICE  
 CITY HALL - SEVENTH FLOOR  
 601 NORTH MAIN STREET  
 WICHITA, KANSAS 67202  
 (316) 266-4112 FAX


**STANDARD TYPE 1-A  
 CURB INLET**  
 OPENING = 6" x 5'-0"

M. E. LINDEBAK P.E. - CITY ENGINEER


PROJECT NUMBER: 784 PPS  
 INDEX CODE: 607861

DATE: MAR 96  
 SHEET 6 OF 9


MANHOLE COVER  
Weight = 180 Lbs.

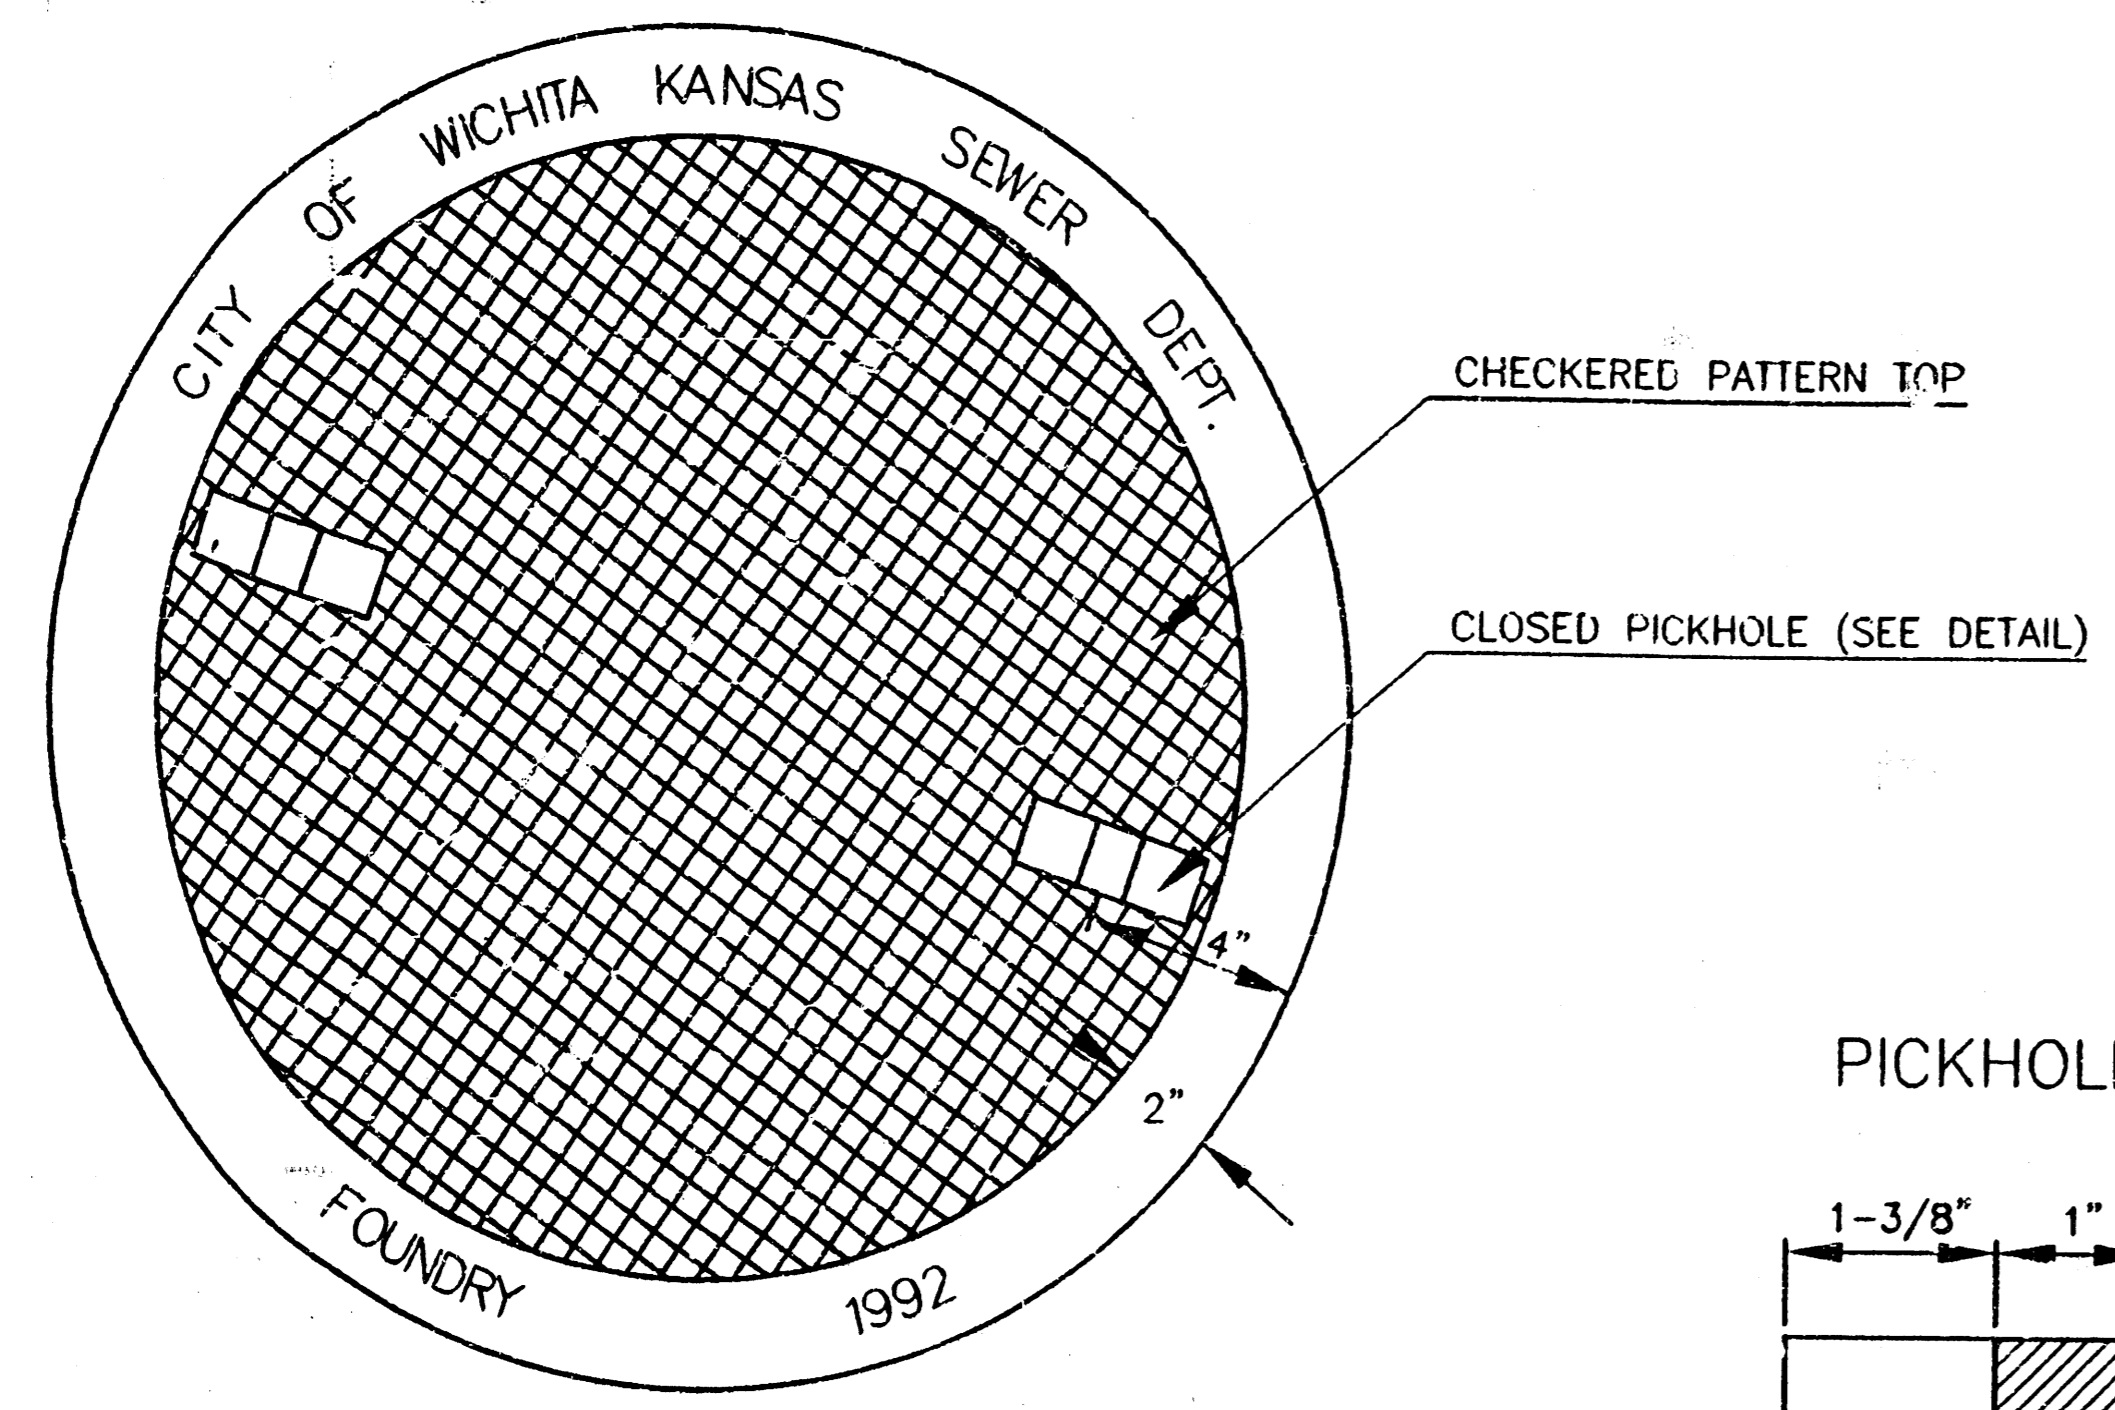


TOP VIEW

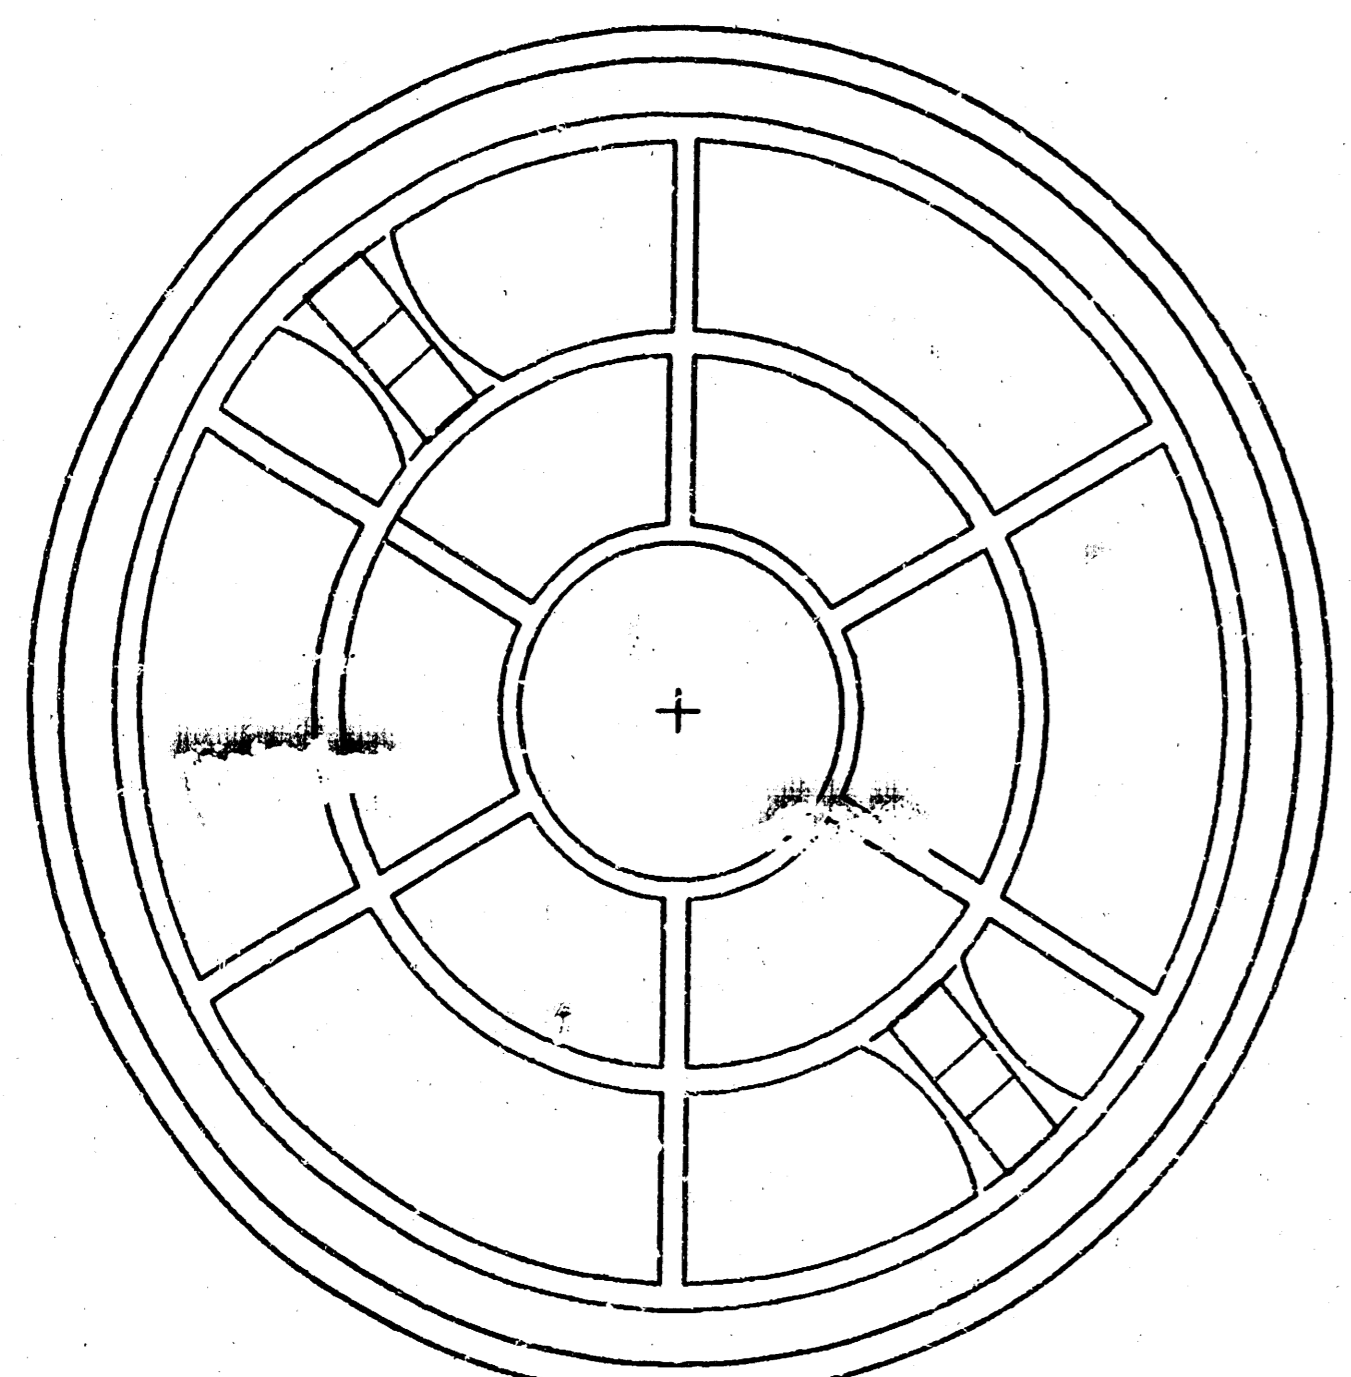


BOTTOM VIEW

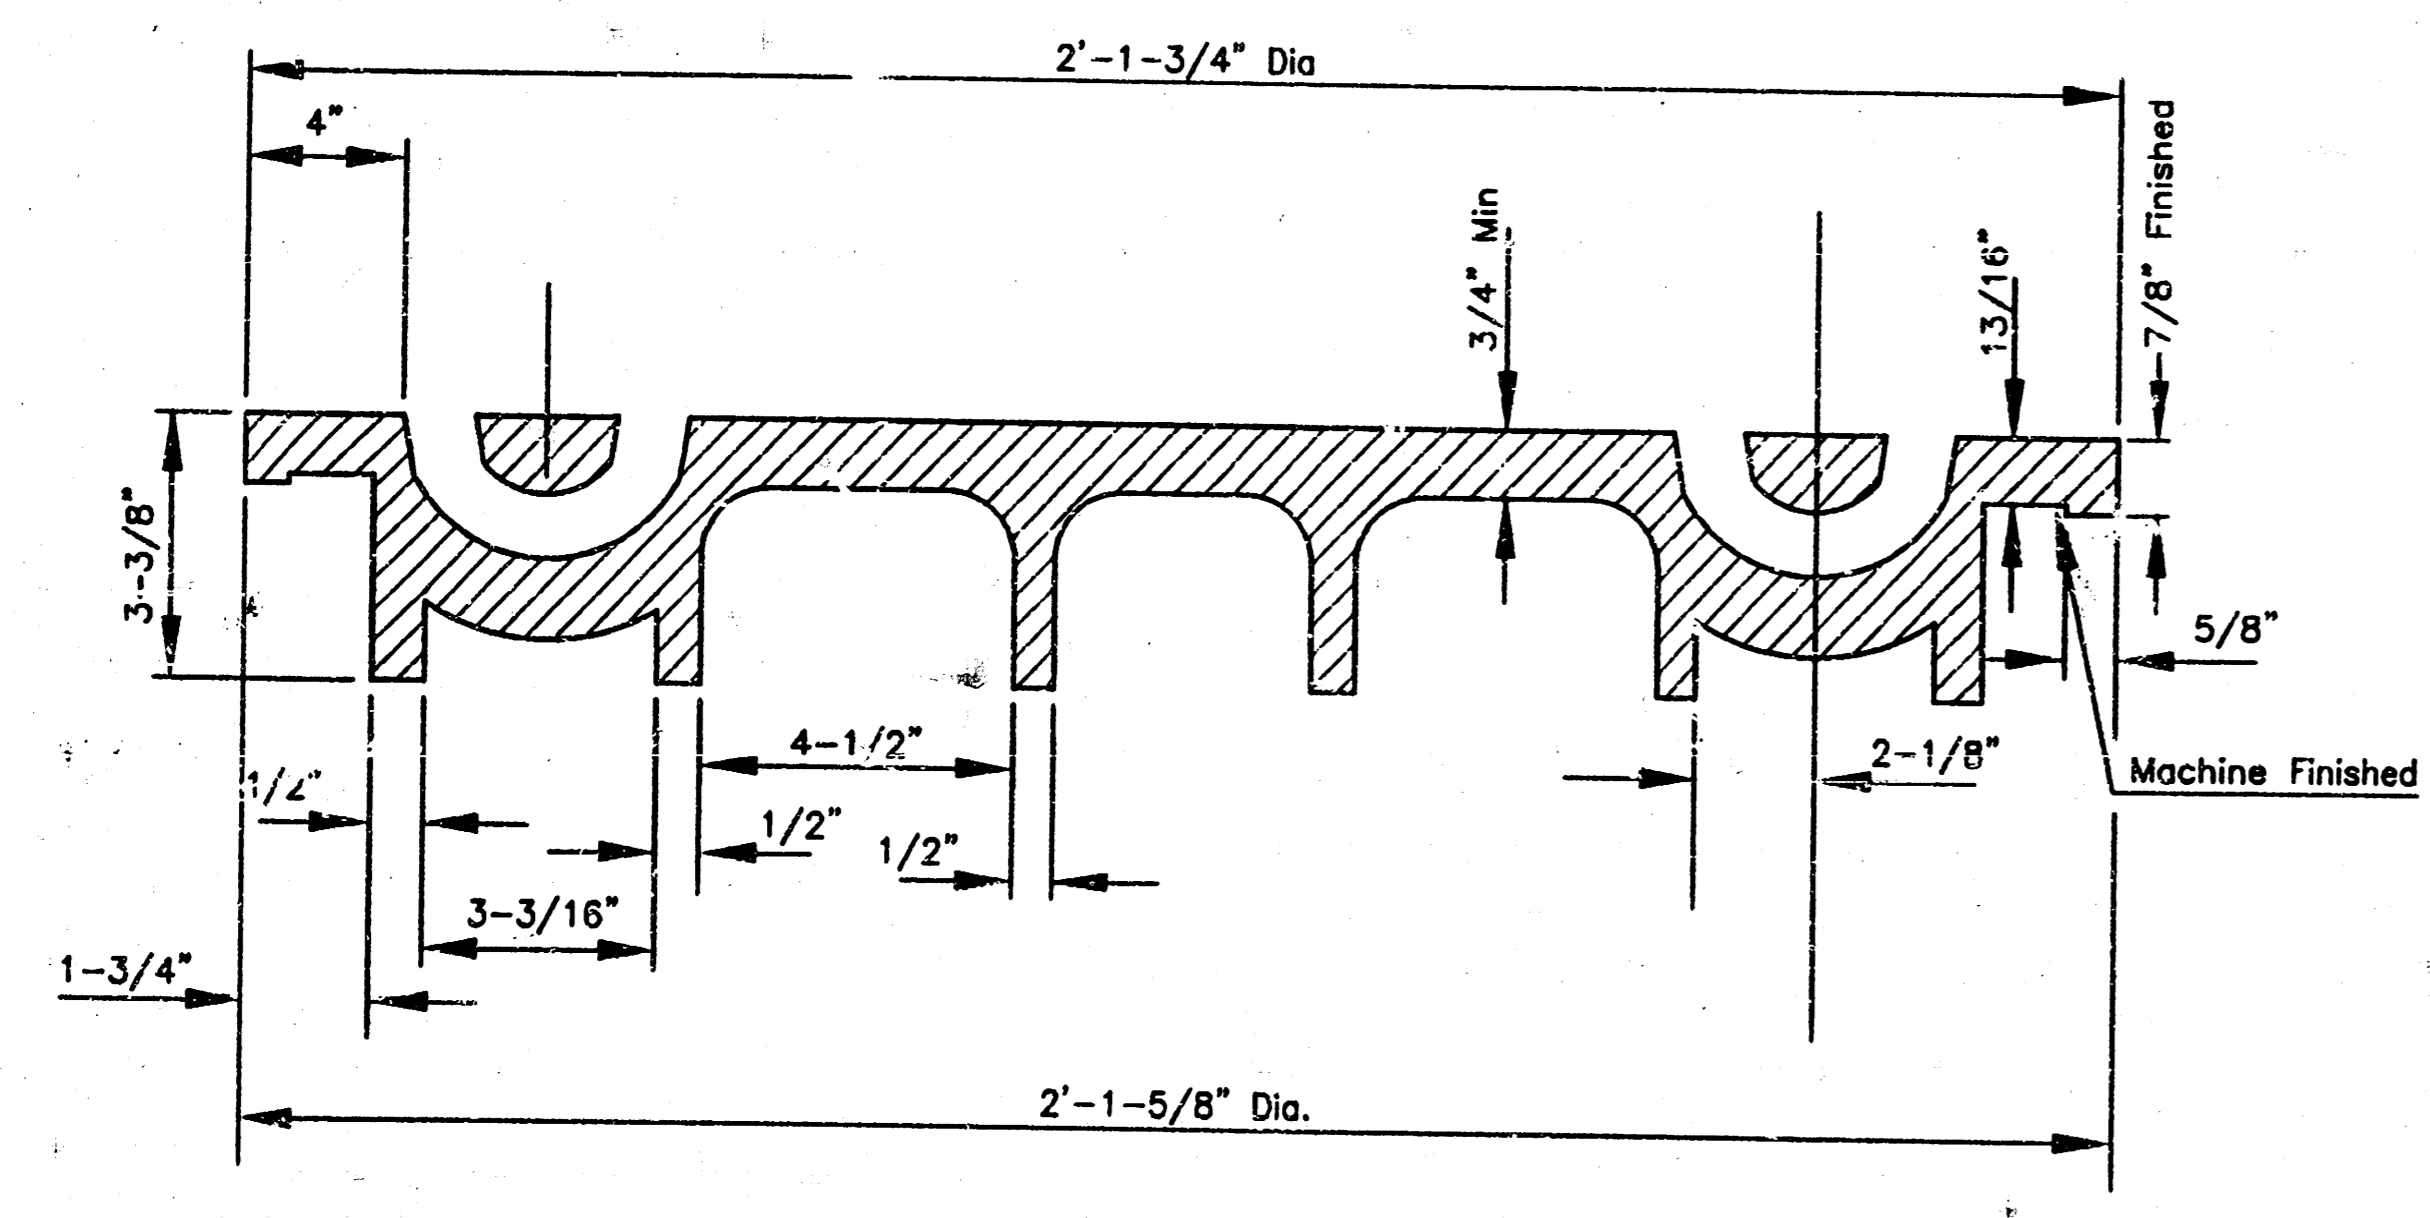

SECTION VIEW

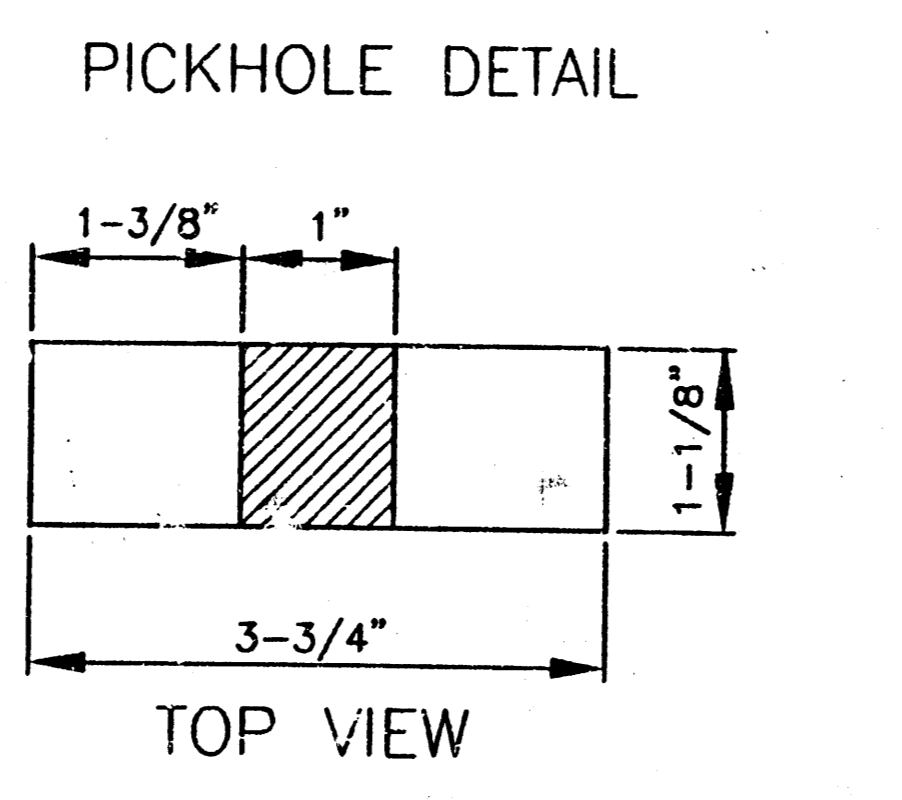

PICKHOLE DETAIL  
TOP VIEW

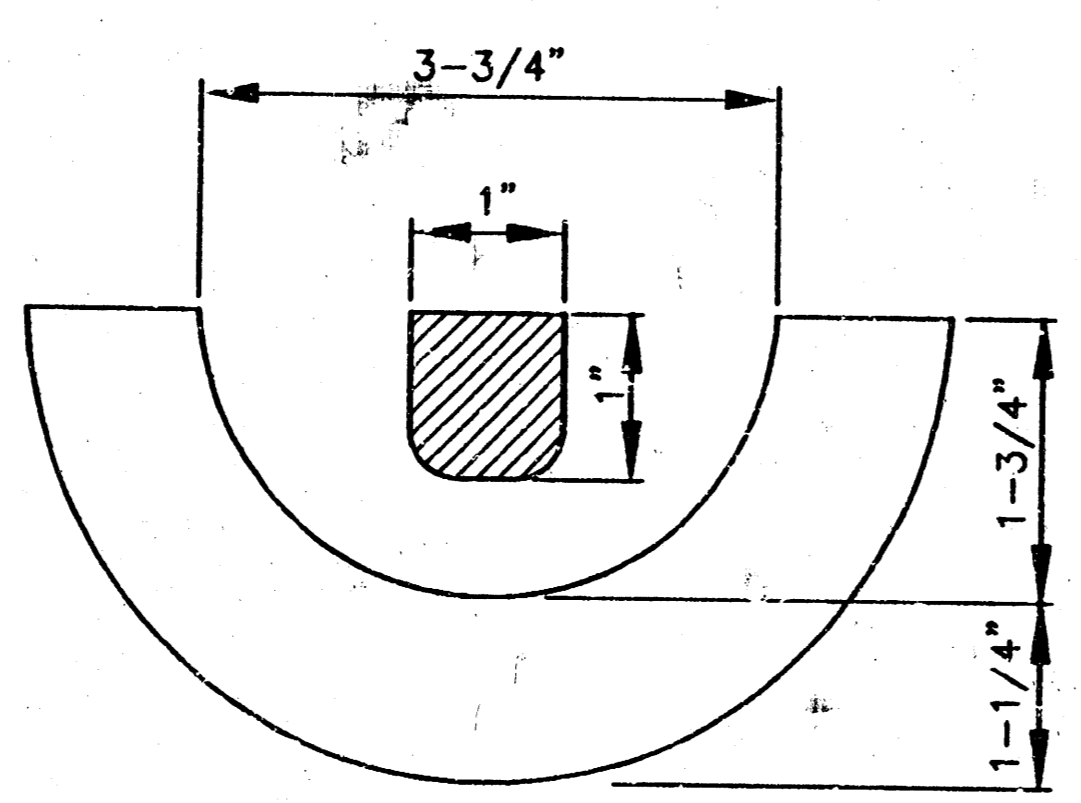


SECTION VIEW

# MANHOLE FRAME AND COVER DETAIL

ADOPTED AS STANDARD DESIGN BY  
CITY OF WICHITA, KANSAS


MANHOLE FRAME  
Weight = 240 Lbs.

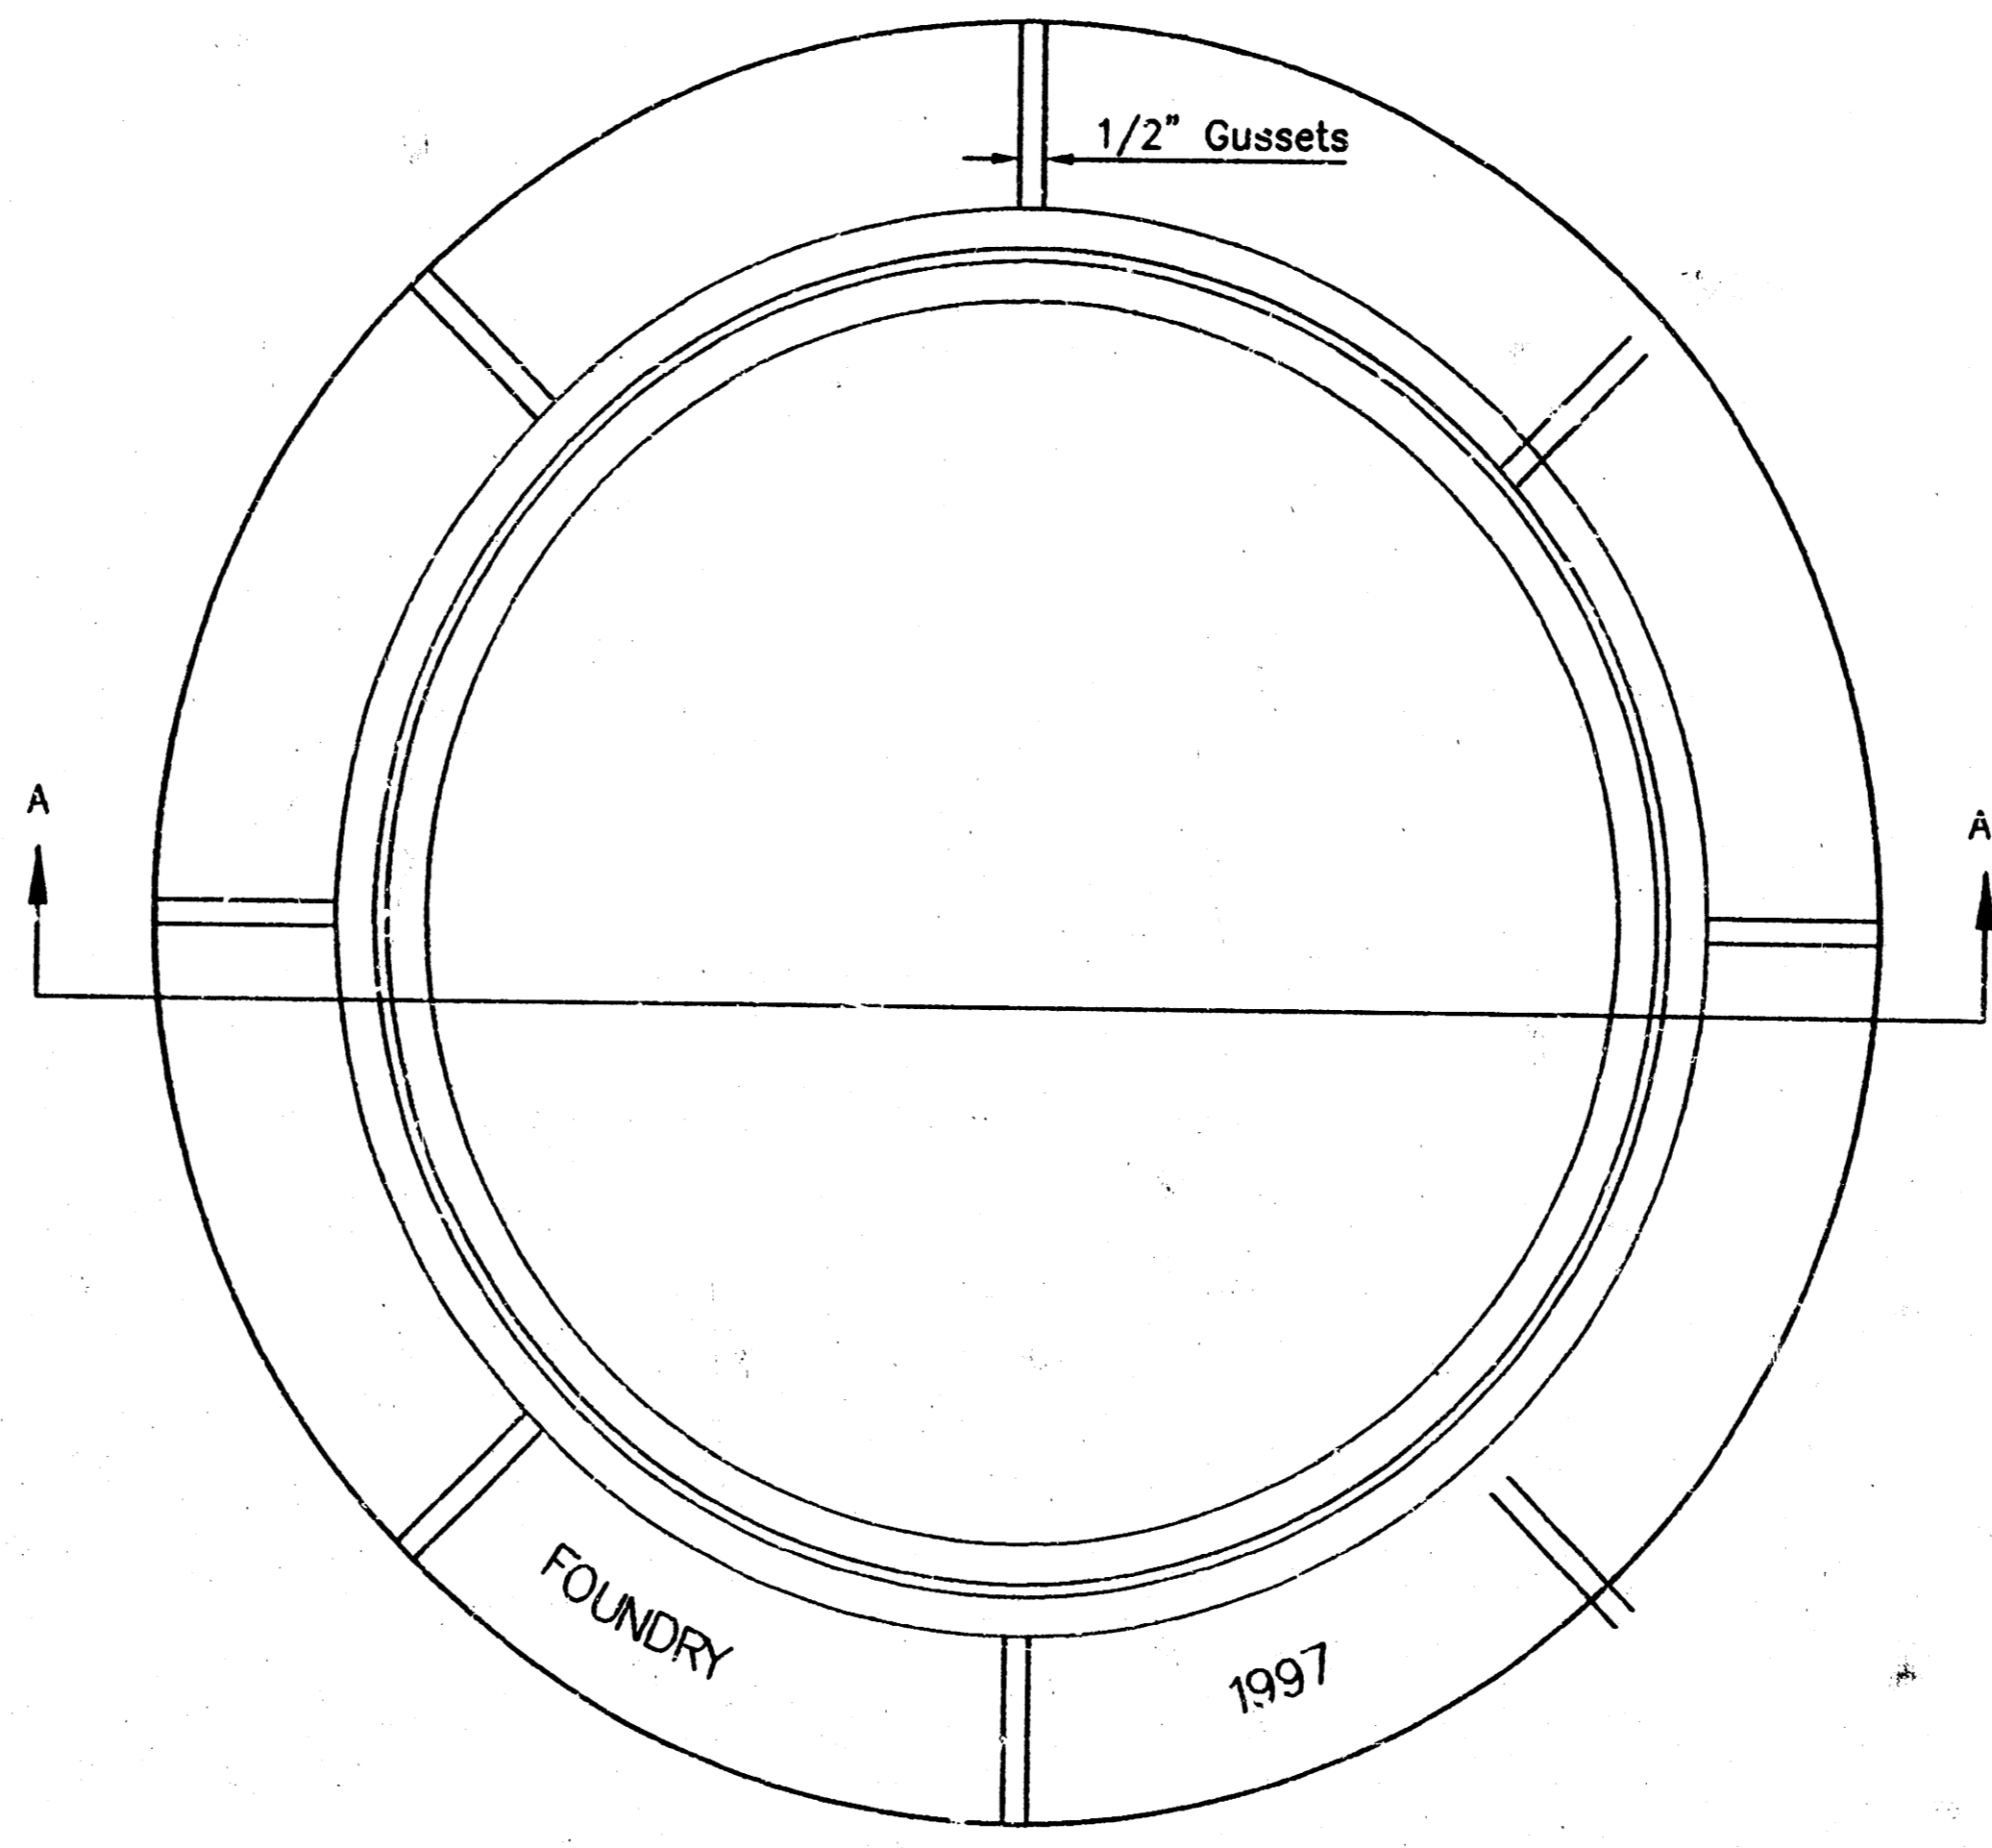


TOP VIEW

## GENERAL NOTES

- MANHOLE CASTINGS SHALL BE MANUFACTURED USING GOOD QUALITY GRAY IRON CONFORMING TO CLASS 30 OF A.S.T.M. DESIGNATION A-48. DIMENSIONS AND WEIGHTS SHOWN ON THE DETAILED DRAWINGS SHALL BE CONSIDERED AS MINIMUM REQUIREMENTS AND ANY DEVIATIONS FROM THE DIMENSIONS SHOWN MUST BE SPECIFICALLY APPROVED. THE FINISHED CASTINGS SHALL BE OF UNIFORM QUALITY, FREE FROM BLOWHOLES, POROSITY, HARD SPOTS, SHRINKAGE DISTORTIONS OR OTHER DEFECTS.
- MANHOLE CASTINGS SHALL WEIGH A MINIMUM OF 180 POUNDS ON THE SOLID COVER AND 240 POUNDS ON THE MANHOLE RING. THIS IS A TOTAL OF 420 POUNDS ON A RING AND COVER SET. CASTINGS WEIGHING LESS THAN THE MINIMUM SPECIFICATIONS WILL NOT BE ACCEPTED.
- MANHOLE CASTINGS SHALL BE MANUFACTURED SUCH THAT A COVER MANUFACTURED BY ANY ONE FOUNDRY WILL FIT INTERCHANGEABLY INTO A FRAME MANUFACTURED BY ANOTHER FOUNDRY AND STILL MEET ALLOWABLE CLEARANCES AND NON-ROCKING REQUIREMENTS. THIS WILL REQUIRE MANUFACTURING OF THE MATCHING FACES ON THE COVER AND THE FRAME TO CLOSE TOLERANCES.
- THE OUTSIDE CIRCUMFERENCE OF THE VERTICAL FACE OF THE COVER AND THE INSIDE CIRCUMFERENCE OF THE VERTICAL FACE IN THE FRAME RECESS SHALL BE MANUFACTURED TO TOLERANCES SUCH THAT THE CLEARANCE BETWEEN THE COVER AND FRAME WILL NOT EXCEED 1/8" AT ANY POINT AROUND THE CIRCUMFERENCE OF THE COVER. THE SEATING SURFACES BETWEEN THE COVER AND FRAME SHALL BE MACHINED SUCH THAT THESE SEATING SURFACES SHALL MAKE FULL CONTACT FOR THEIR FULL CIRCUMFERENCE TO PRECLUDE THE COVER FROM ROCKING IN THE FRAME.
- THE MANHOLE FRAME AND COVER SHALL BE MARKED WITH LETTERING INDICATING THE NAME OF THE MANUFACTURER AND THE YEAR WHEN THE COVER OR FRAME WAS CAST. THE COVER SHALL BE FURTHER IDENTIFIED WITH REGARDS TO OWNERSHIP USING LETTERS AT LEAST 1 INCH IN HEIGHT. THIS IDENTIFICATION SHALL BE "CITY OF WICHITA SEWER DEPARTMENT". THE WORD DEPARTMENT MAY BE ABBREVIATED. THE TEXTURE OF THE TOP SURFACE OF THE COVER SHALL BE MANUFACTURED IN A CHECKERED PATTERN DESIGN AS INDICATED ON THE DRAWINGS. SMOOTH BLOCKOUTS SHALL BE UTILIZED TO HIGHLIGHT THE LETTERING ON THE COVER SURFACE. THE TOTAL AREA OF SMOOTH SURFACE BLOCKOUT SHALL NOT EXCEED THE AREA AS INDICATED ON THE DRAWING. POSITIONING OF SMOOTH BLOCKOUTS AND LETTERING MAY VARY FROM THAT SHOWN ON THE DETAILED DRAWING.

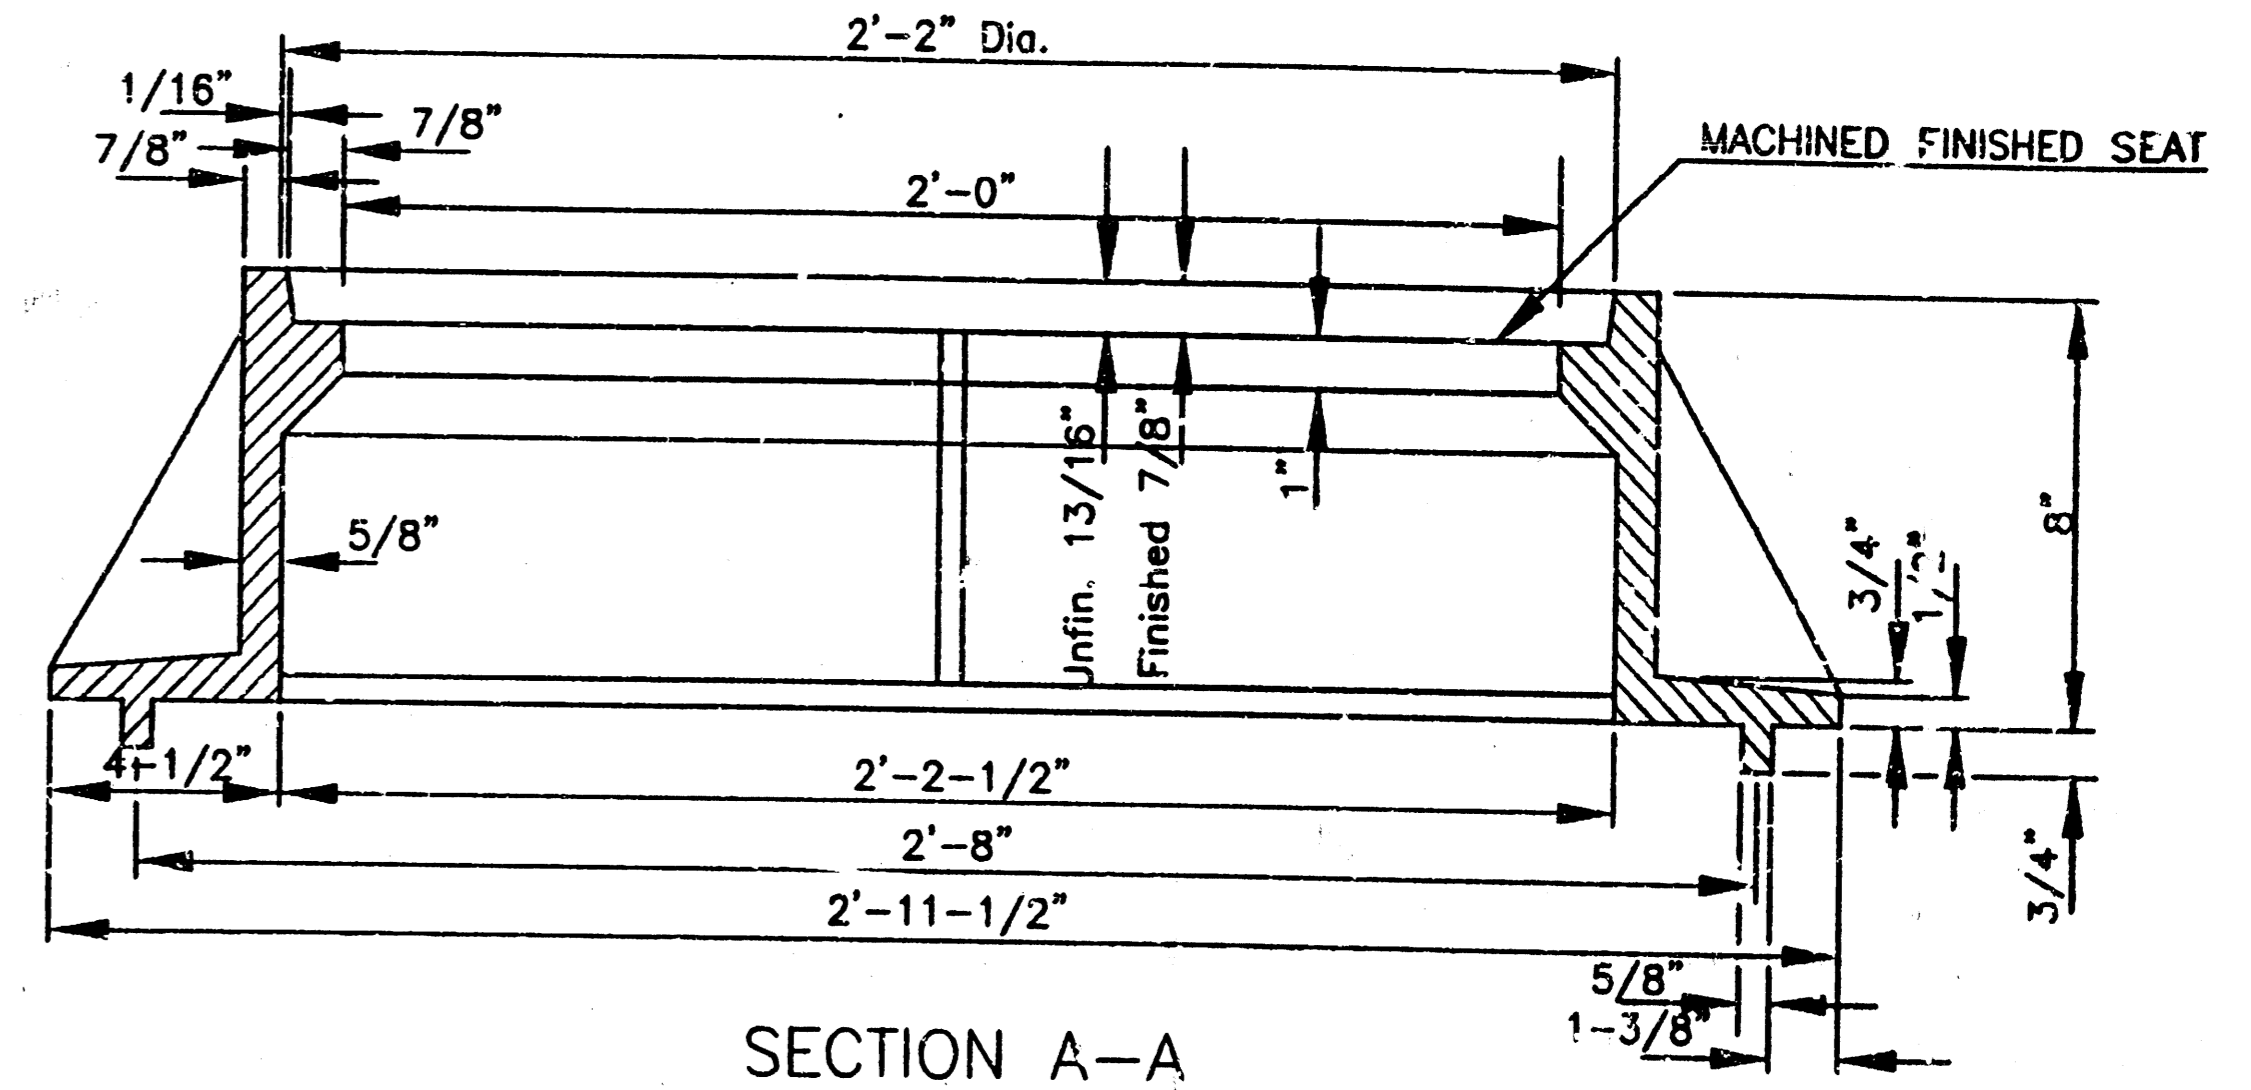

SECTION A-A  
MUD RING

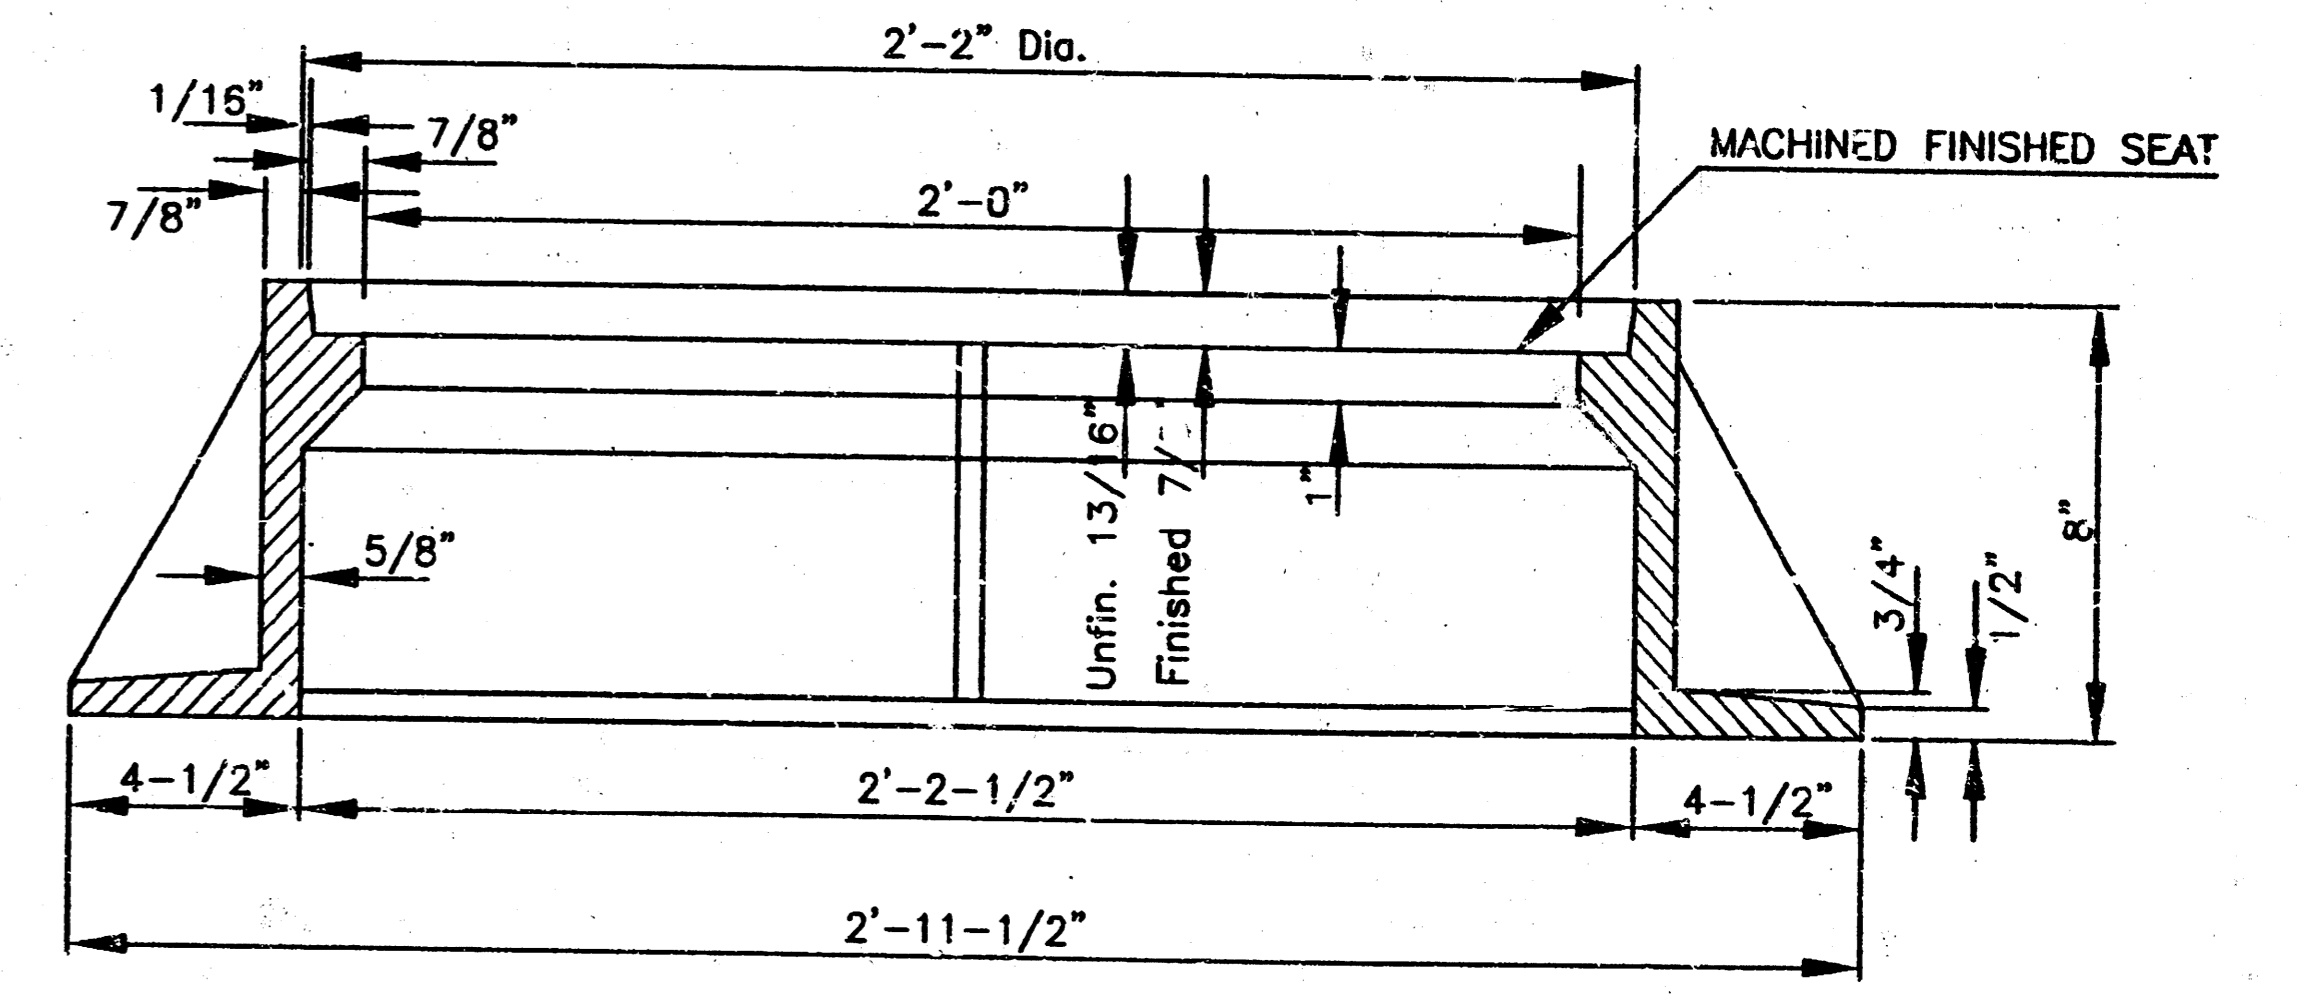

SECTION A-A

<p>THE CITY OF WICHITA CITY ENGINEER'S OFFICE CITY HALL - SEVENTH FLOOR 502 NORTH MAIN STREET WICHITA, KANSAS 67202 (316) 266-4114 FAX</p>	<p>MANHOLE FRAME AND COVER</p>	
	<p>M. E. LINDEBAK P.E. - CITY ENGINEER</p>	
	<p>PROJECT NUMBER 784 PPS</p>	<p>INDEX CODE 607861</p>
	<p>DATE MAR 96</p>	<p>SHEET 9 OF 9</p>