



HWY. K-15

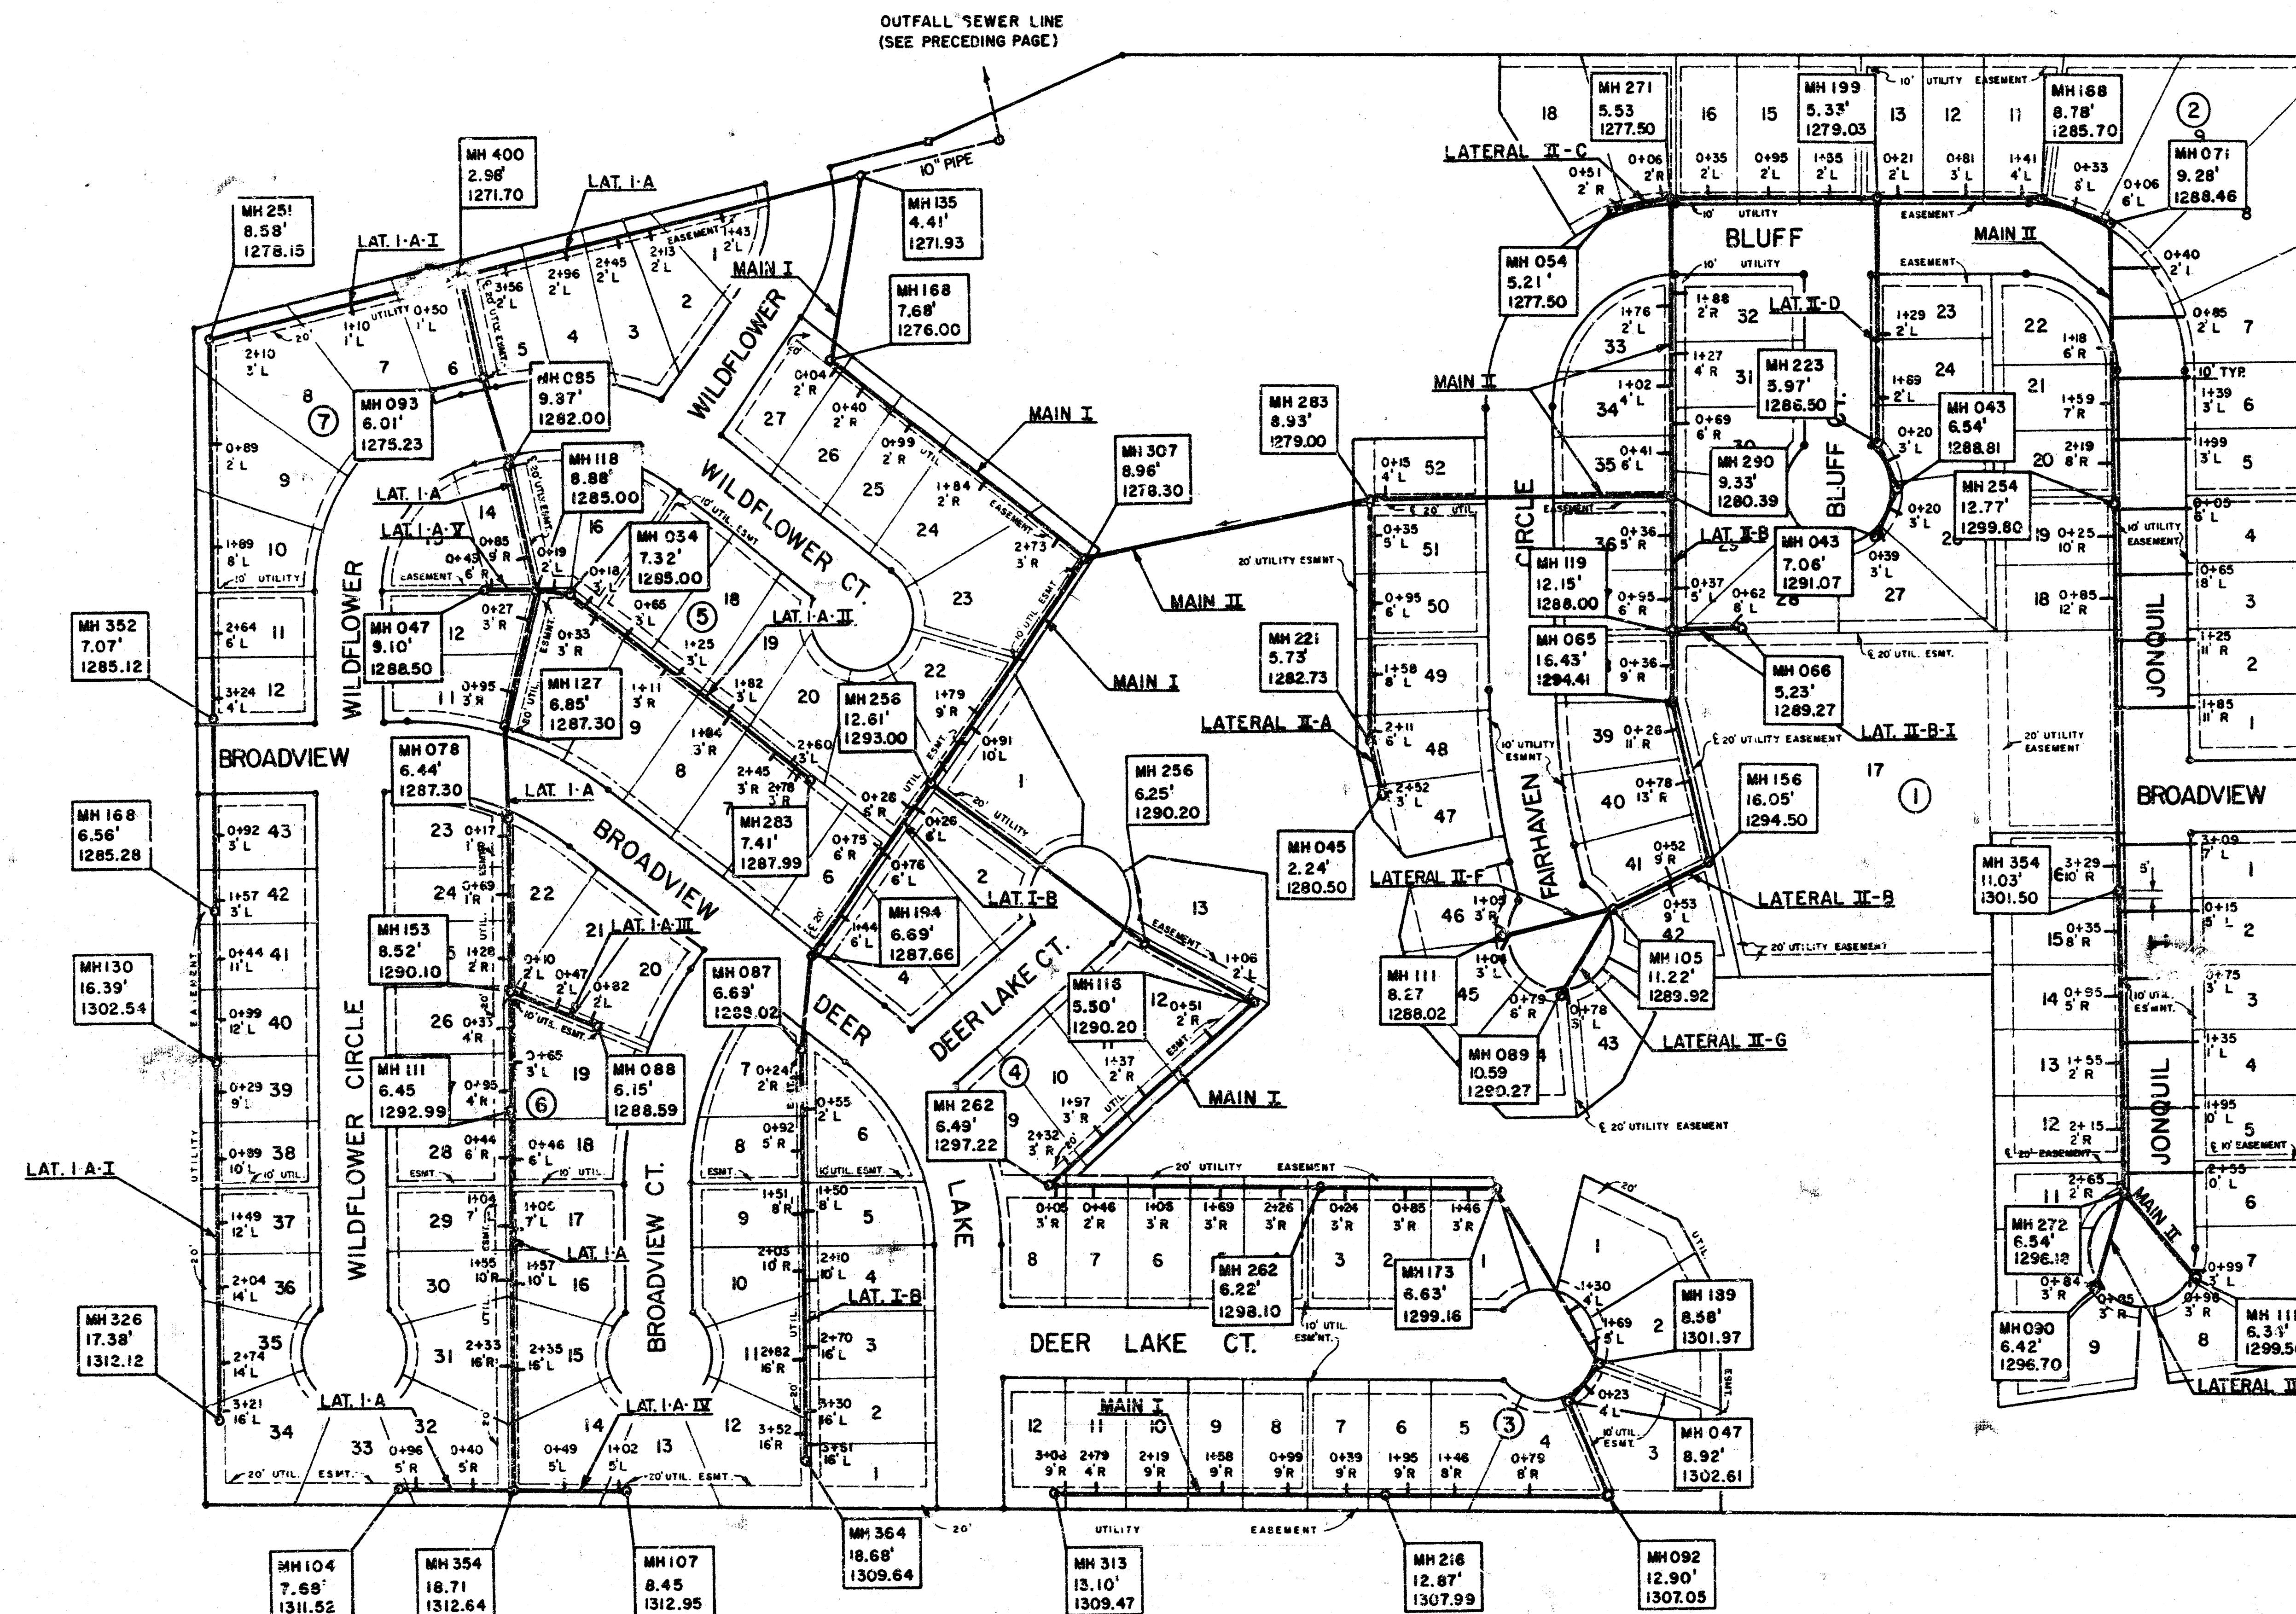

LEGEND

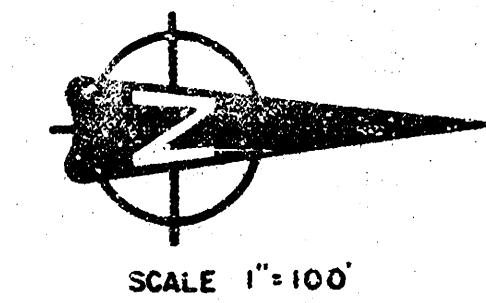

DISTANCE TO PRECEDING DOWNSTREAM MANHOLE
DEPTH - RING TO FLOW LINE OUT
MANHOLE RING ELEVATION

WYE
DISTANCE FROM PRECEDING
DOWNSTREAM MANHOLE
LINEAR FOOT OF RISER PIPE
L=LEFT, R=RIGHT OF MAIN
ALL PIPE SHOWN IS 8" UNLESS OTHERWISE NOTED.



DEISS & GOODNESS ENGINEERS
2160 W. 1ST ST.
WICHITA, KANSAS 67203
(316) 832-0213

"AS CONSTRUCTED" SANITARY SEWER SYSTEM

DEER LAKES ESTATES, SEDGWICK COUNTY, KANSAS

SCALE 1"=100'
DATE 4/29/83
PROJECT NO.
SHEET 2 OF 2

**OAKLAWN
SUBDIVISION**

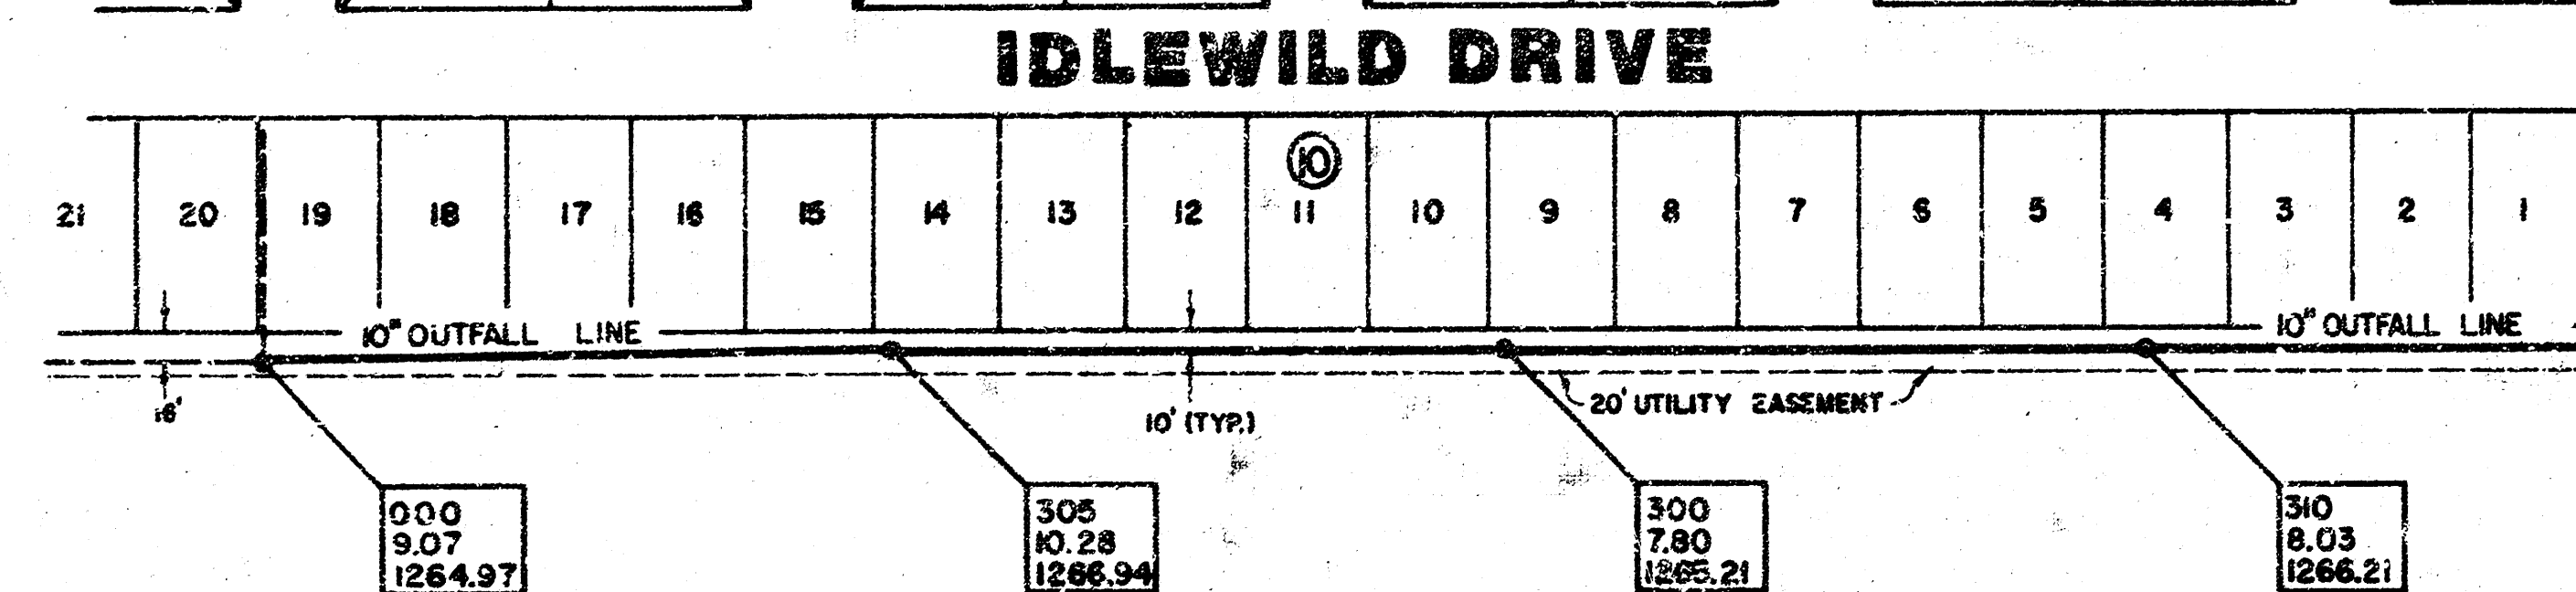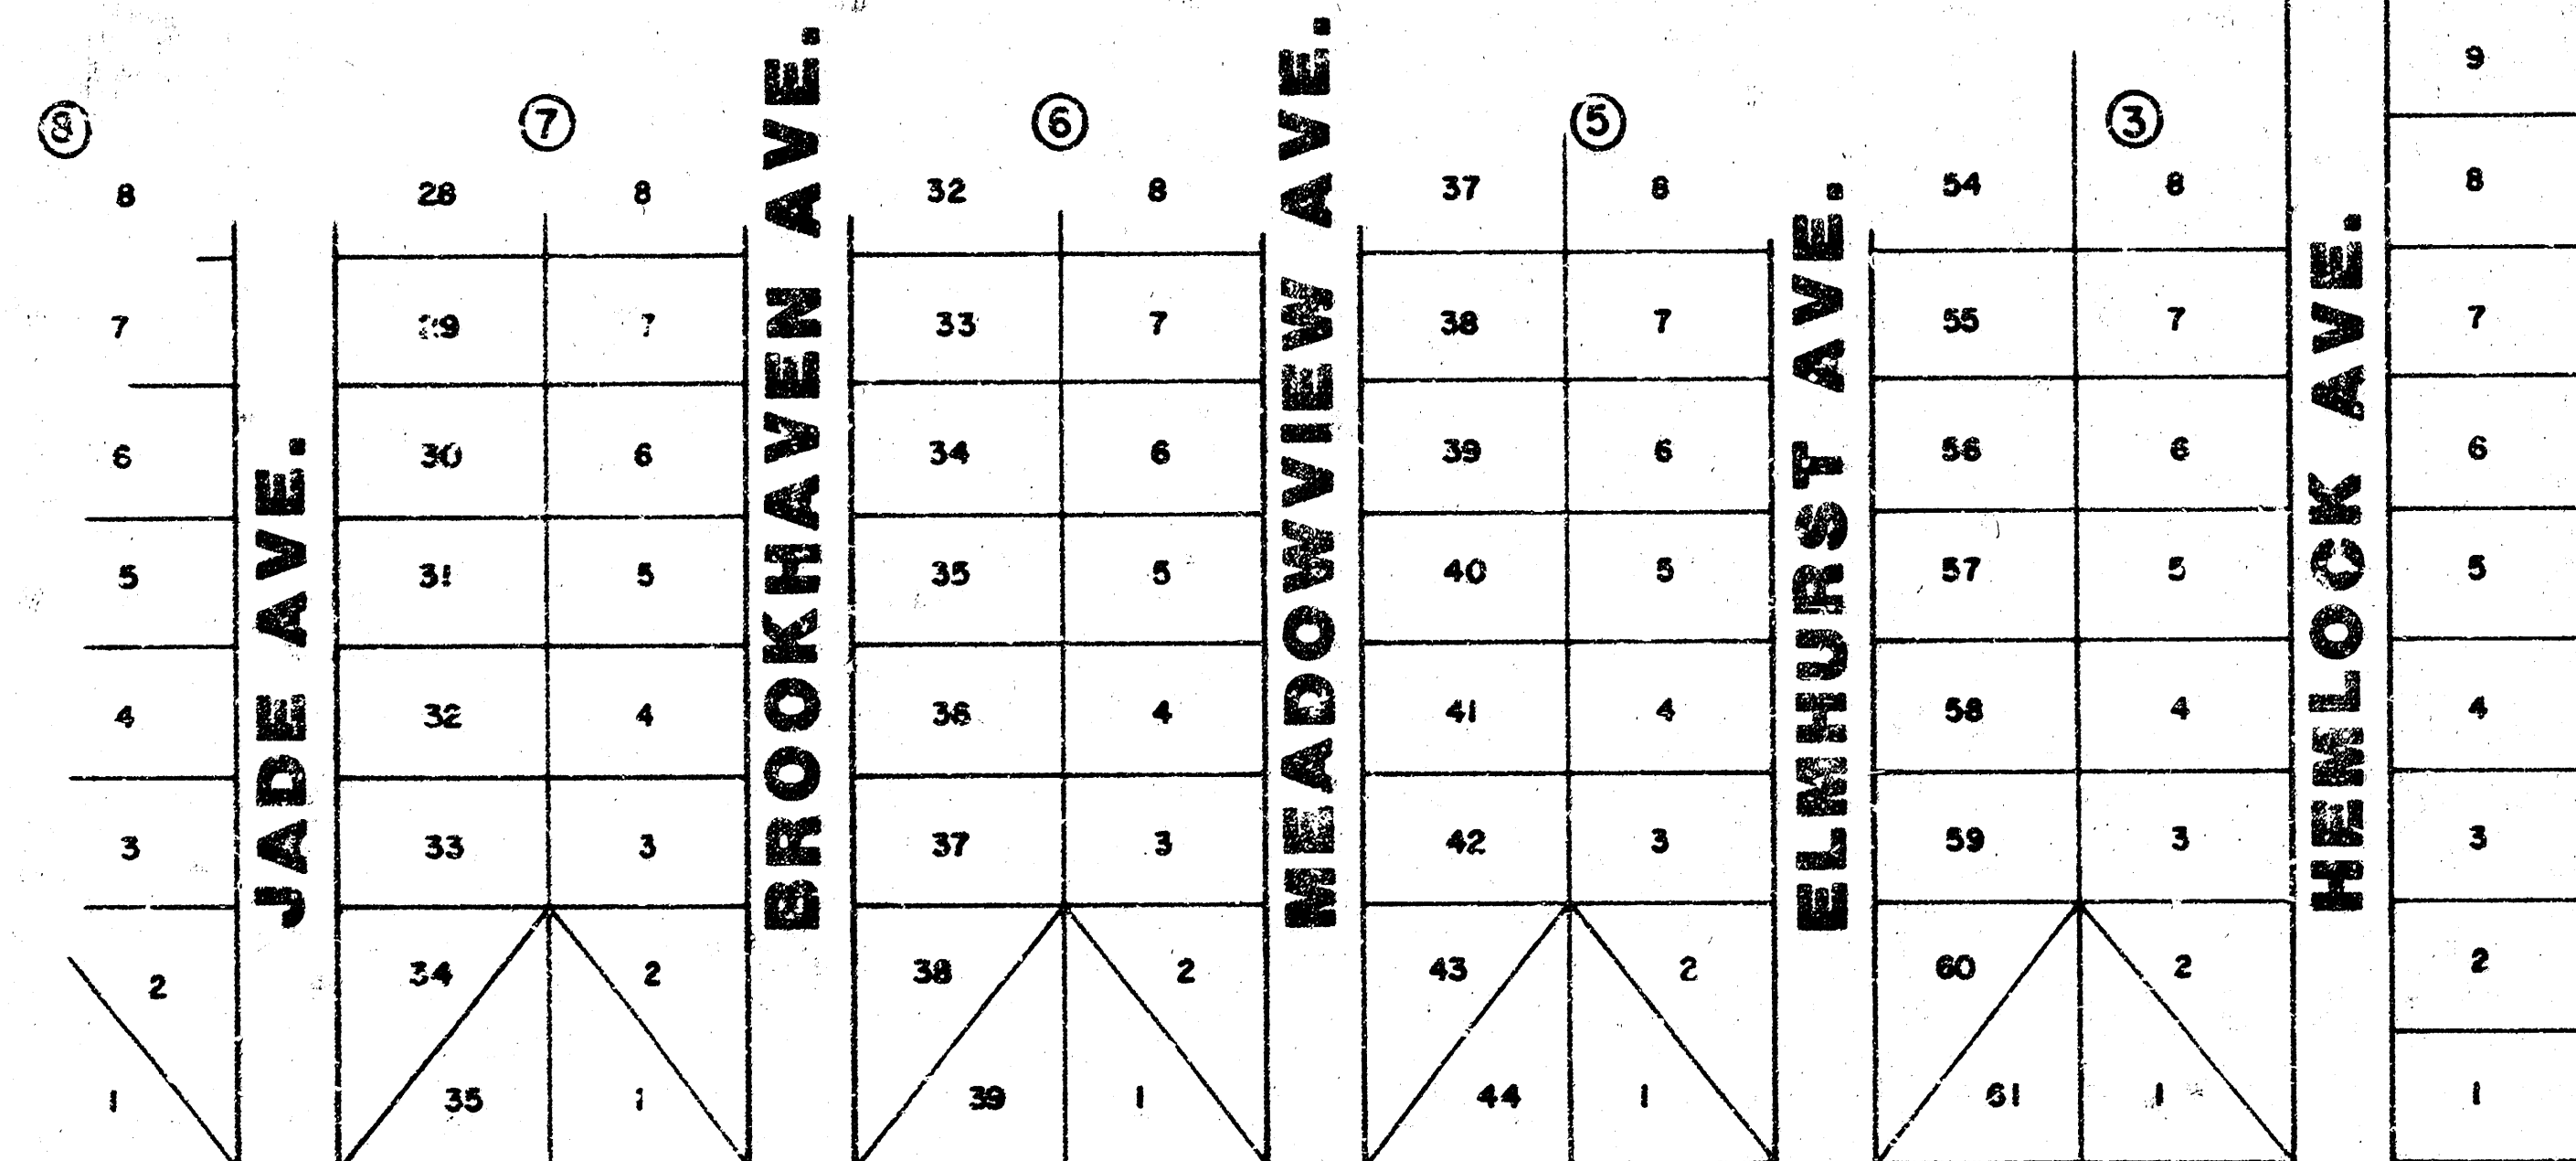

PINAIRE MOBILE HOME PARK

TIERRA AVE.

③

②

SO. CLIFTON AVE.

**MATHEWSON AVENUE
CHURCH OF CHRIST**

U. S. D. 260

DEER LAKE ESTATES


K-15 STATE HIGHWAY

A.T. & S.F. R.R.

123 4.56 1234.56
DISTANCE TO DOWNSTREAM MANHOLE
MEASUREMENT (RING TO FL. OUT)
TOP OF MANHOLE RING (U.S.G.S. DATUM)

SEWER LINE MANHOLE

NOTE:
- ALL PIPE ON THIS SHEET IS 10"
- THERE ARE NO STUBS INSTALLED

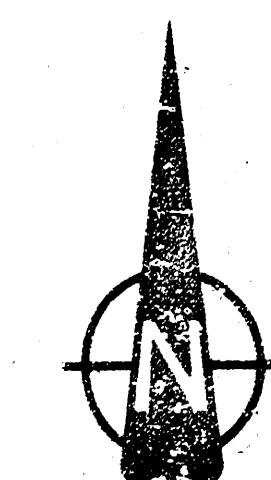

SCALE: 1"=100'

DEISS & GOODNESS ENGINEERS
2100 WEST 21ST STREET
WICHITA, KANSAS 67203
(316) 624-0213

"AS CONSTRUCTED" SANITARY SEWER SYSTEM

DEER LAKES ESTATES, SEDGWICK COUNTY, KANSAS

SCALE: 3/16"=1'
DATE: 4/29/93
PROJECT NO.:
SHEET 1 OF 2