



D.M. 100.40 CHISELED SQUARE ON CENTERLINE CONCRETE
PAVEMENT SOUTH SLAB K-42 AND WEST LINE WEST STREET.

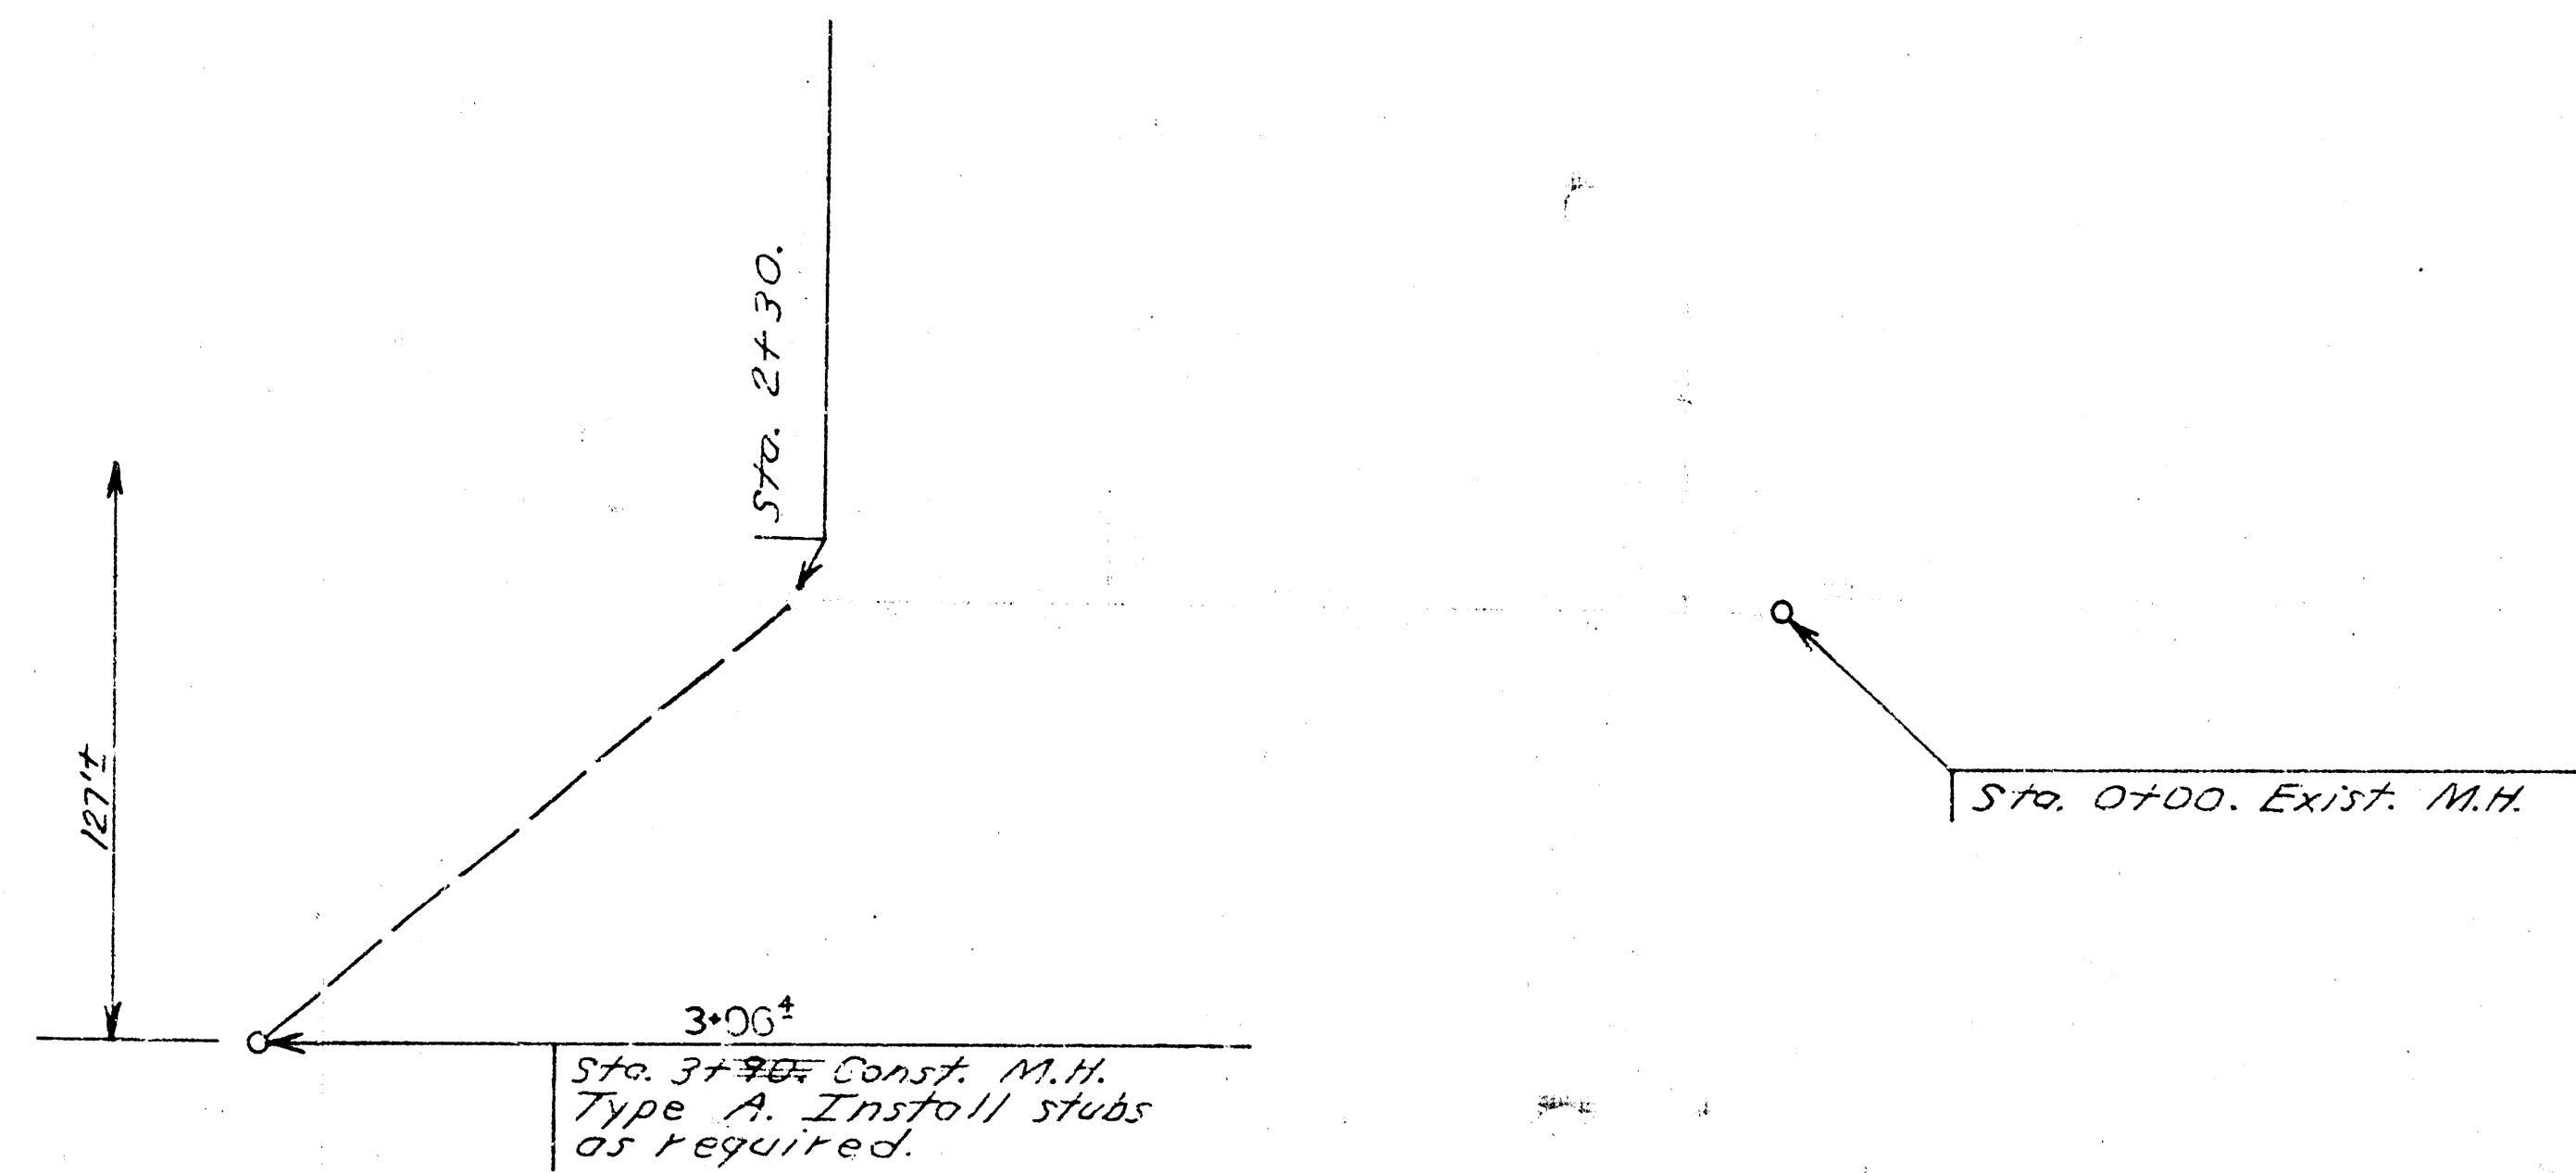

NOTE: EXACT LOCATION OF MANHOLE AT STA. 3+40 IS TO BE DETERMINED BY OWNER. CONCRETE ENCASMENT WILL BE REQUIRED UNDER THE DRAINAGE DITCH BEGINNING FROM MANHOLE AT STA 2+30 IF COVER OVER SEWER IS LESS THAN 30".

Rev. 10-26-73

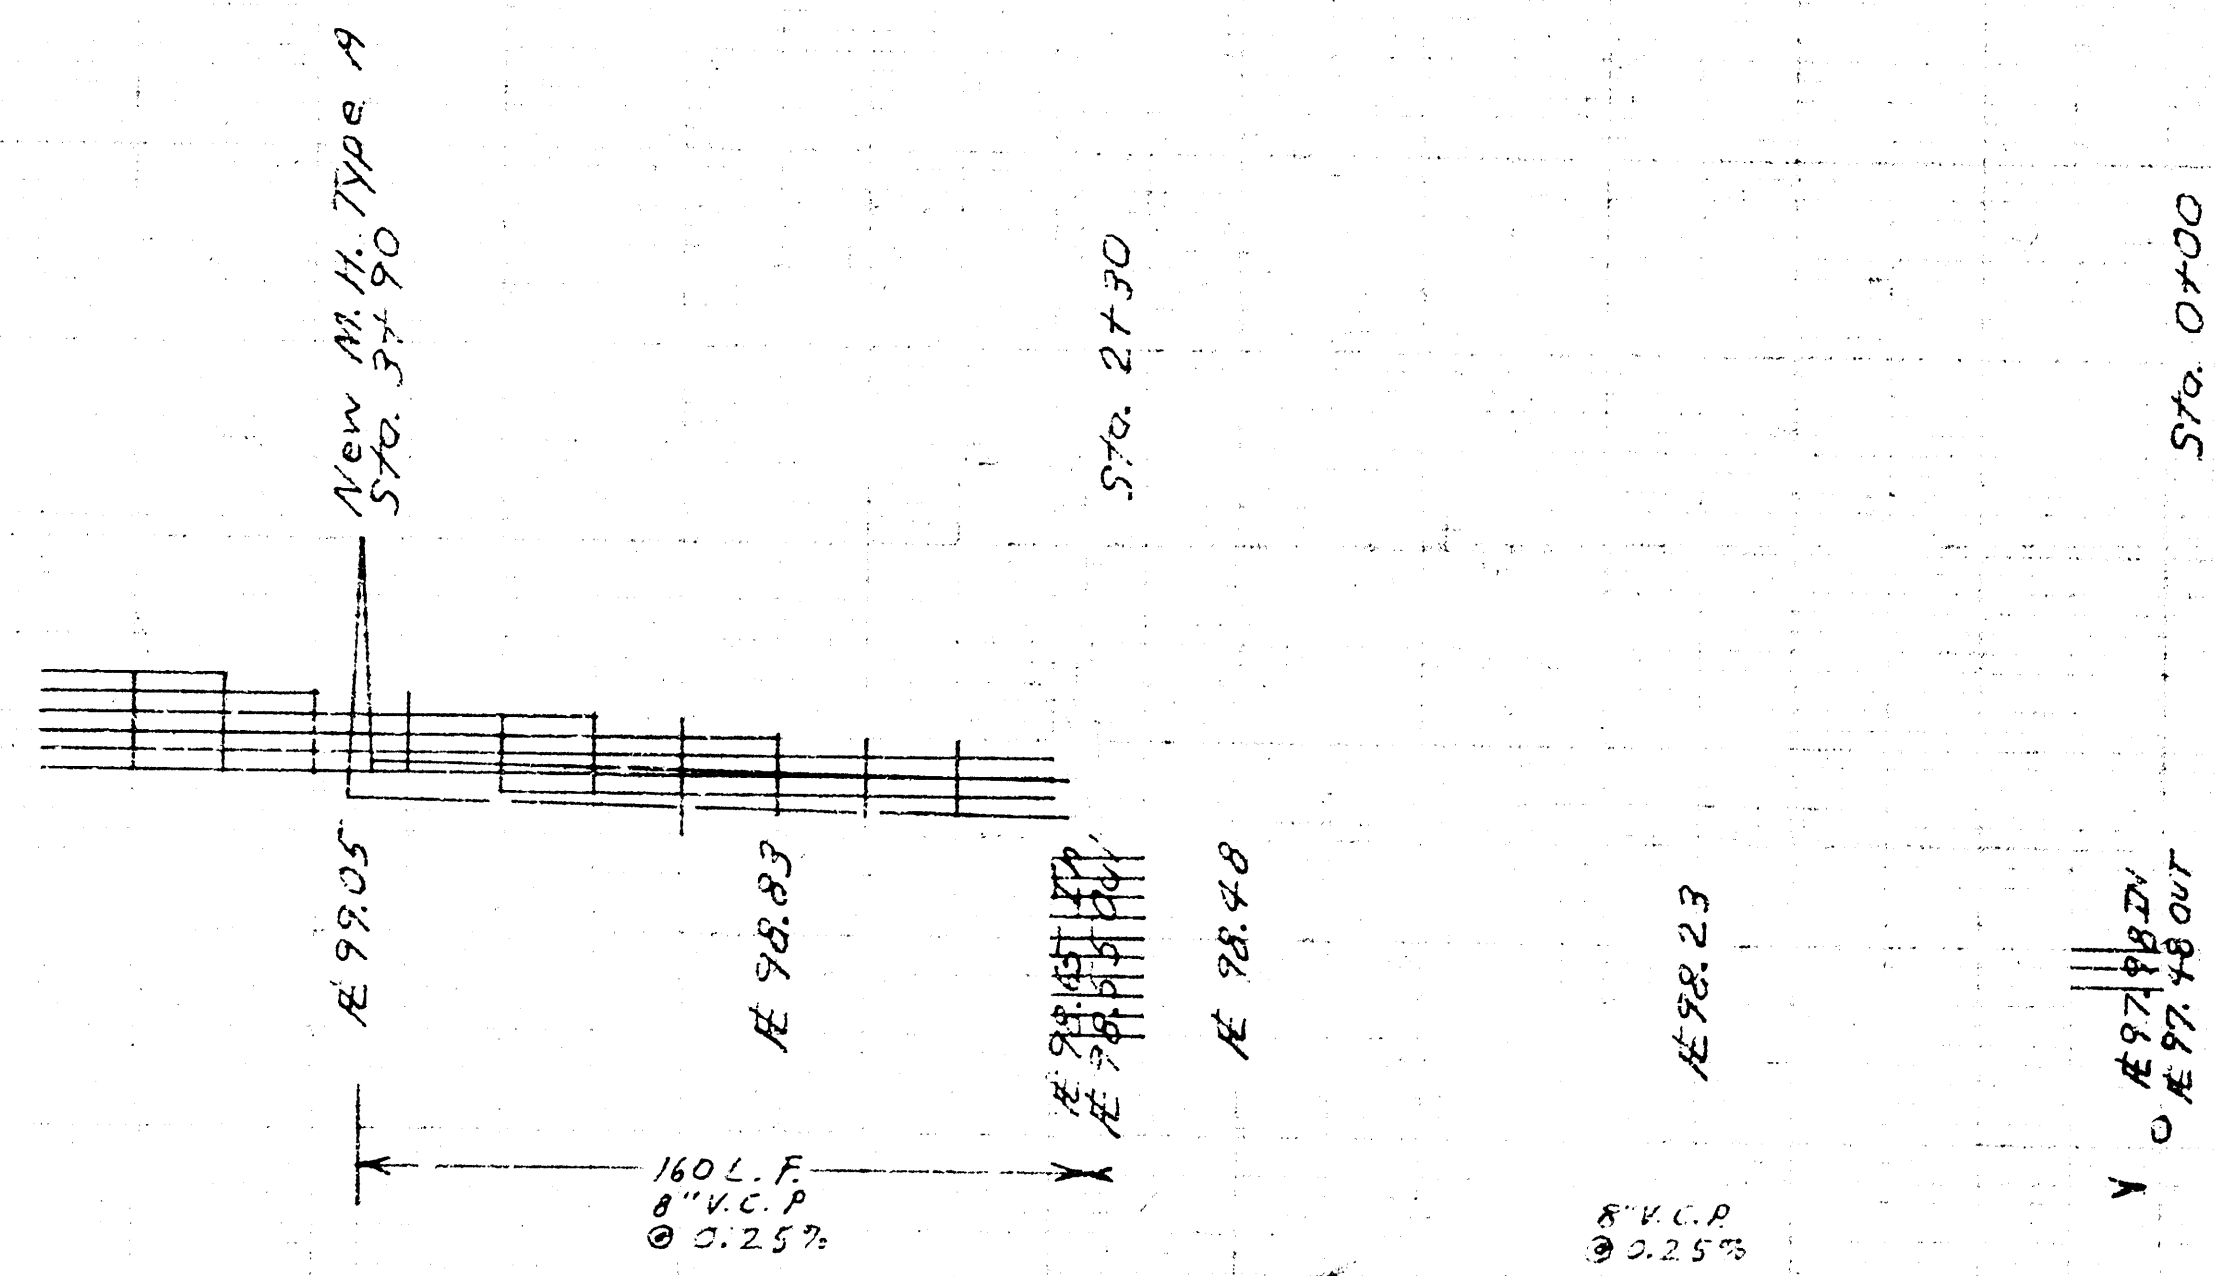

85 SURT. ENG. MEASUREMENTS
199.0843