



B.M. 100.49 CHISELED SQUARE ON CENTERLINE CONCRETE
PAVEMENT, SOUTH SLAB K-42 AND WEST LINE WEST STREET.

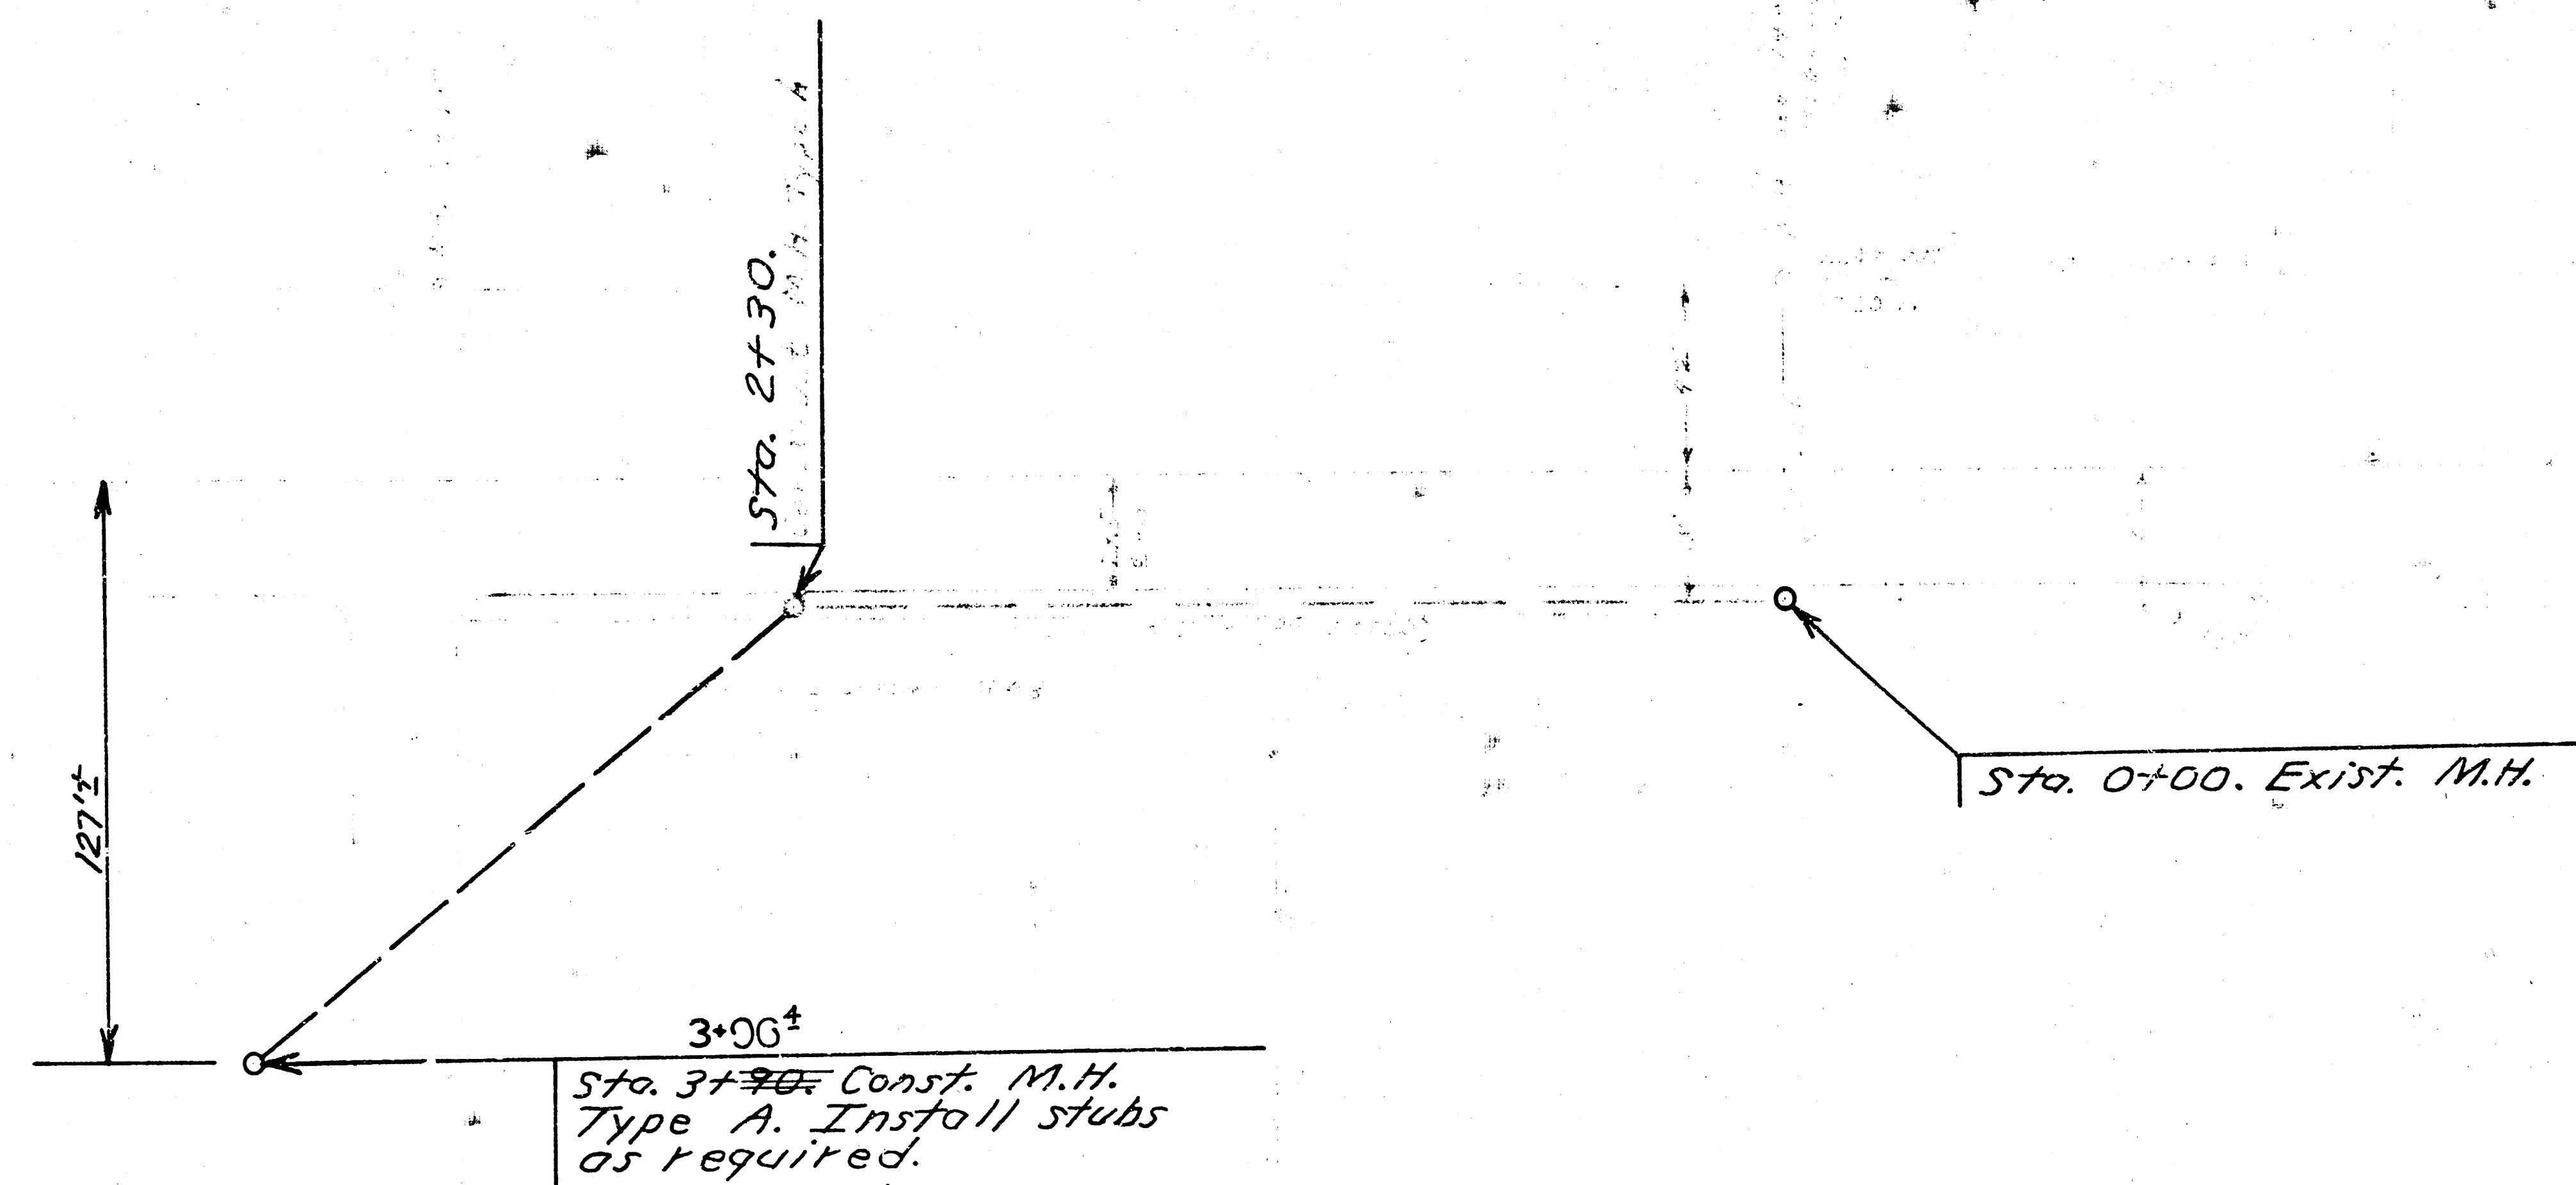

NOTE: EXACT LOCATION OF MANHOLE AT STA. 3+90 IS TO
BE DETERMINED BY OWNER. CONCRETE ENCASEMENT
WILL BE REQUIRED UNDER THE DRAINAGE DITCH
BEGINNING FROM MANHOLE AT STA 2+30 IF COVER
OVER SEWER IS LESS THAN 30".

Rev. 10-26-73

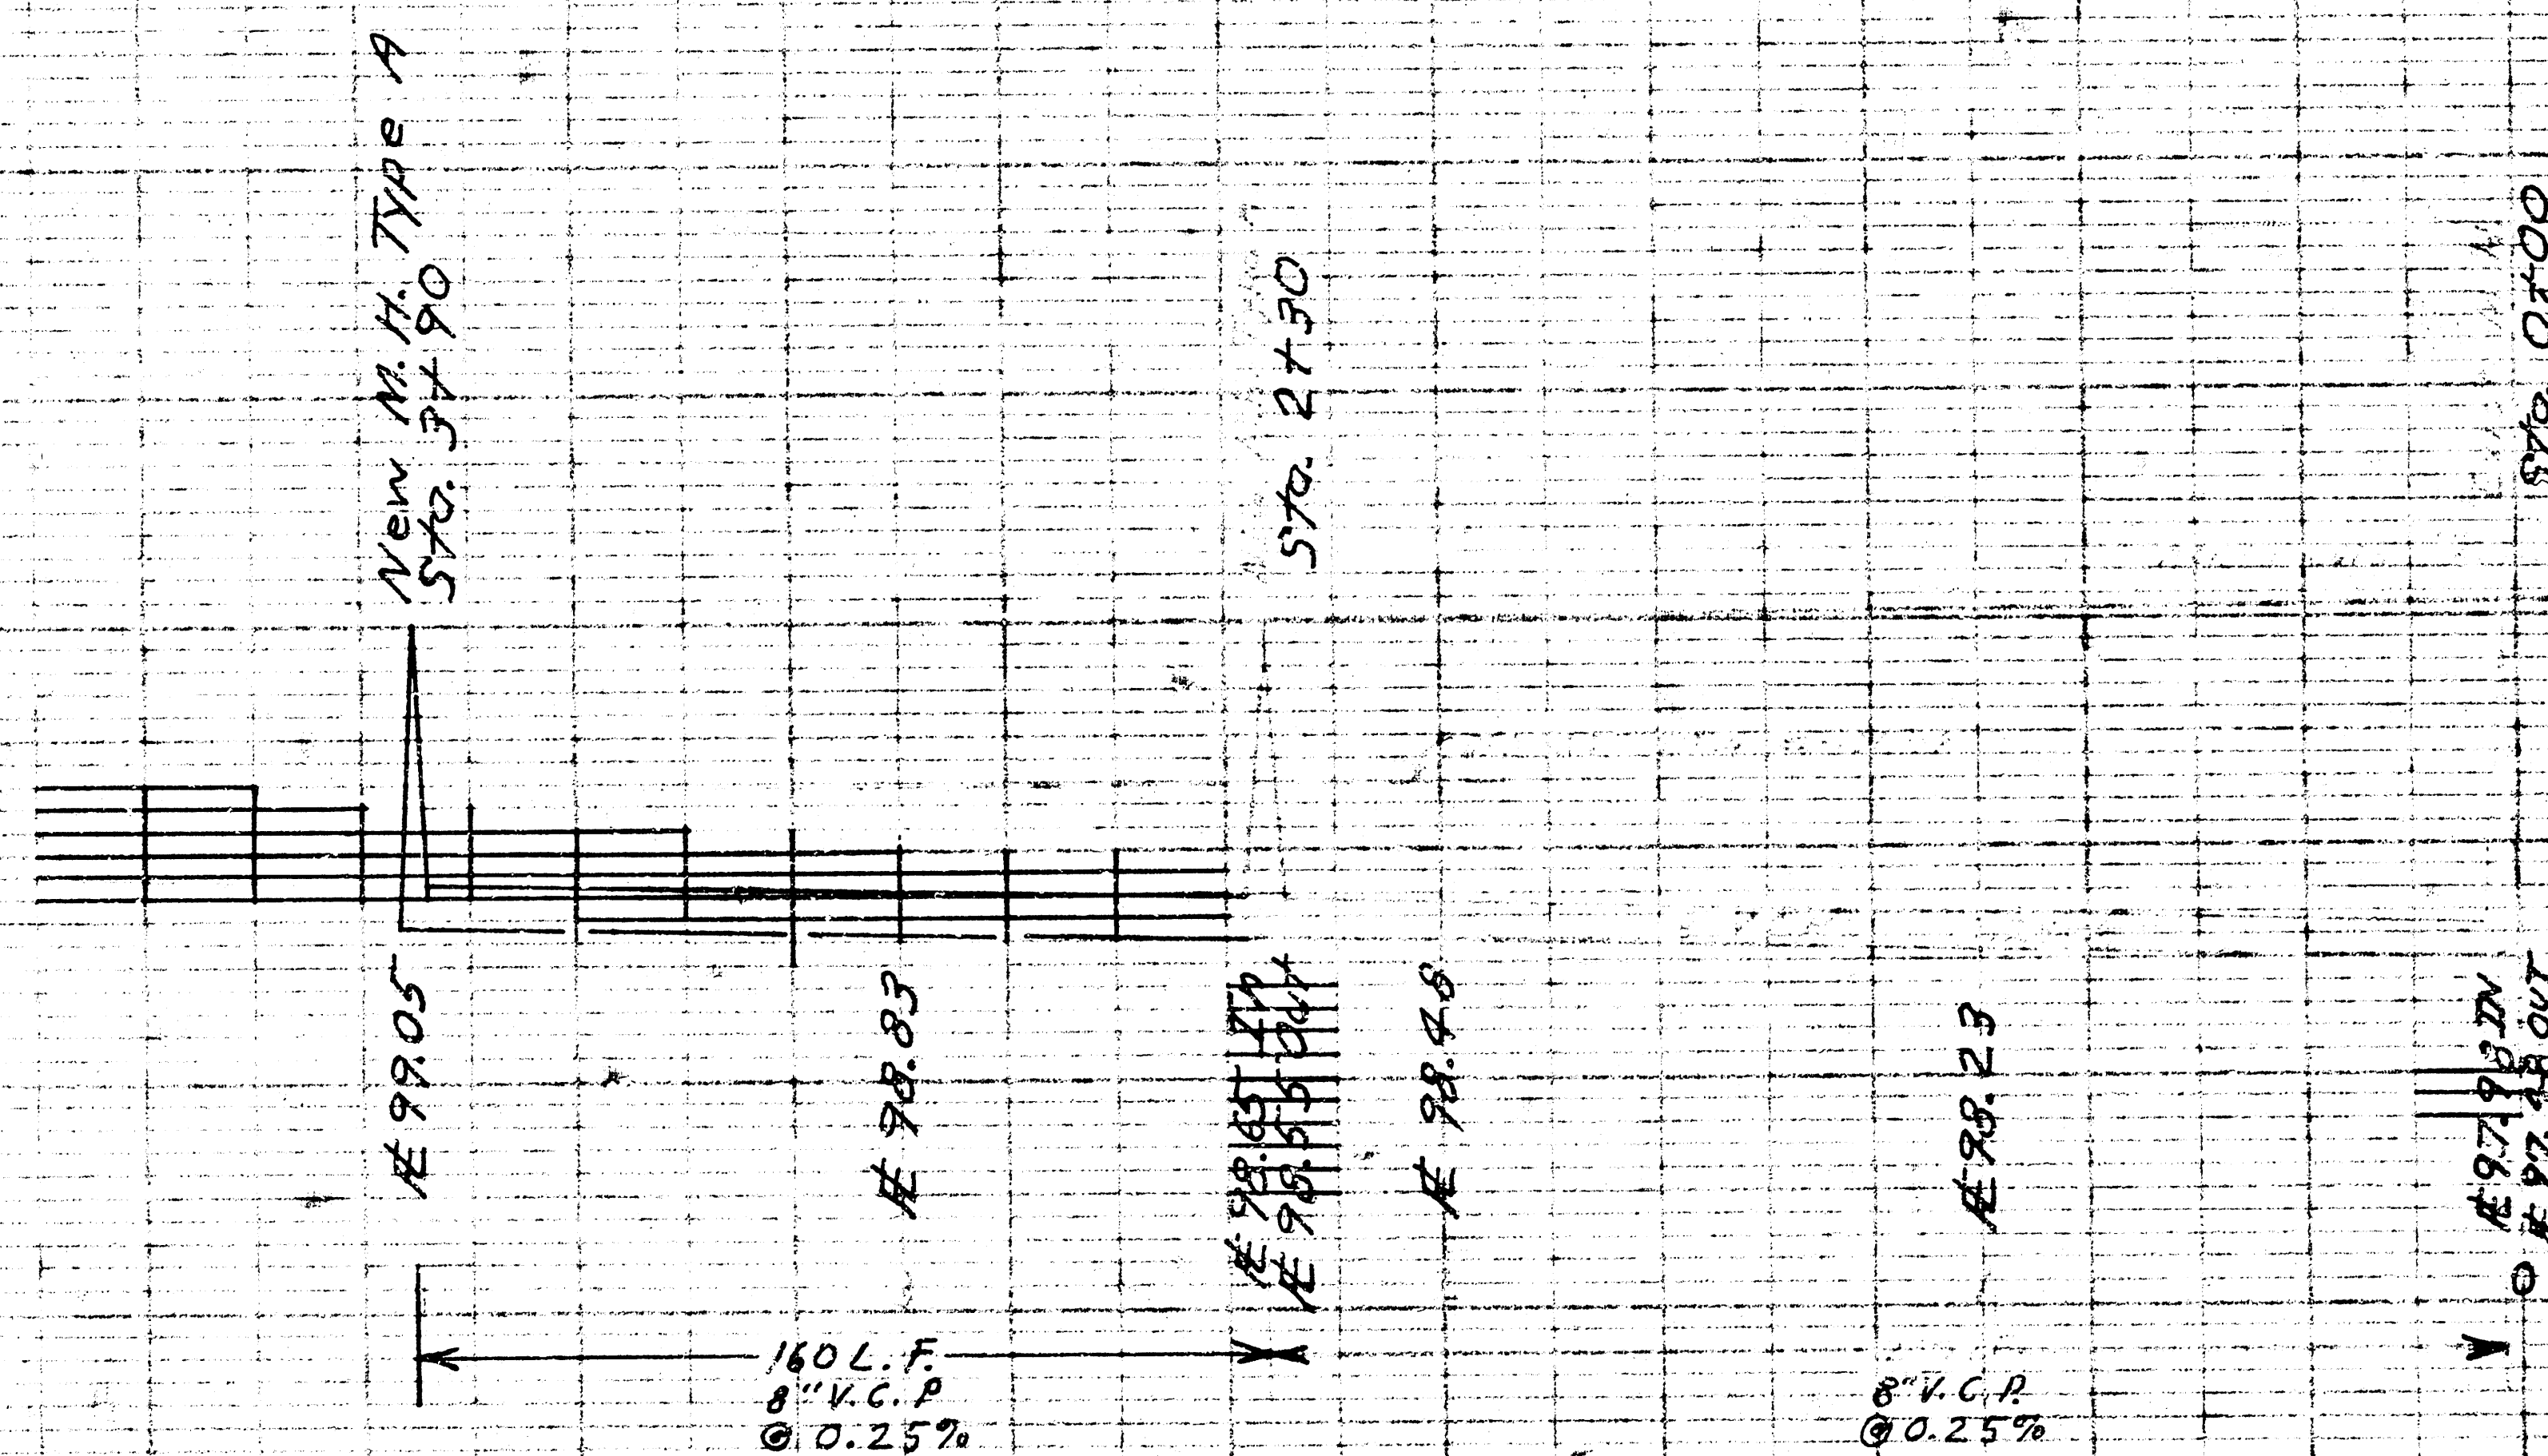

AS BUILT ELEV. MEASUREMENTS
SS, K-18