
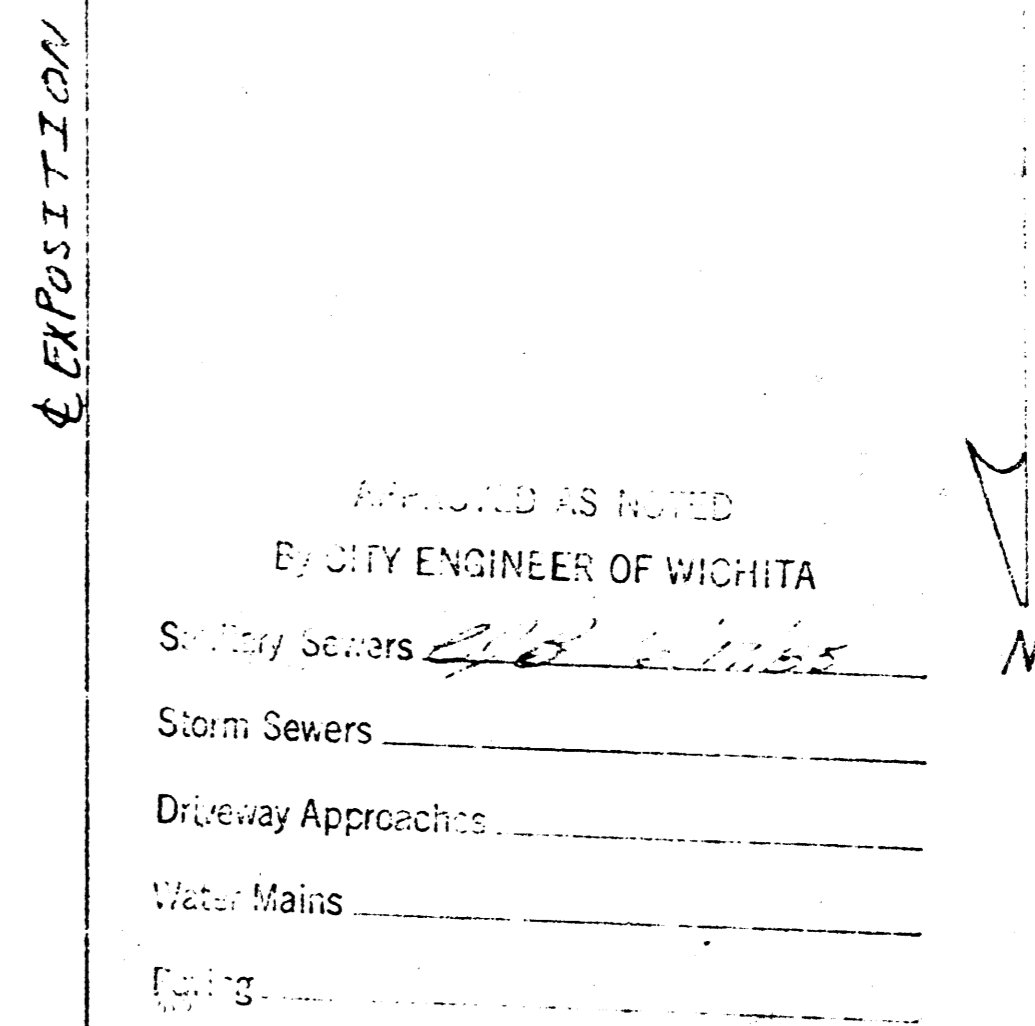
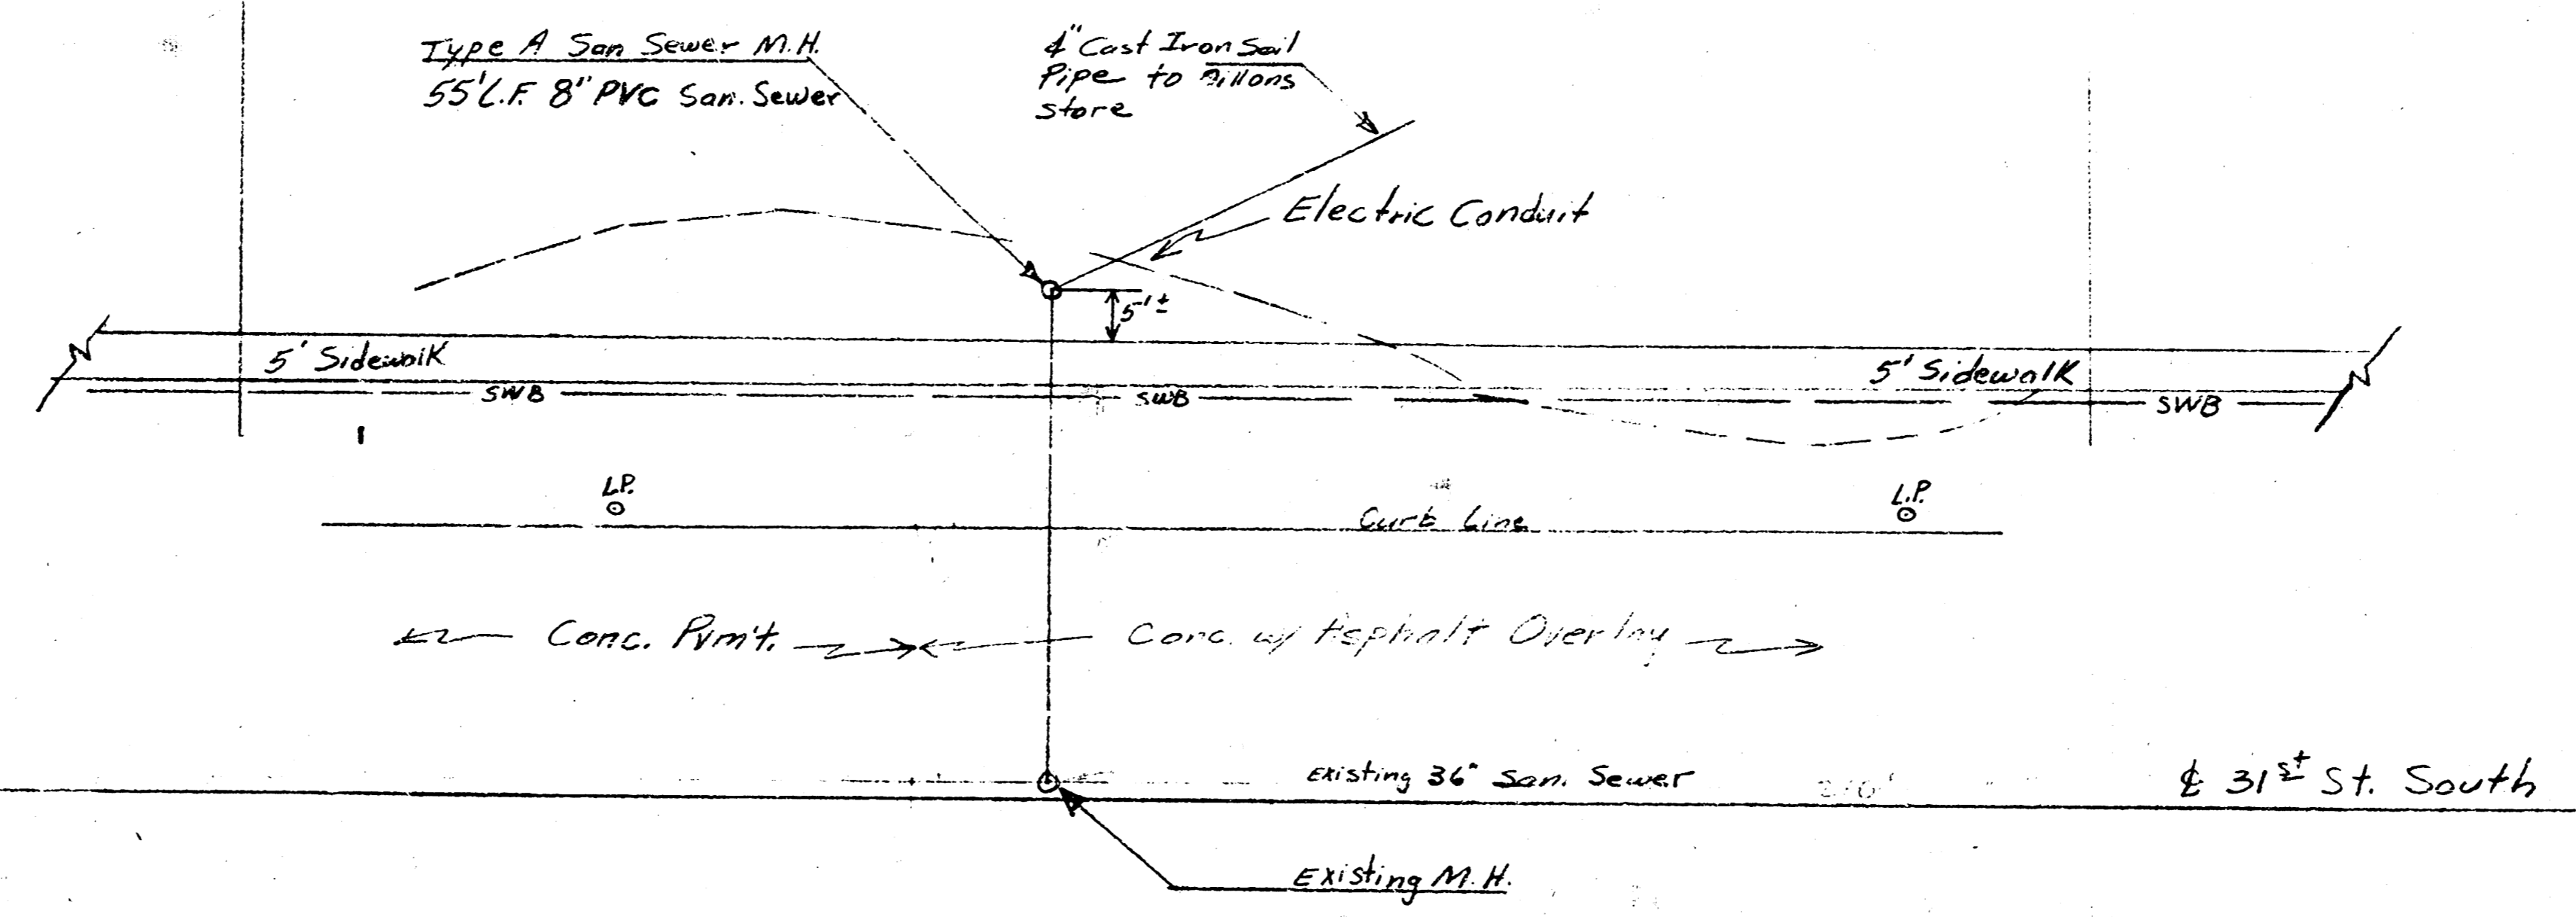


Project No. 468-76-245-80001-000-000-022

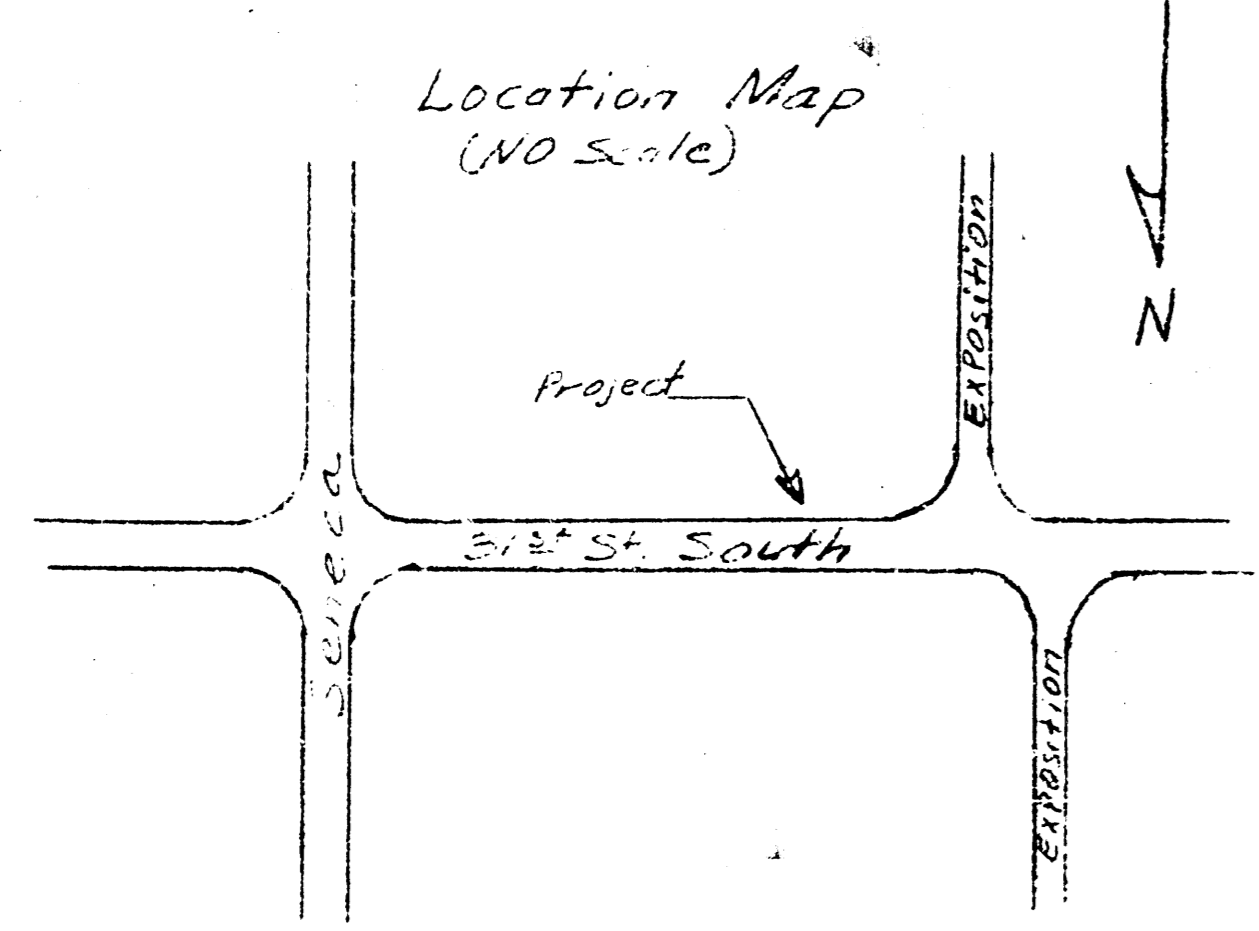


NOTE TO CONTRACTOR

This project will be constructed under the supervision of the CITY ENGINEER and conforming to the SPECIFICATIONS of the CITY OF WICHITA. The CONTRACTOR will pay the City of Wichita for all costs of plan review, inspection and backing per contract.

Scale:
1" = 60' Horizontal
1" = 8' Vertical

PLAN
SUBMITTED BY: _____
DATE: _____
NOTE BOOK NO. _____
DRAWING NUMBER: _____
BY: _____
CHECKED BY: _____
DATE: _____

PROFILE
SUBMITTED BY: _____
DATE: _____
NOTE BOOK NO. _____
DRAWING NUMBER: _____
BY: _____
CHECKED BY: _____
DATE: _____

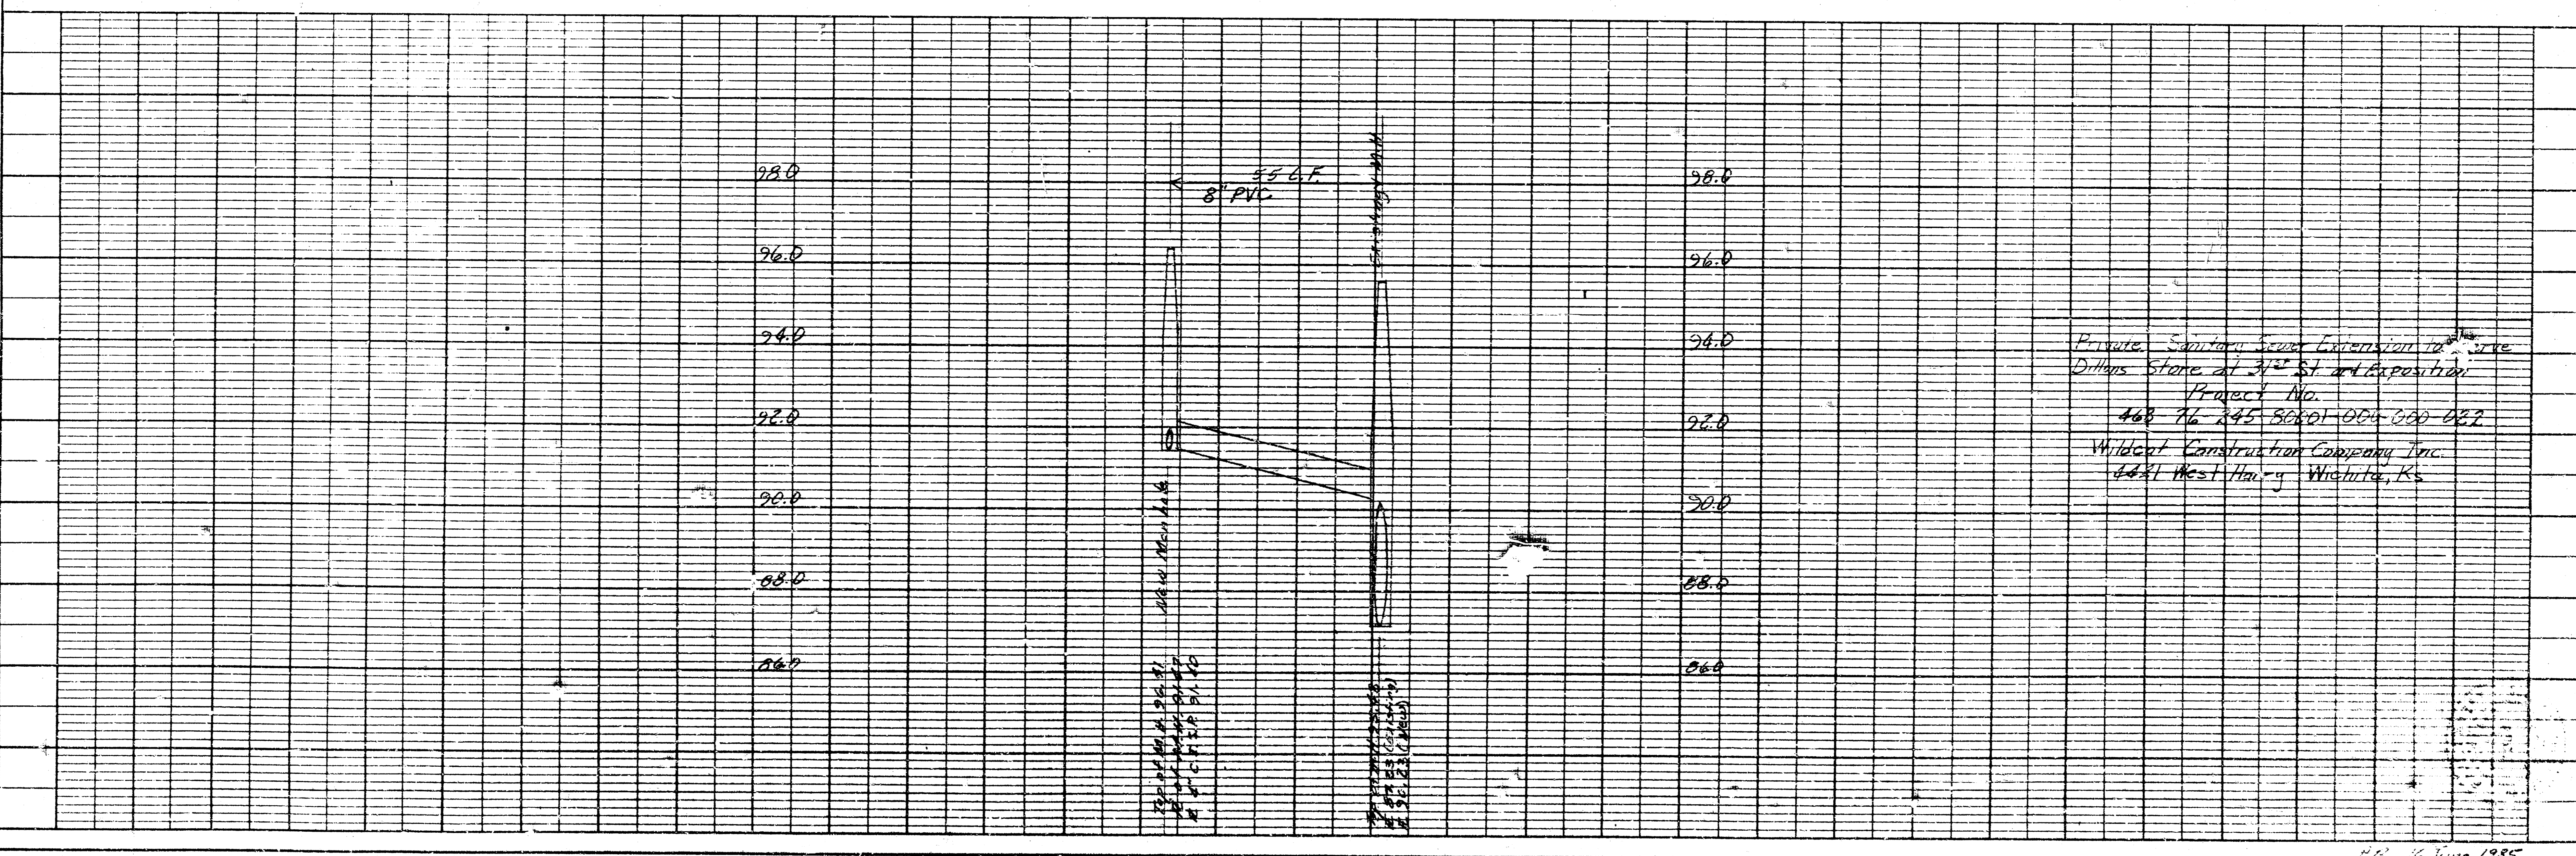

Private Sanitary Sewer Extension to Diltons Store at 31st St. and Exposition
Project No. 468-76-245-80001-000-000-022
Wildcat Construction Company Inc.
4421 West Henry, Wichita, Ks