
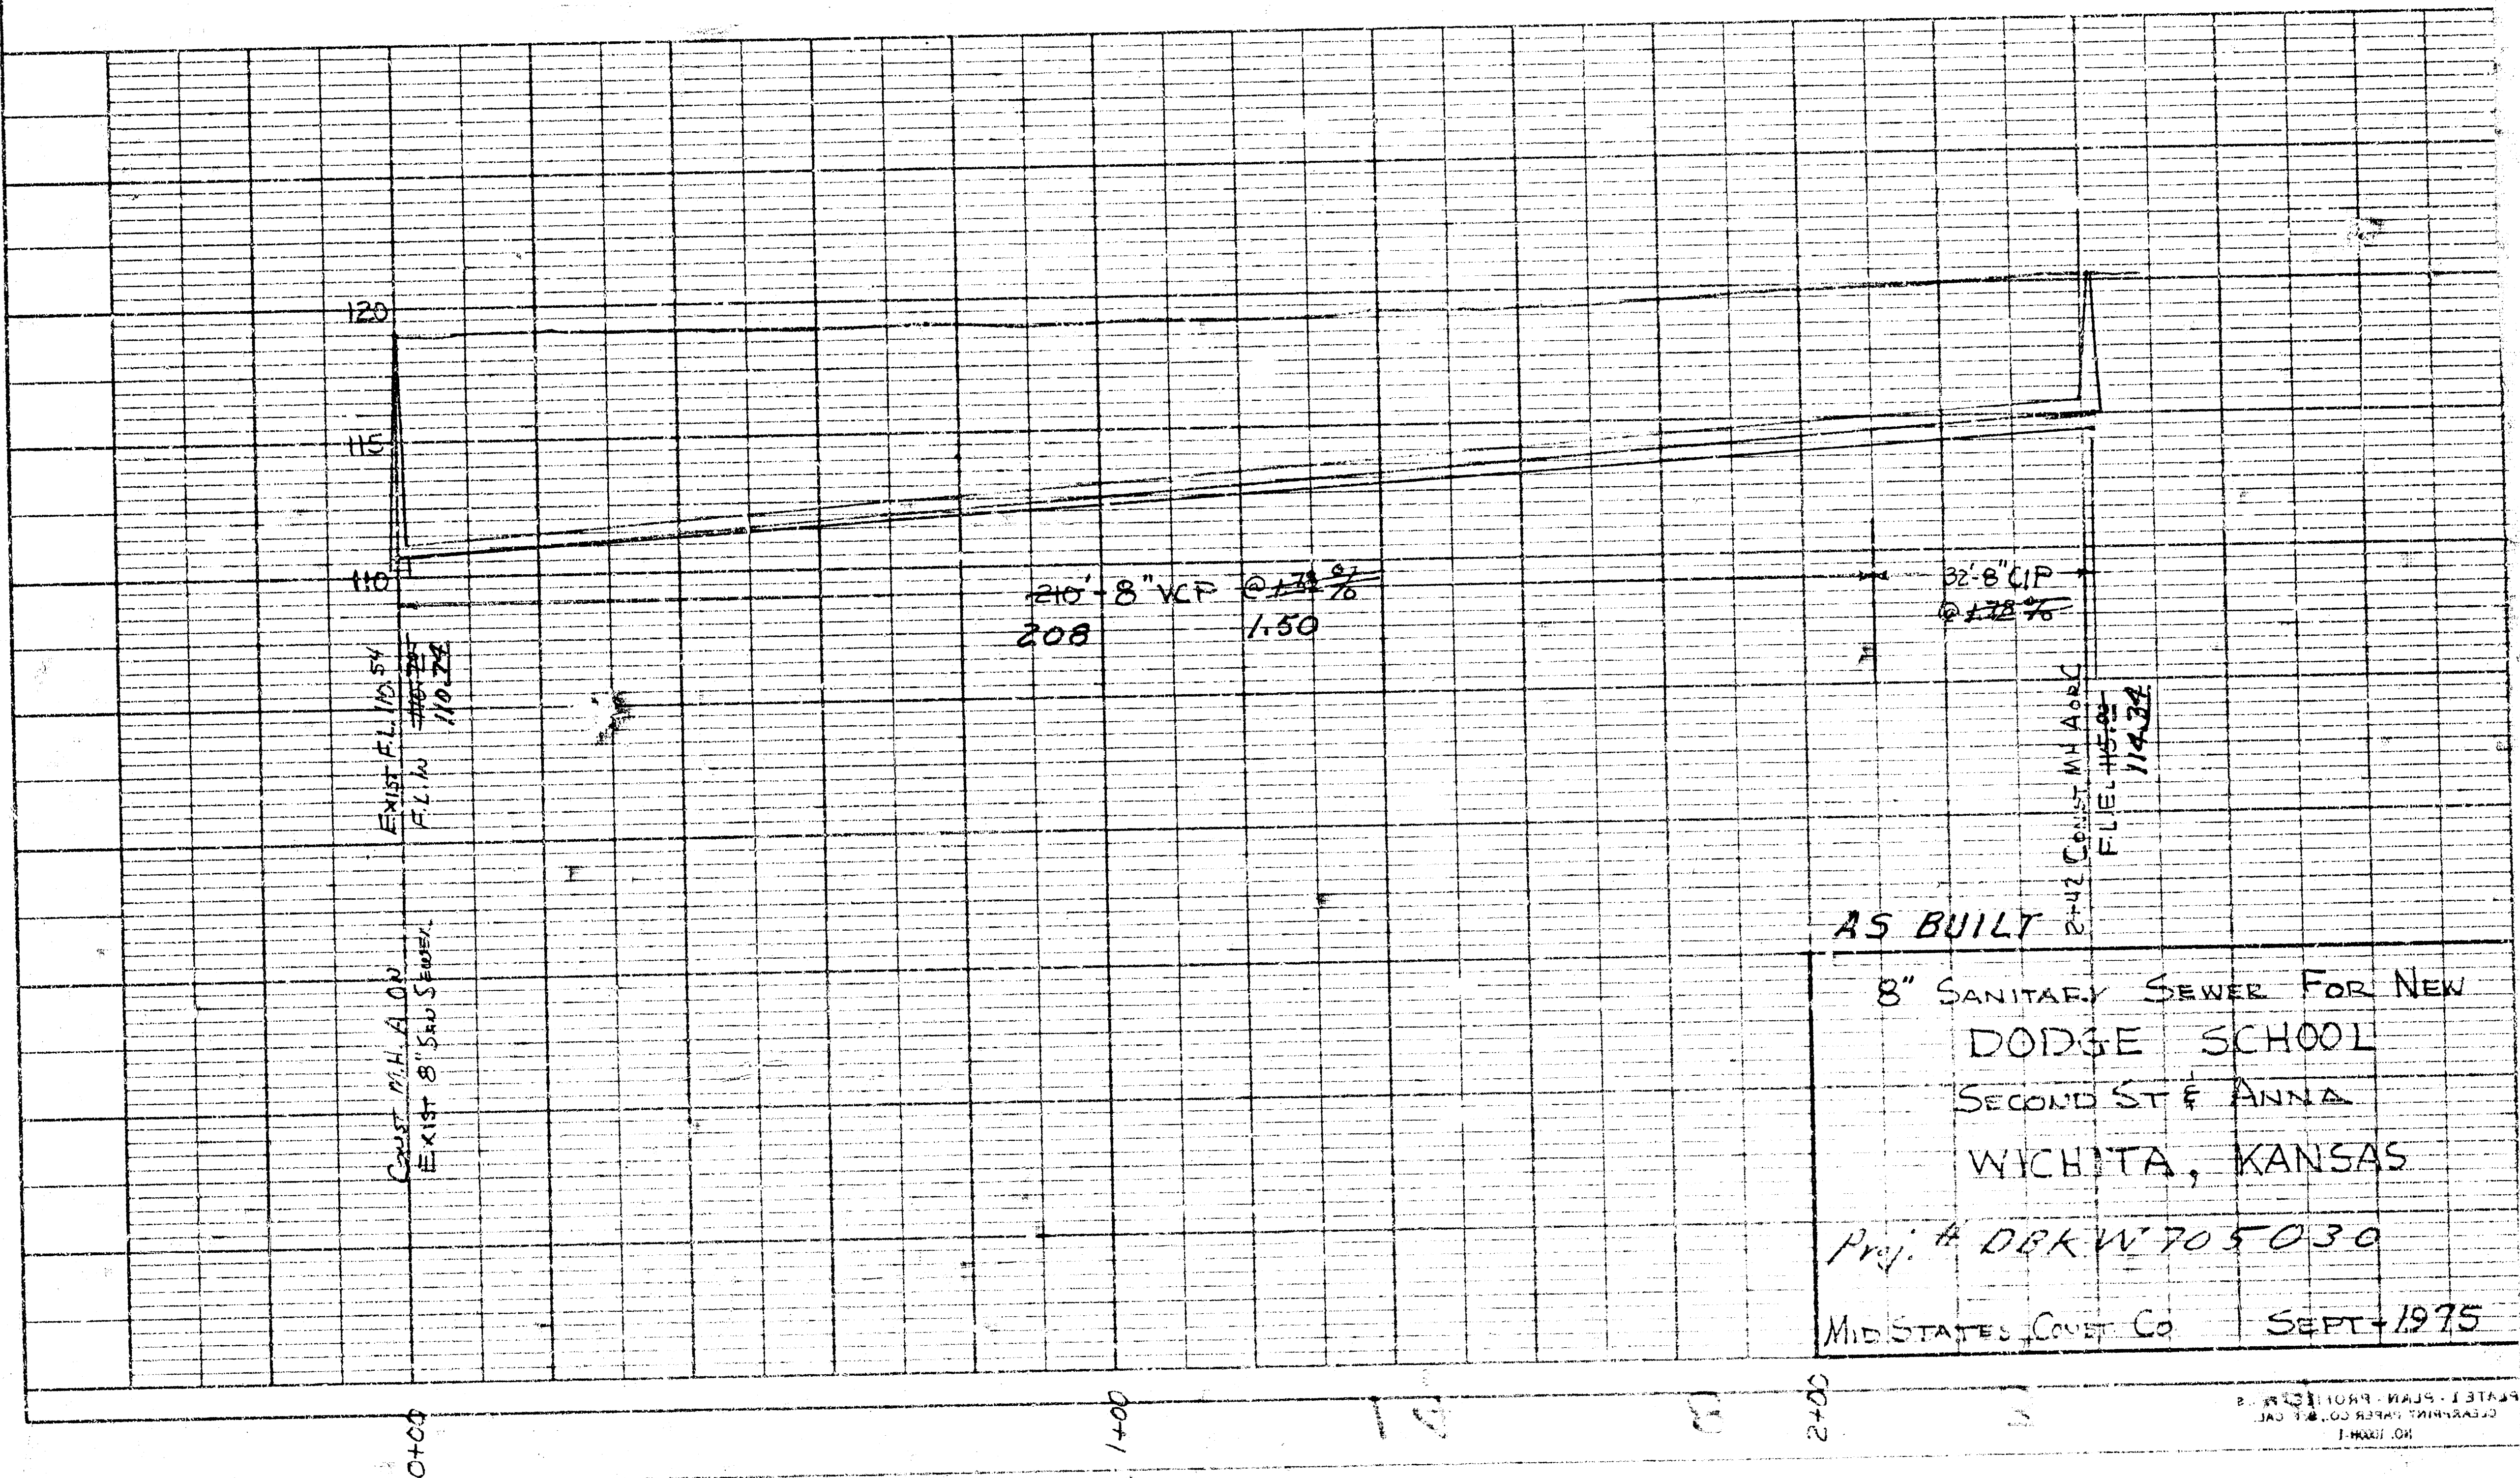


9-22-75
 APPROVED AS NOTED
 By CITY ENGINEER OF WICHITA
 Sanitary Sewers: D.E.S.
 Storm Sewers: _____
 Driveway Approaches: _____

NOTE TO CONTRACTOR
 This project will be constructed under the supervision of the CITY ENGINEER and conforming to the SPECIFICATIONS of the CITY OF WICHITA. The CONTRACTOR will reimburse the City of Wichita for all costs of Engineering, Study, and Inspection.

WYES
 0+59 E 6"
 1+10 W 4"
 1+67 E 6"
 2+05 W 6"

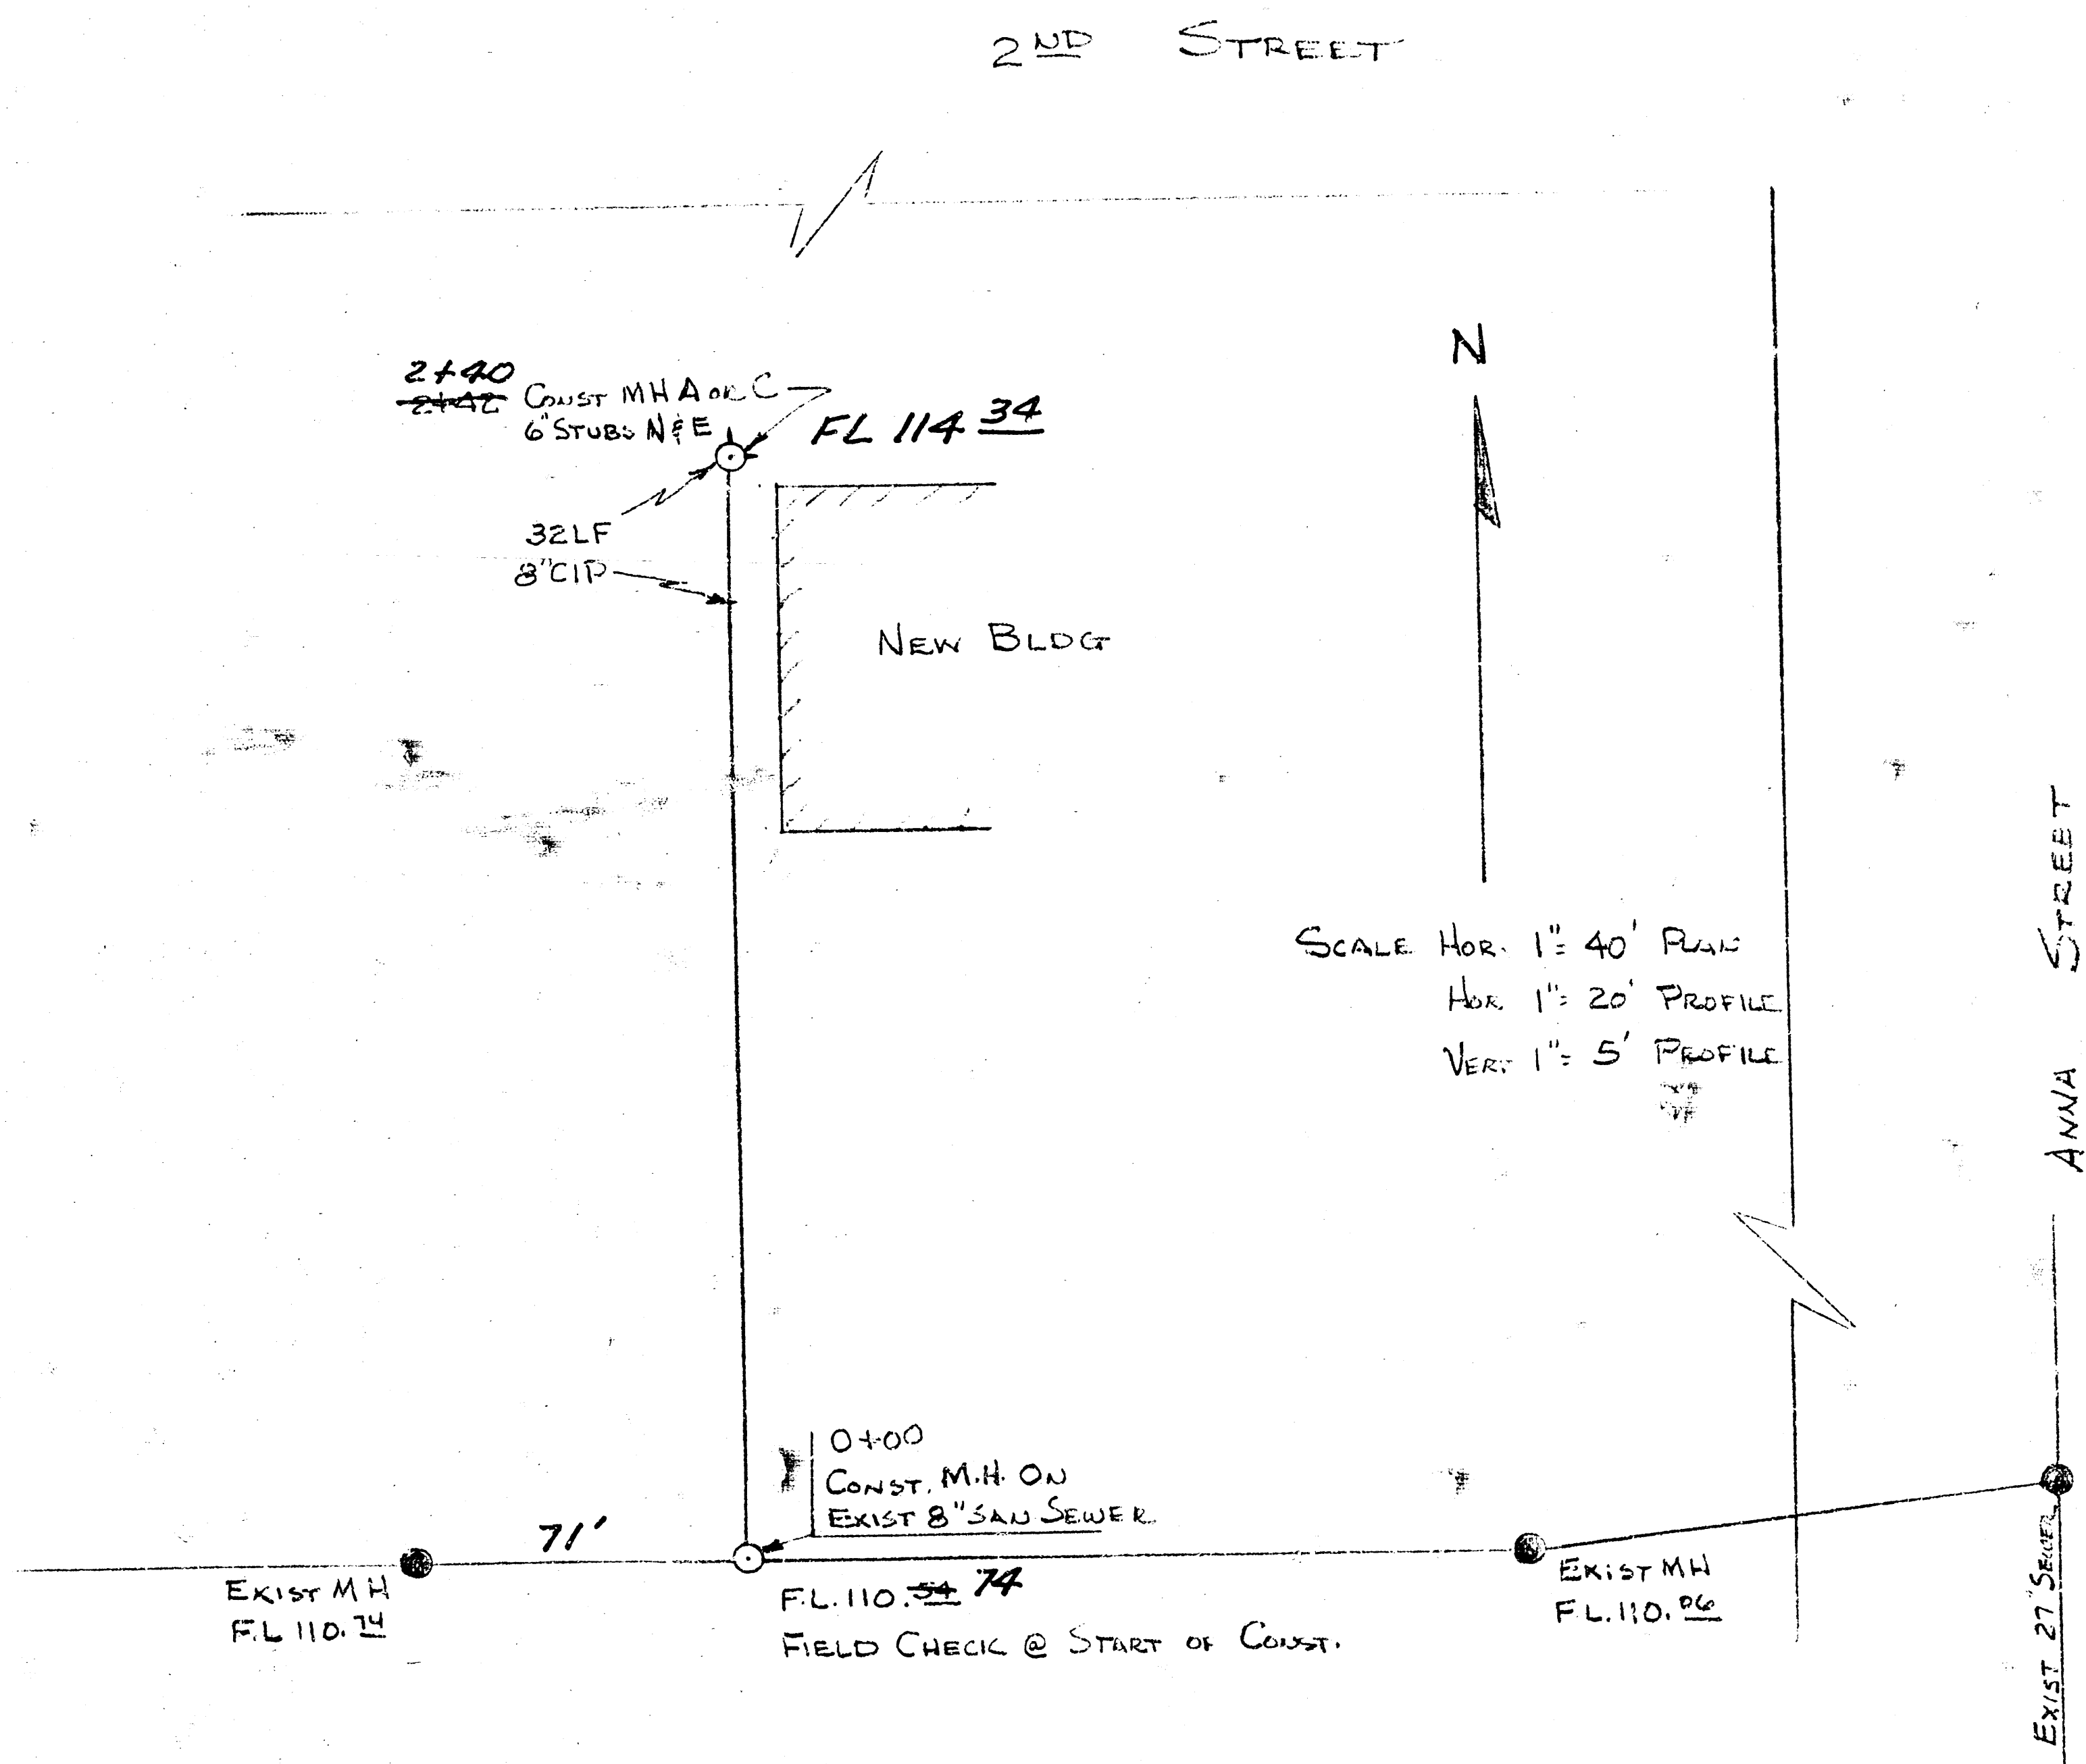

AS BUILT
 8" SANITARY SEWER FOR NEW
 DODGE SCHOOL
 SECOND ST & ANNA
 WICHITA, KANSAS
 Proj. # DRK W 705030
 MID STATES CONST CO SEPT 1975

8" SANITARY SEWER FOR NEW
 DODGE SCHOOL
 SECOND ST & ANNA
 WICHITA, KANSAS
 Proj. # DRK W 705030
 MID STATES CONST CO SEPT 1975