



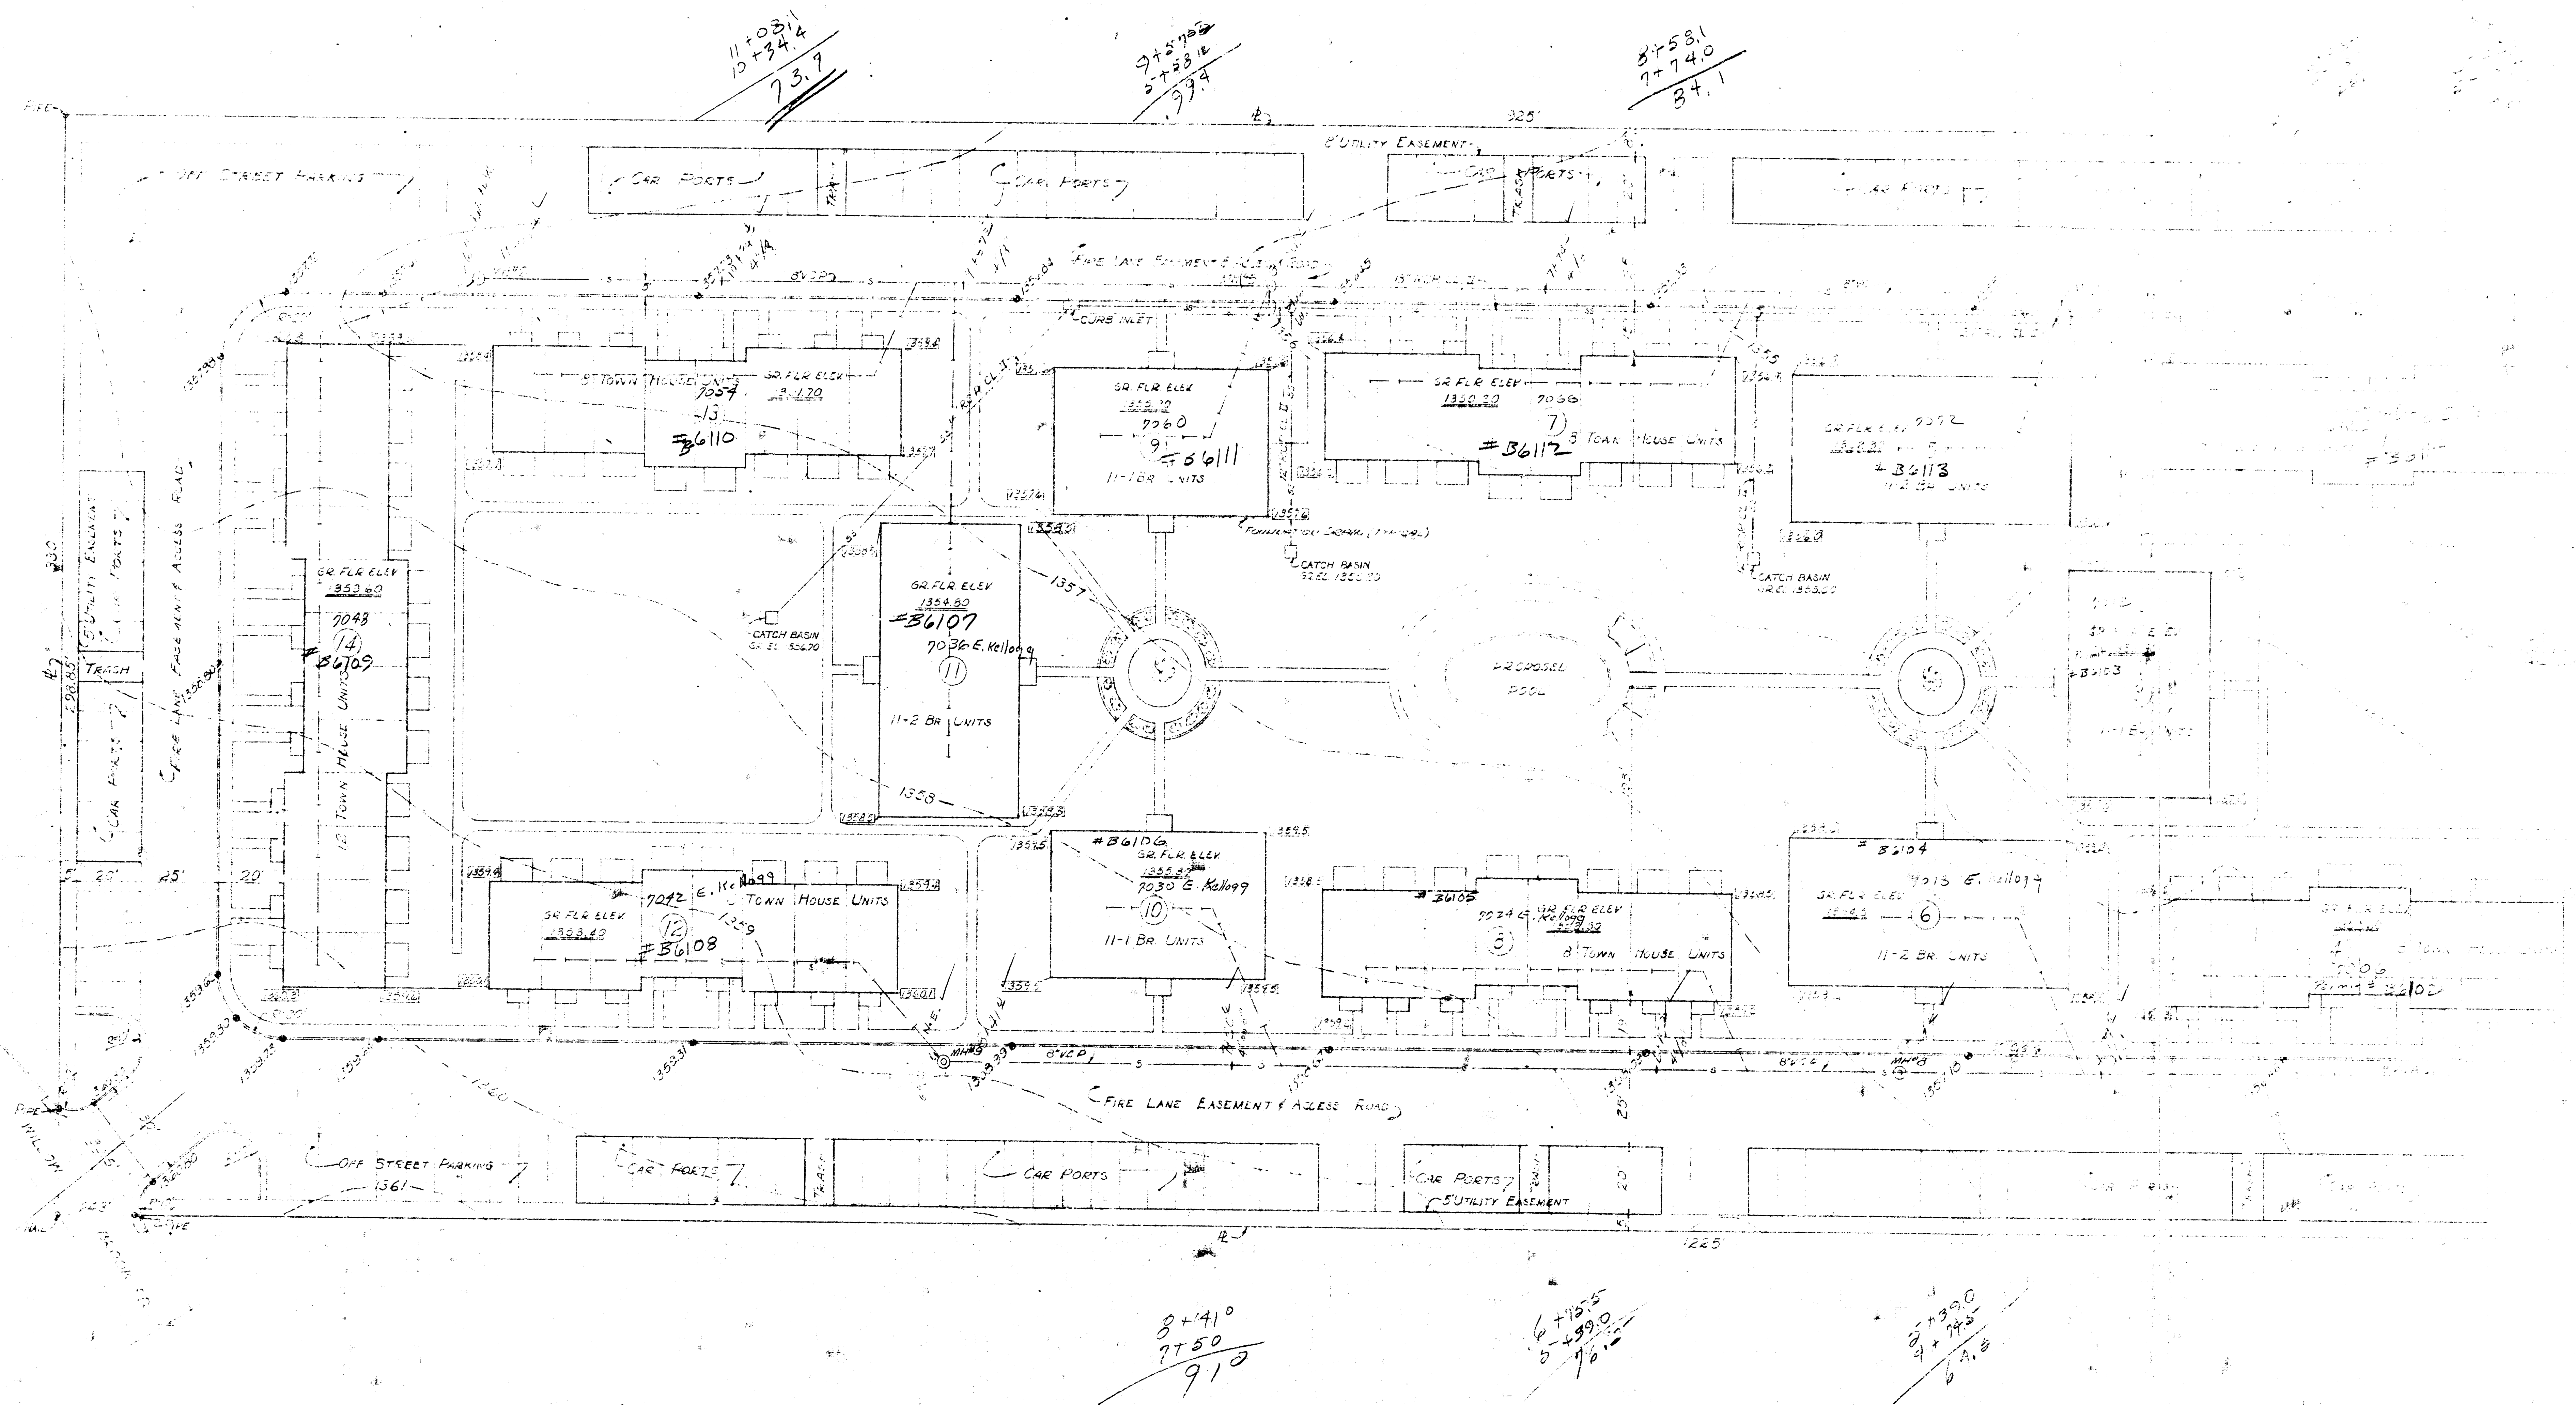

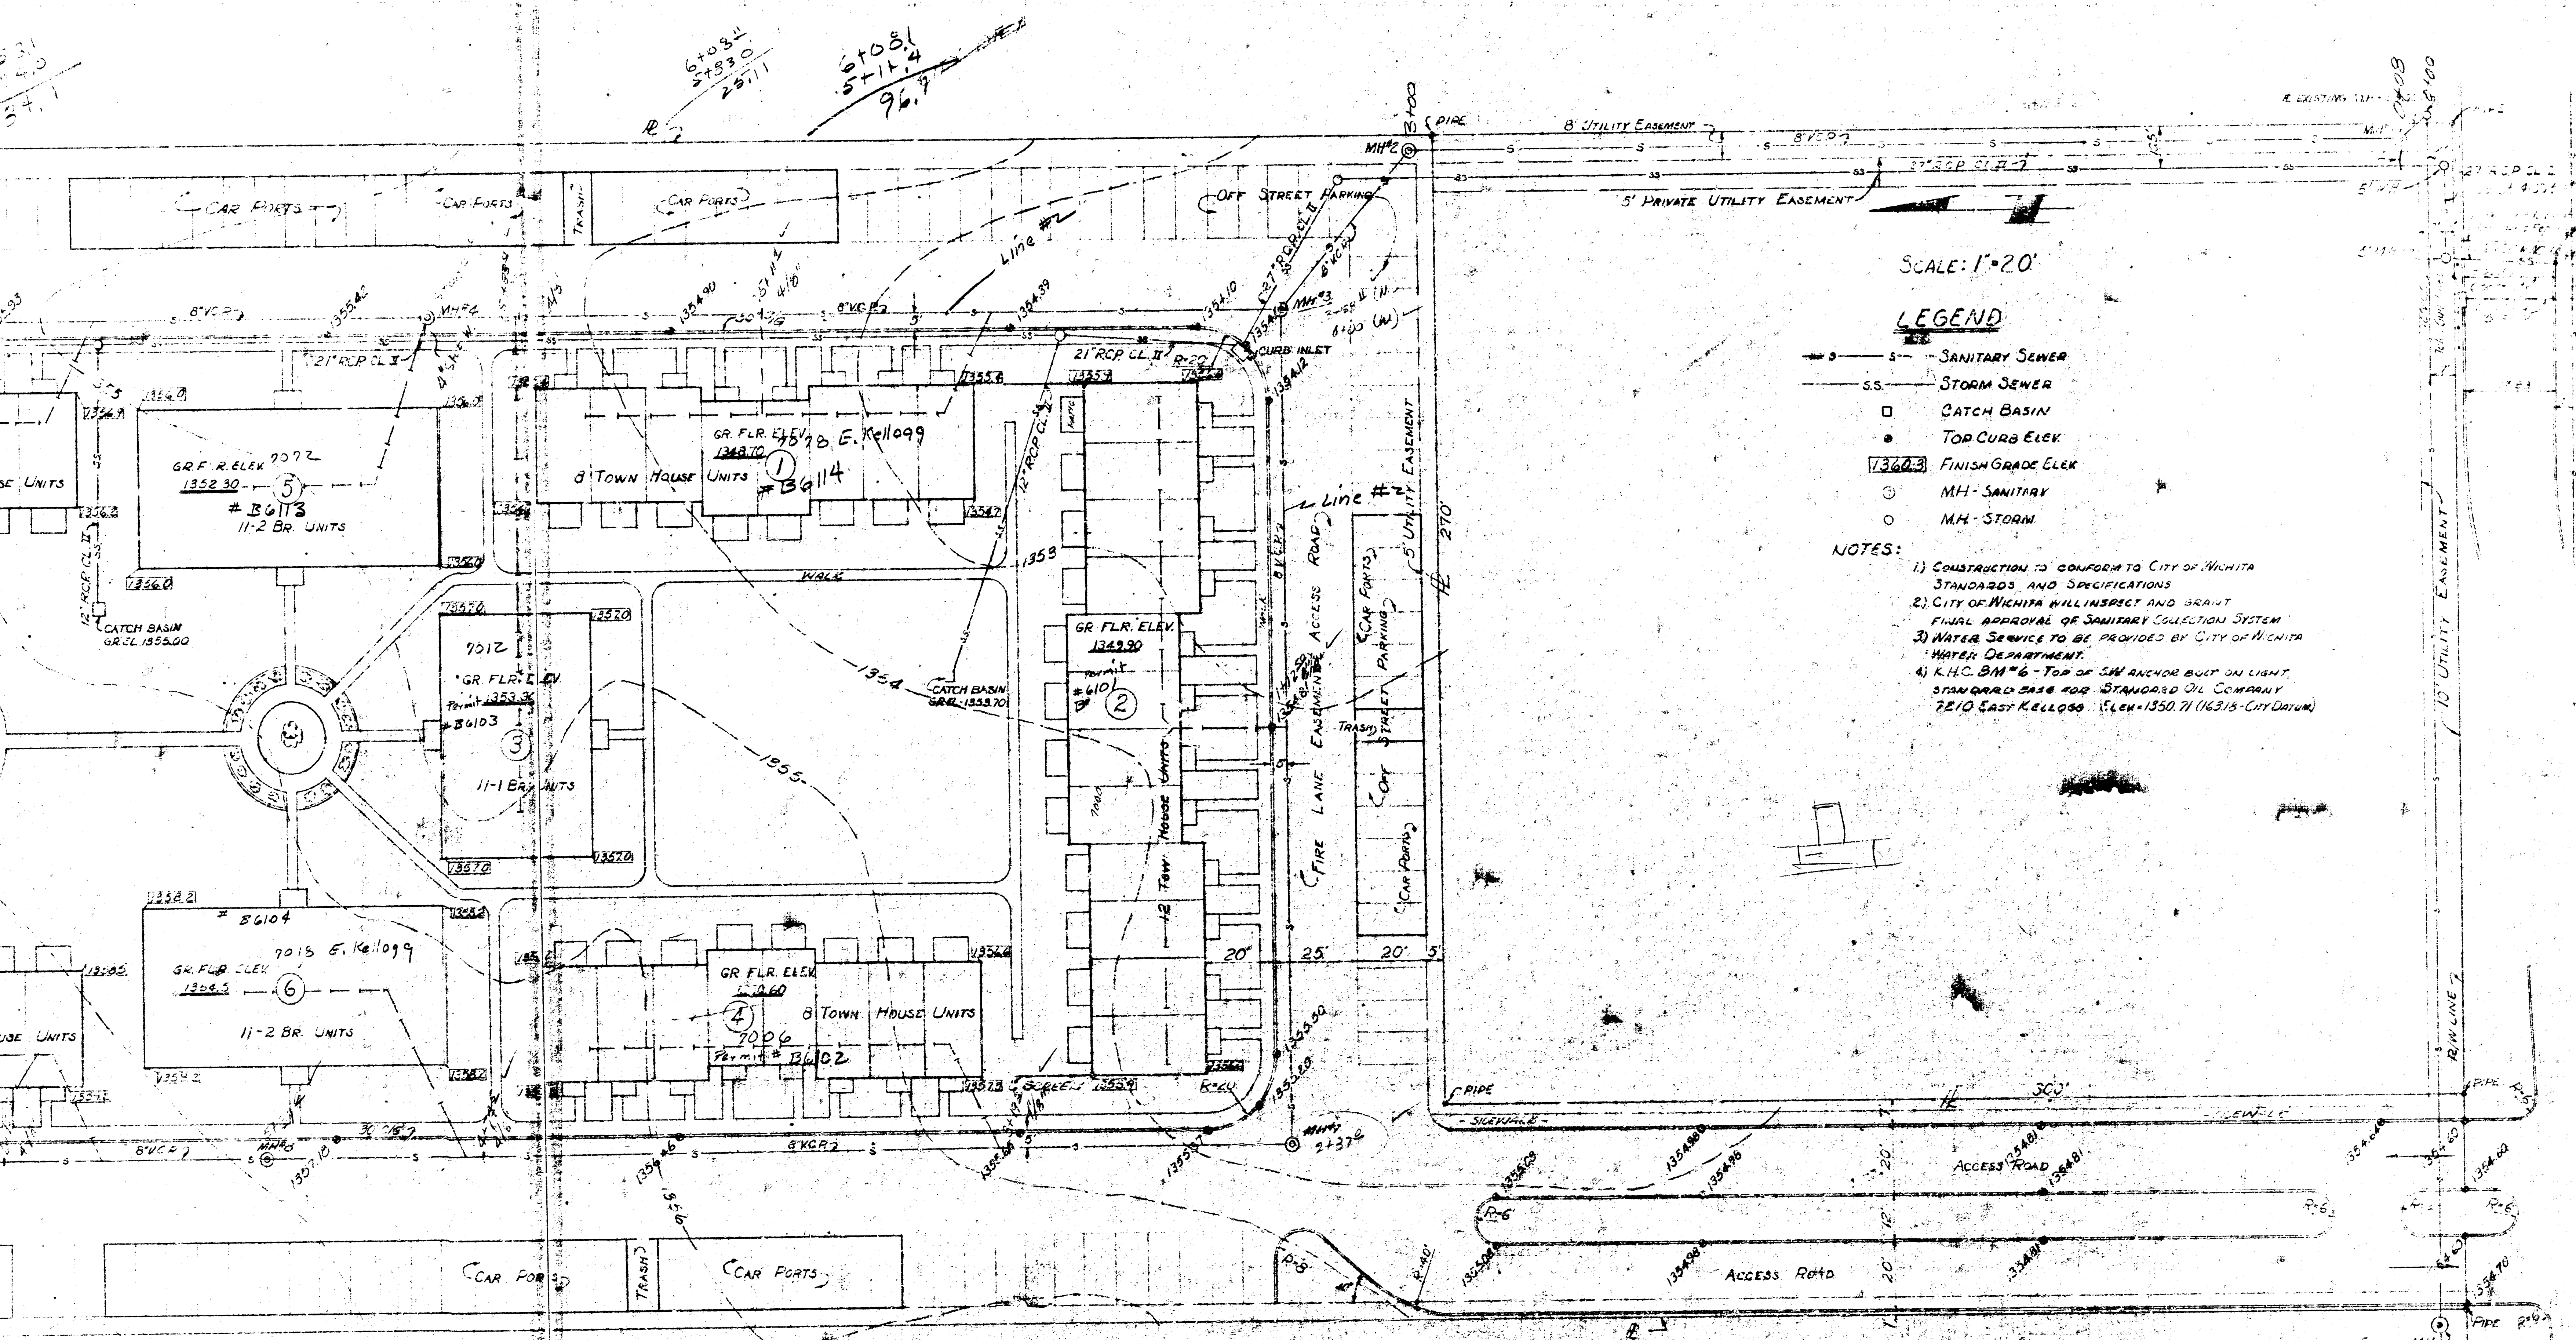

SCALE: 1"=20'

LEGEND

- S — SANITARY SEWER
- SS — STORM SEWER
- CATCH BASIN
- TOP CURB ELEV
- 1360.3 FINISH GRADE ELEV
- MH - SANITARY
- MH - STORM


NOTES:



- 1) CONSTRUCTION TO CONFORM TO CITY OF WICHITA STANDARDS AND SPECIFICATIONS
- 2) CITY OF WICHITA WILL INSPECT AND GRANT FINAL APPROVAL OF SANITARY COLLECTION SYSTEM
- 3) WATER SERVICE TO BE PROVIDED BY CITY OF WICHITA WATER DEPARTMENT
- 4) K.H.C. BM #6 - TOP OF SW ANCHOR BUILT ON LIGHT STANDARD DATA FOR STANDARD OIL COMPANY 7210 EAST KELLOGG (ELEV=1350.71 (16316 - CITY DATUM))


CITY OF WICHITA
APPROVED AS NOTED
By CITY ENGINEER OF WICHITA
Sanitary Engineer
Sharon Seiden
Ordinary Approval



NOTE TO CONTRACTOR
This project will be constructed on the supervision of the CITY ENGINEER and conforming to the SPECIFICATIONS of the CITY OF WICHITA. The CONTRACTOR will reimburse the City of Wichita for all cost of engineering and inspection.


EASTBOROUGH APARTMENTS
WICHITA KANSAS
PLOT PLAN
PROFESSIONAL ENGINEERING
CONSULTANTS
309 LAURA WICHITA, KANS
DRAWN BY ESR LK2 BE JCE

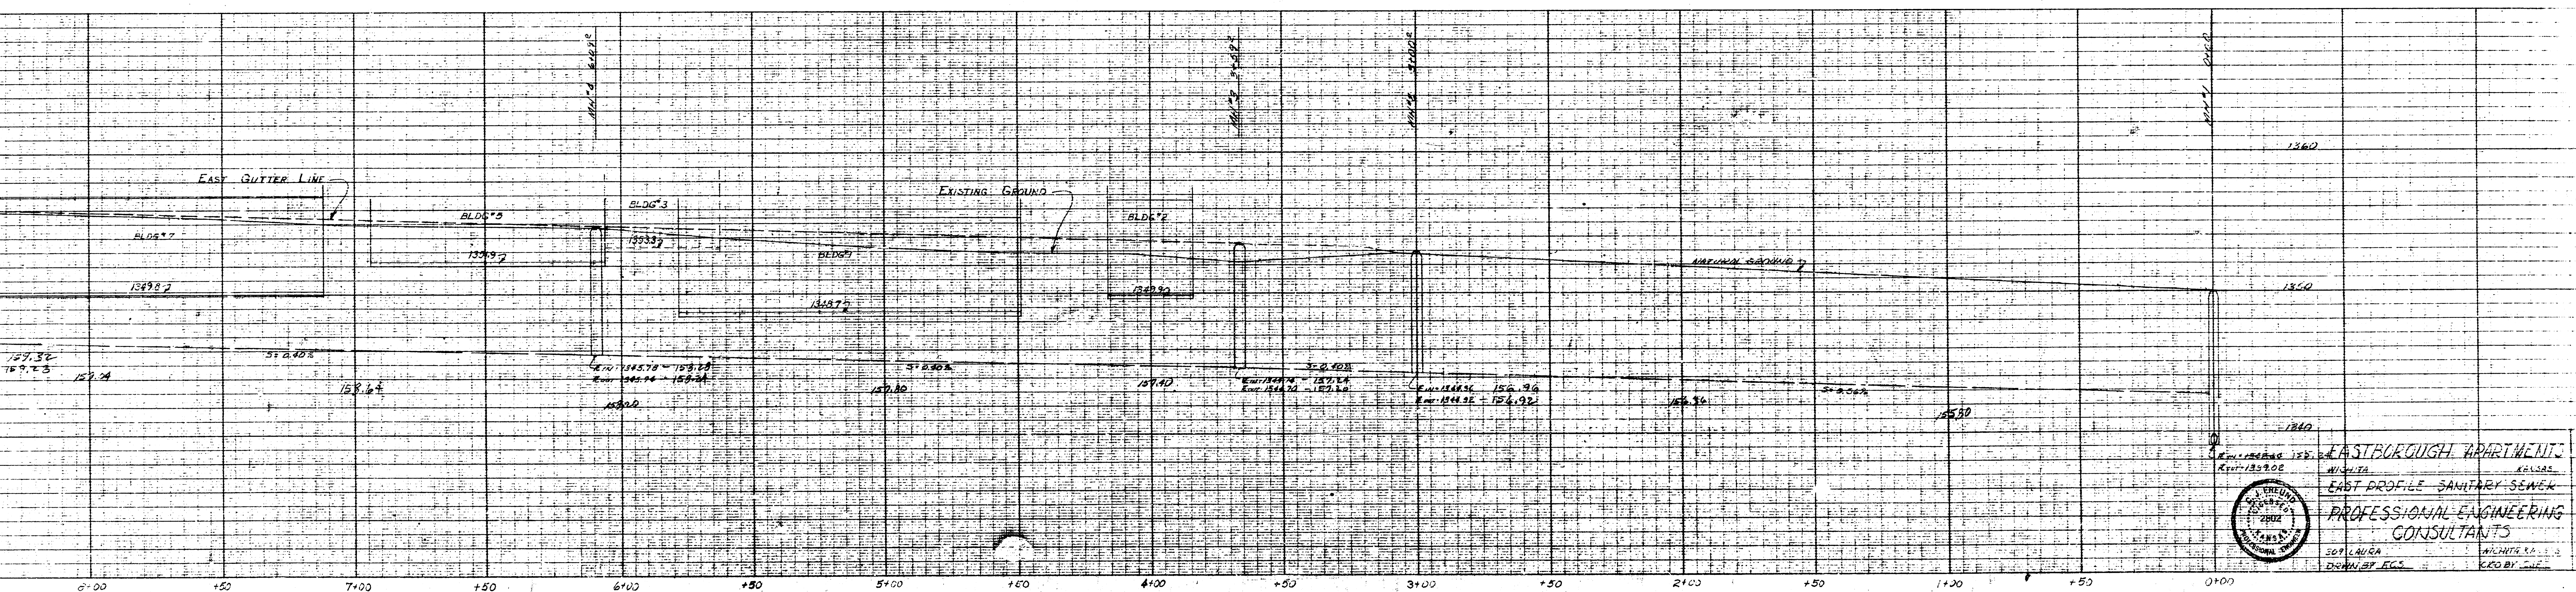

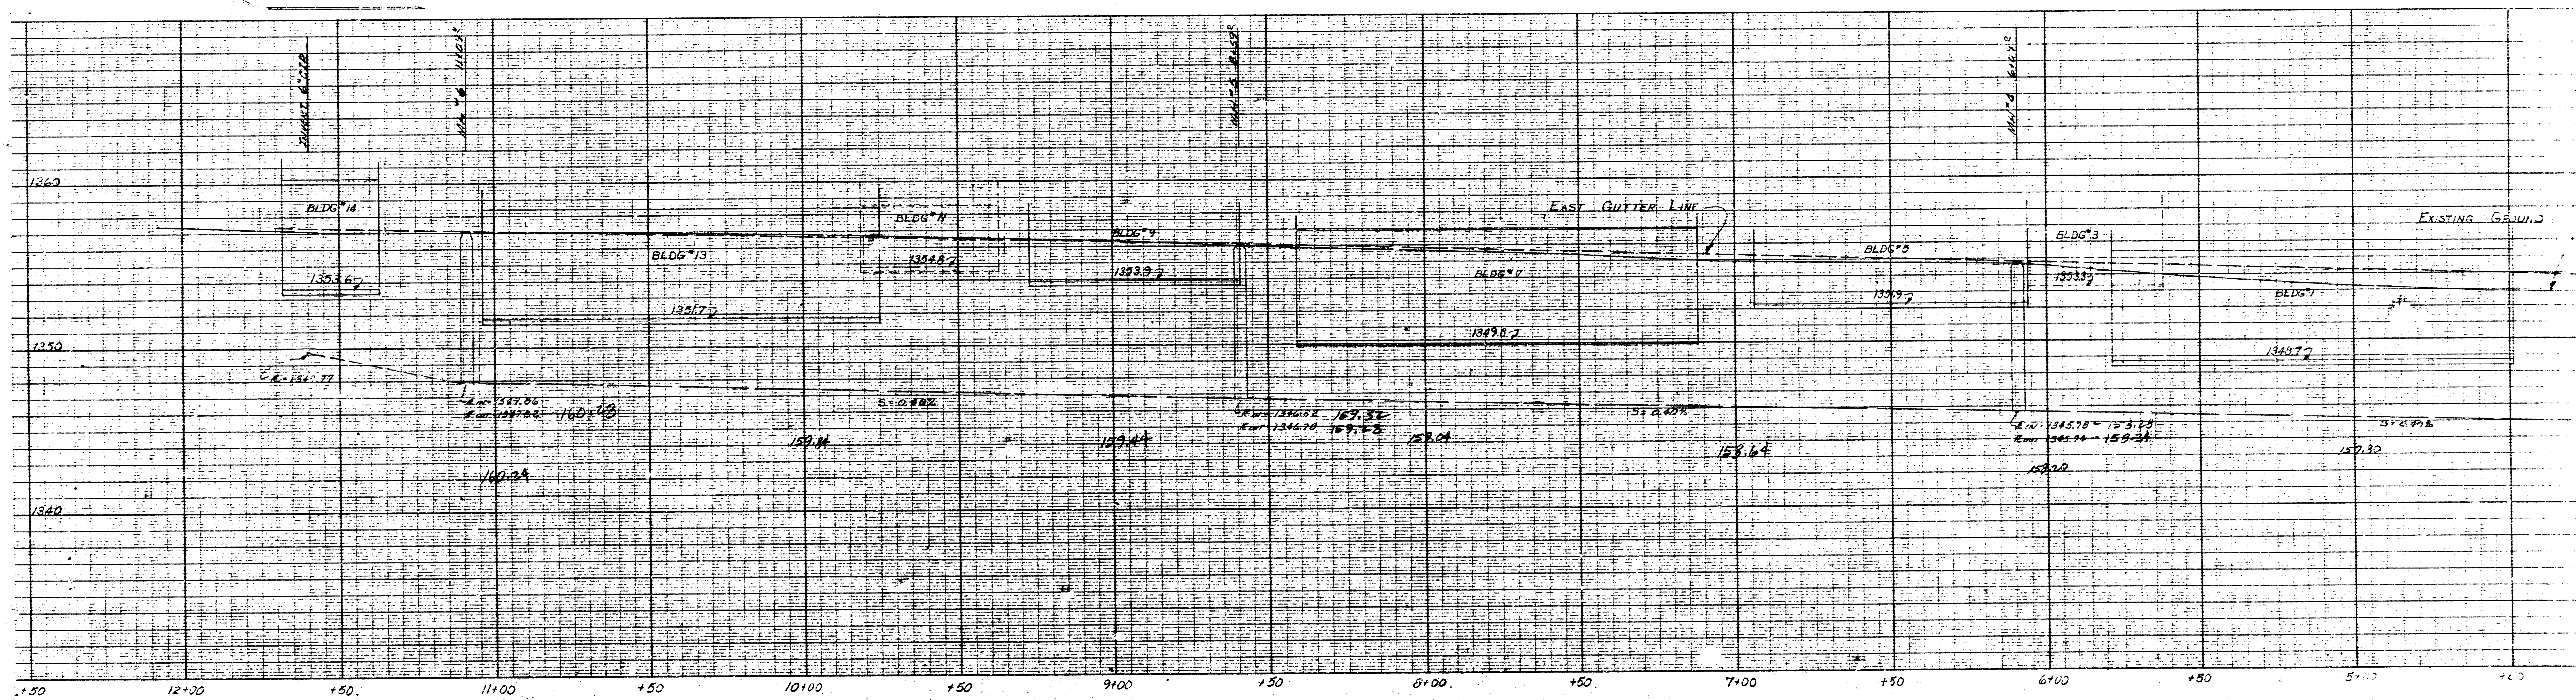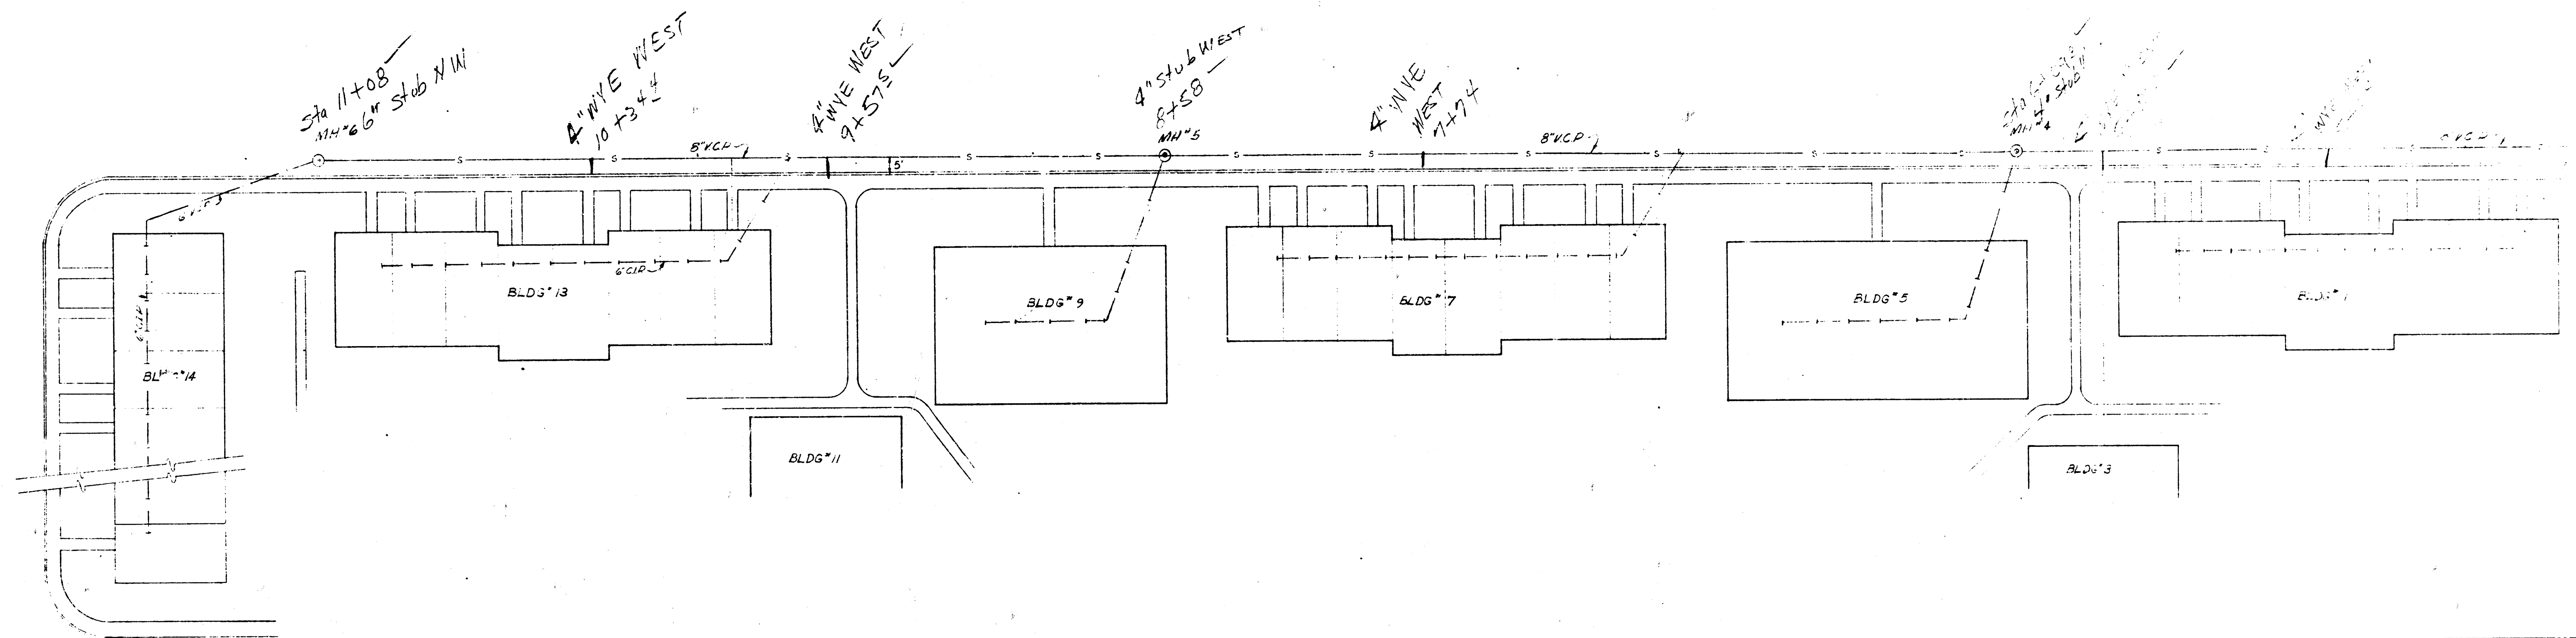

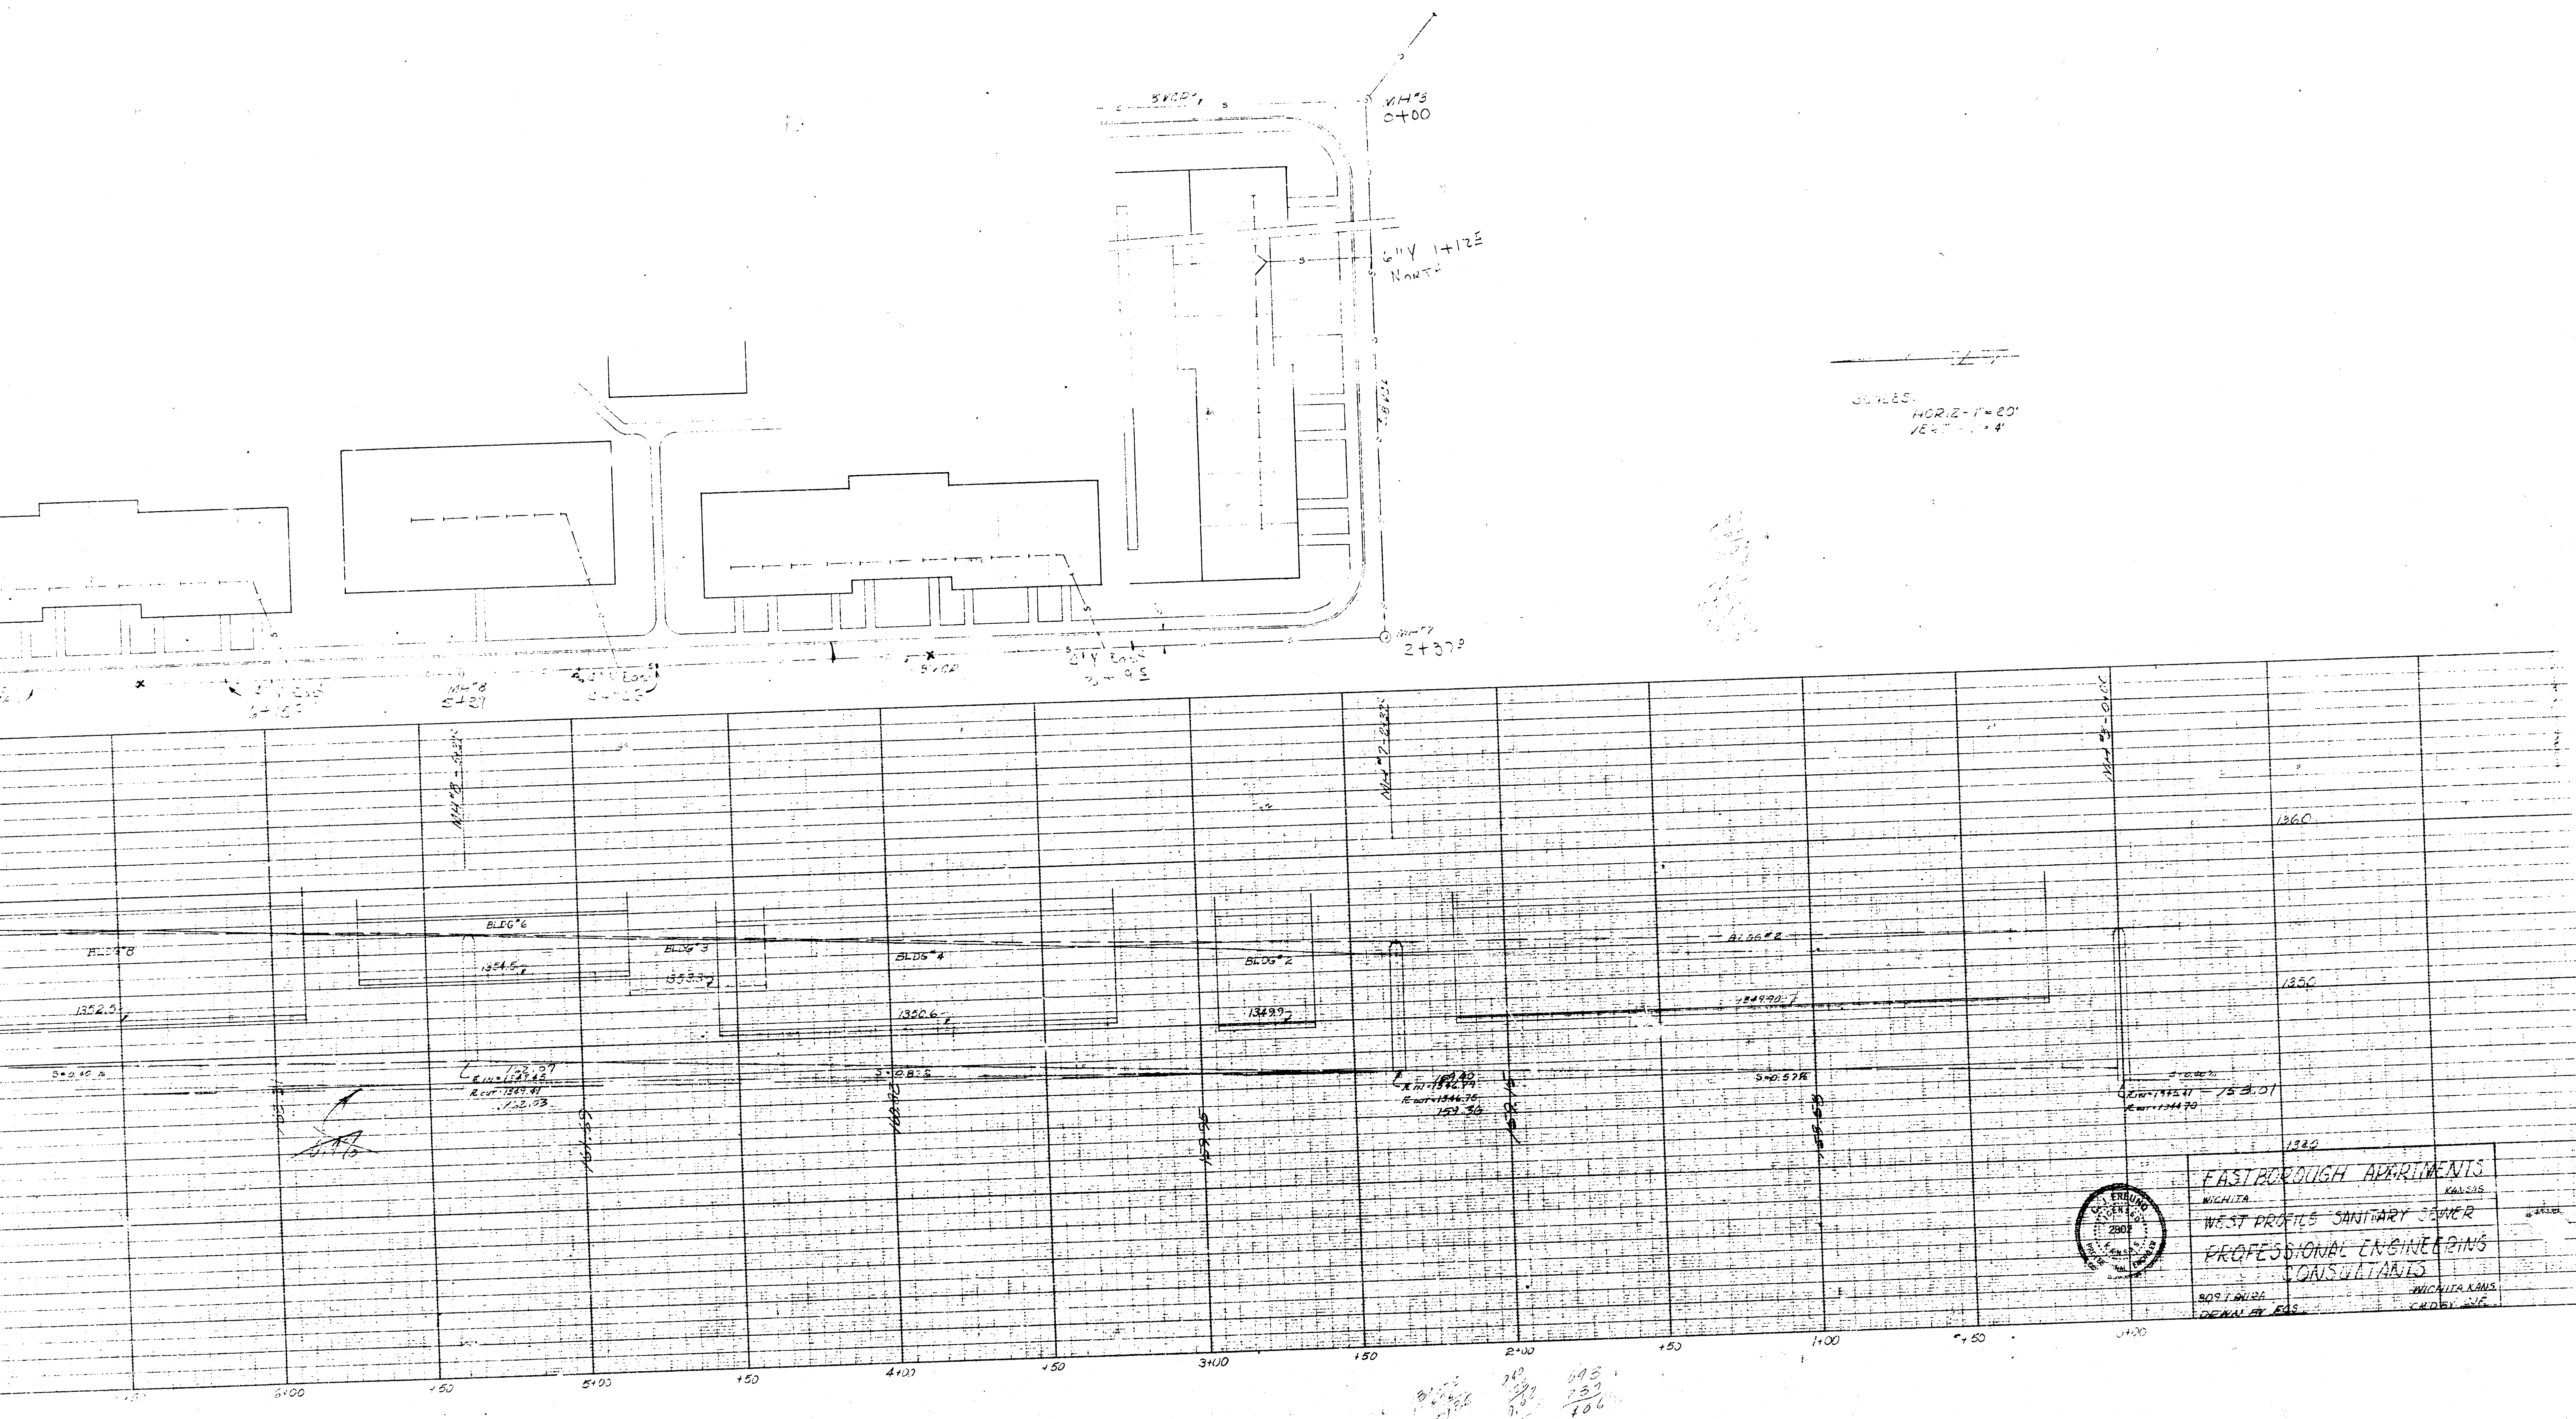

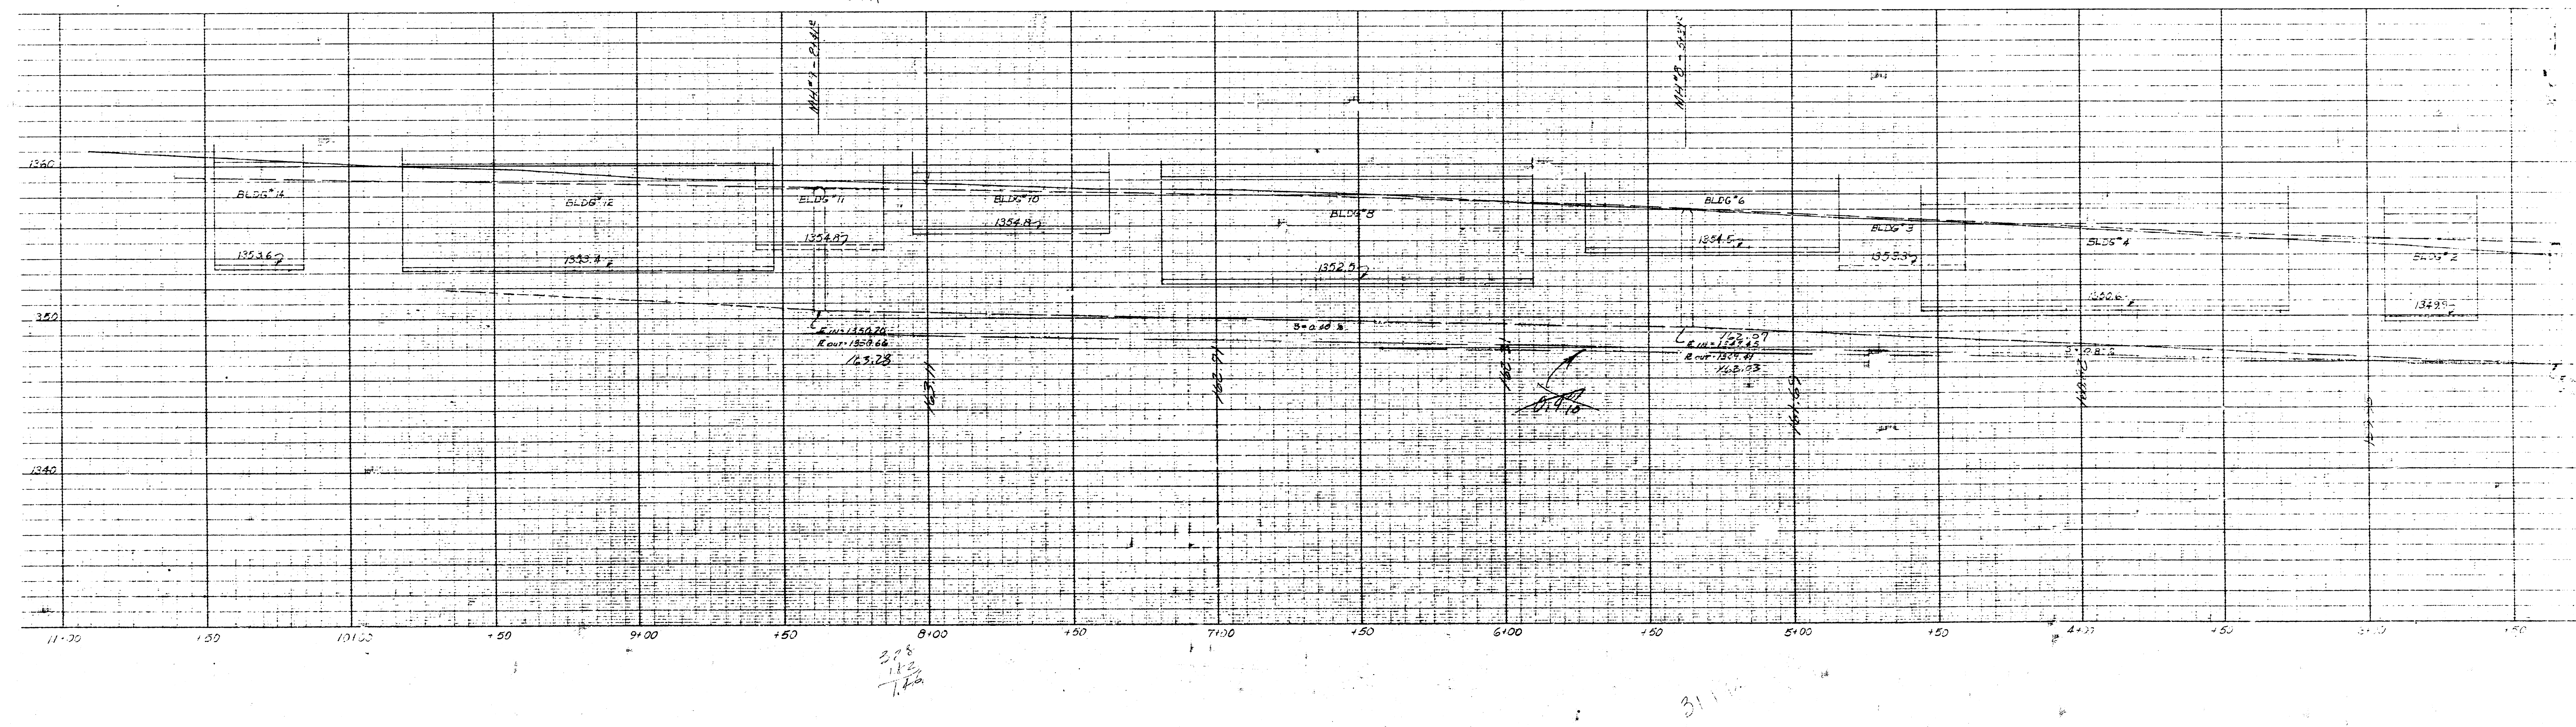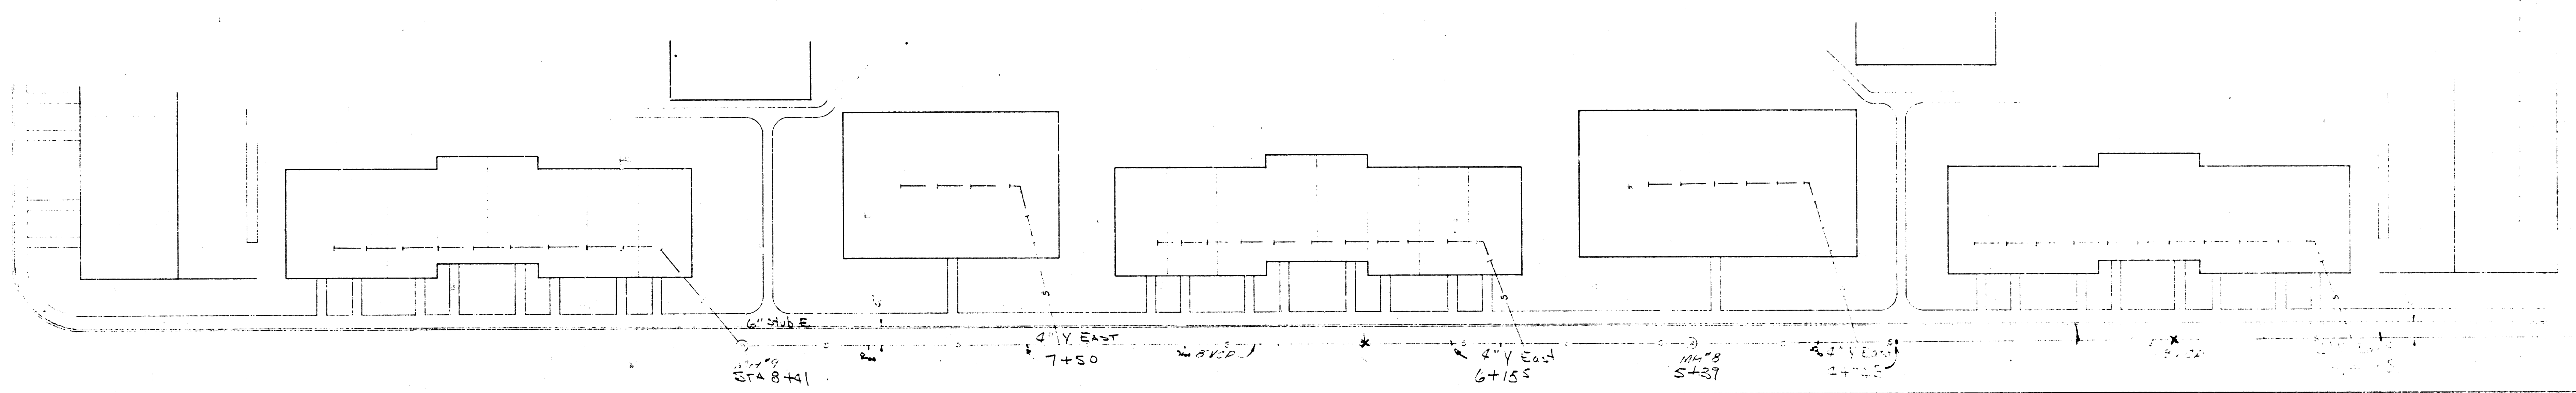

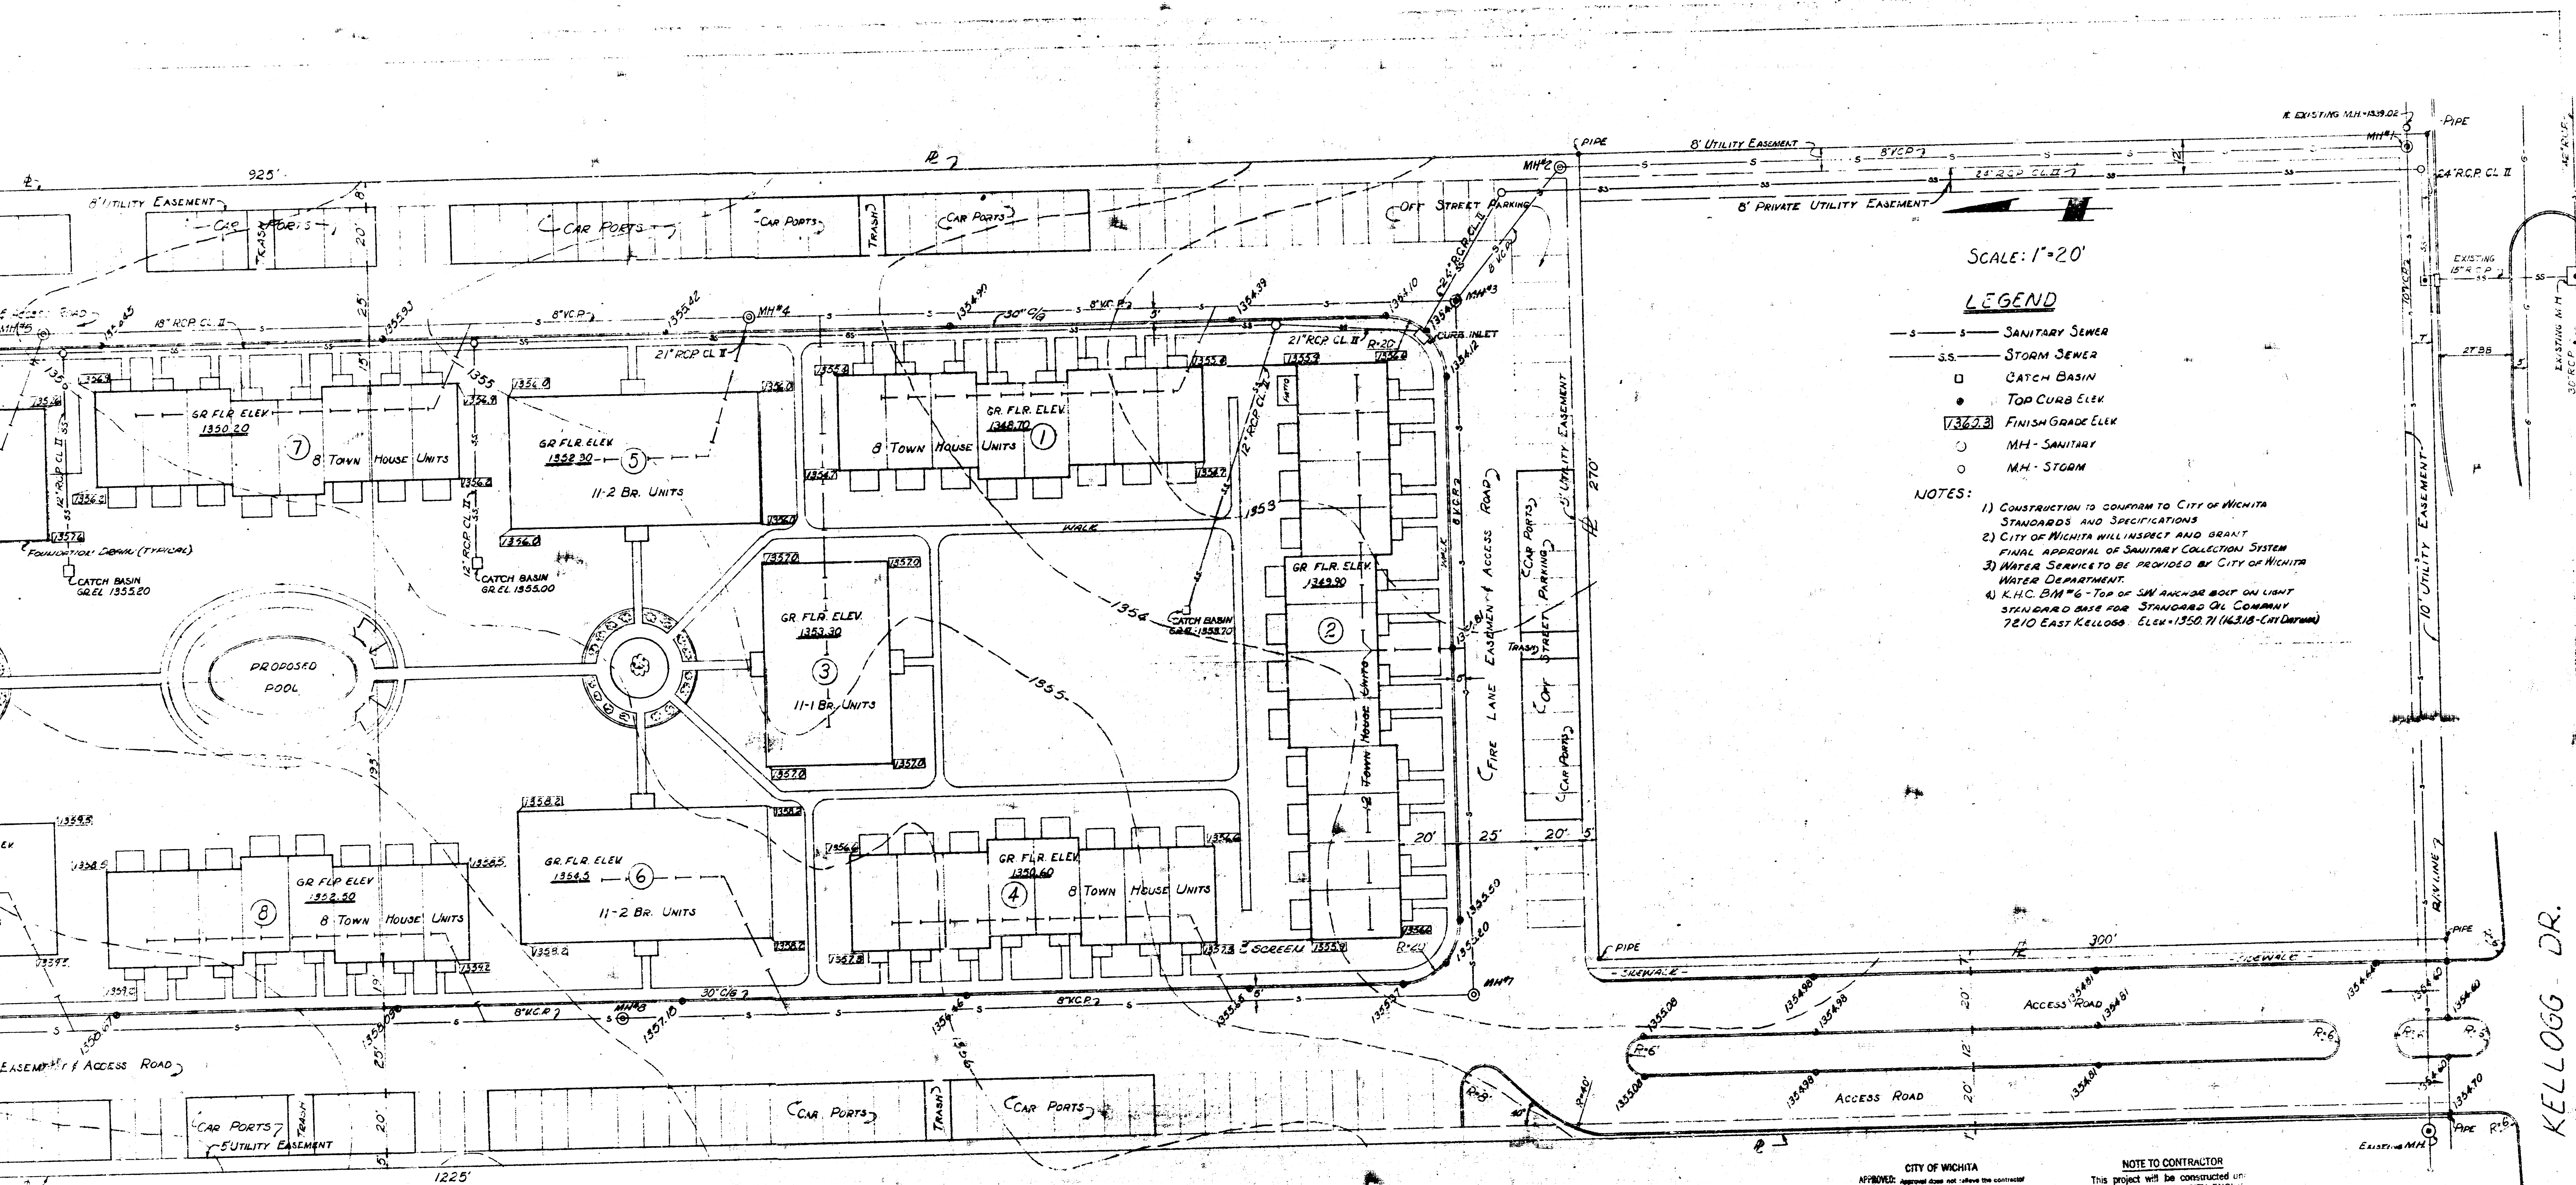

SCALE: 1"=20'

LEGEND

- S — SANITARY SEWER
- S.S. — STORM SEWER
- CATCH BASIN
- TOP CURB ELEV
- 1362.2 FINISH GRADE ELEV
- MH - SANITARY
- MH - STORM

NOTES:

- 1) CONSTRUCTION TO CONFORM TO CITY OF WICHITA STANDARDS AND SPECIFICATIONS
- 2) CITY OF WICHITA WILL INSPECT AND GRANT FINAL APPROVAL OF SANITARY COLLECTION SYSTEM
- 3) WATER SERVICE TO BE PROVIDED BY CITY OF WICHITA WATER DEPARTMENT
- 4) K.H.C. B.M. #6 - TOP OF 3/4" ANCHOR BOLT ON LIGHT STANDARD BASE FOR STANDARD OIL COMPANY 7810 EAST KELLOGG. ELEV. 1350.71 (16318 - CHIT DIRM)

CITY OF WICHITA
APPROVED: [Signature]
Date: May 31 1966
Engineer: D. S. [Signature]

NOTE TO CONTRACTOR
This project will be constructed under the supervision of the CITY ENGINEER and conforming to the SPECIFICATIONS of the CITY OF WICHITA. The CONTRACTOR will reimburse the City of Wichita for all cost of Engineering, Plans and Inspection.

APPROVED AS NOTED
By CITY ENGINEER OF WICHITA
[Signature]
Storm Sewers
Drainage Approaches

EASTBOROUGH APARTMENTS
WICHITA KANSAS
PLOT PLAN
PROFESSIONAL ENGINEERING CONSULTANTS
309 LAURA DRIVE ST. 15 S
WICHITA, KANSAS 67203

