

PLANS

SANITARY SEWER SYSTEM

CRESTVIEW COUNTRY CLUB ESTATES

EAST MEADOWS ADDITION

NORTH
POINT

ADD.

EAST

MEADOWS

ADD.

LEGEND


1" = 100' (Horizontal Scale)

1" = 10' (Vertical Scale)


AS RECONSTRUCTED

SANITARY SEWER LINES



CRESTVIEW IMPROVEMENT DISTRICT

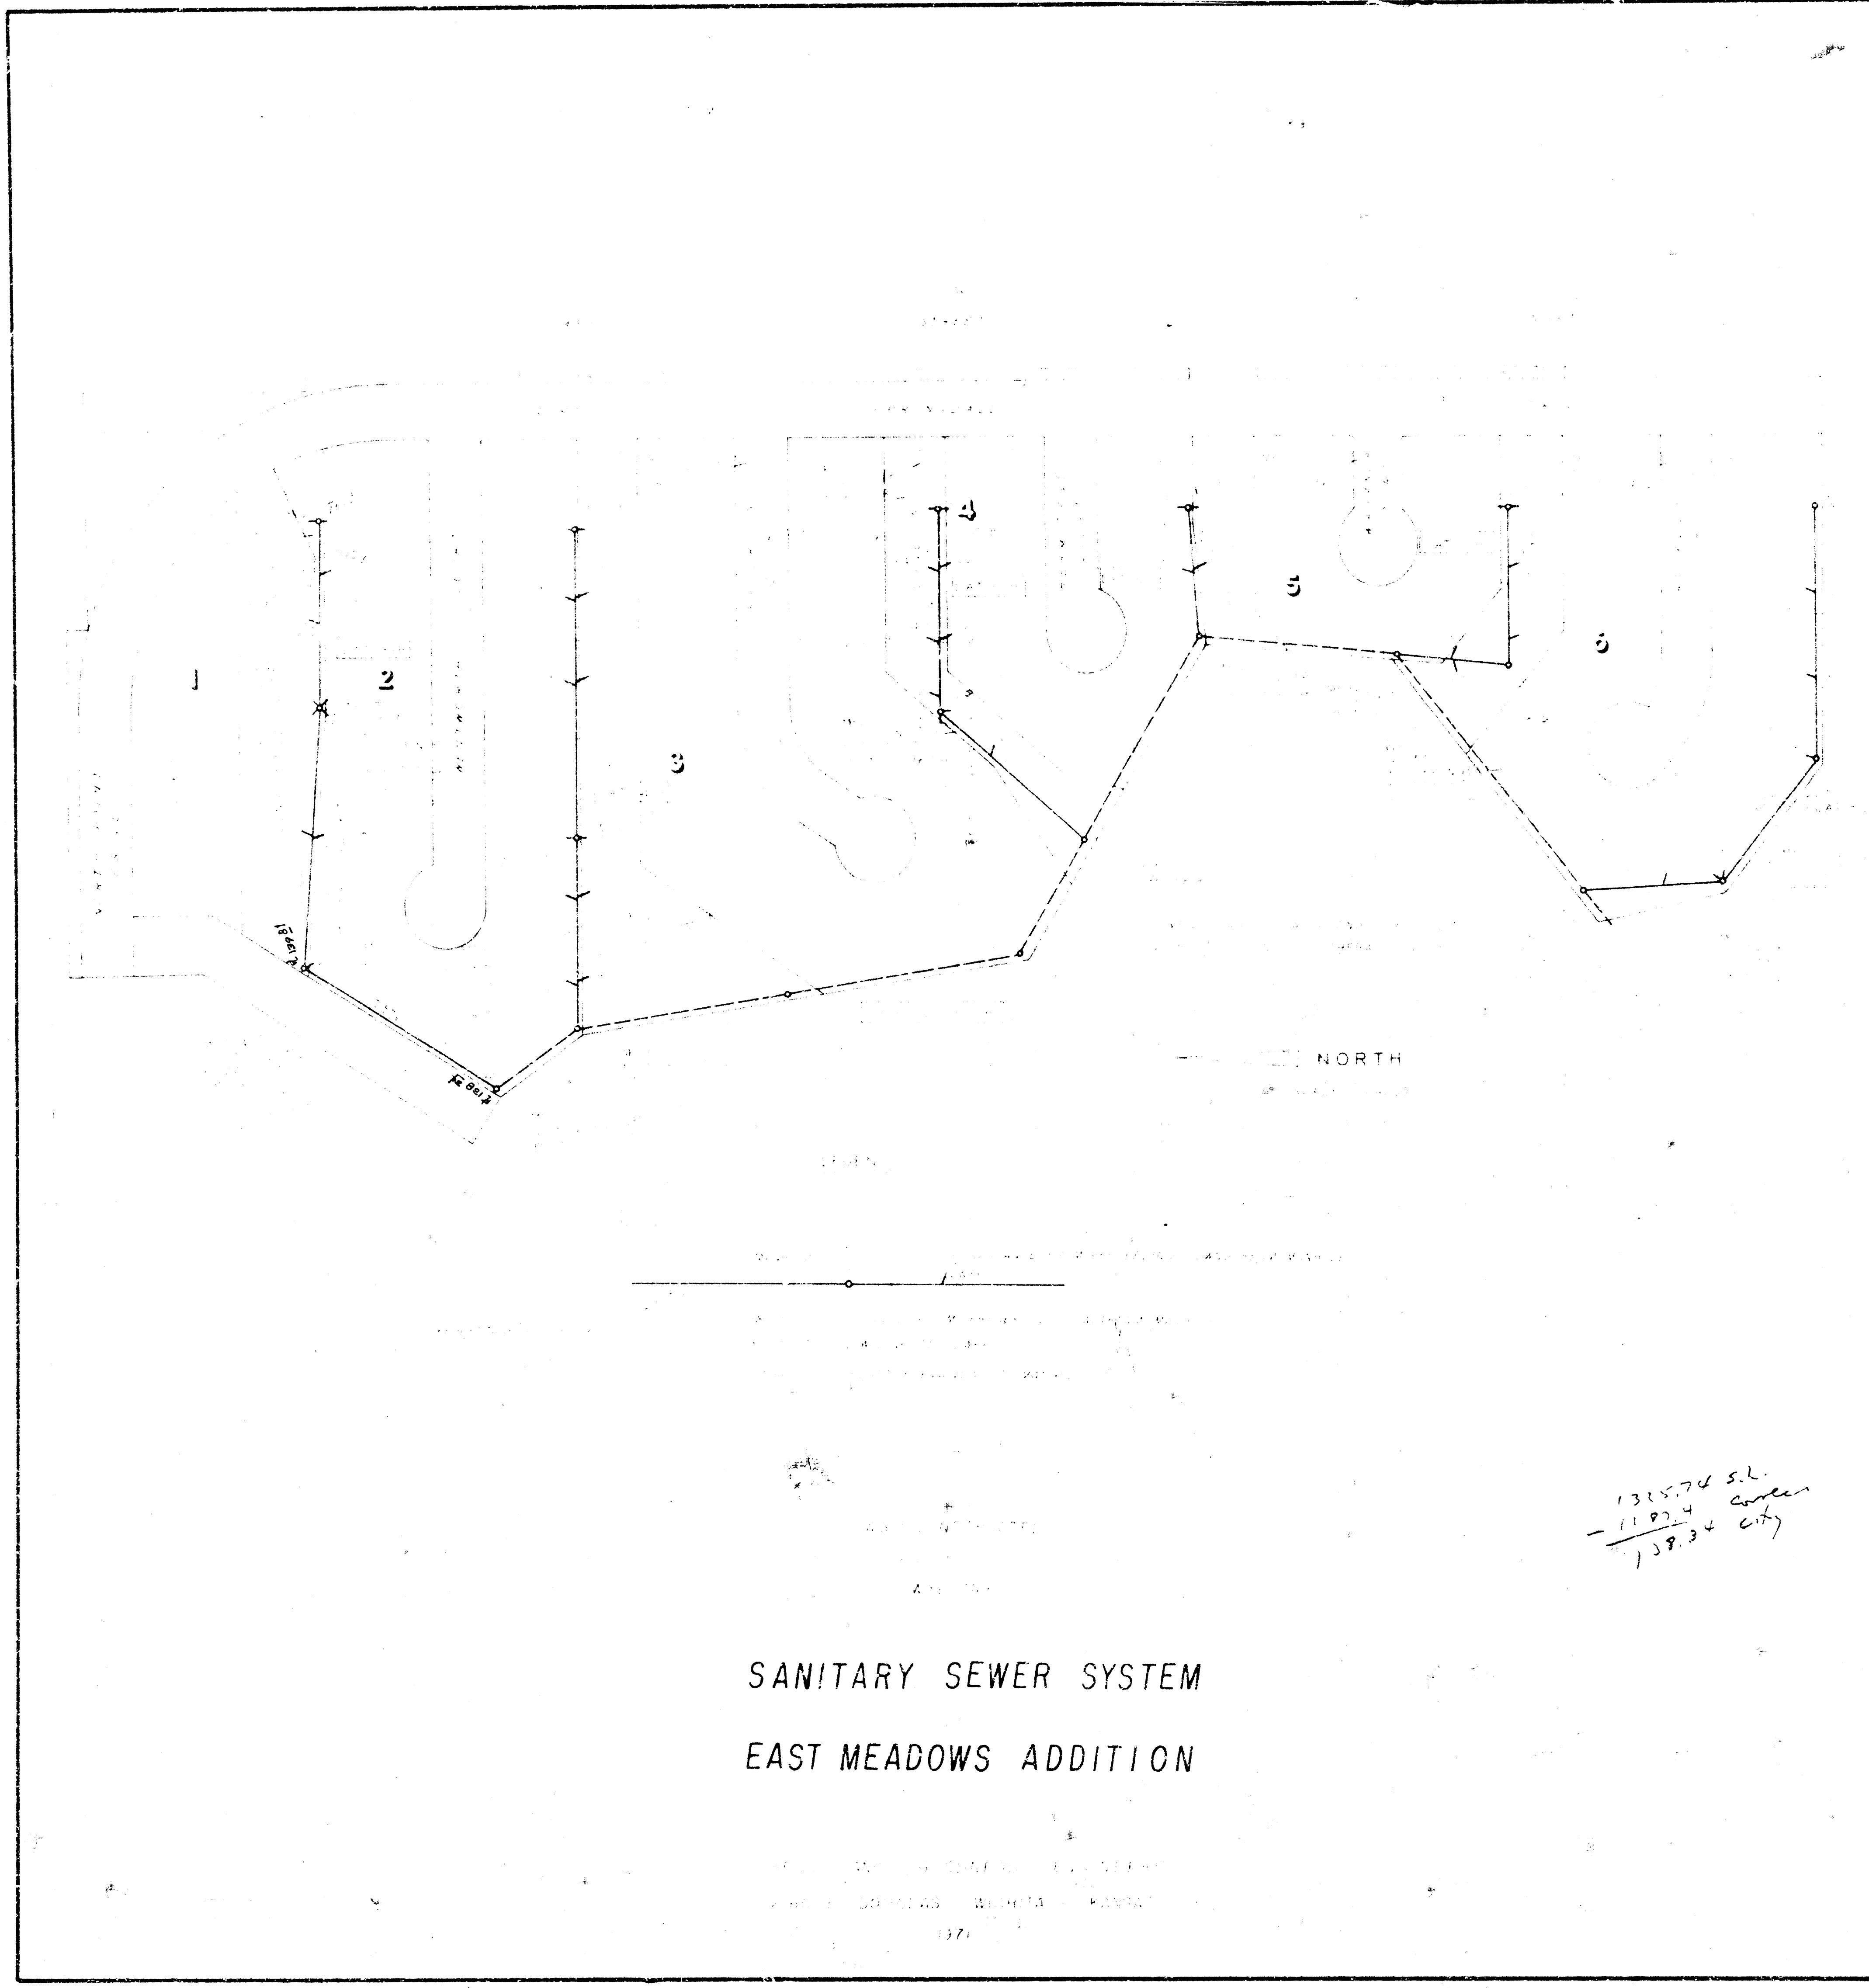

DATE: 11-11-66	DESIGN AND ADDRESS: ENGINEERS	SANITARY SEWER SYSTEM	FIG. NO. 2
	PINE & BOULDER - RICHITA - PAUSAD	EAST WENDERS ADDITION	OF 5

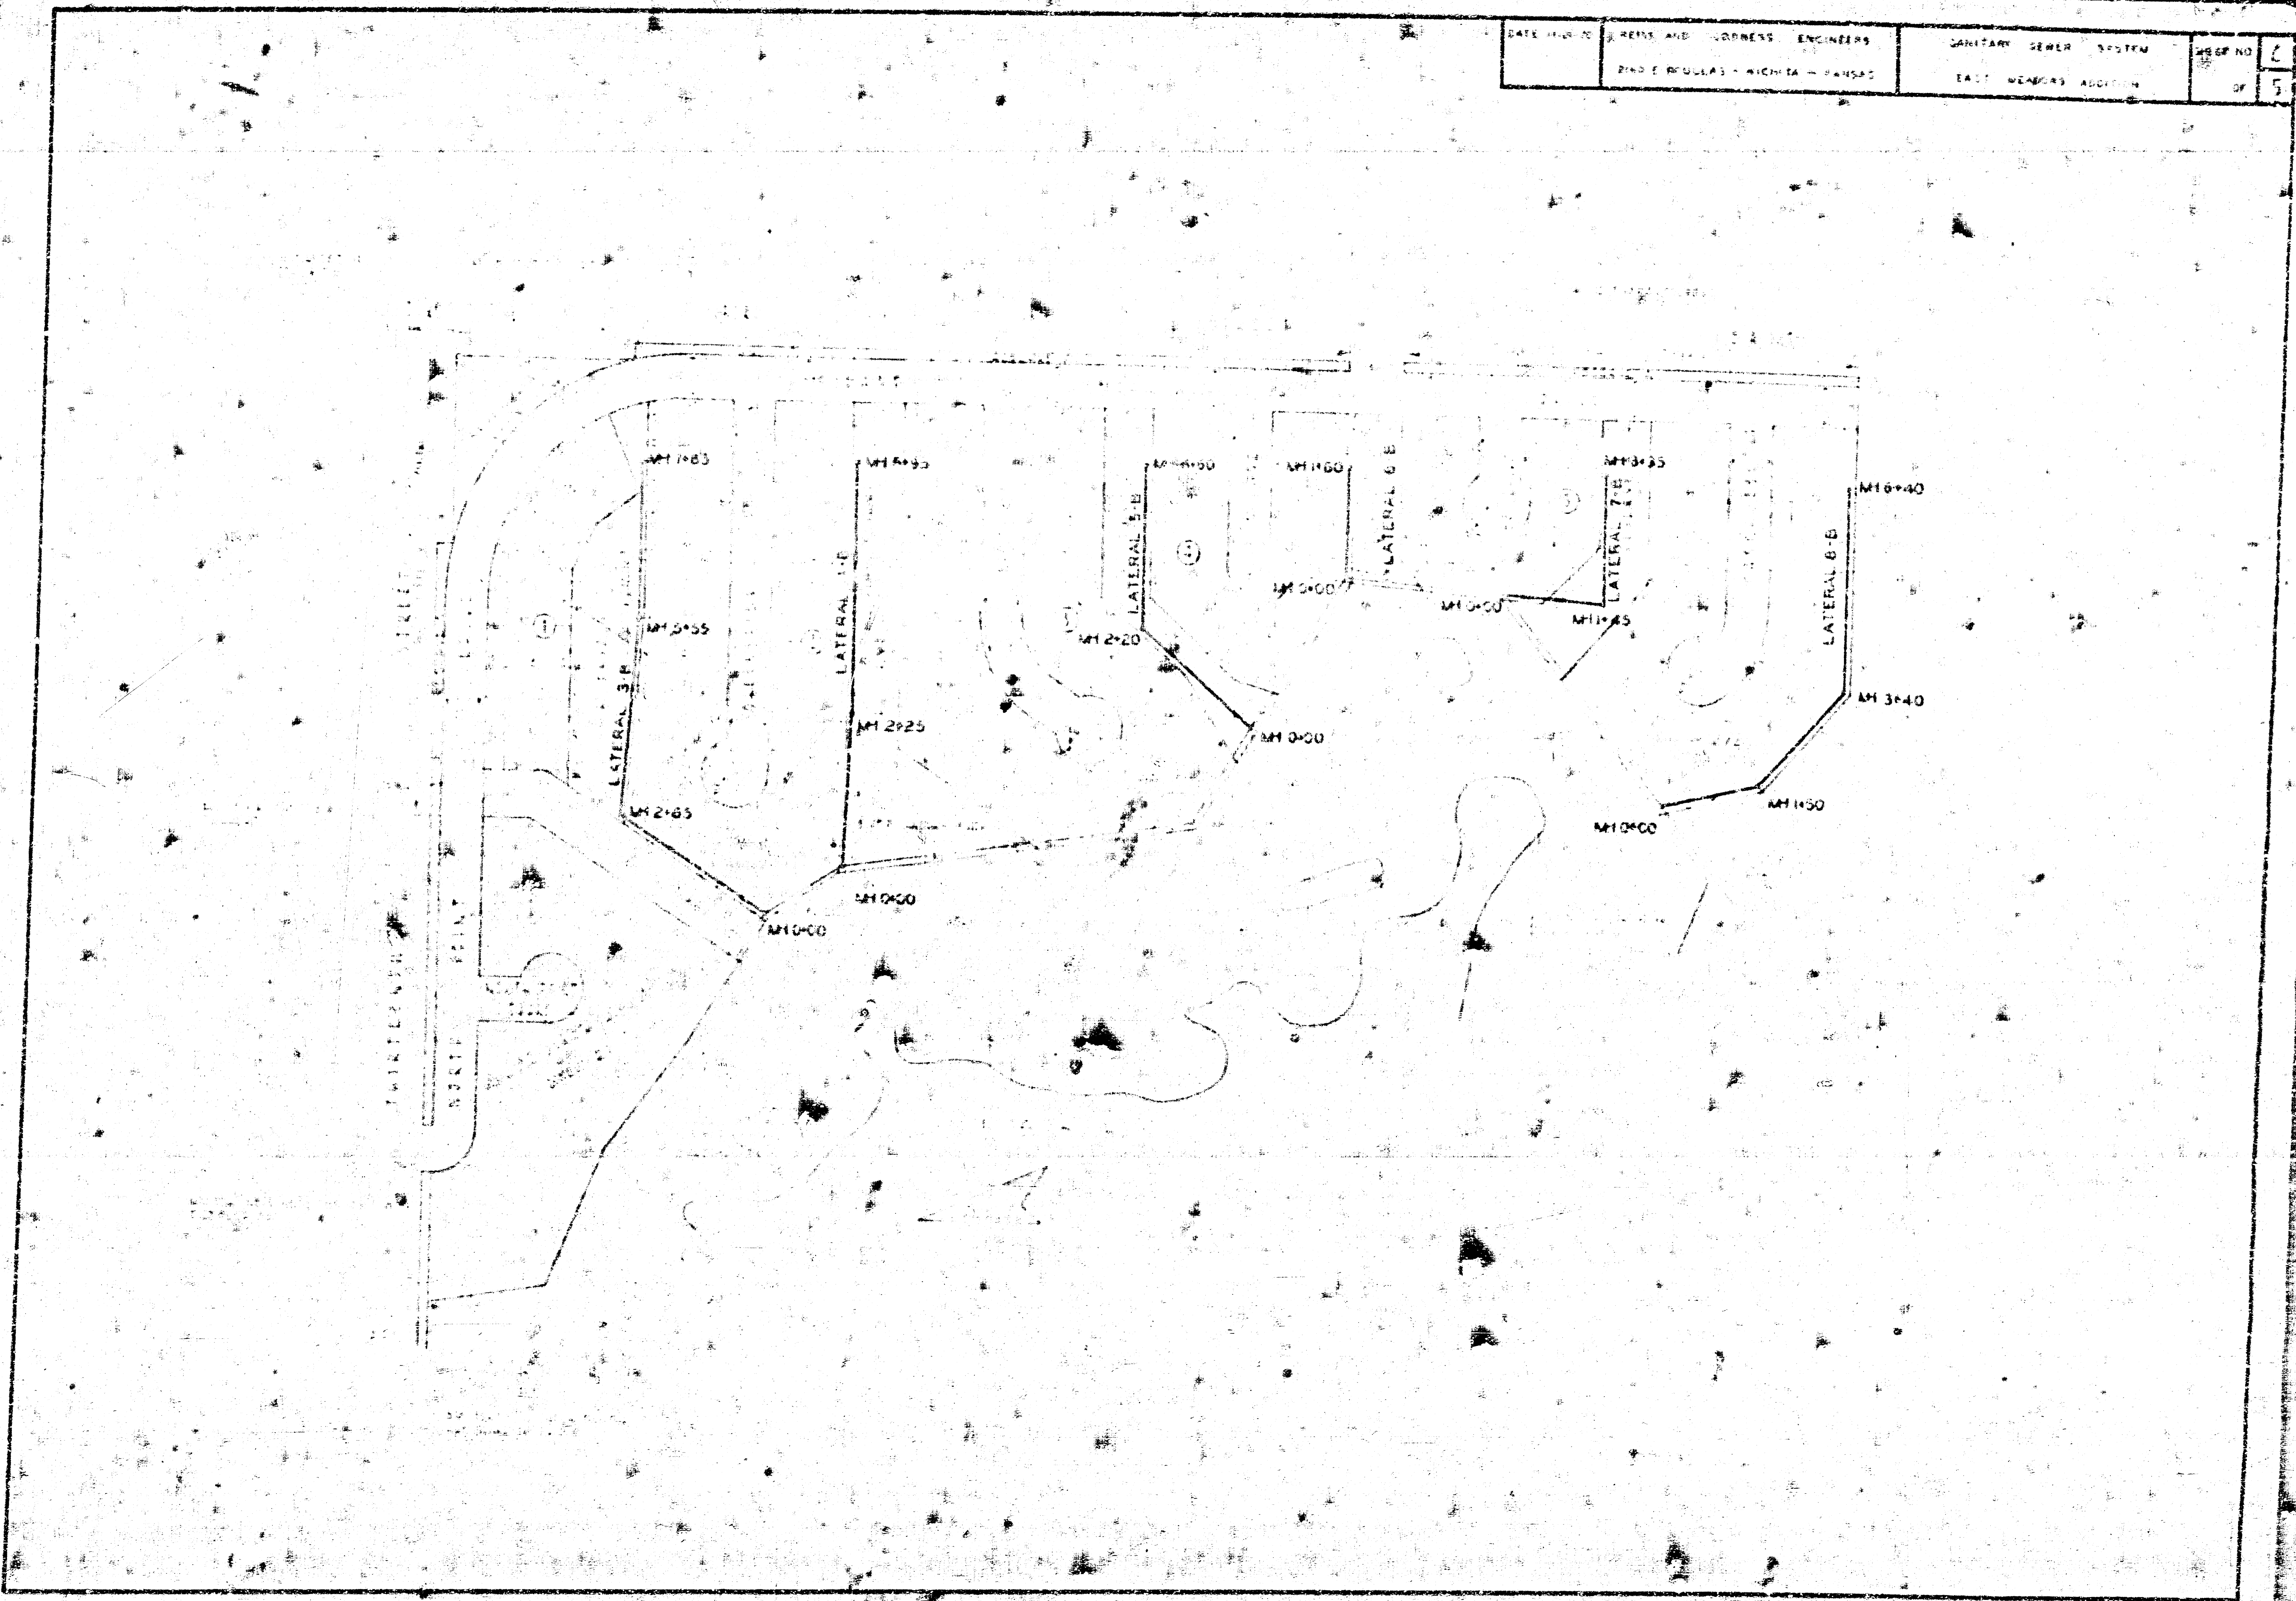

DATE	NOV 19 1964	TIME	10:00	BY	J. H. H.
NO.	1	NAME	JOHN H. H.	UNIT	1

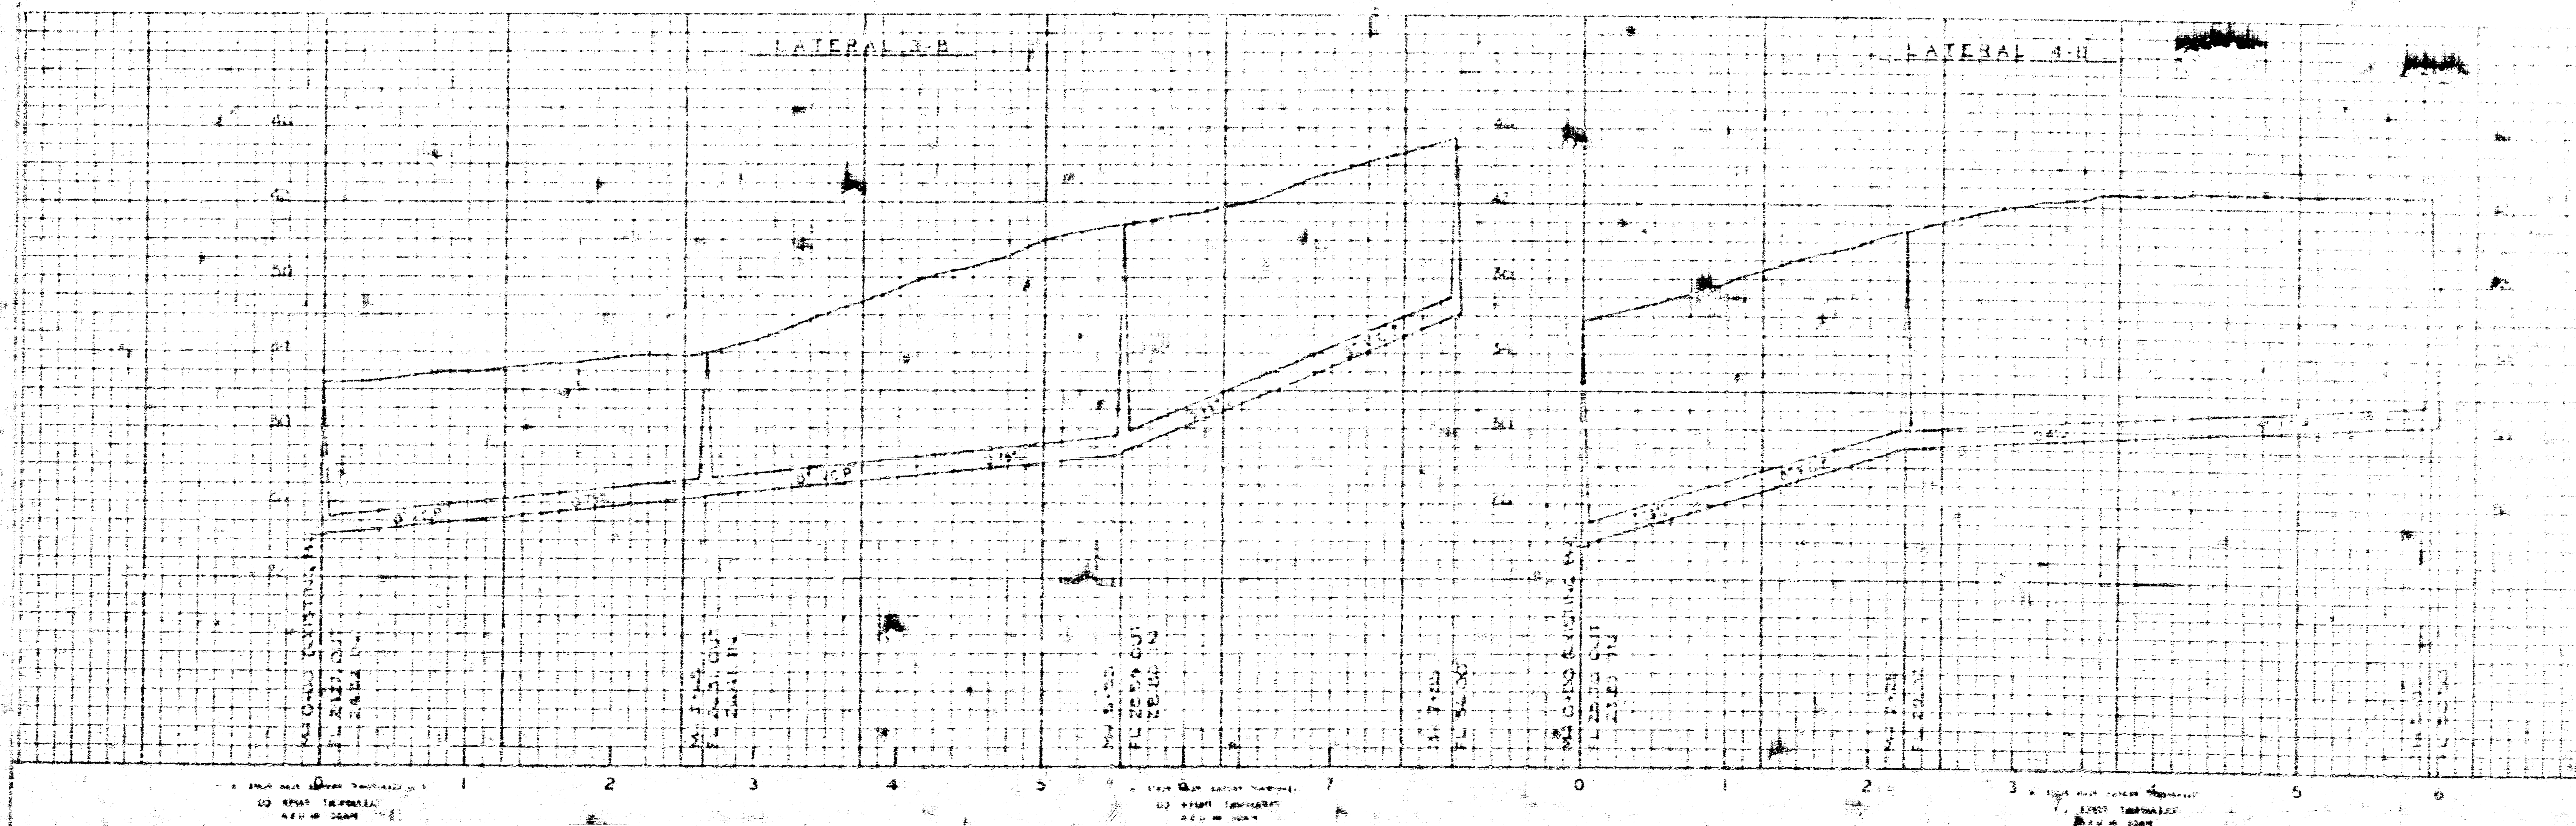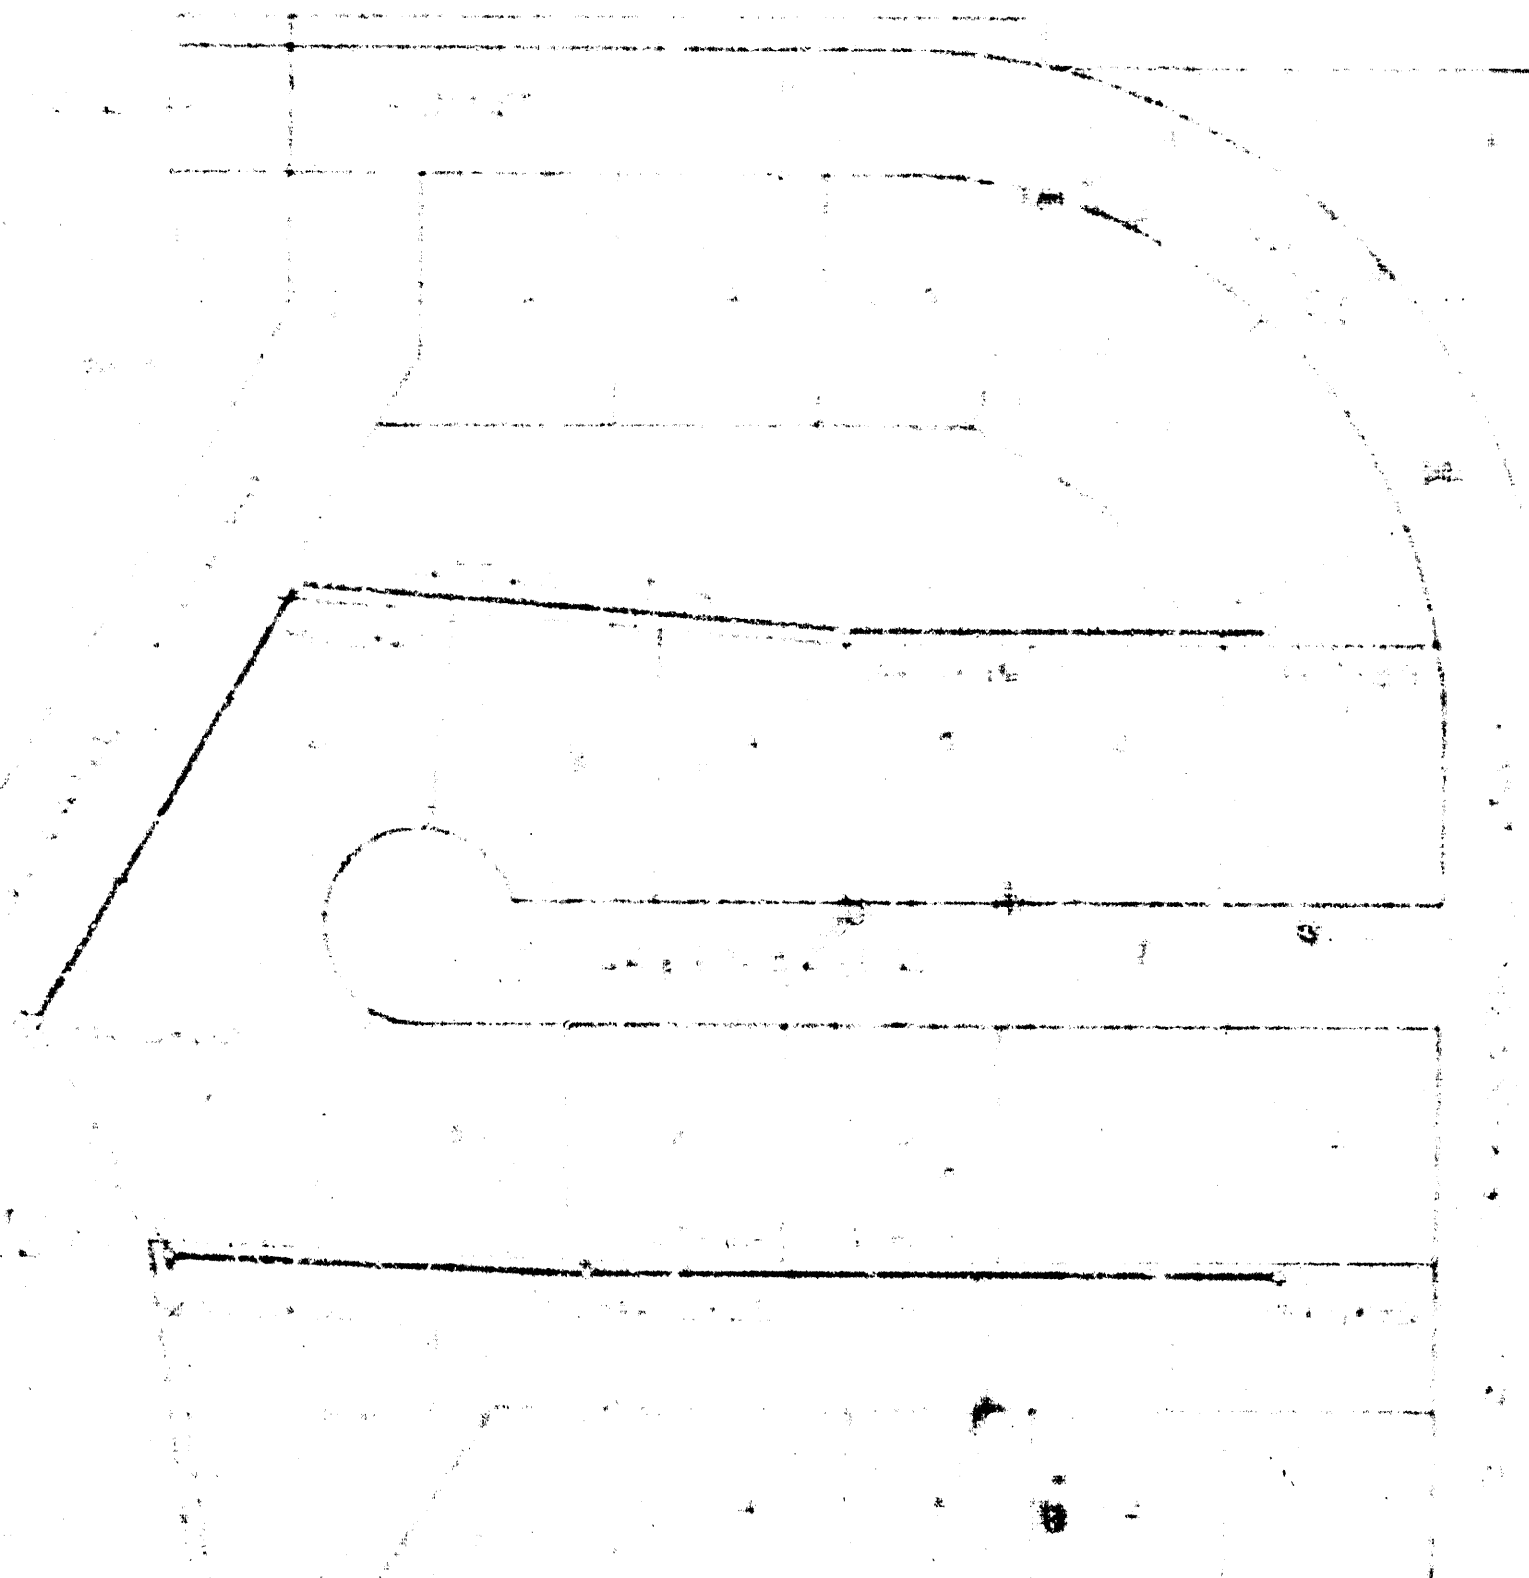

AS 114-20	HEAVY AND BUSINESS ENGINEERS	ANTHONY HEAVY SYSTEM	SHEET	1
	140 E. CHICAGO - CHICAGO - ILLINOIS	PORT WHEELING ALLIANCE	OF	5

