


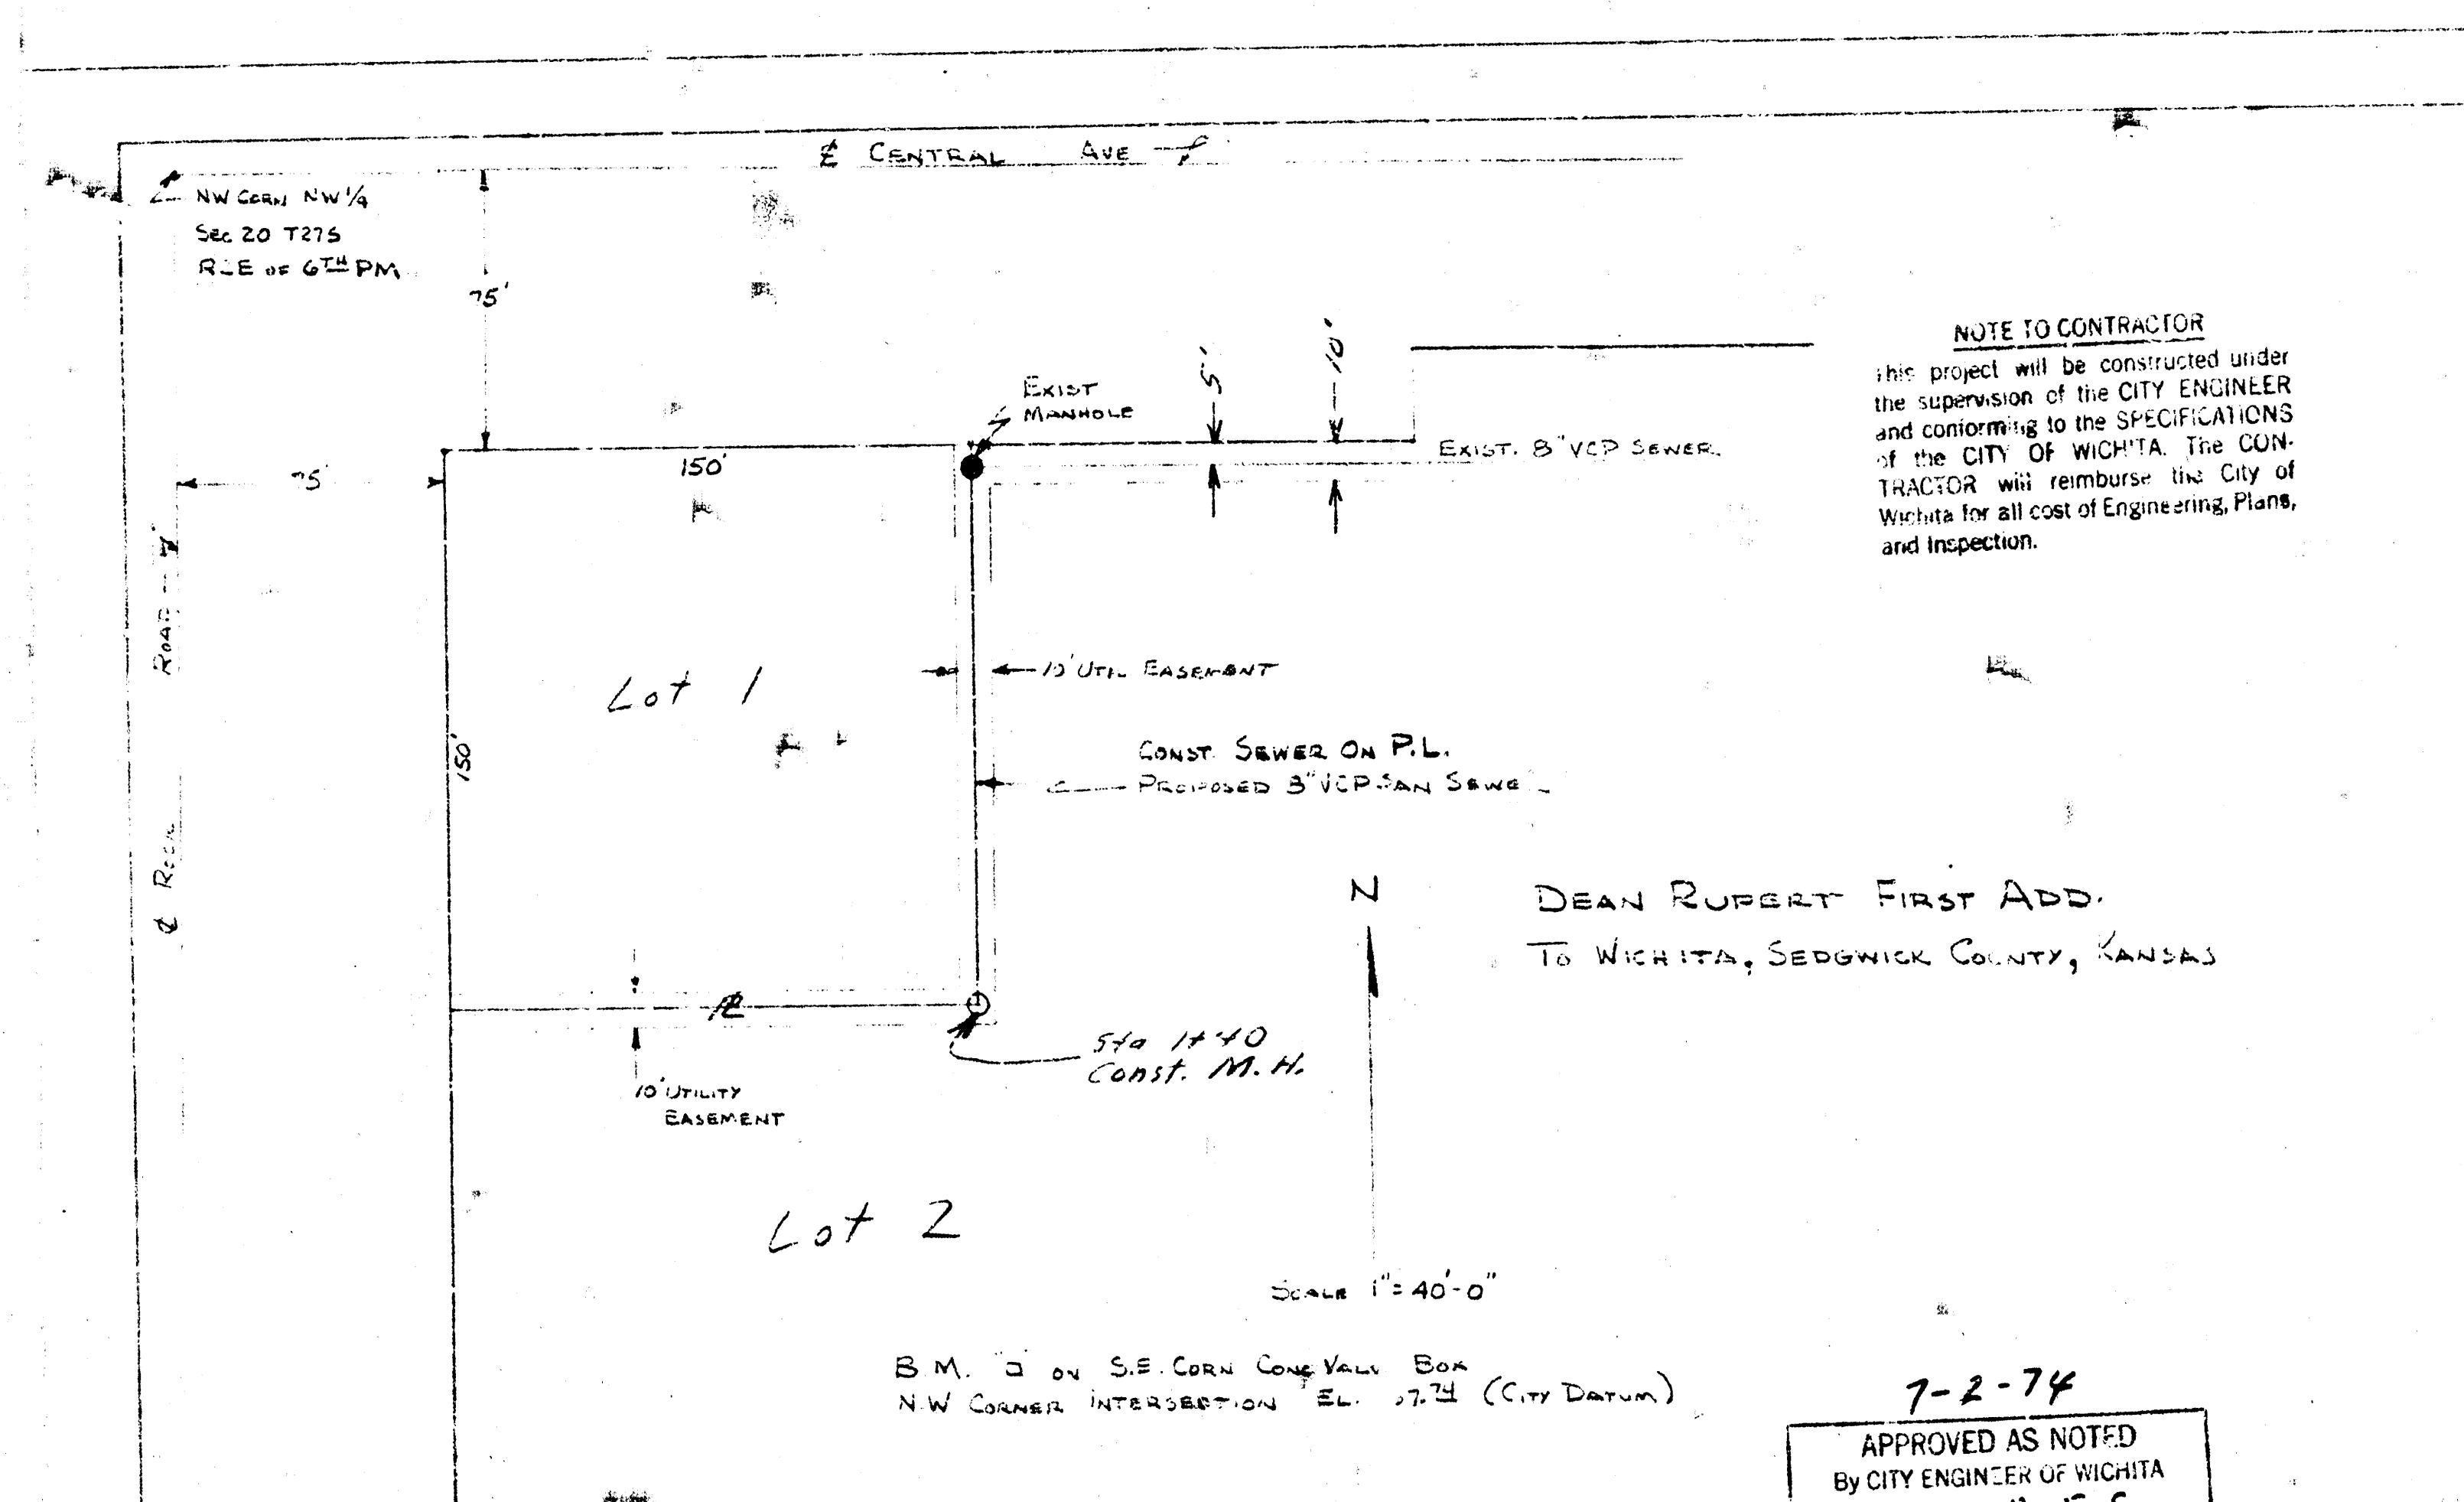

7-2-74
 APPROVED AS NOTED
 By CITY ENGINEER OF WICHITA
 Sanitary Sewers D.E.S.
 Storm Sewers _____
 Driveway Approaches _____

