

R.R. spike in e. side power pole,
9.6' S. of S.E. cor. Graham-Casado
Addition; elev. 138.57



1. The Contractor shall be responsible for preserving property corner irons. The Contractor will be required to re-establish any property irons which are disturbed by his construction operations. Such irons shall be re-established by a licensed land surveyor in accordance with state laws.
2. The Contractor shall verify the locations of underground utilities by contacting One-Call at 687-2470 a minimum of 48 hours prior to any excavation.
3. The Contractor shall make arrangements with the Wichita Water Department for relocating the water meter and service line as indicated on the plan, prior to beginning work.
4. Traffic will not be affected by construction of this project.
5. Construction of this project shall comply with the latest revision of the City of Wichita's STANDARD SPECIFICATIONS FOR CONSTRUCTION OF PUBLIC WORKS PROJECTS BY PRIVATE CONTRACT.

APPROVED AS NOTED

BY CITY ENGINEER OF WICHITA

Sanitary Sewers VRH 1/30/90

Storm Sewers

Driveway Approaches_

Water Mains.

Water Mains.

Paving_____


NOTE TO CONTRACTOR

INSPECTION AND TESTING FOR THIS PROJECT IS TO BE PROVIDED BY A LICENSED CONSULTING ENGINEERING FIRM UNDER CONTRACT WITH THE OWNER/DEVELOPER. SAID INSPECTION TO BE IN ACCORDANCE WITH THE CITY OF WICHITA STANDARD CONSTRUCTION ENGINEERING PRACTICES AND CERTIFIED BY A LICENSED PROFESSIONAL ENGINEER. NO WORK SHALL BE PERFORMED IN DEDICATED EASEMENTS OR PUBLIC RIGHT-OF-WAY BY THE CONTRACTOR WITHOUT SUCH INSPECTION NOR SHALL ANY WORK BE COMMENCED WITHOUT WRITTEN AUTHORIZATION BY THE CITY ENGINEER.


PROFILE SCALE

1" = 20' HORIZ.

1" = 5' Vert.

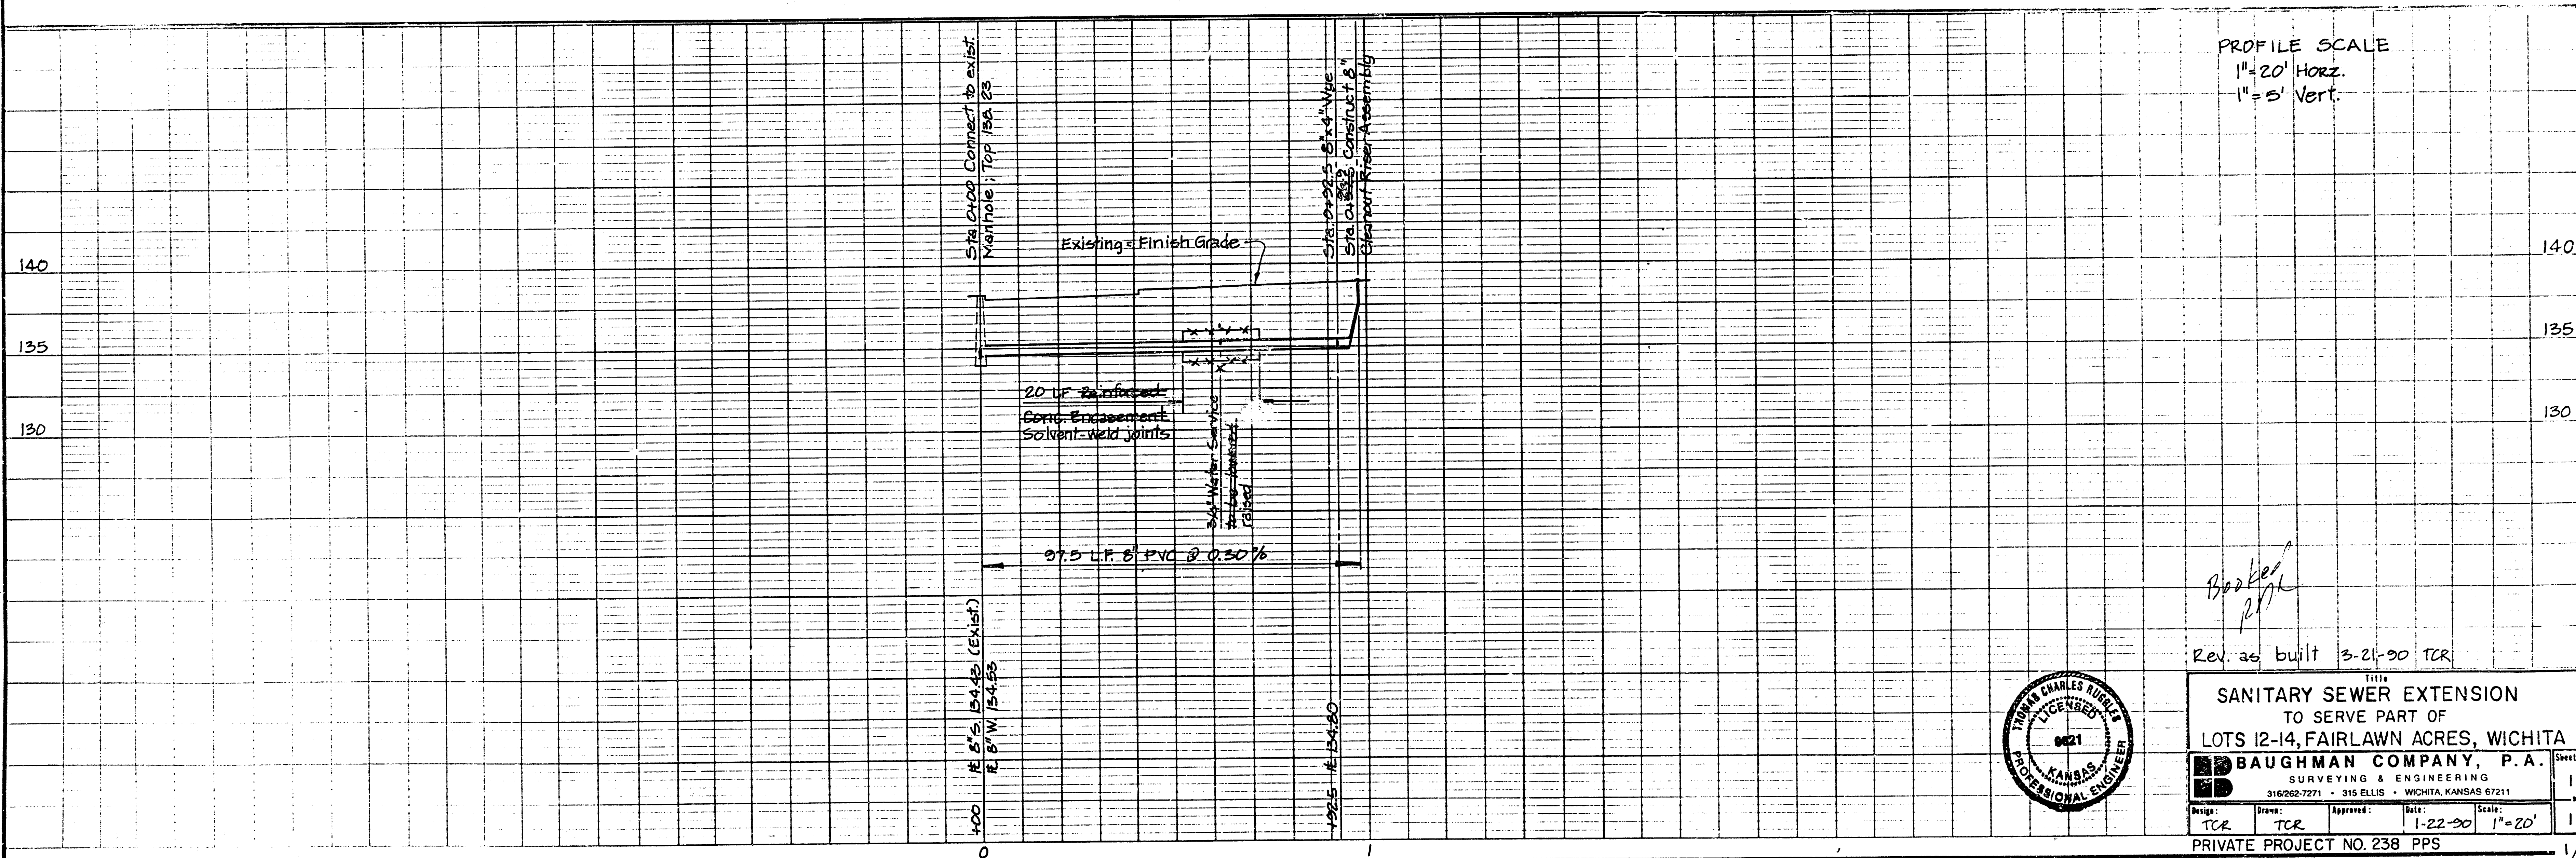

Rev. as built 3-21-90 TCR

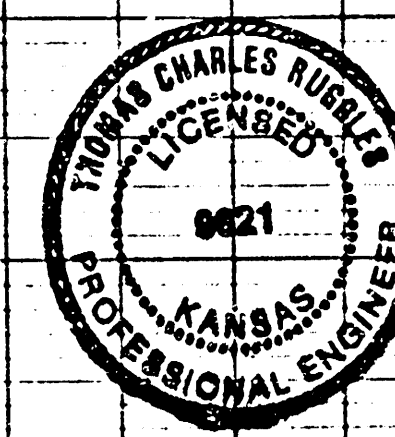

Title
 SANITARY SEWER EXTENSION
 TO SERVE PART OF
 LOTS 12-14, FAIRLAWN ACRES, WICHITA

BAUGHMAN COMPANY. P.A.

SURVEYING & ENGINEERING

Design:	Drawn:	Approved:	Date:	Scale:
---------	--------	-----------	-------	--------

TCR	TCR		1-22-90	1"=20'	
-----	-----	--	---------	--------	--

PRIVATE PROJECT NO. 238 PPS

BENCH MARK

R.R. spike in e. side power pole,
3.6' S. of S.E. cor. Graham-Casado
Addition; elev. 136.57

GENERAL NOTES


1. The Contractor shall be responsible for preserving property corner irons. The Contractor will be required to re-establish any property irons which are disturbed by his construction operations. Such irons shall be re-established by a licensed land surveyor in accordance with state laws.
2. The Contractor shall verify the locations of underground utilities by contacting One-Call at 687-2470 a minimum of 48 hours prior to any excavation.
3. The Contractor shall make arrangements with the Wichita Water Department for relocating the water meter and service line as indicated on the plan, prior to beginning work.
4. Traffic will not be affected by construction of this project.
5. Construction of this project shall comply with the latest revision of the City of Wichita PROCEDURE FOR CONSTRUCTION OF PUBLIC WORKS PROJECTS BY PRIVATE CONTRACT.

APPROVED AS NOTED


By CITY ENGINEER OF WICHITA
Sanitary Sewers VRH 1/30/90
Storm Sewers _____
Driveway Approaches _____
Water Mains _____
Paving _____

NOTE TO CONTRACTOR


INSPECTION AND TESTING FOR THIS PROJECT IS TO BE PROVIDED BY A LICENSED CONSULTING ENGINEERING FIRM UNDER CONTRACT WITH THE OWNER/DEVELOPER. SAID INSPECTION TO BE IN ACCORDANCE WITH THE CITY OF WICHITA STANDARD CONSTRUCTION ENGINEERING PRACTICES AND CERTIFIED BY A LICENSED PROFESSIONAL ENGINEER. NO WORK SHALL BE PERFORMED IN DEDICATED EASEMENTS OR PUBLIC RIGHT-OF-WAY BY THE CONTRACTOR WITHOUT SUCH INSPECTION NOR SHALL ANY WORK BE COMMENCED WITHOUT WRITTEN AUTHORIZATION BY THE CITY ENGINEER.

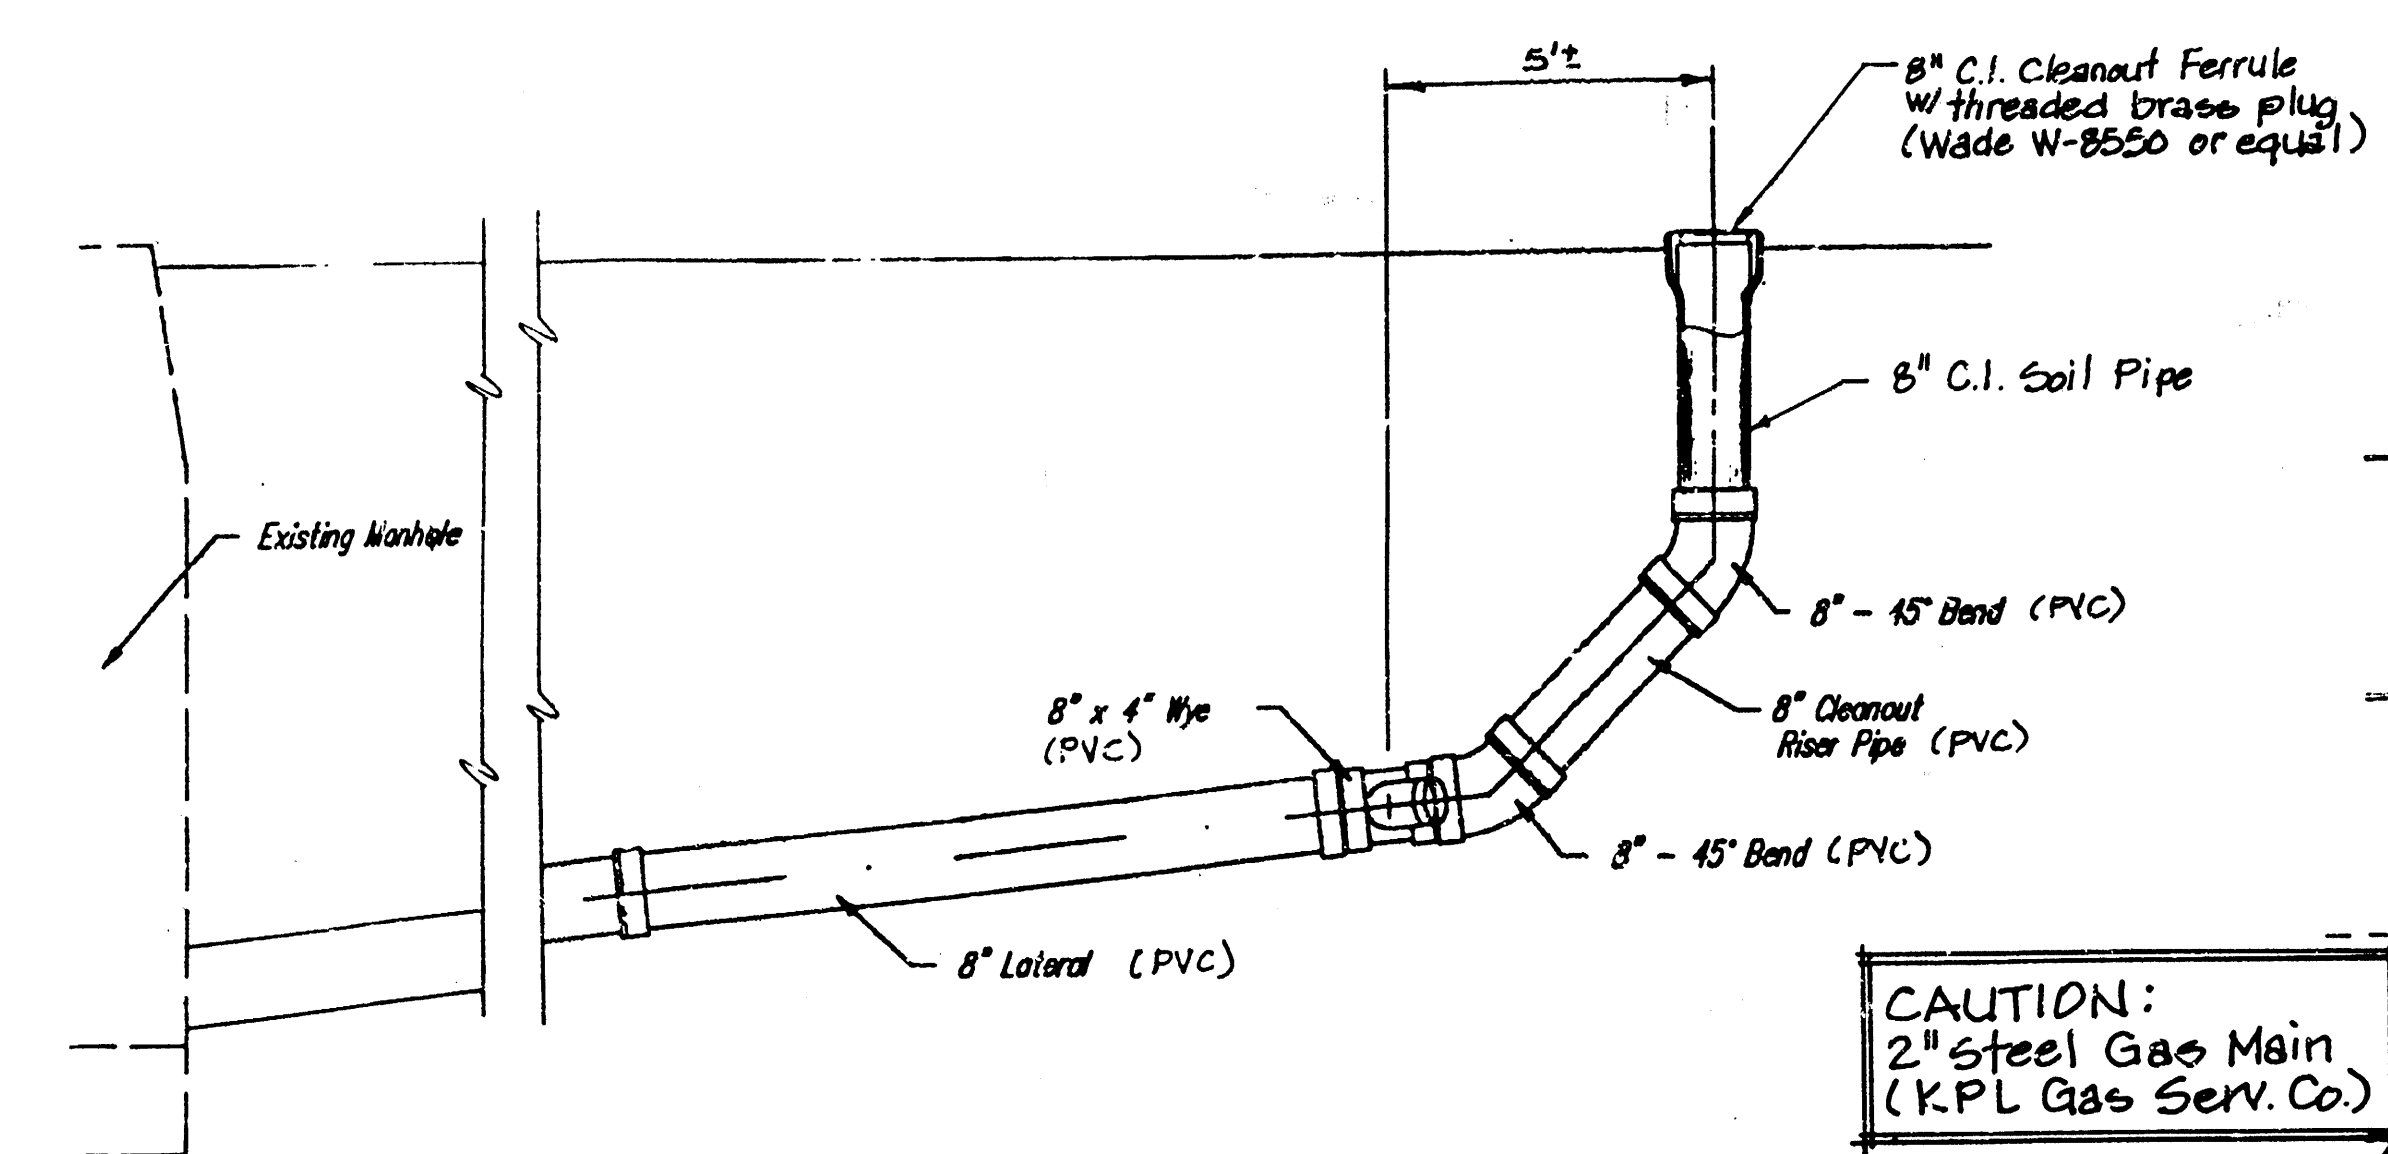

CLEANOUT RISER DETAIL

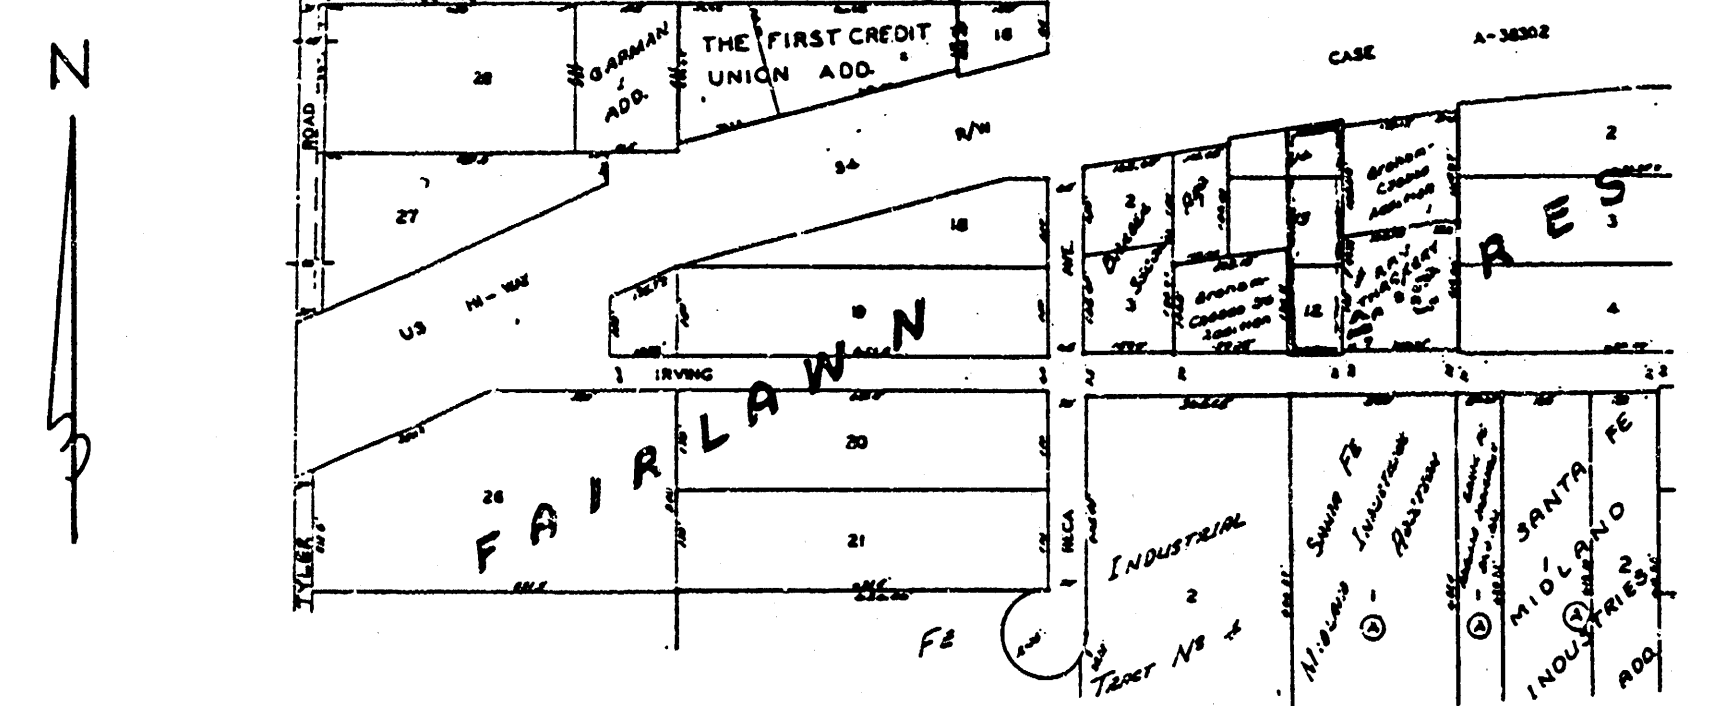



LOCATION MAP

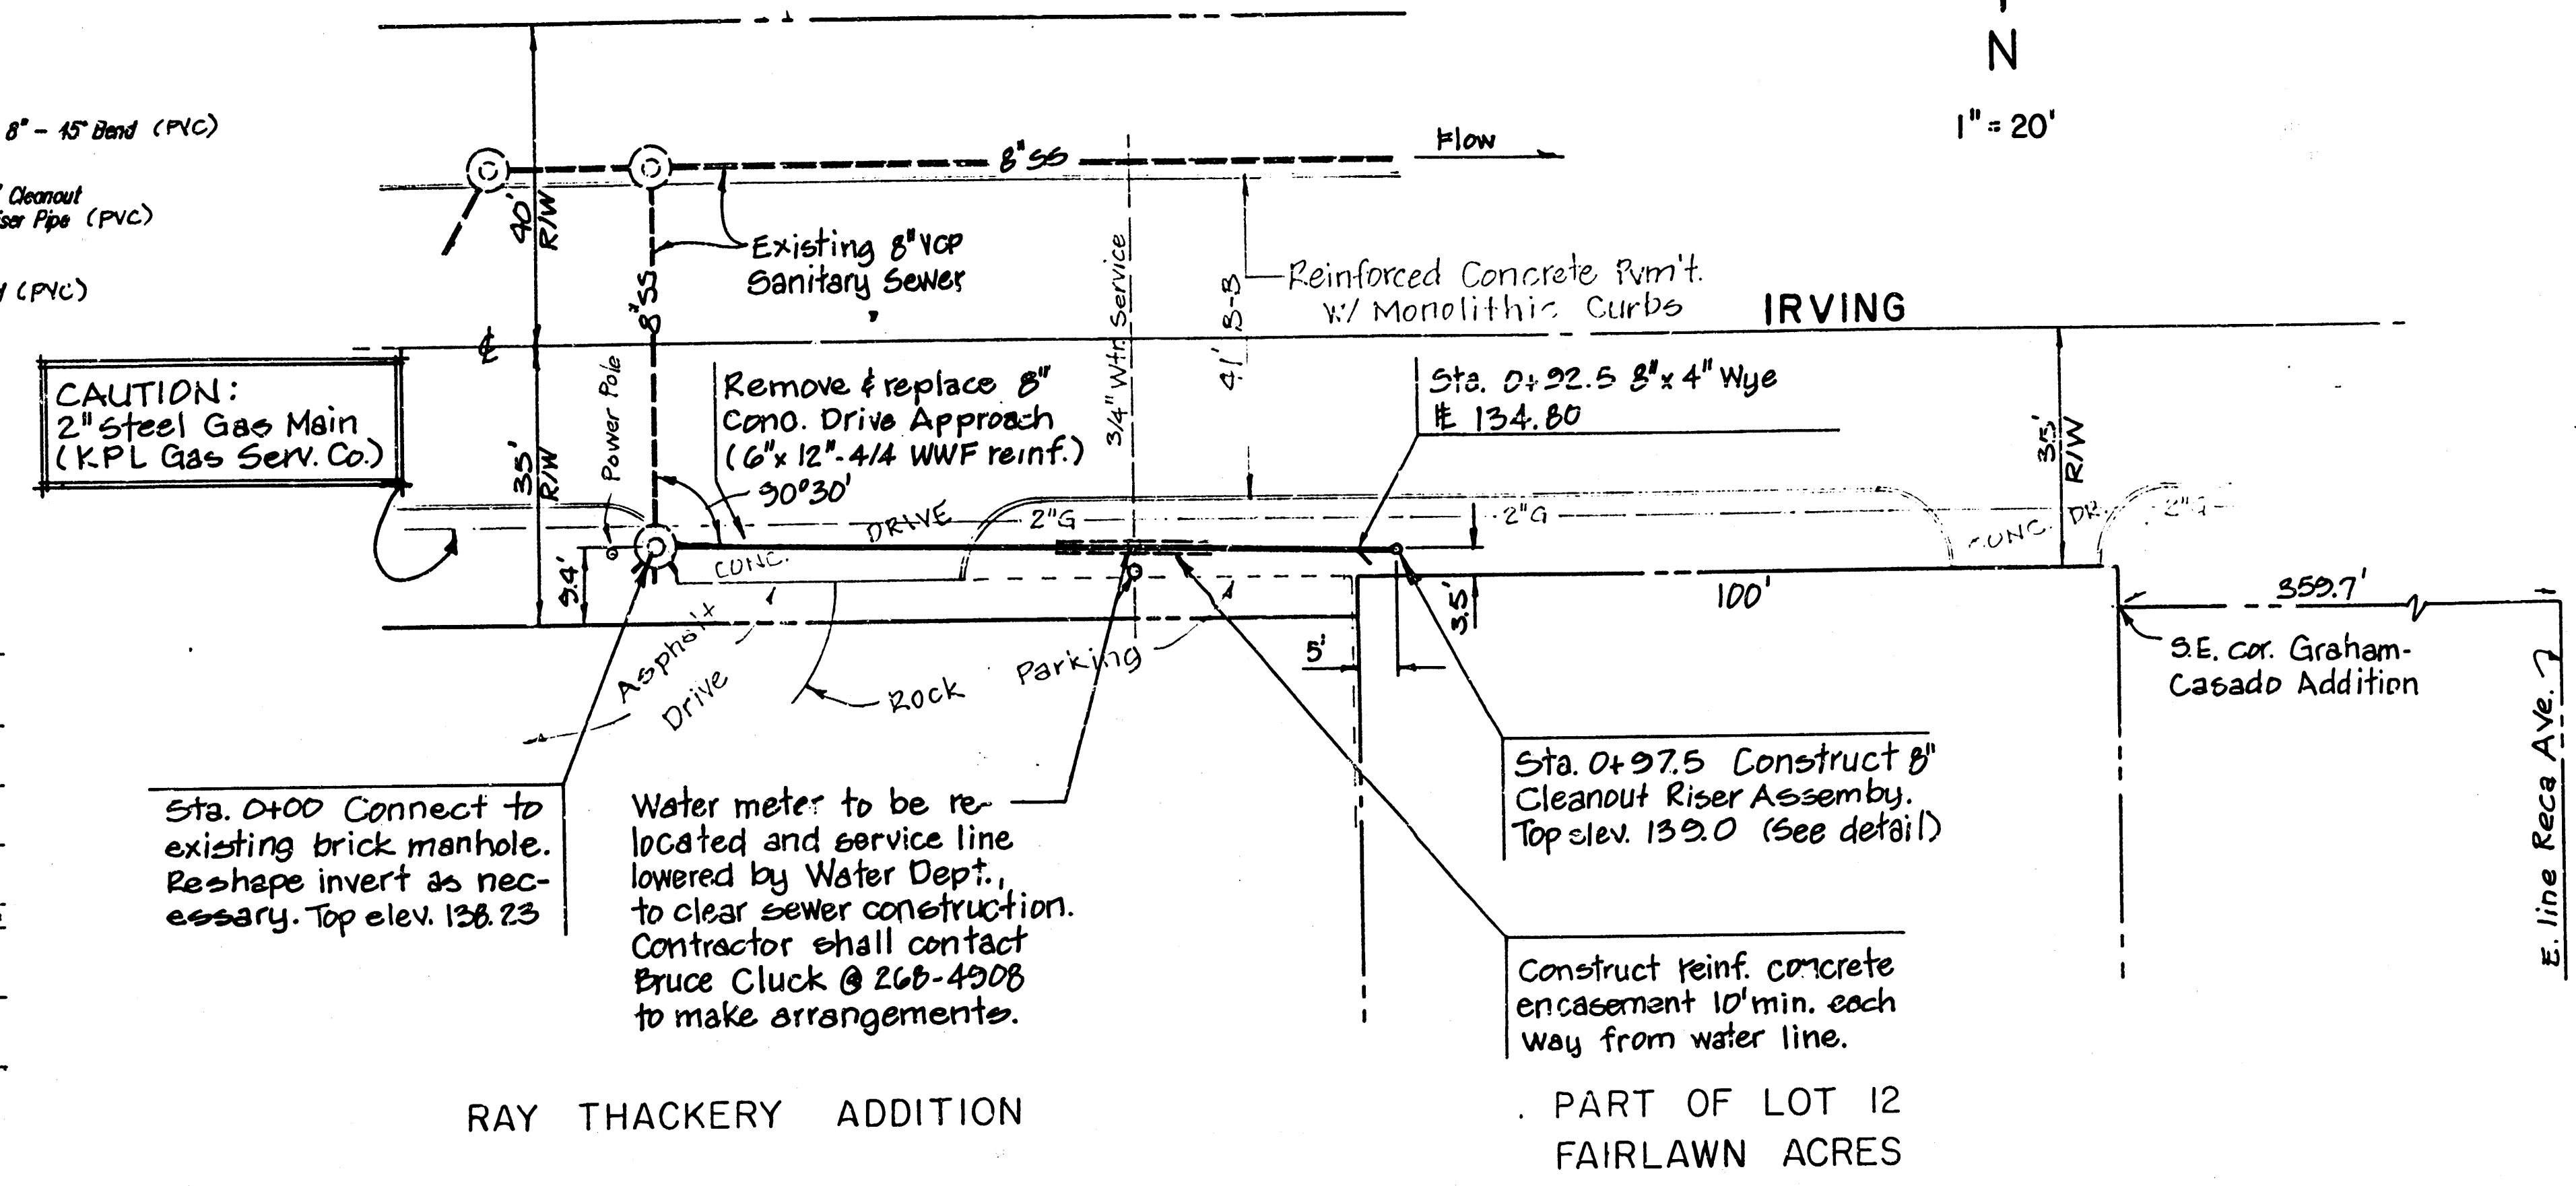

RAY THACKERY ADDITION

PART OF LOT 12 FAIRLAWN ACRES

PROFILE SCALE
1"=20' Horiz.
1"=5' Vert.

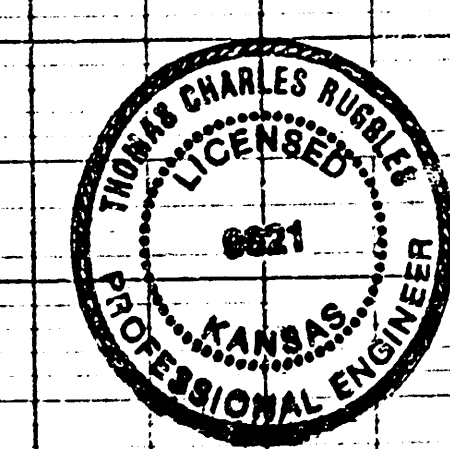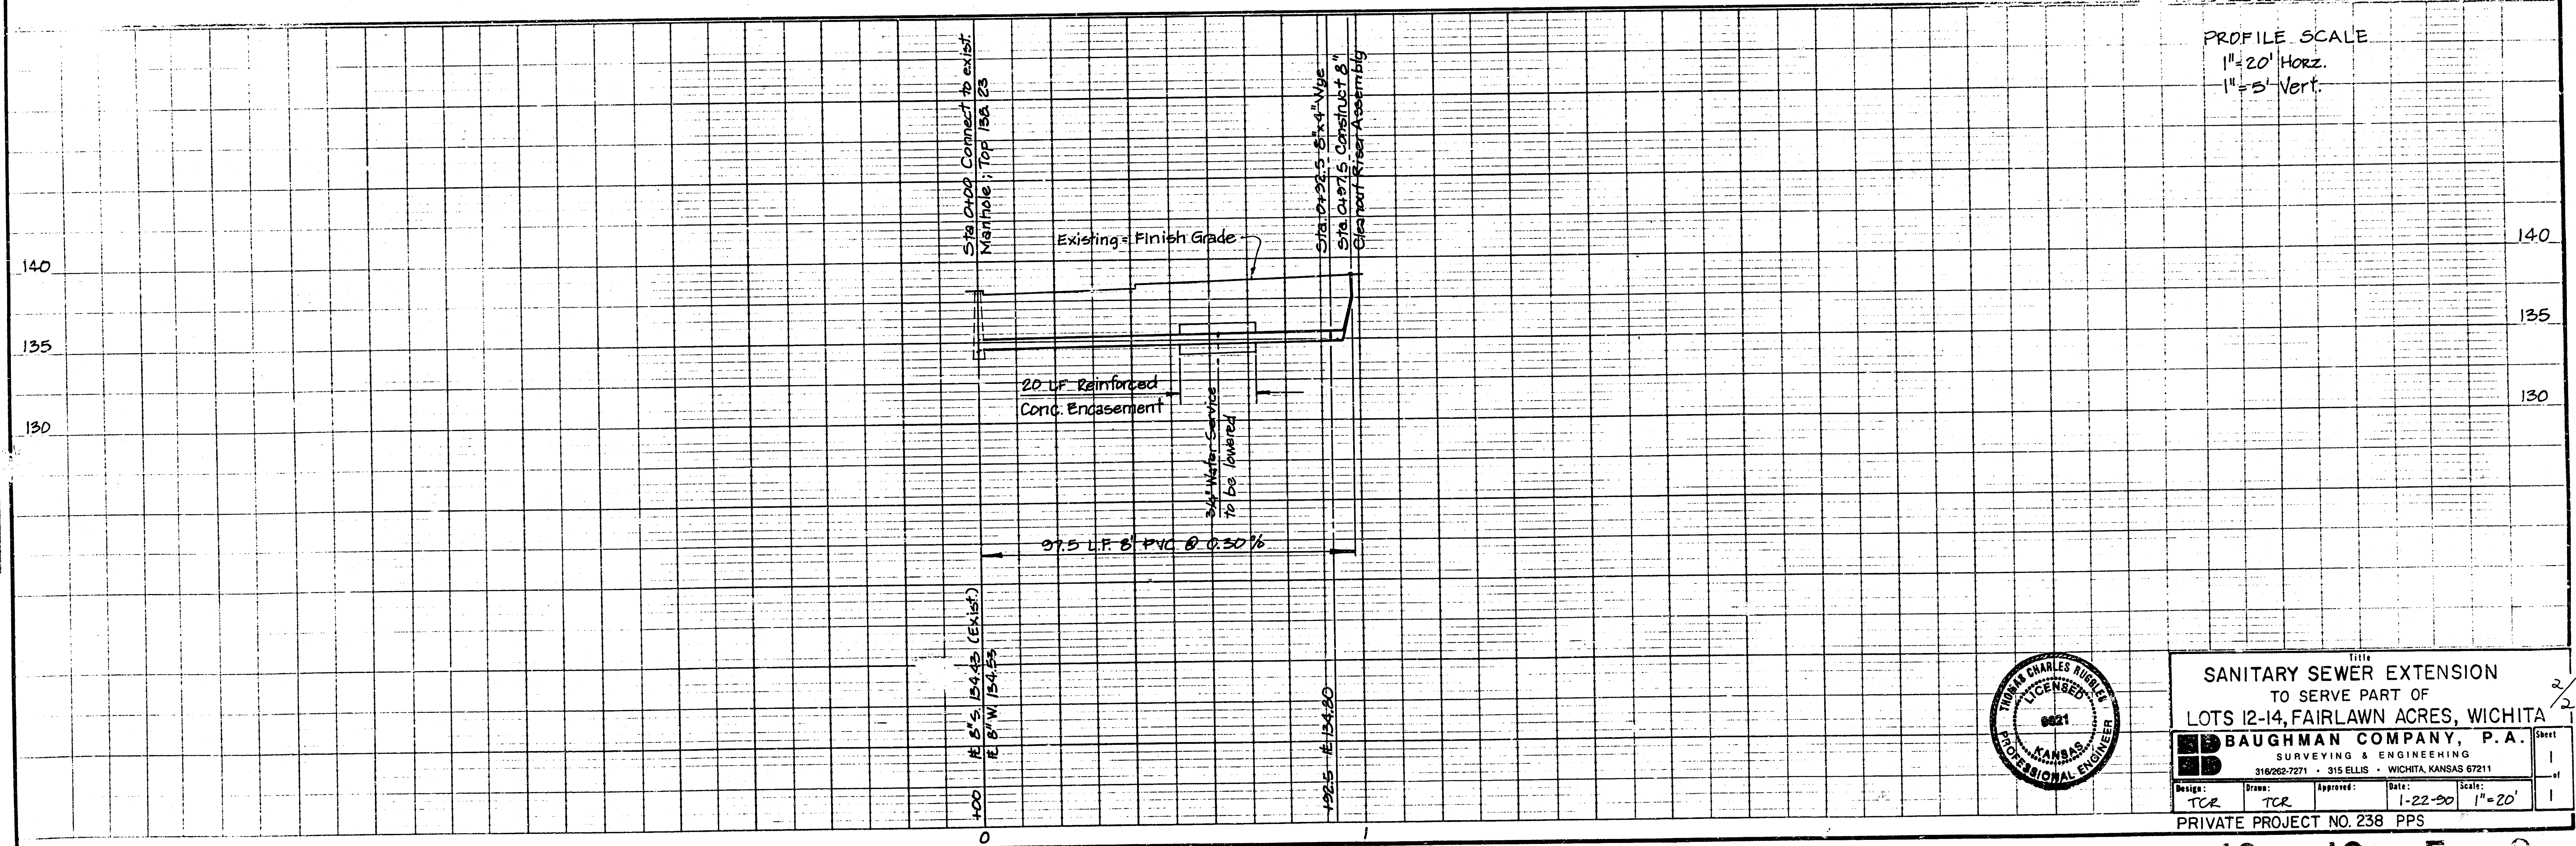

Title			
SANITARY SEWER EXTENSION			
TO SERVE PART OF			
LOTS 12-14, FAIRLAWN ACRES, WICHITA			
BY BAUGHMAN COMPANY, P.A.			
SURVEYING & ENGINEERING			
316/262-7271 • 315 ELLIS • WICHITA, KANSAS 67211			
Drawn:	TCR	Checked:	TCR
Date:	1-22-90	Scale:	1"=20'
PRIVATE PROJECT NO. 238 PPS			