
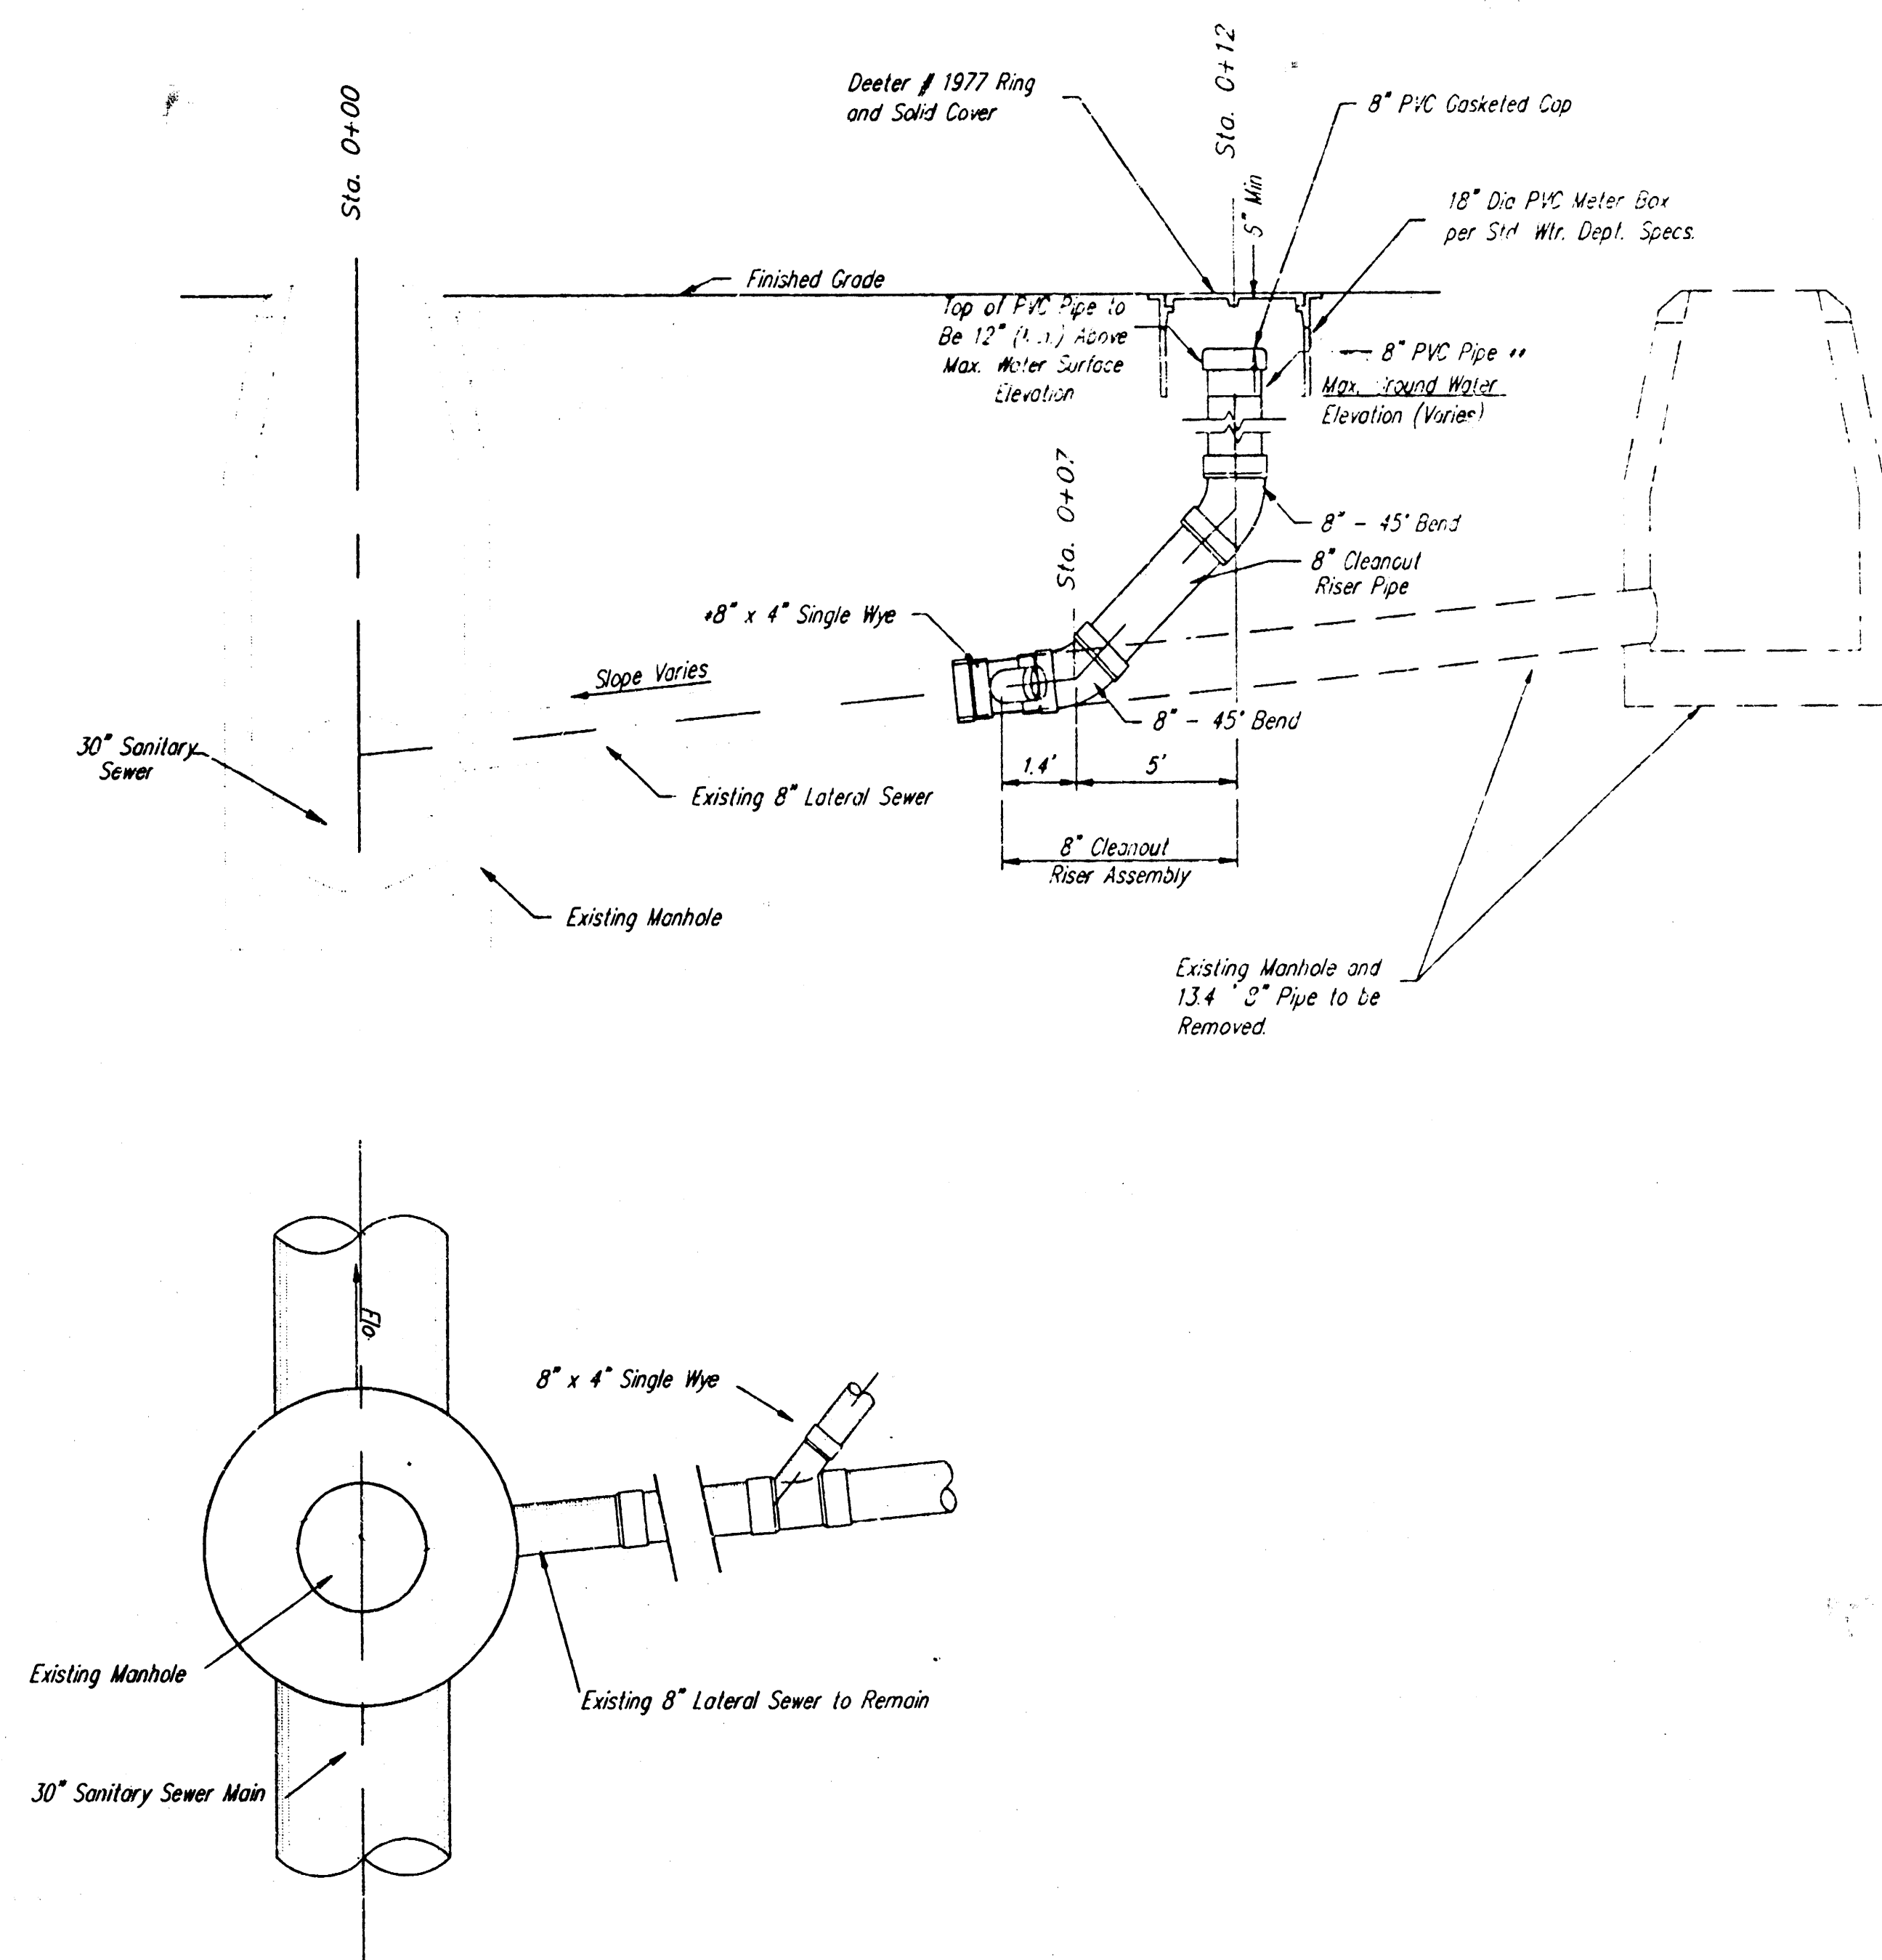


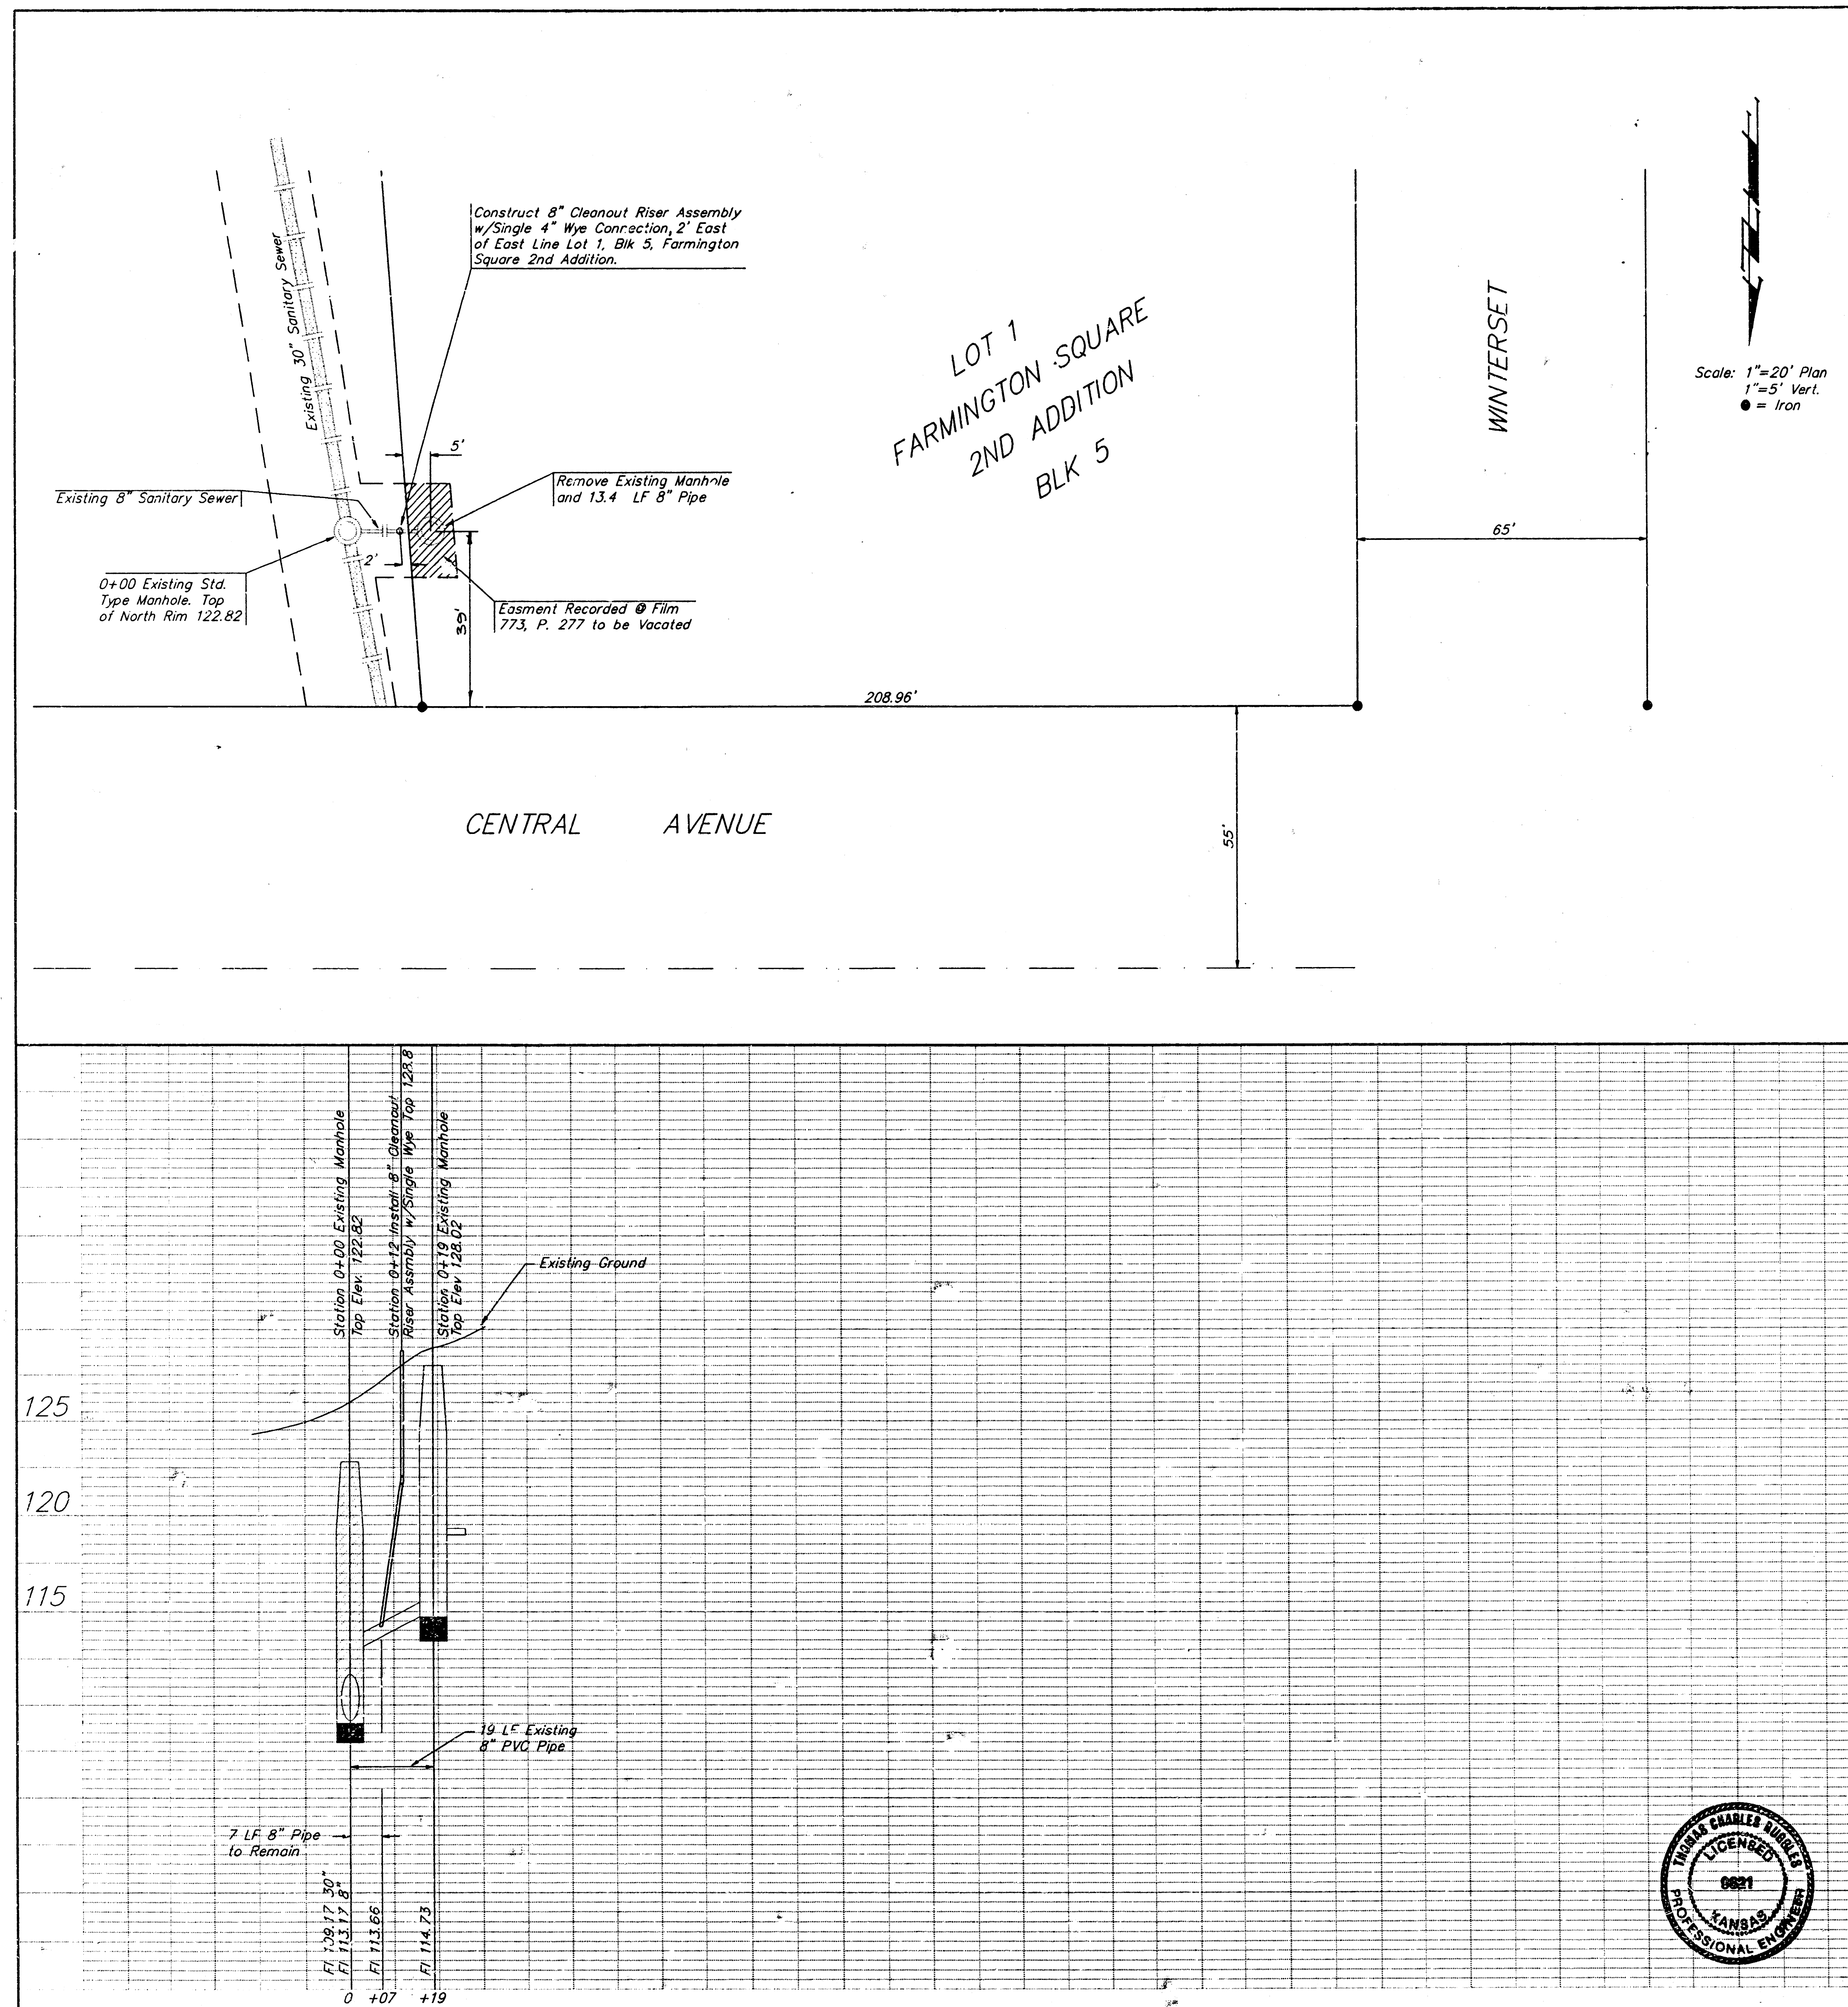

8" CLEANOUT RISER ASSEMBLY DETAIL

APPROVED AS NOTED  
BY CITY ENGINEER OF WICHITA

Sanitary Sewers RM 7/10/91

Storm Sewers \_\_\_\_\_


Driveway Approaches \_\_\_\_\_

Water Mains \_\_\_\_\_

Paving \_\_\_\_\_

NOTE TO CONTRACTORS

Inspection and testing for this project is to be provided by a Licensed Consulting Engineering Firm under contract with the Owner/Developer. Said inspection to be in accordance with the City of Wichita standard construction engineering practices and certified by a Licensed Professional Engineer. No work shall be performed in dedicated easements or public right-of-way by the Contractor without such inspection nor shall any work be commenced without written authorization by the City Engineer.

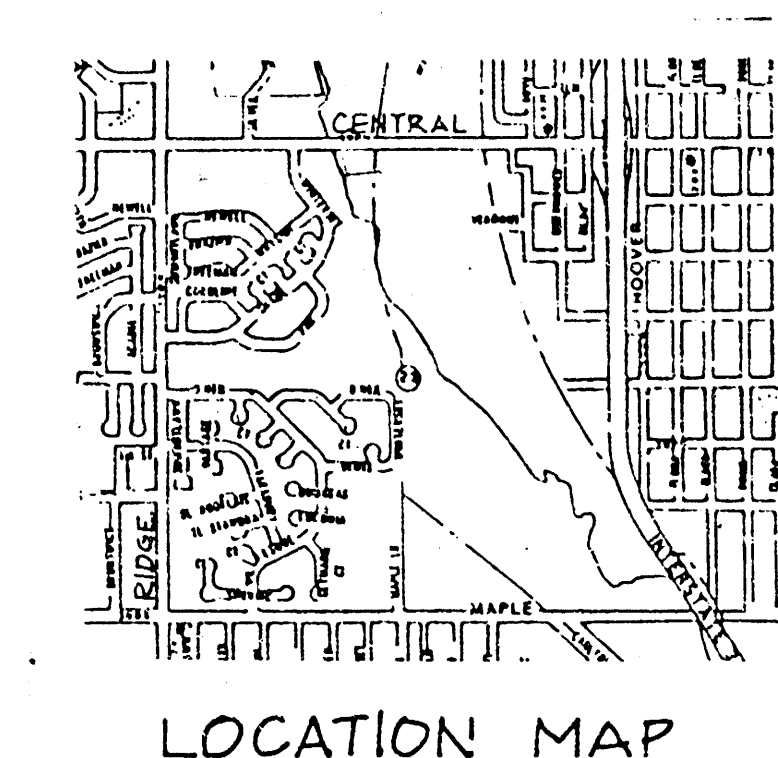

Booked 3/13/92  
JKB

No Revision as built 5-4-91

PART OF LOT 1, BLK 5, FARMINGTON SQUARE 2ND ADDITION  
SANITARY SEWER IMPROVEMENTS

BAUGHMAN COMPANY P. A.  
ENGINEERING & SURVEYING  
316/262-7271 • 315 ELLIS • WICHITA, KANSAS 67211

PROJECT NUMBER  
293 FPS (607861)

|               |              |          |                   |                   |
|---------------|--------------|----------|-------------------|-------------------|
| DESIGN<br>TCR | DRAWN<br>MPS | APPROVED | DATE<br>JUNE 1991 | SCALE<br>AS NOTED |
|---------------|--------------|----------|-------------------|-------------------|

REV. 1  
SHEET 1 OF 1

