


Bench Mark: Square Cut in Top of Curb
14' North of Manhole @ Sta. 0+00
Elevation = 86.69 City Datum.

Bench Mark: Nail in Cap, located 30'
East of Manhole @ Sta. 3+85.9
Elevation = 86.69 City Datum

Scale: 1" = 20' Plan
1" = 5' Profile

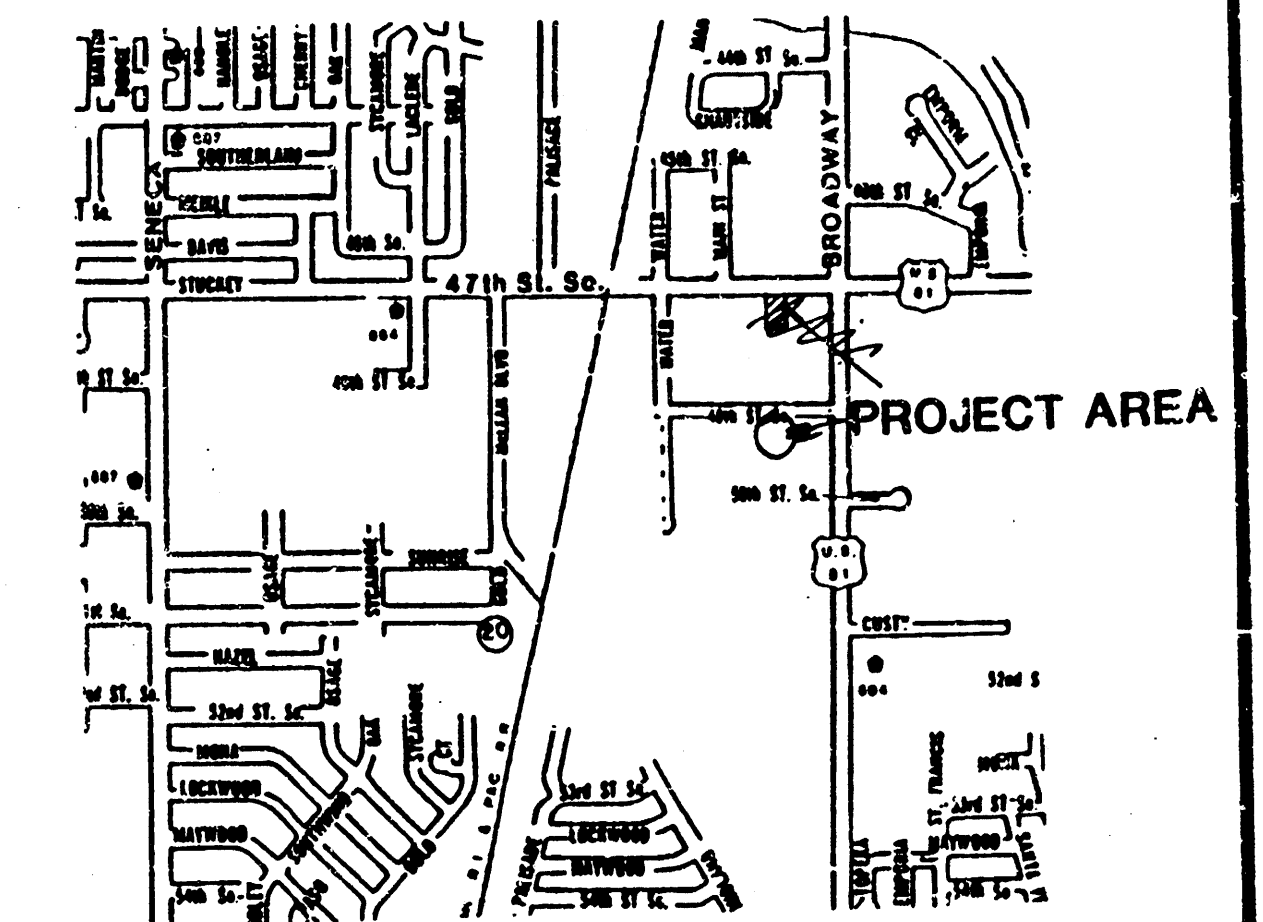

GENERAL NOTES

Existing utility lines and their location, as shown on the plans, represent the best information obtainable for design. The Contractor will be required to work around existing utilities which do not conflict with proposed construction.

The contractor shall be responsible for locating all underground utility lines prior to construction of the sanitary sewer. This includes all public and private utilities that may be present on the site.

NOTE TO CONTRACTOR

INSPECTION AND TESTING FOR THIS PROJECT IS TO BE PROVIDED BY A LICENSED CONSULTING ENGINEERING FIRM UNDER CONTRACT WITH THE OWNER/DEVELOPER. SAME INSPECTION TO BE IN ACCORDANCE WITH THE CITY OF WICHITA STANDARD CONSTRUCTION ENGINEERING PRACTICES AND PERFORMED BY A LICENSED PROFESSIONAL ENGINEER. ANY WORK SHALL BE PERFORMED WITHIN THE CITY OF WICHITA. THE CONTRACTOR SHALL BE RESPONSIBLE FOR LOCATING ALL UTILITIES PRIOR TO CONSTRUCTION. ANY WORK SHALL BE PERFORMED WITHIN THE CITY OF WICHITA. THE CONTRACTOR SHALL BE RESPONSIBLE FOR LOCATING ALL UTILITIES PRIOR TO CONSTRUCTION.

APPROVED AS NOTED
BY CITY ENGINEER OF WICHITA

Sanitary Sewers *KRH 7/17/89*
Storm Sewers
Driveway Approaches
Water Mains
Paving



REVISED AS BUILT 7-25-89

INDEX CODE 222 PPS

PRIVATE SANITARY SEWER RELOCATION
TO SERVE LOT 1, FIREBALL ADDITION
CITY OF WICHITA, KANSAS

BAUGHMAN COMPANY, P.A.
SURVEYING & ENGINEERING
3102008-7271 315 ELLIS - WICHITA, KANSAS 67211

Drawn:	C. Bohm	Checked:	C. Bohm	Approved:	N.B.W.	Date:	7/89	Scale:	Noted
--------	---------	----------	---------	-----------	--------	-------	------	--------	-------

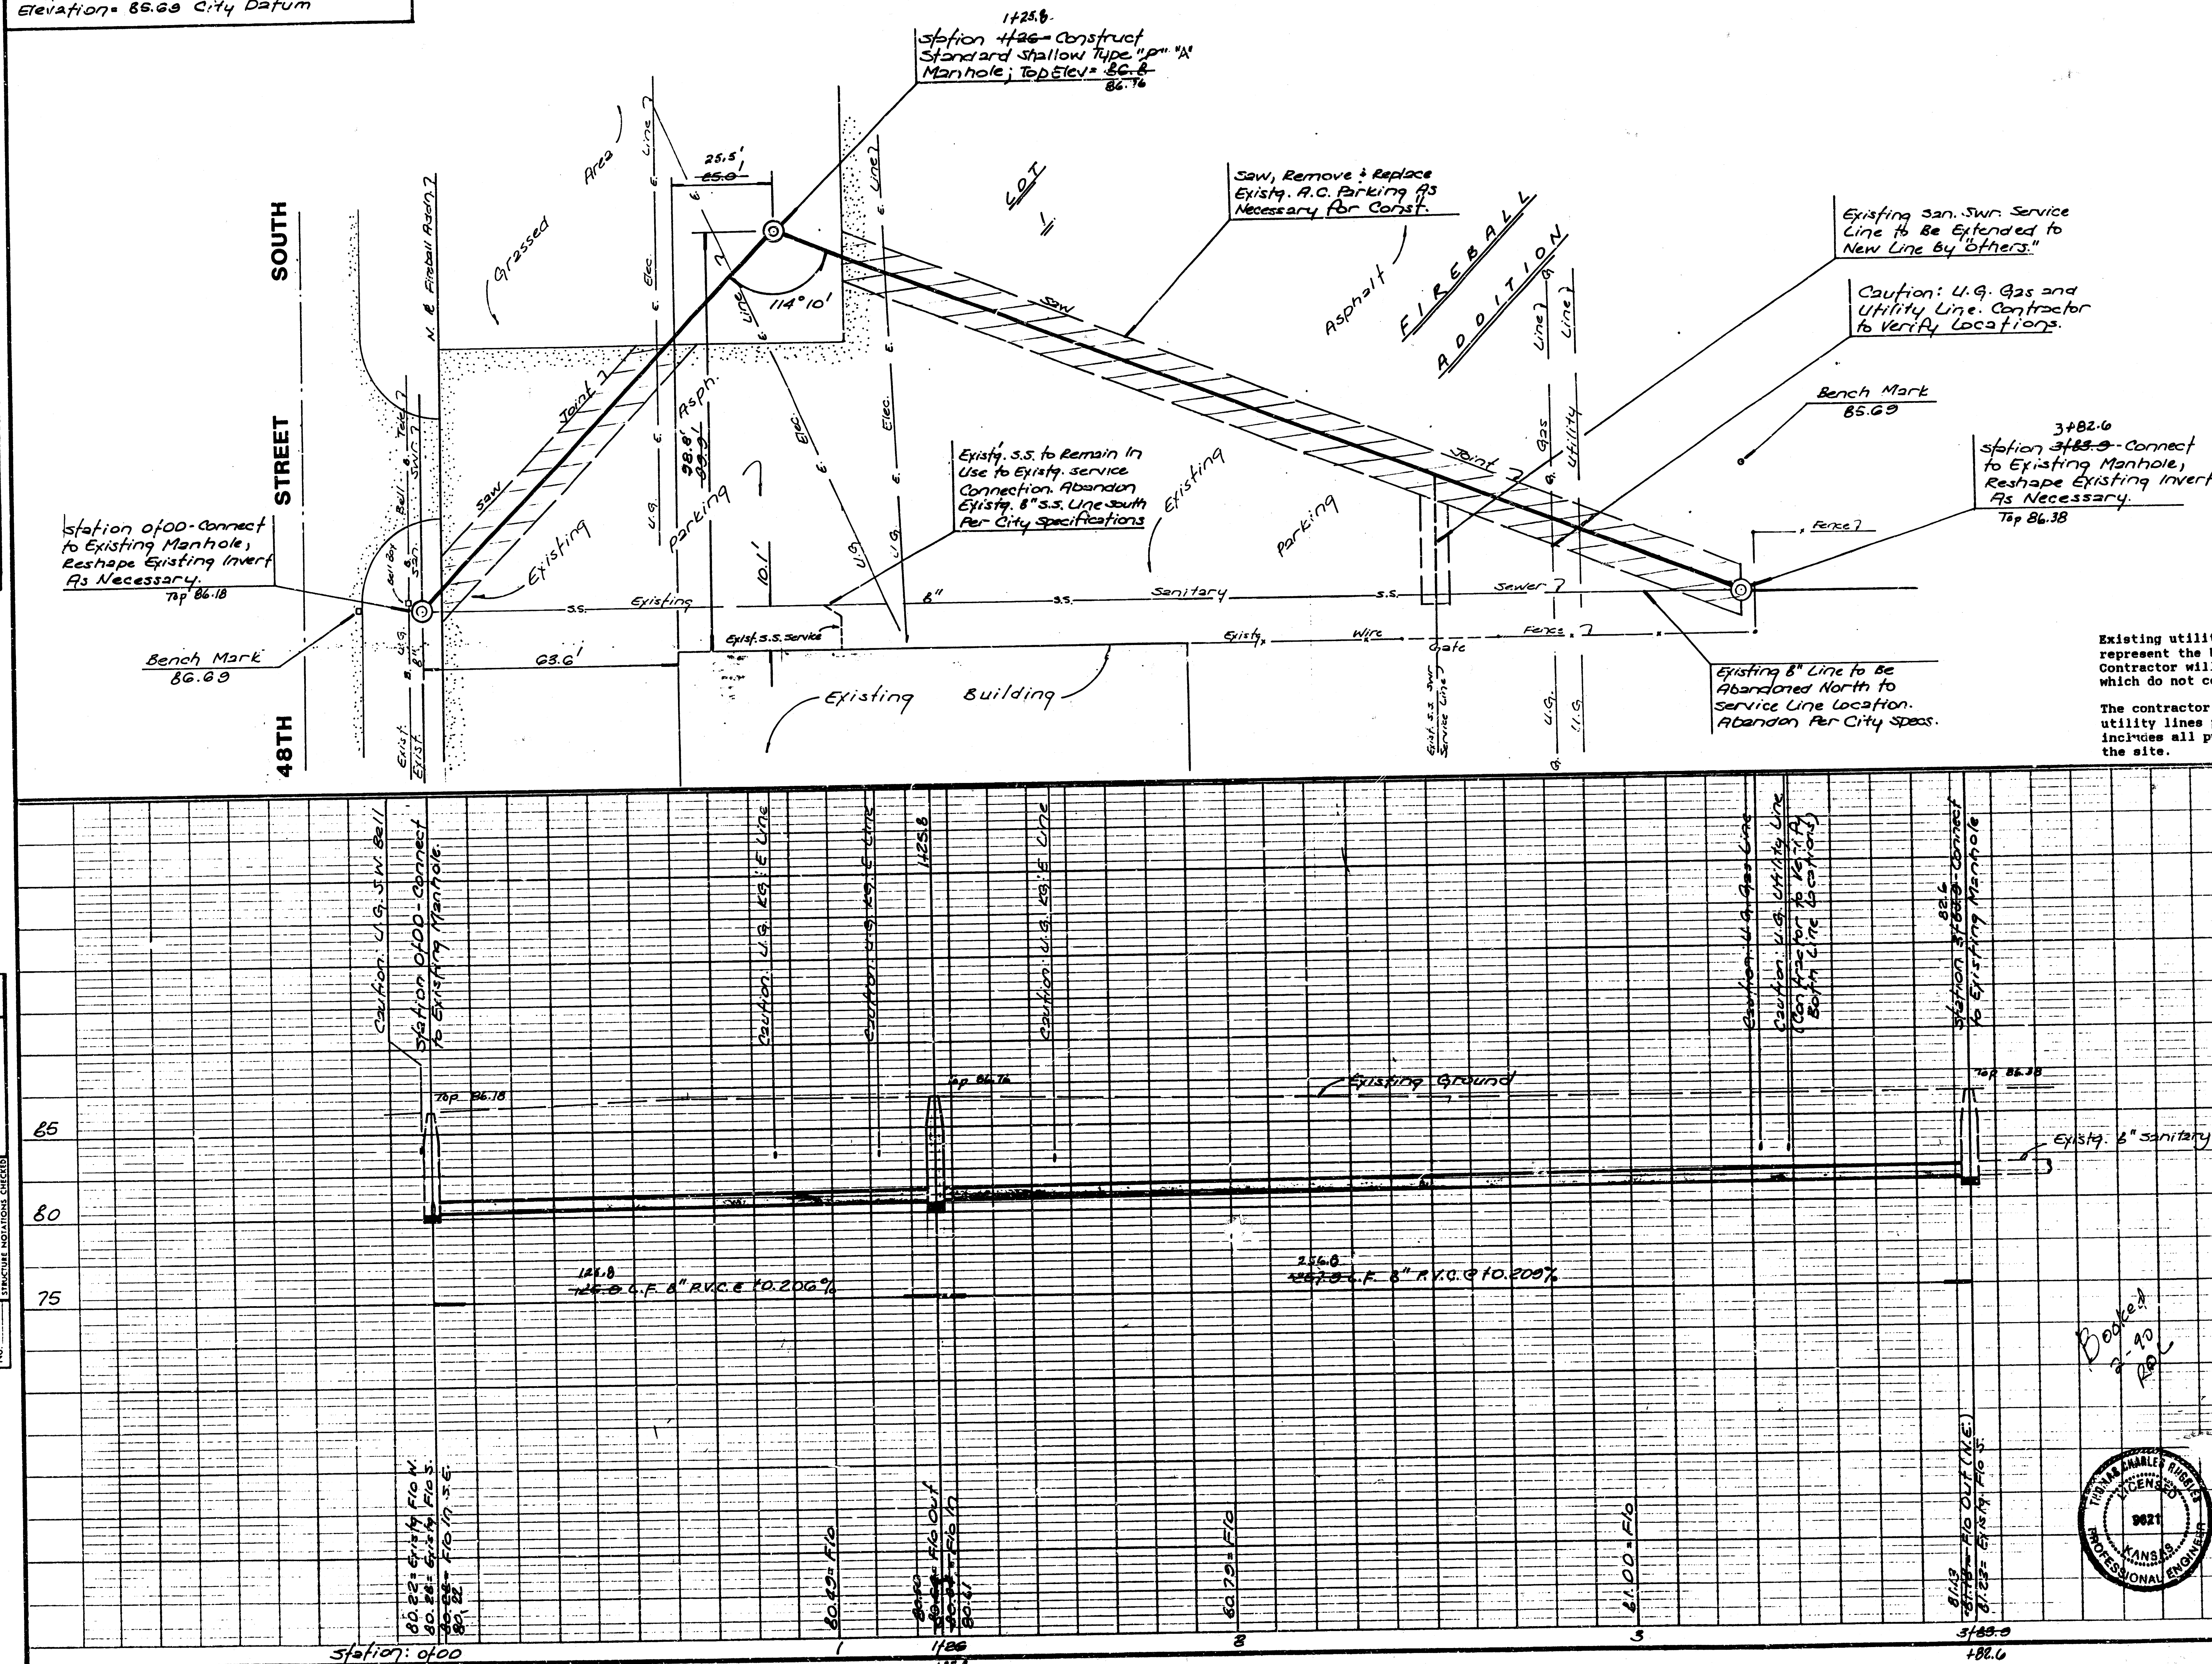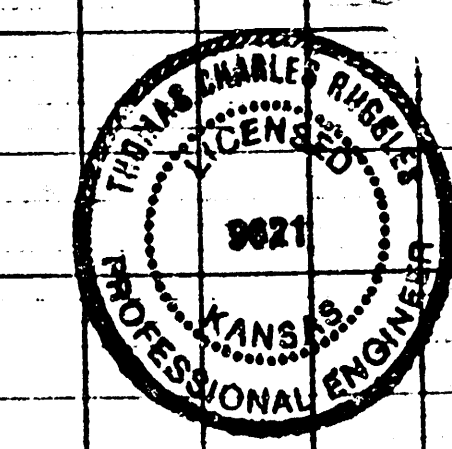


FILMED FROM THE BEST
AVAILABLE COPY....


Bench Mark: Square Cut in Top of Curb
14' North of Manhole @ Sta. 0+00
Elevation: 86.69 City Datum.

Bench Mark: Nail in Cap, located 30'
East of Manhole @ Sta. 3+83.9
Elevation: 86.69 City Datum

Scale: 1"=20' Plan
1"=5' Profile

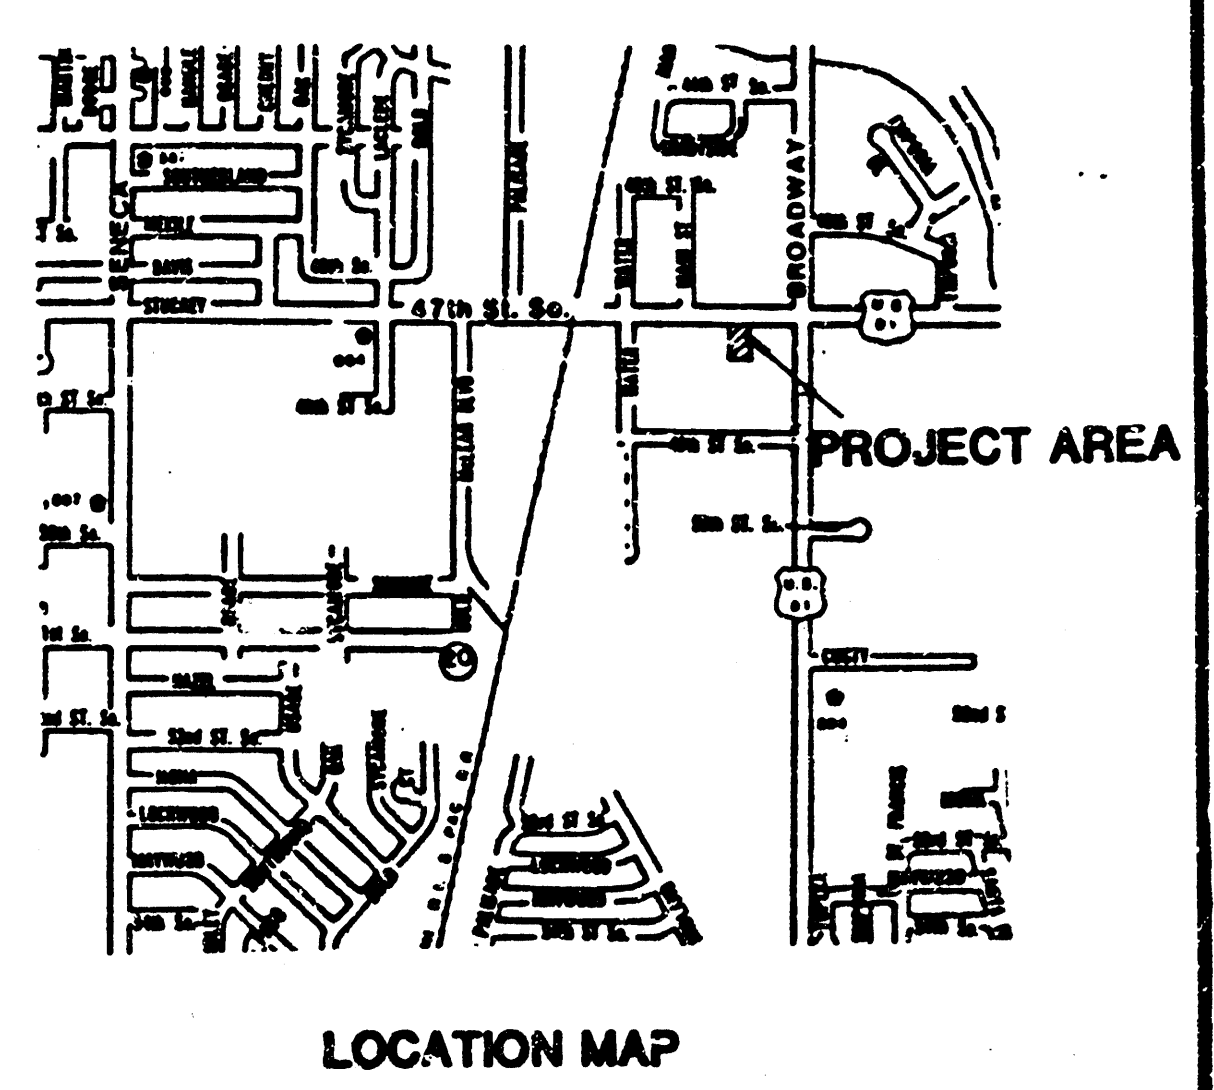

PLAN	NOTES
1	NOTE: SEE PLAN FOR ALL DIMENSIONS AND LOCATIONS.
2	NOTE: SEE PLAN FOR ALL DIMENSIONS AND LOCATIONS.
3	NOTE: SEE PLAN FOR ALL DIMENSIONS AND LOCATIONS.
4	NOTE: SEE PLAN FOR ALL DIMENSIONS AND LOCATIONS.
5	NOTE: SEE PLAN FOR ALL DIMENSIONS AND LOCATIONS.
6	NOTE: SEE PLAN FOR ALL DIMENSIONS AND LOCATIONS.
7	NOTE: SEE PLAN FOR ALL DIMENSIONS AND LOCATIONS.
8	NOTE: SEE PLAN FOR ALL DIMENSIONS AND LOCATIONS.
9	NOTE: SEE PLAN FOR ALL DIMENSIONS AND LOCATIONS.
10	NOTE: SEE PLAN FOR ALL DIMENSIONS AND LOCATIONS.

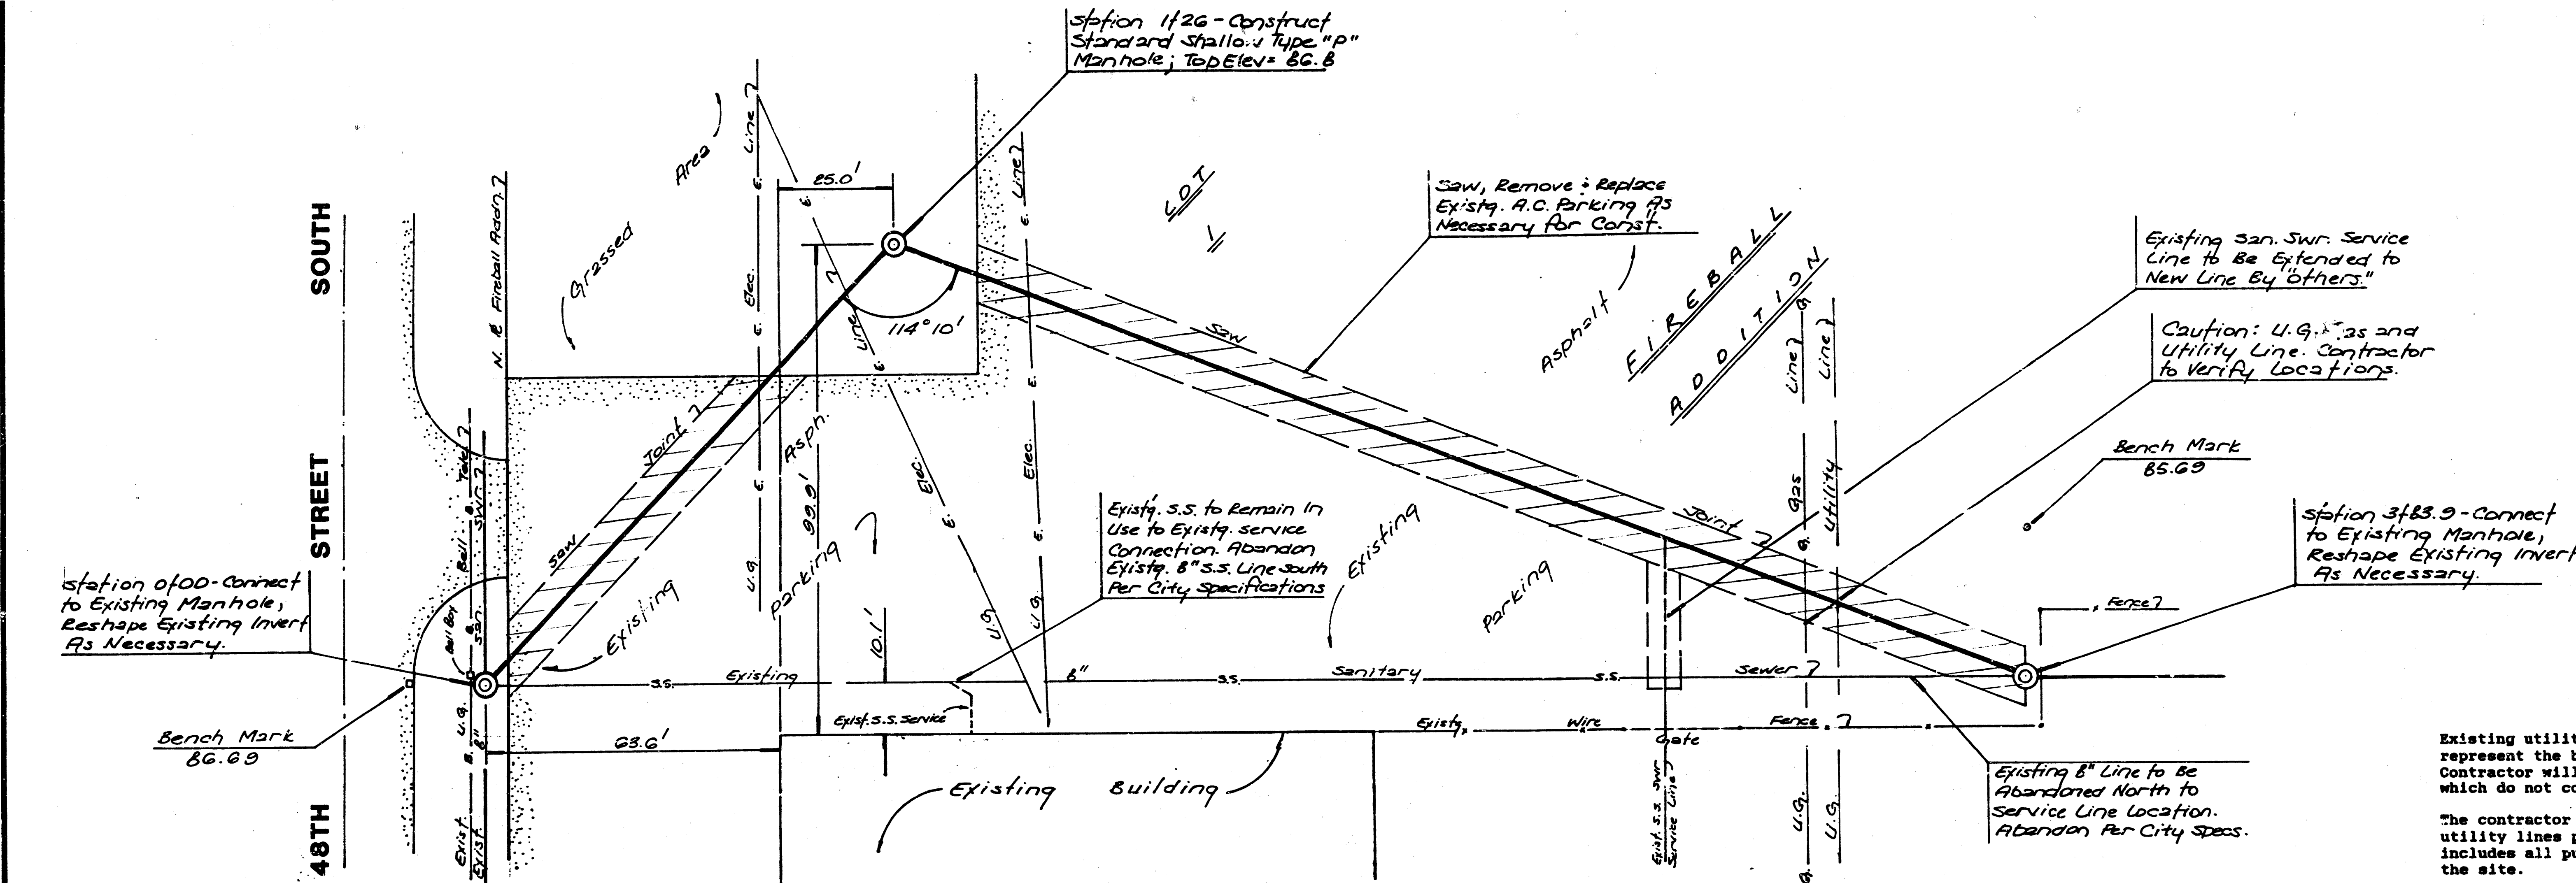


GENERAL NOTES

Existing utility lines and their location, as shown on the plans, represent the best information obtainable for design. The Contractor will be required to work around existing utilities which do not conflict with proposed construction.

The contractor shall be responsible for locating all underground utility lines prior to construction of the sanitary sewer. This includes all public and private utilities that may be present on the site.

PROFILE	NOTES
1	NOTE: SEE PROFILE FOR ALL ELEVATIONS AND SLOPES.
2	NOTE: SEE PROFILE FOR ALL ELEVATIONS AND SLOPES.
3	NOTE: SEE PROFILE FOR ALL ELEVATIONS AND SLOPES.
4	NOTE: SEE PROFILE FOR ALL ELEVATIONS AND SLOPES.
5	NOTE: SEE PROFILE FOR ALL ELEVATIONS AND SLOPES.
6	NOTE: SEE PROFILE FOR ALL ELEVATIONS AND SLOPES.
7	NOTE: SEE PROFILE FOR ALL ELEVATIONS AND SLOPES.
8	NOTE: SEE PROFILE FOR ALL ELEVATIONS AND SLOPES.
9	NOTE: SEE PROFILE FOR ALL ELEVATIONS AND SLOPES.
10	NOTE: SEE PROFILE FOR ALL ELEVATIONS AND SLOPES.

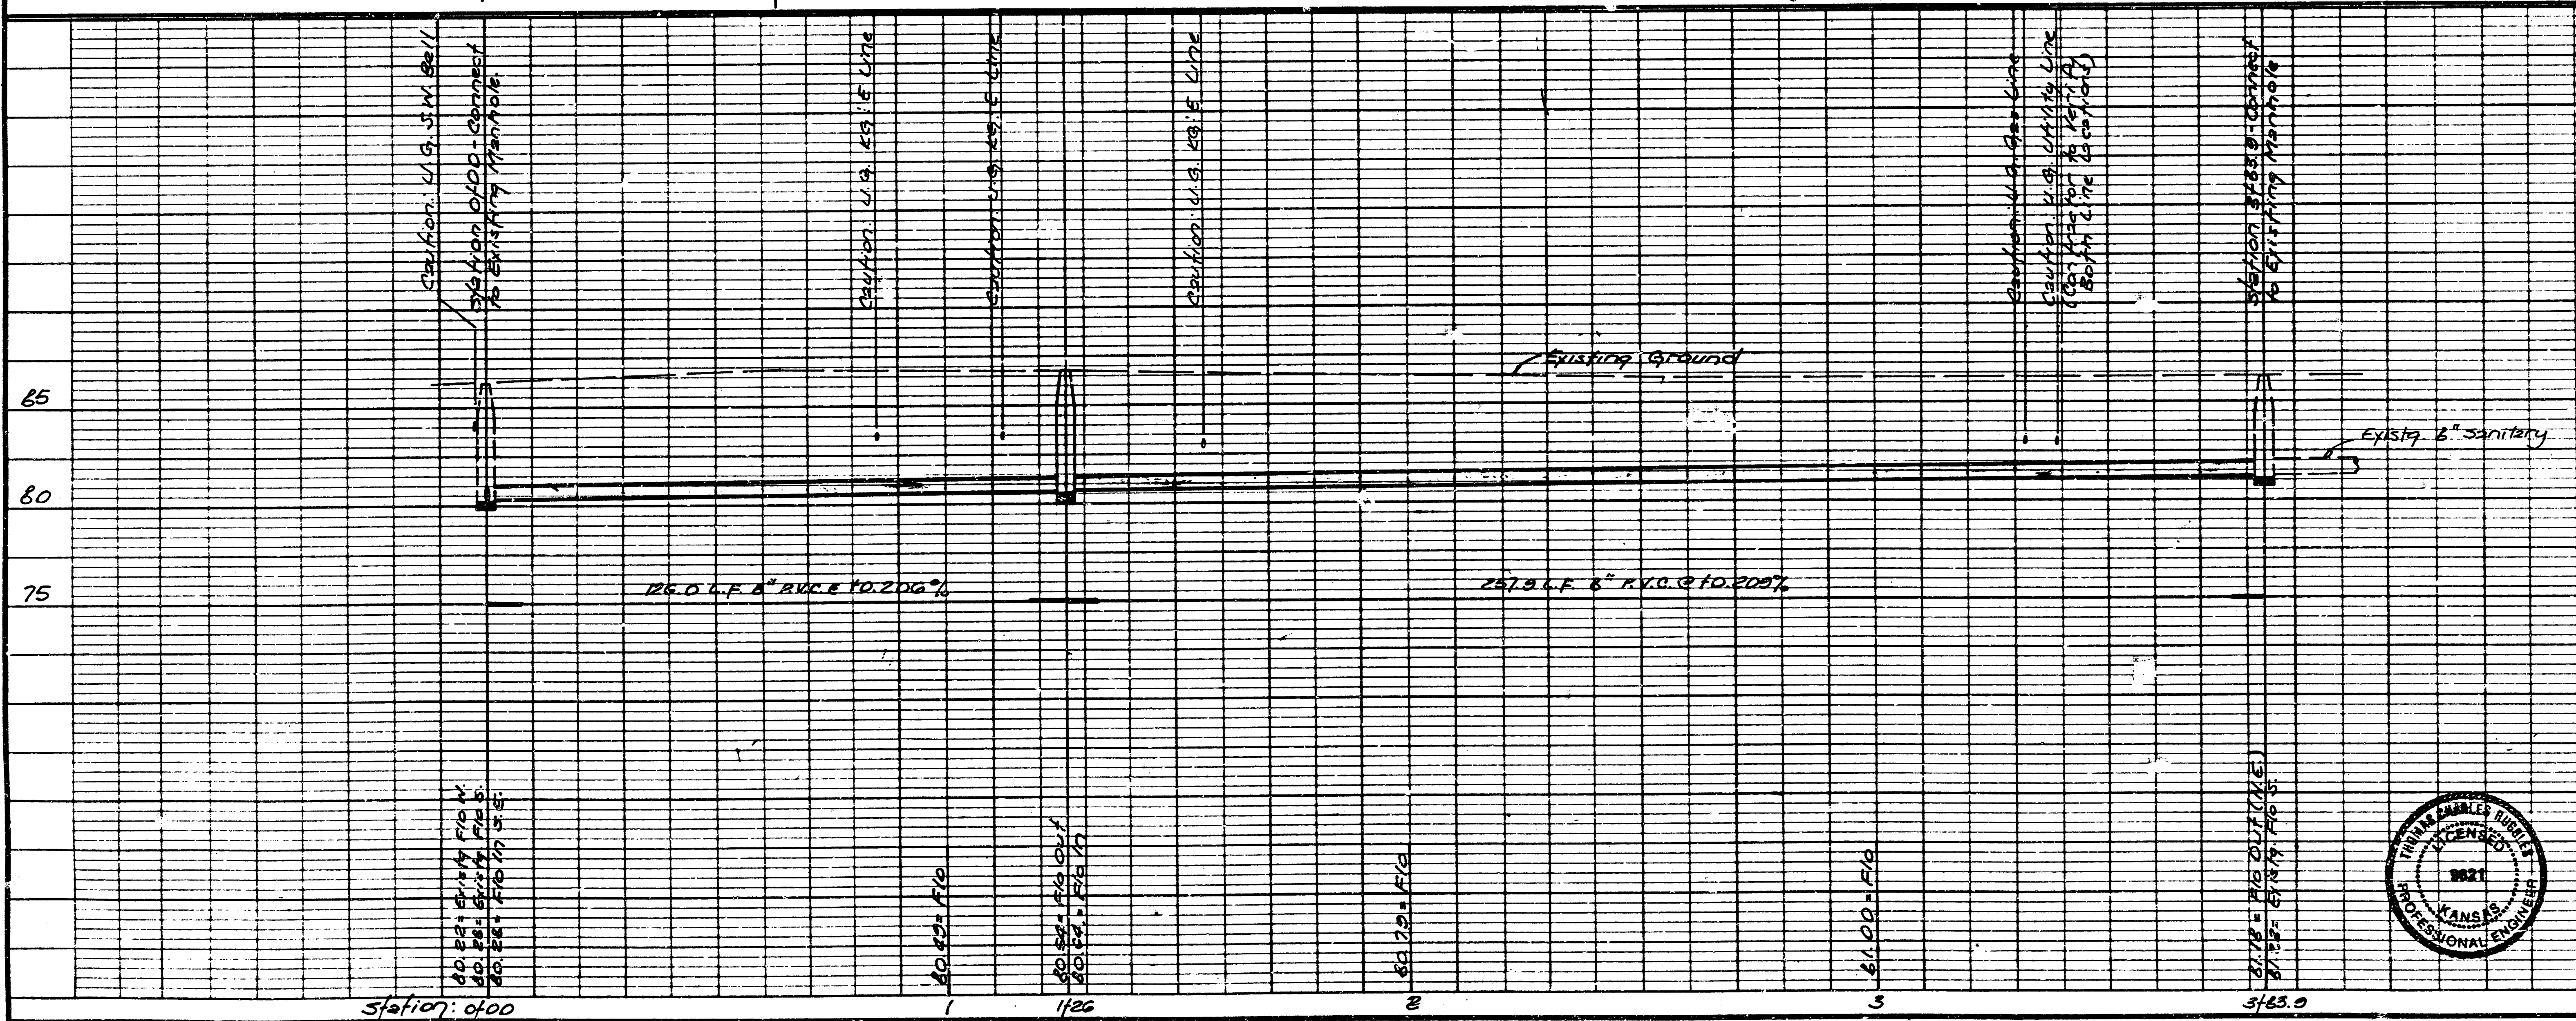

NOTE TO CONTRACTOR

INSPECTION AND TESTING FOR THIS PROJECT IS TO BE PROVIDED BY A LICENSED CONSULTING ENGINEERING FIRM UNDER CONTRACT WITH THE CITY OF WICHITA. THE CONTRACTOR SHALL BE RESPONSIBLE FOR THE PROTECTION OF ALL EXISTING UTILITIES AND STRUCTURES. ANY DAMAGE TO EXISTING UTILITIES OR STRUCTURES SHALL BE REPAIRED BY THE CONTRACTOR AT HIS OWN EXPENSE. THE CONTRACTOR SHALL BE RESPONSIBLE FOR THE PROTECTION OF ALL EXISTING UTILITIES AND STRUCTURES. ANY DAMAGE TO EXISTING UTILITIES OR STRUCTURES SHALL BE REPAIRED BY THE CONTRACTOR AT HIS OWN EXPENSE.

APPROVED AS NOTED

CITY ENGINEER OF WICHITA

Sanitary Sewers VRH 1/1/89

Storm Sewers _____


Driveway Approaches _____

Water Mains _____

Paving _____

INDEX CODE 222 PPS

PRIVATE SANITARY SEWER RELOCATION TO SERVE LOT 1, FIREBALL ADDITION CITY OF WICHITA, KANSAS

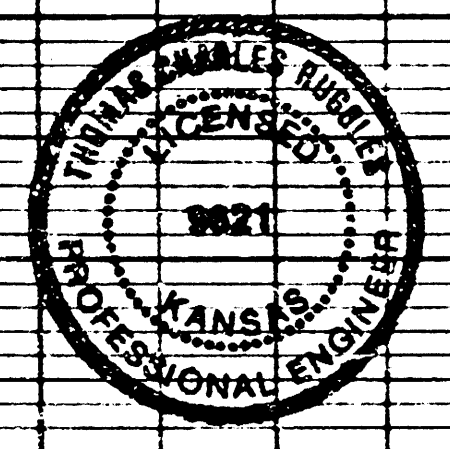

BAUGHMAN COMPANY, P.A.	Sheet
SURVEYING & ENGINEERING	1 2/2
31022-7271 • 315 ELLIS • WICHITA, KANSAS 67211	
Drawn: C. Baughman	Checked: N.B.W.
Date: 7/89	Scale: Noted
2	

FILMED FROM THE BEST AVAILABLE COPY.....