


Nowak Construction Co, Inc. Contractor  
 RB- Inspectors  
 Released 11/2/05  
 As-Built  
 .pdf by JDL 11/3/05

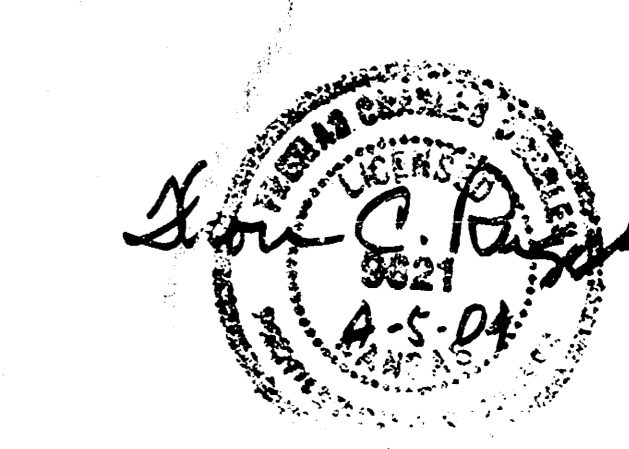

AS BUILT		FRIENDS UNIVERSITY 3RD ADDITION SANITARY SEWER RECONSTRUCTION WICHITA, KANSAS	
	Ruggles & Bohm, P.A. Engineering, Surveying, Land Planning		DESIGN TCR
	924 North Main Wichita, Kansas 67203 www.rbkansas.com (316) 264-8008 (316) 264-4621 fax E-mail: info@rbkansas.com		DRAWN EJB
DRAWING FILE Base {As Built}	PROJECT NUMBER 1411 PPS (607861)	DATE Apr. 5, 2004	REVIEW EJB
			UTILITY
			SHEET 1 OF 1