


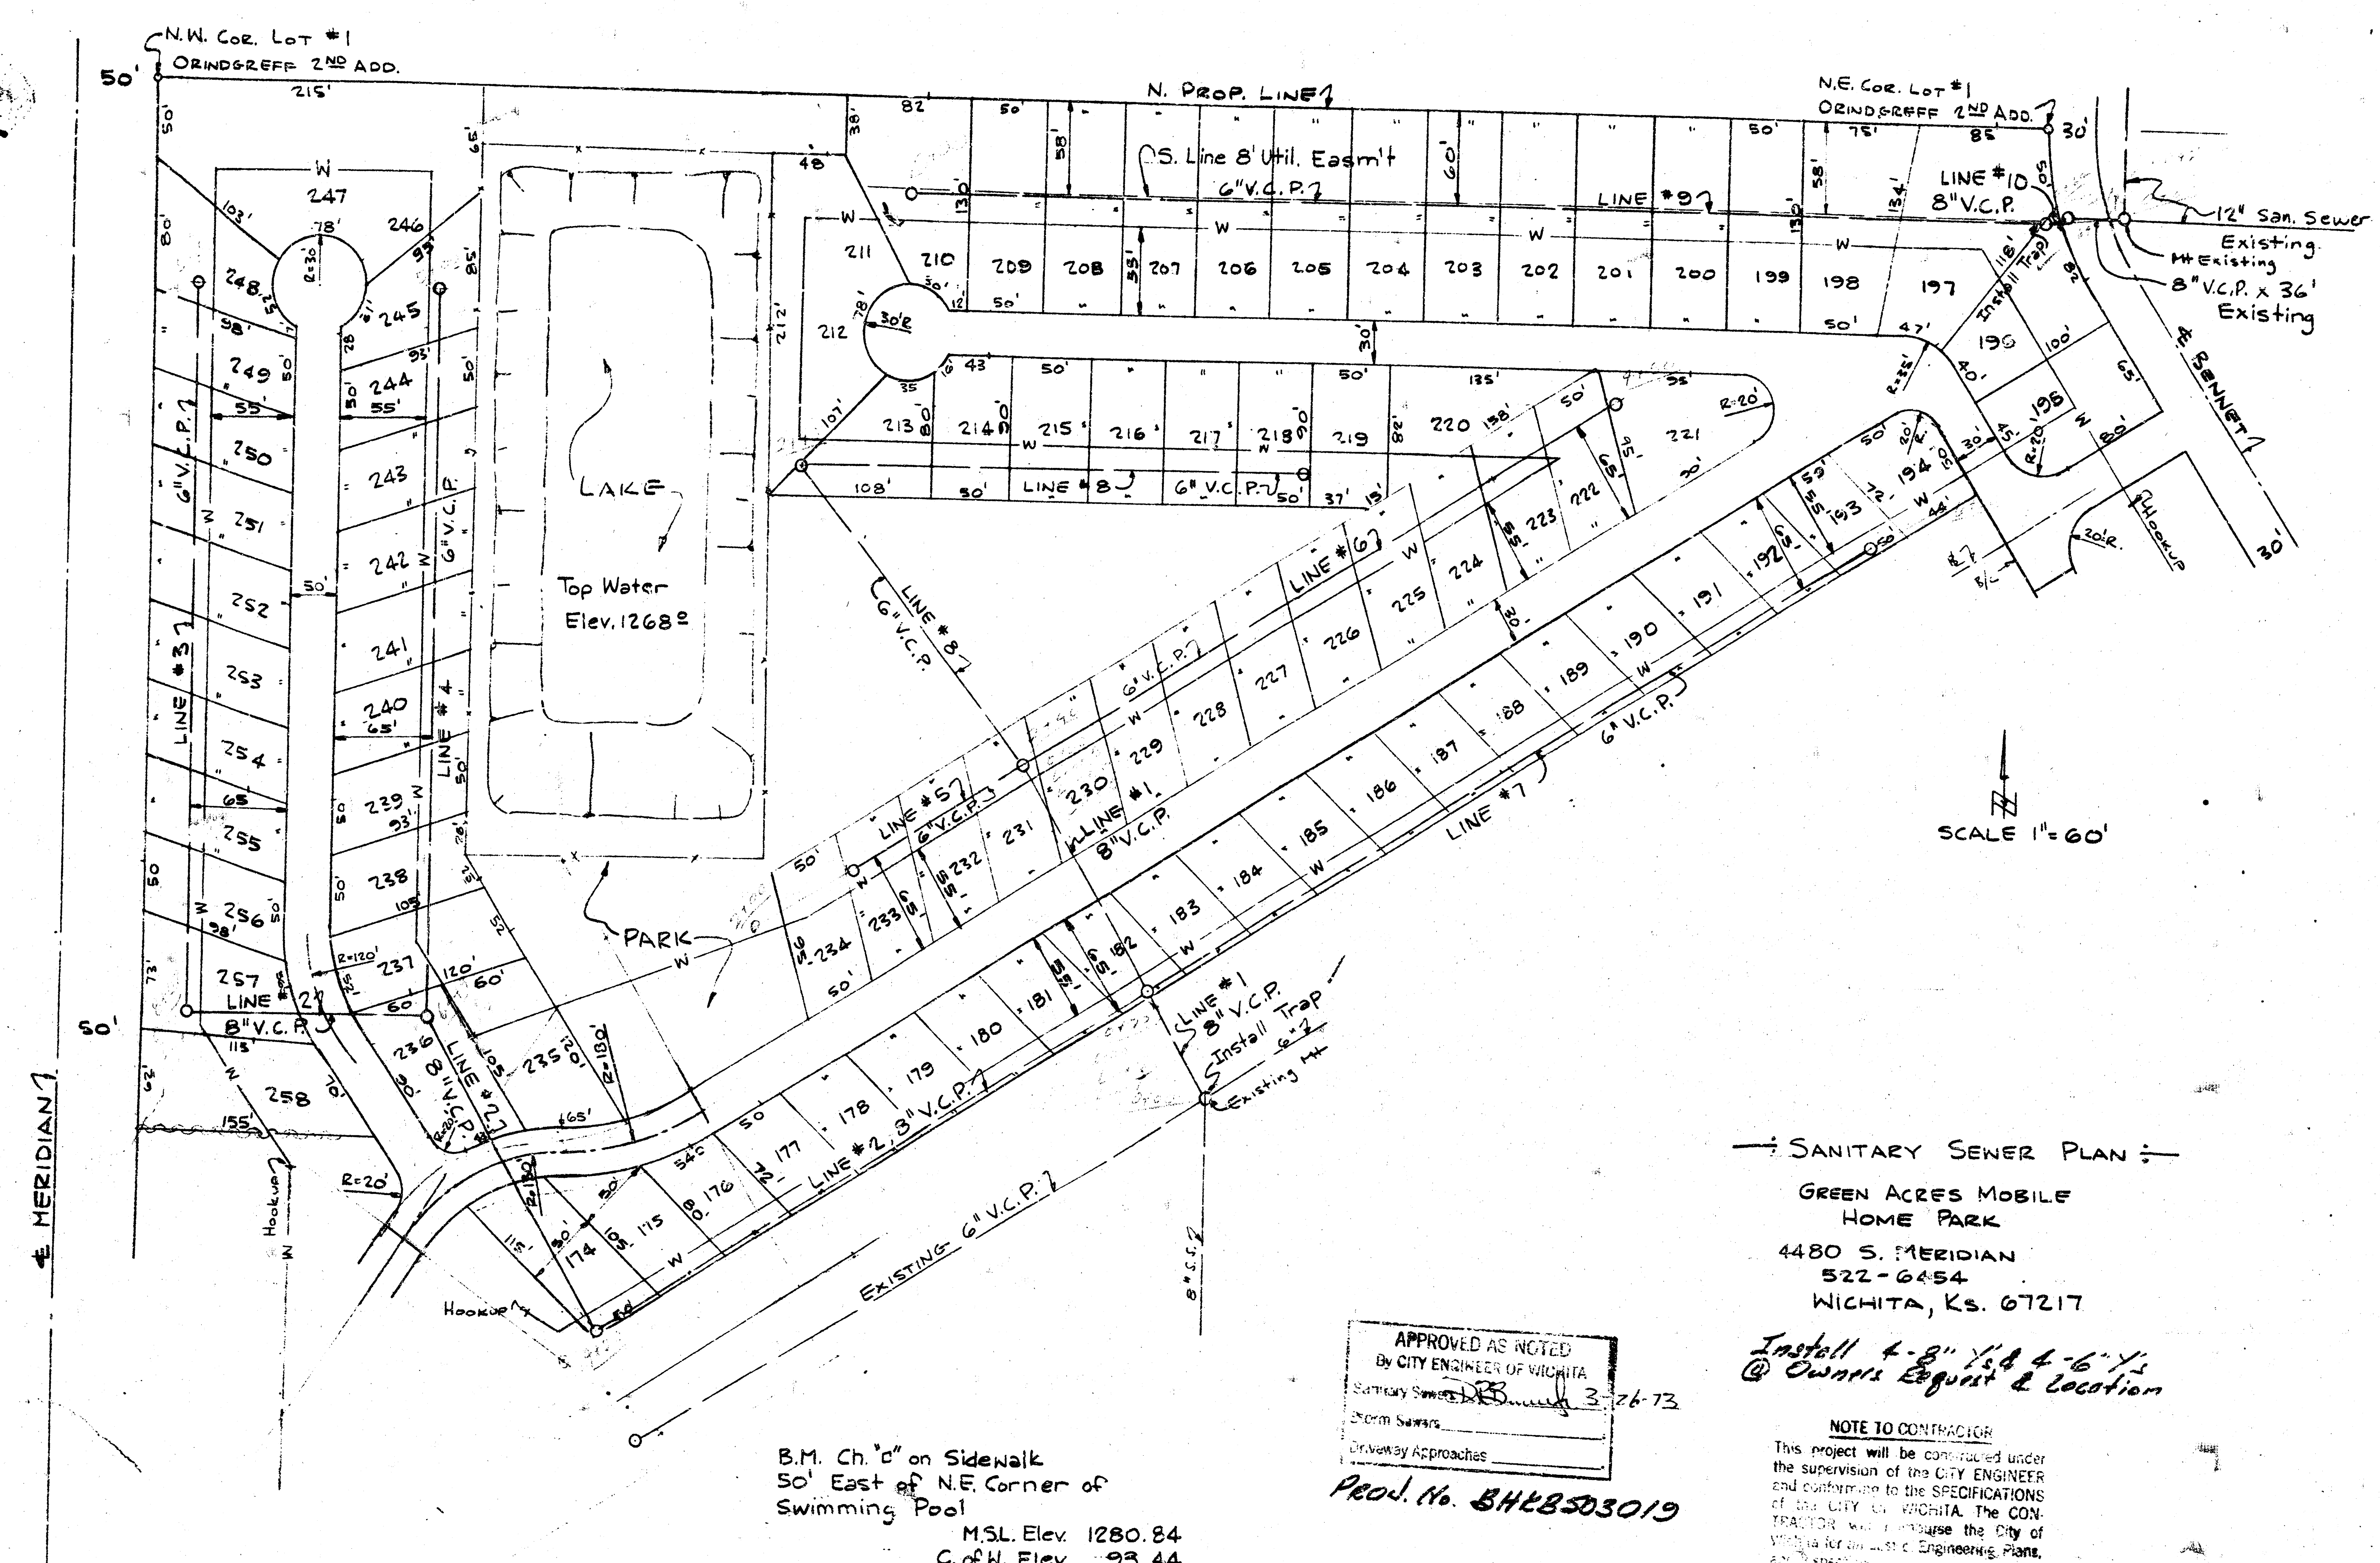

— SANITARY SEWER PLAN —
GREEN ACRES MOBILE
HOME PARK
4480 S. MERIDIAN
522-6454
WICHITA, KS. 67217


Install 4-8" V.C.P. & 6-4"
@ Owners Request & Location

NOTE TO CONTRACTOR
This project will be constructed under
the supervision of the CITY ENGINEER
and conform to the SPECIFICATIONS
of the CITY OF WICHITA. The CON-
TRACTOR will reimburse the City of
Wichita for an extra Engineering Plan,
and inspection.

Submit As Built Plans
Showing location of all V's
installed & changes in Orig. Plan

LINE #7	NOTE	LINE #8	NOTE	LINE #9	NOTE
0+00	M+	0+00	M+	0+00	M+
0+38	Y	1+00	Y	0+20	Y
0+58	Y	2+43	M+	1+10	Y
1+28	Y	2+65	Y	1+72	Y
1+58	Y	3+60	Y	2+22	Y
2+58	Y	4+00	Y	2+72	Y
2+88	Y	4+50	Y	3+22	Y
3+28	Y	5+00	Y	3+72	Y
3+58	Y	5+50	Y	4+22	Y
4+28	Y	5+73	M+	4+72	Y
4+58	Y			5+22	Y
5+28	Y			5+72	Y
5+58	Y			6+22	Y
6+00	M+			6+72	Y
				7+22	Y
				8+00	M+

GREEN RIDGE MOBILE HOME RESORT "Y" LOCATIONS SAN. SERIES					
No Y's	LINE #1	LINE #3	NOTE	LINE #5	NOTE
0+00	MT	0+00	MT	0+00	MT
0+08	Y	0+31	Y	0+49	Y
0+58	Y	0+81	Y	0+98	Y
1+08	Y	1+31	Y	1+47	Y
1+58	Y	1+81	Y	1+96	Y
2+08	Y	2+31	Y	2+00	MT
2+58	Y	2+81	Y		
3+08	Y	3+31	Y	LINE #6	
3+58	Y	3+81	Y	0+00	MT
4+20	MT	4+31	Y	0+49	Y
4+58	Y	4+81	Y	0+98	Y
5+09	Y	5+10	MT	1+47	Y
6+09	Y			1+96	Y
7+35	Y	LINE #4		2+45	Y
8+09	MT	0+00	MT	2+94	Y
		0+20	Y	3+43	Y
		0+70	Y	3+92	Y
		1+20	Y	4+30	MT
		1+70	Y		
		2+20	Y		
		2+70	Y		
		3+20	Y		
		3+70	Y		
		4+20	Y		
		5+15	Y		
		5+25	MT		

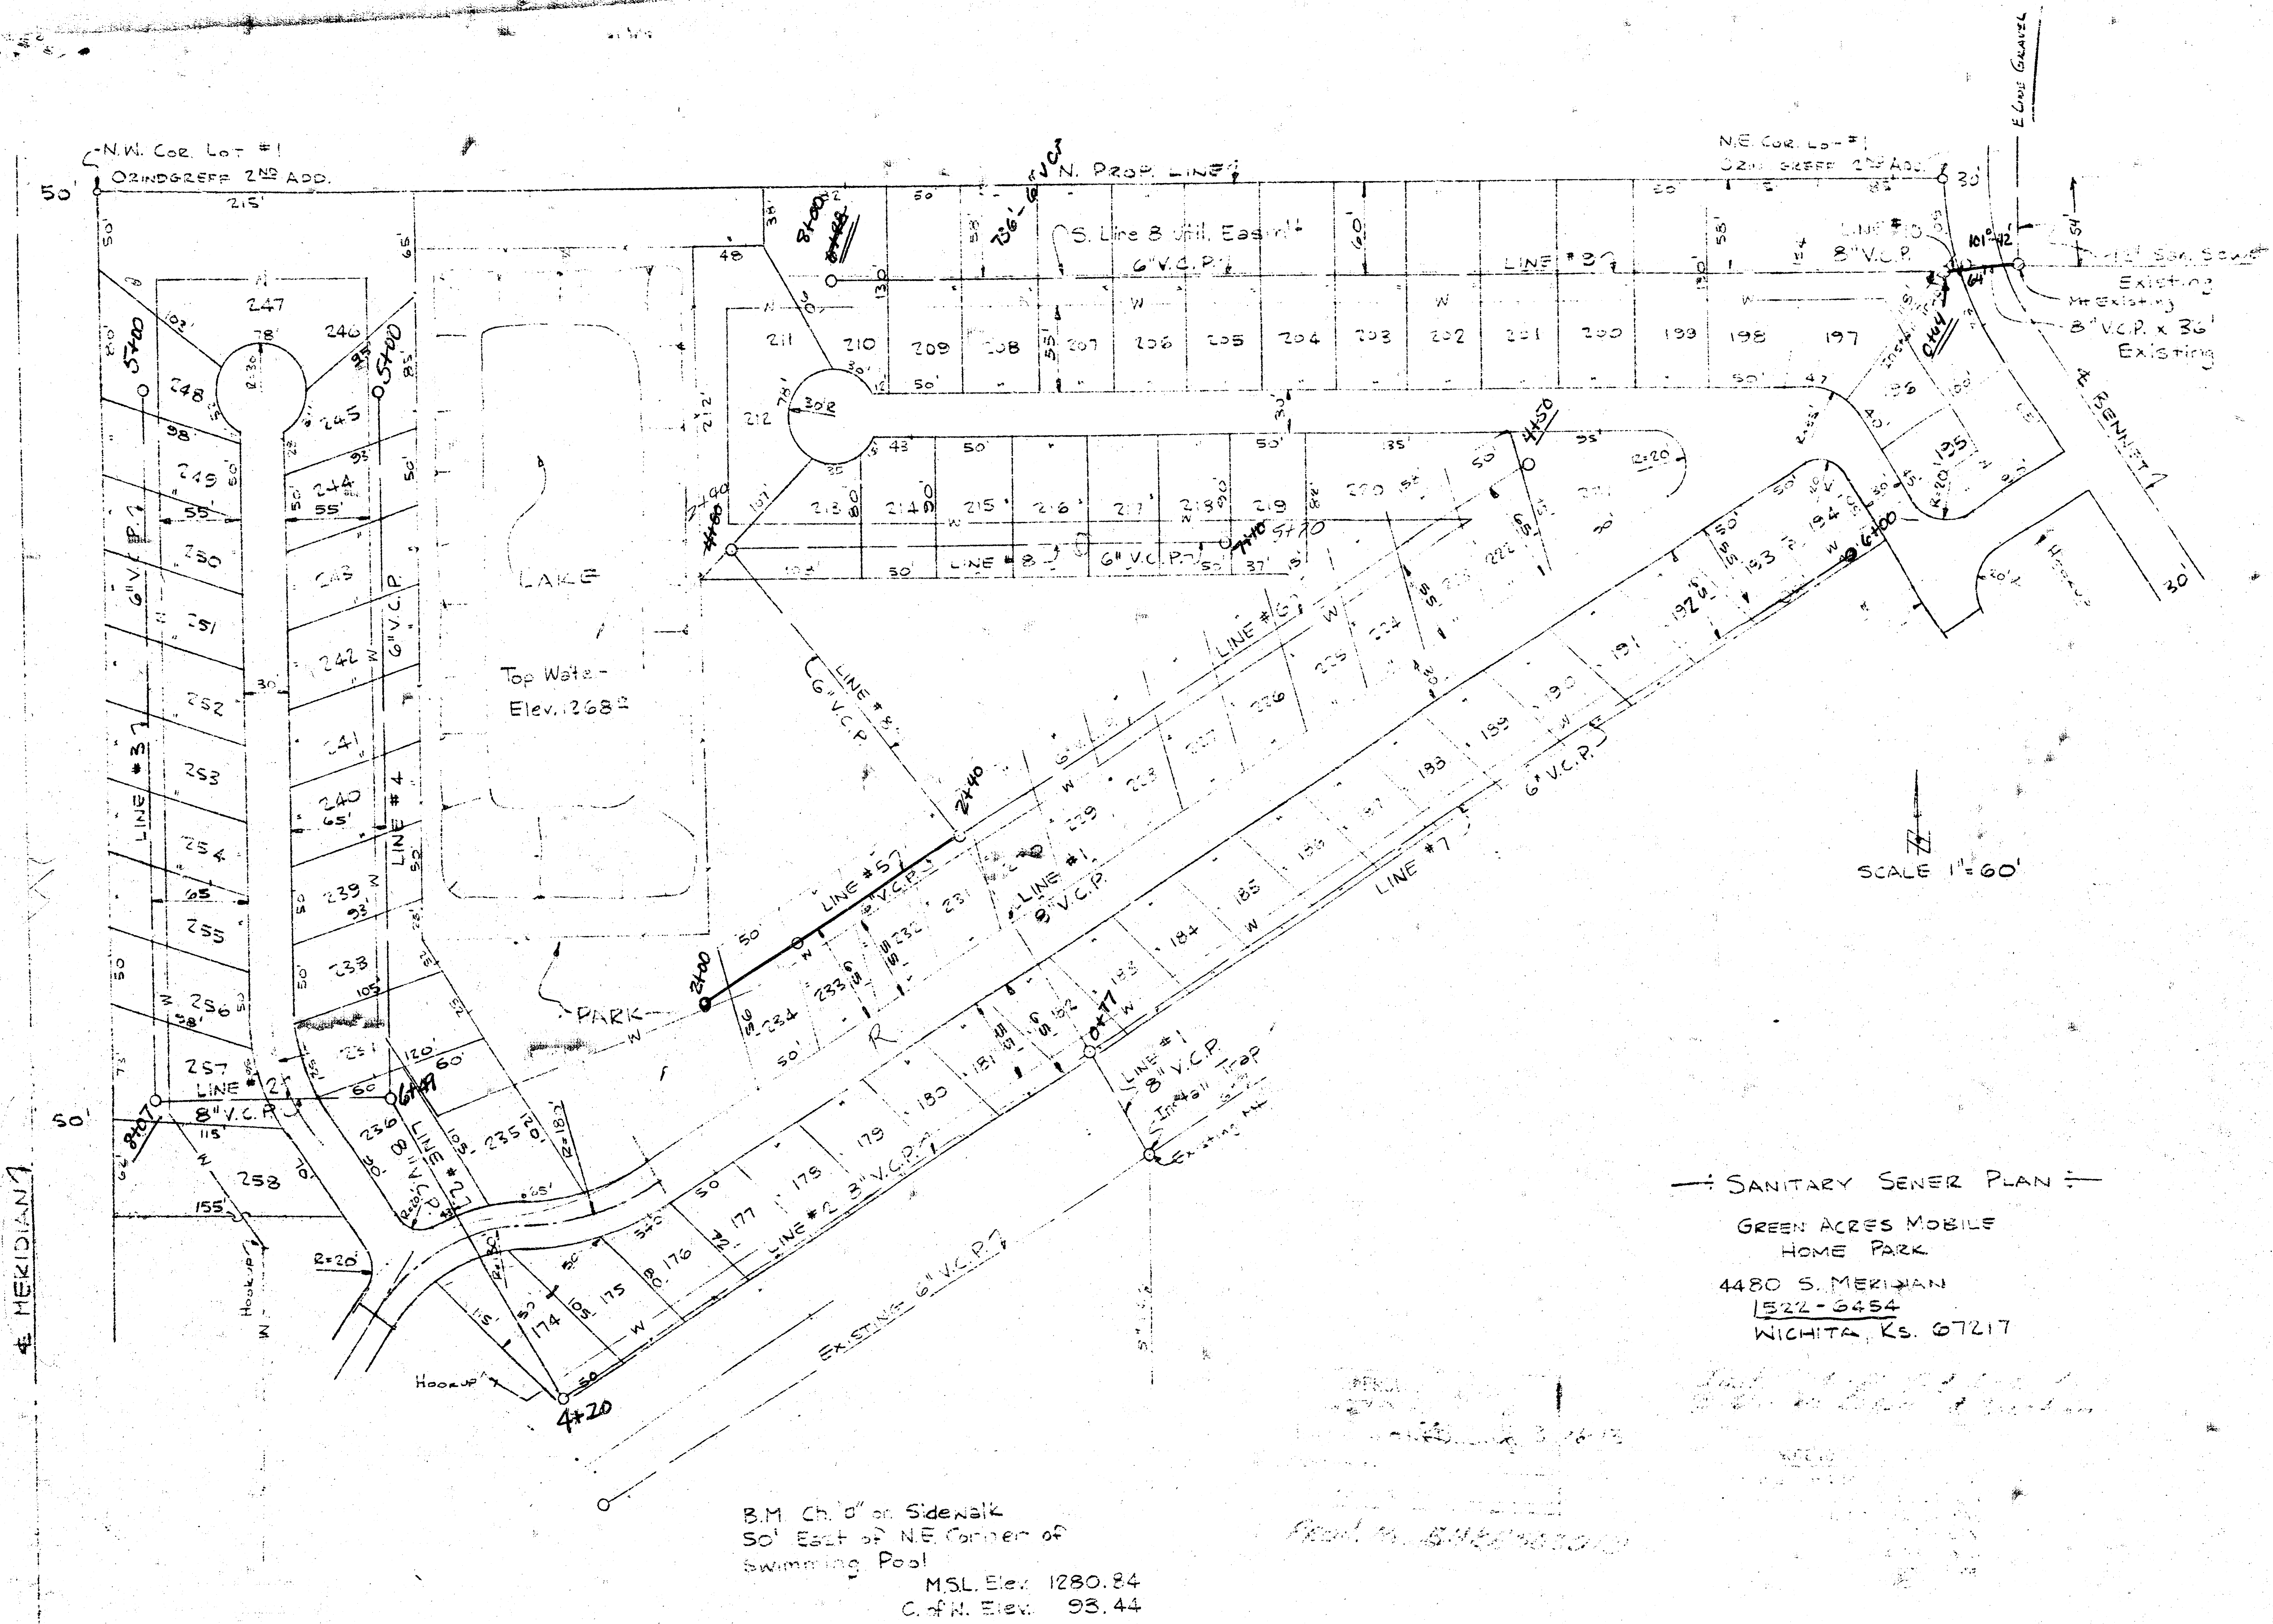

—: SANITARY SEWER PLAN :—

GREEN ACRES MOBILE
HOME PARK

4480 S. MERIDIAN
1522-6454
WICHITA, KS. 67217

AS BUILT PLANS
GREEN ACRES MOBILE HOMES
H.C. Ladd