



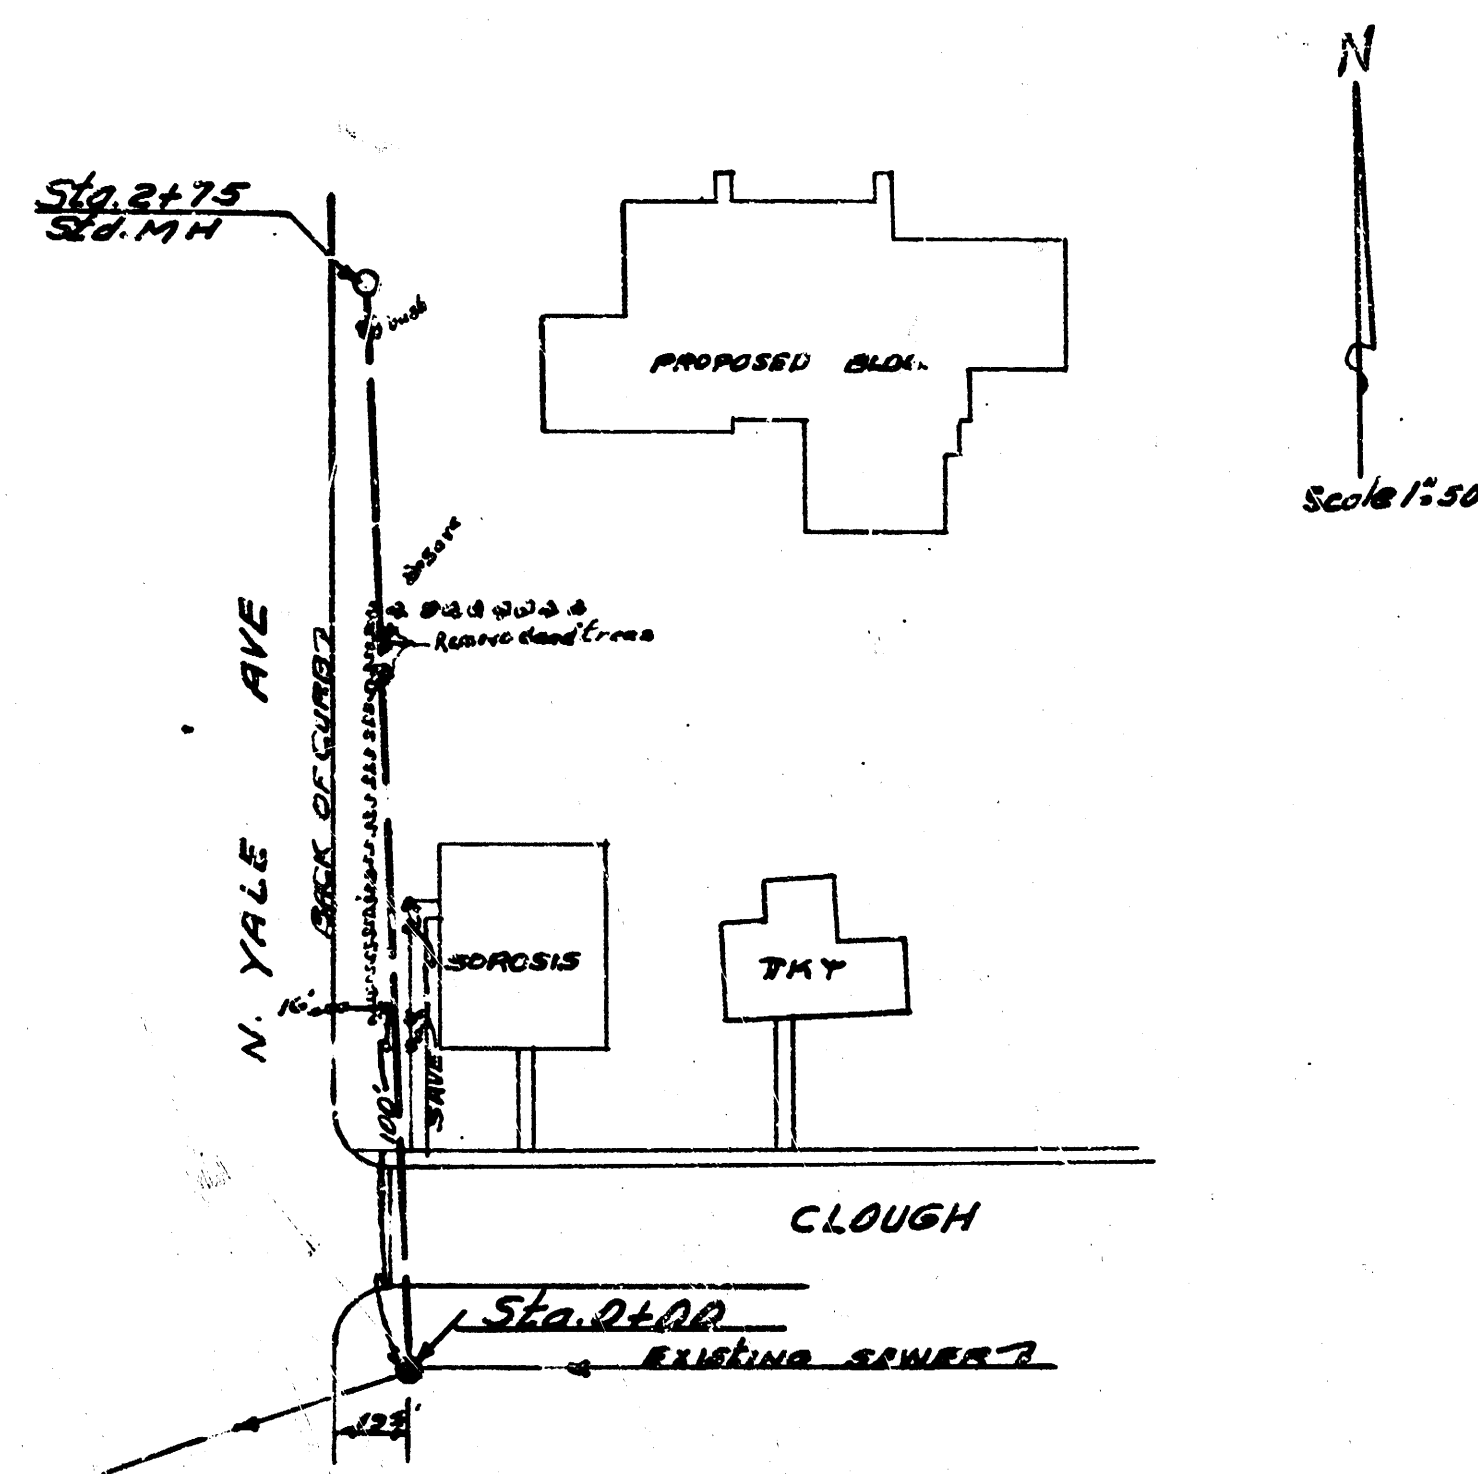

THIS SEWER LINE WAS CONSTRUCTED UNDER THE SUPERVISION OF THE CITY ENGINEER AND CHECKED BY THE CITY ENGINEER. THE CONTRACTOR WAS THE CITY OF WICHITA. AN OUTSIDE ENGINEERING FIRM, AND INSPECTOR.

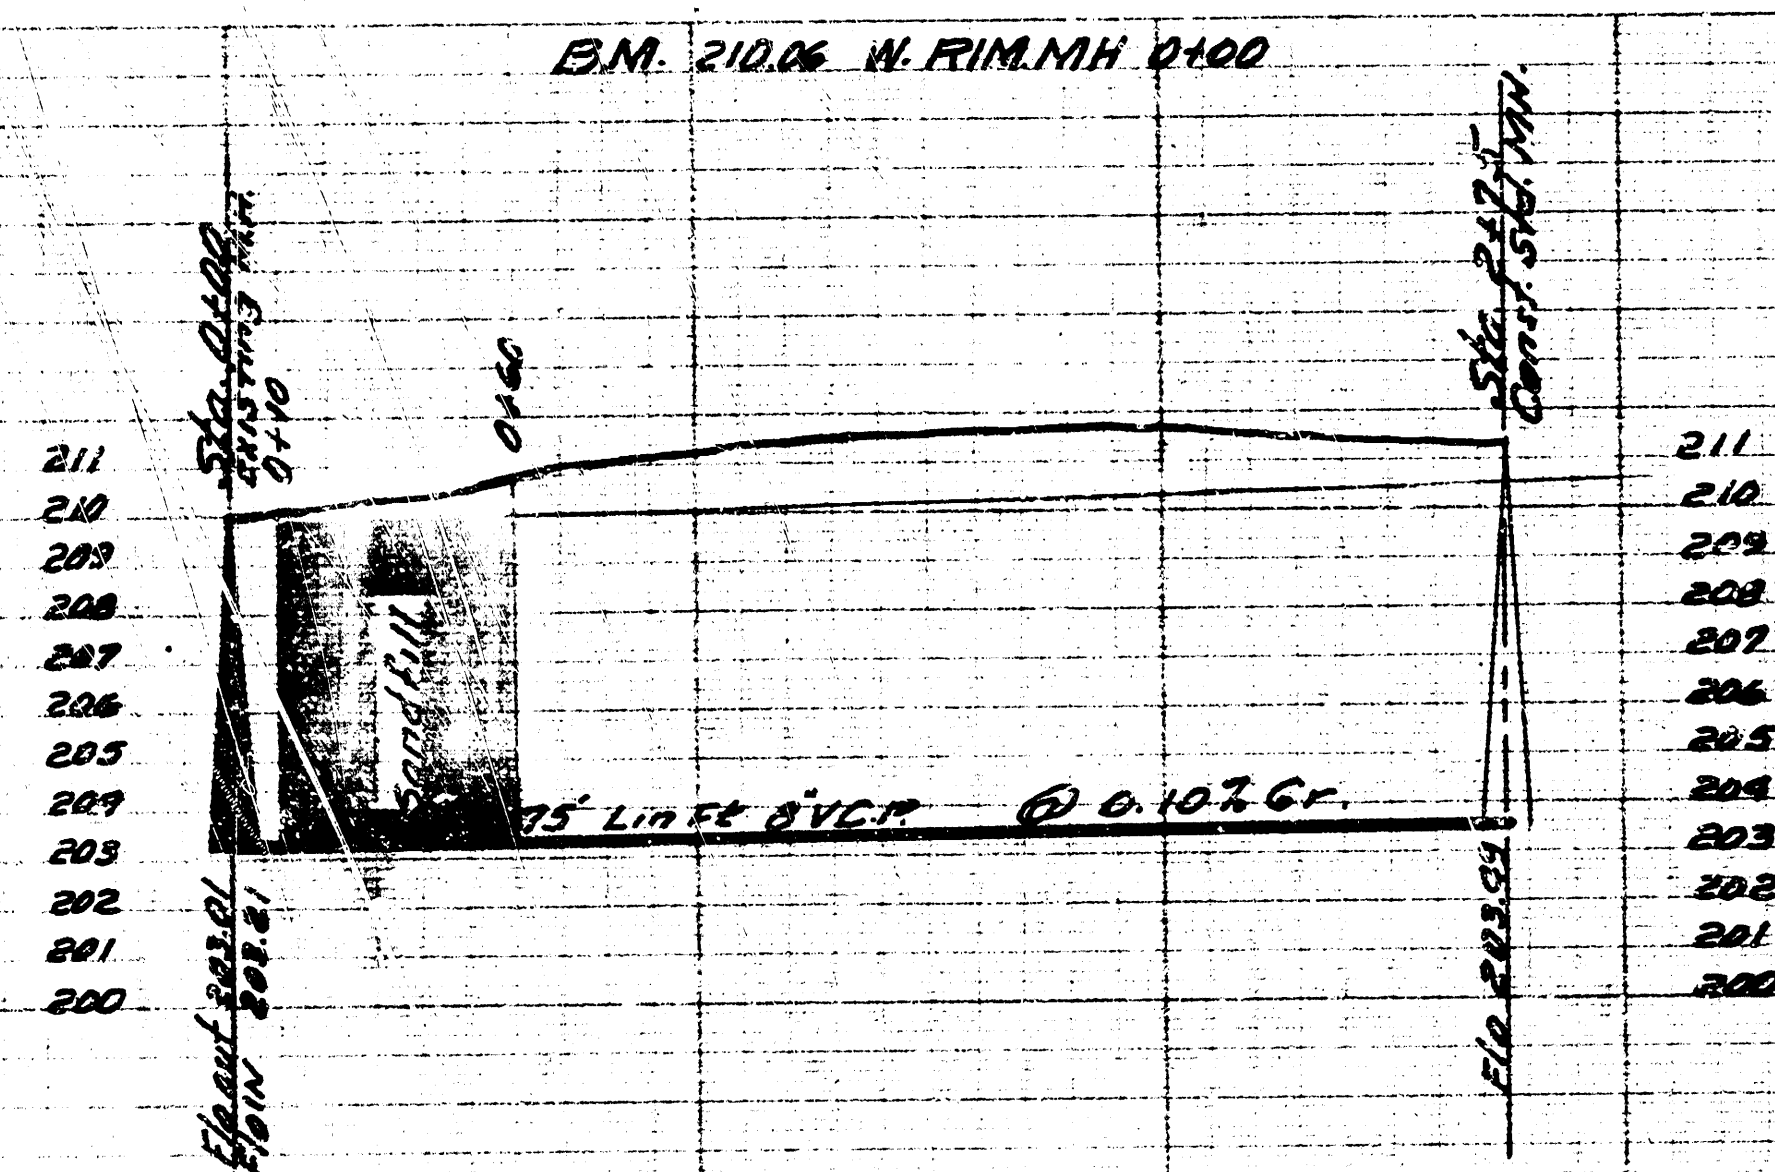

HOME EC. BLDG. SEWER W.L.
CITY OF WICHITA KANSAS
BE SMITH CITY ENGINEER
Private Conf.

Date
Plan by
Checked by
Sheet No.