



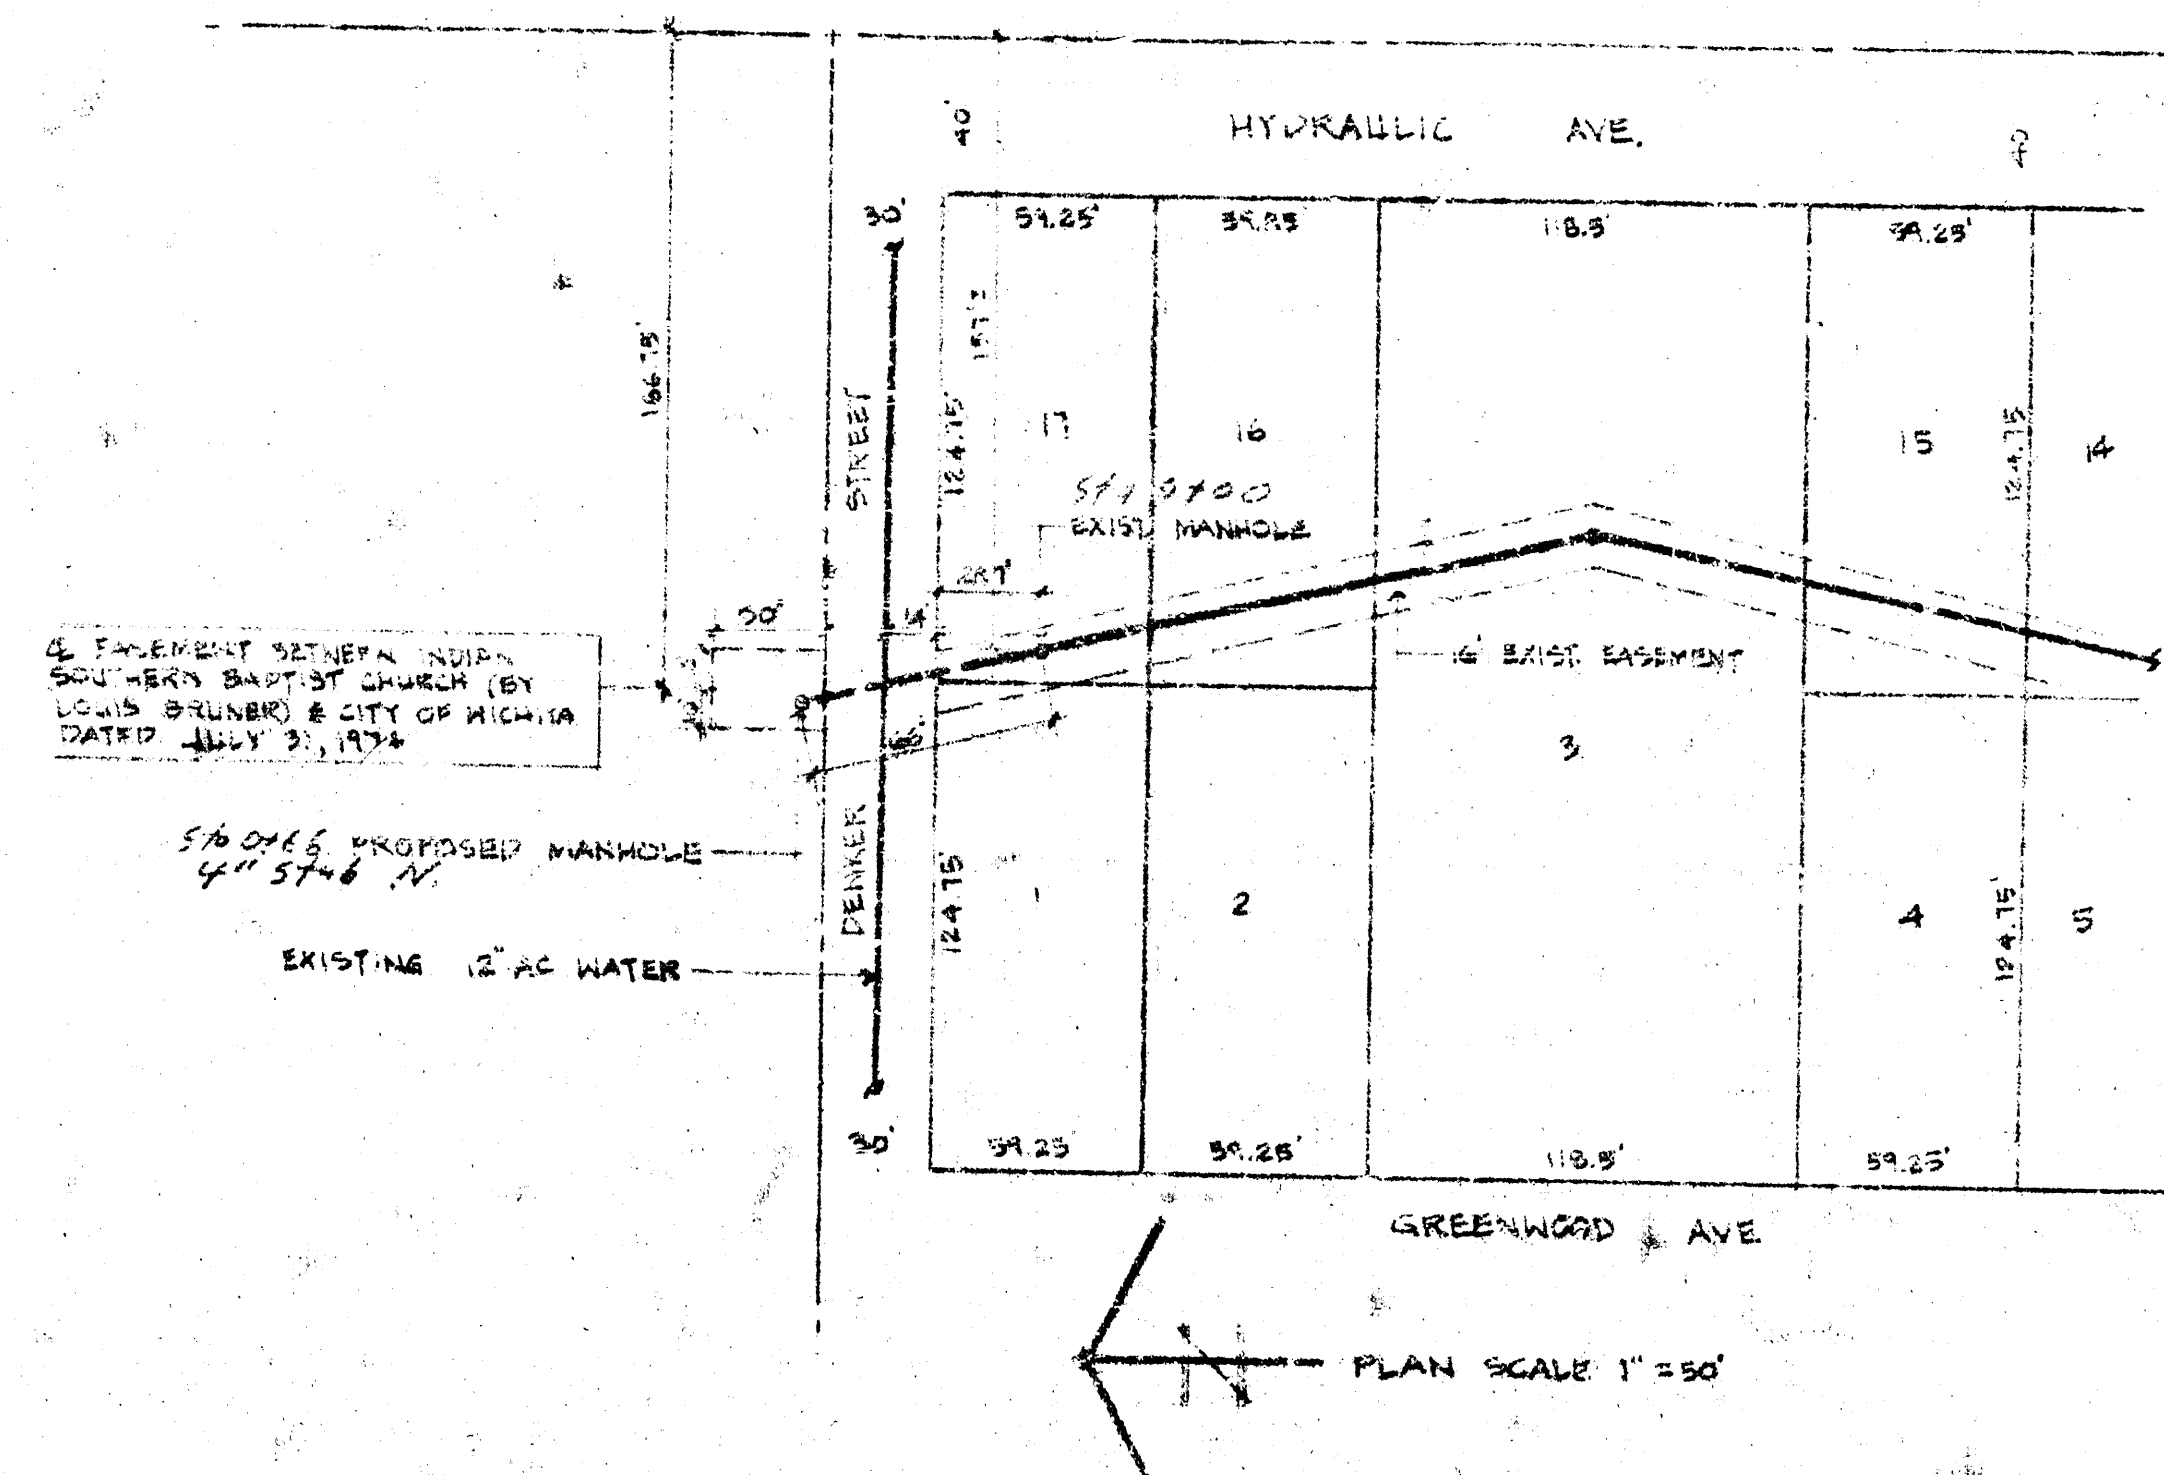

4. AGREEMENT BETWEEN ROYAL
SOUTHERN BAPTIST CHURCH (BY
LOUIS BRUNER) & CITY OF WICHITA
DATED JULY 31, 1974

PROPOSED 12" WATER
EXISTING 12" AC WATER

PROFILE SCALE
HORIZ. 1" = 50'
VERT. 1" = 5'

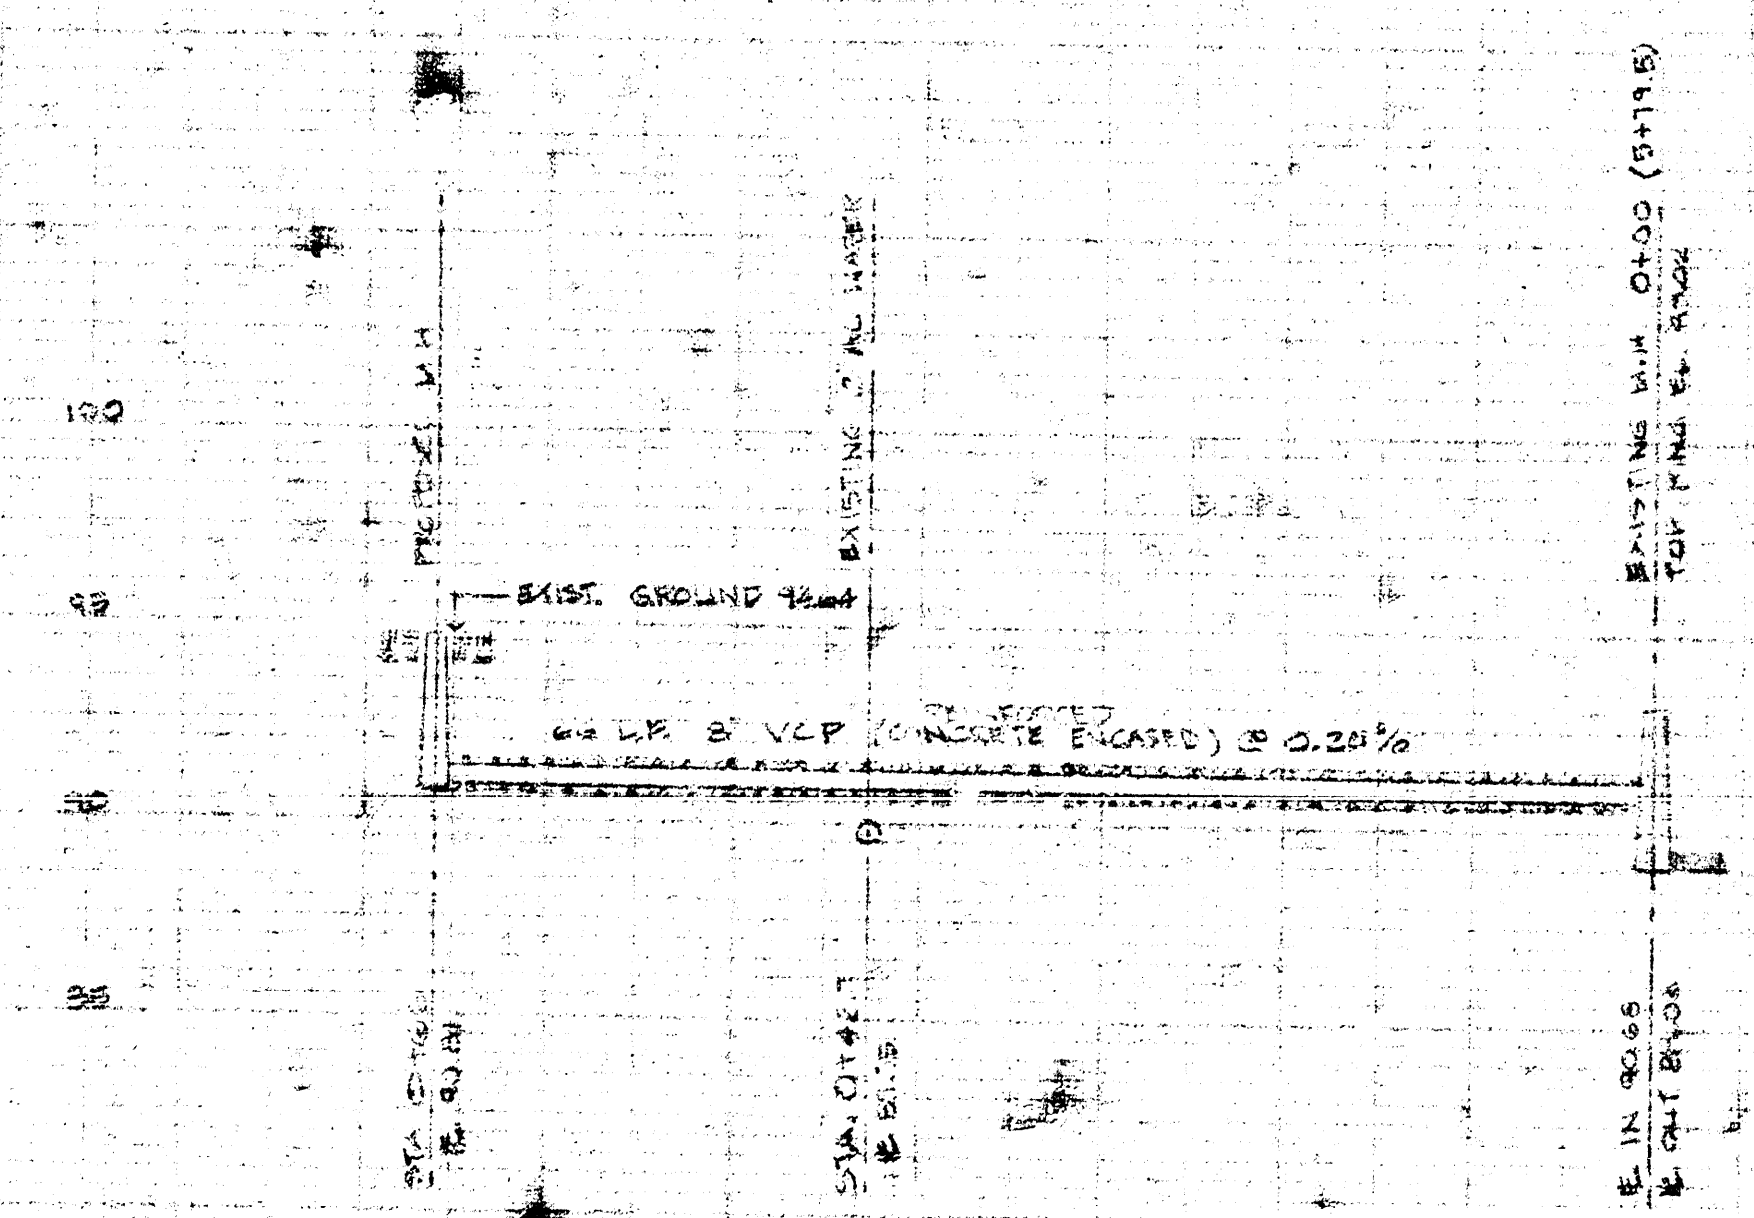

* WICHITA CITY WENCH MARK DISC - 12.07
48" S. 4. 12" DIA. & 48" S. 4. 12" DIA. HYDRAULIC
12" S. 4. 12" DIA. PENNY NAIL & S.D. POWER POLE
12" S. 4. 12" DIA. PENNY NAIL & S.D. POWER POLE

APPROVED AS NOTED
By CITY ENGINEER OF WICHITA
Sanitary Sewer
Shown as per
Division Approved



UTILITY CONTRACTORS

INDIAN SOUTHERN BAPTIST
CHURCH PURCHASE

12" SANITARY SEWER PLANS
DATE: JULY 19, 1974 DRAWN BY: M.W.
REV: AUG 22, 1974

3224170 4056

14 3 5 1