
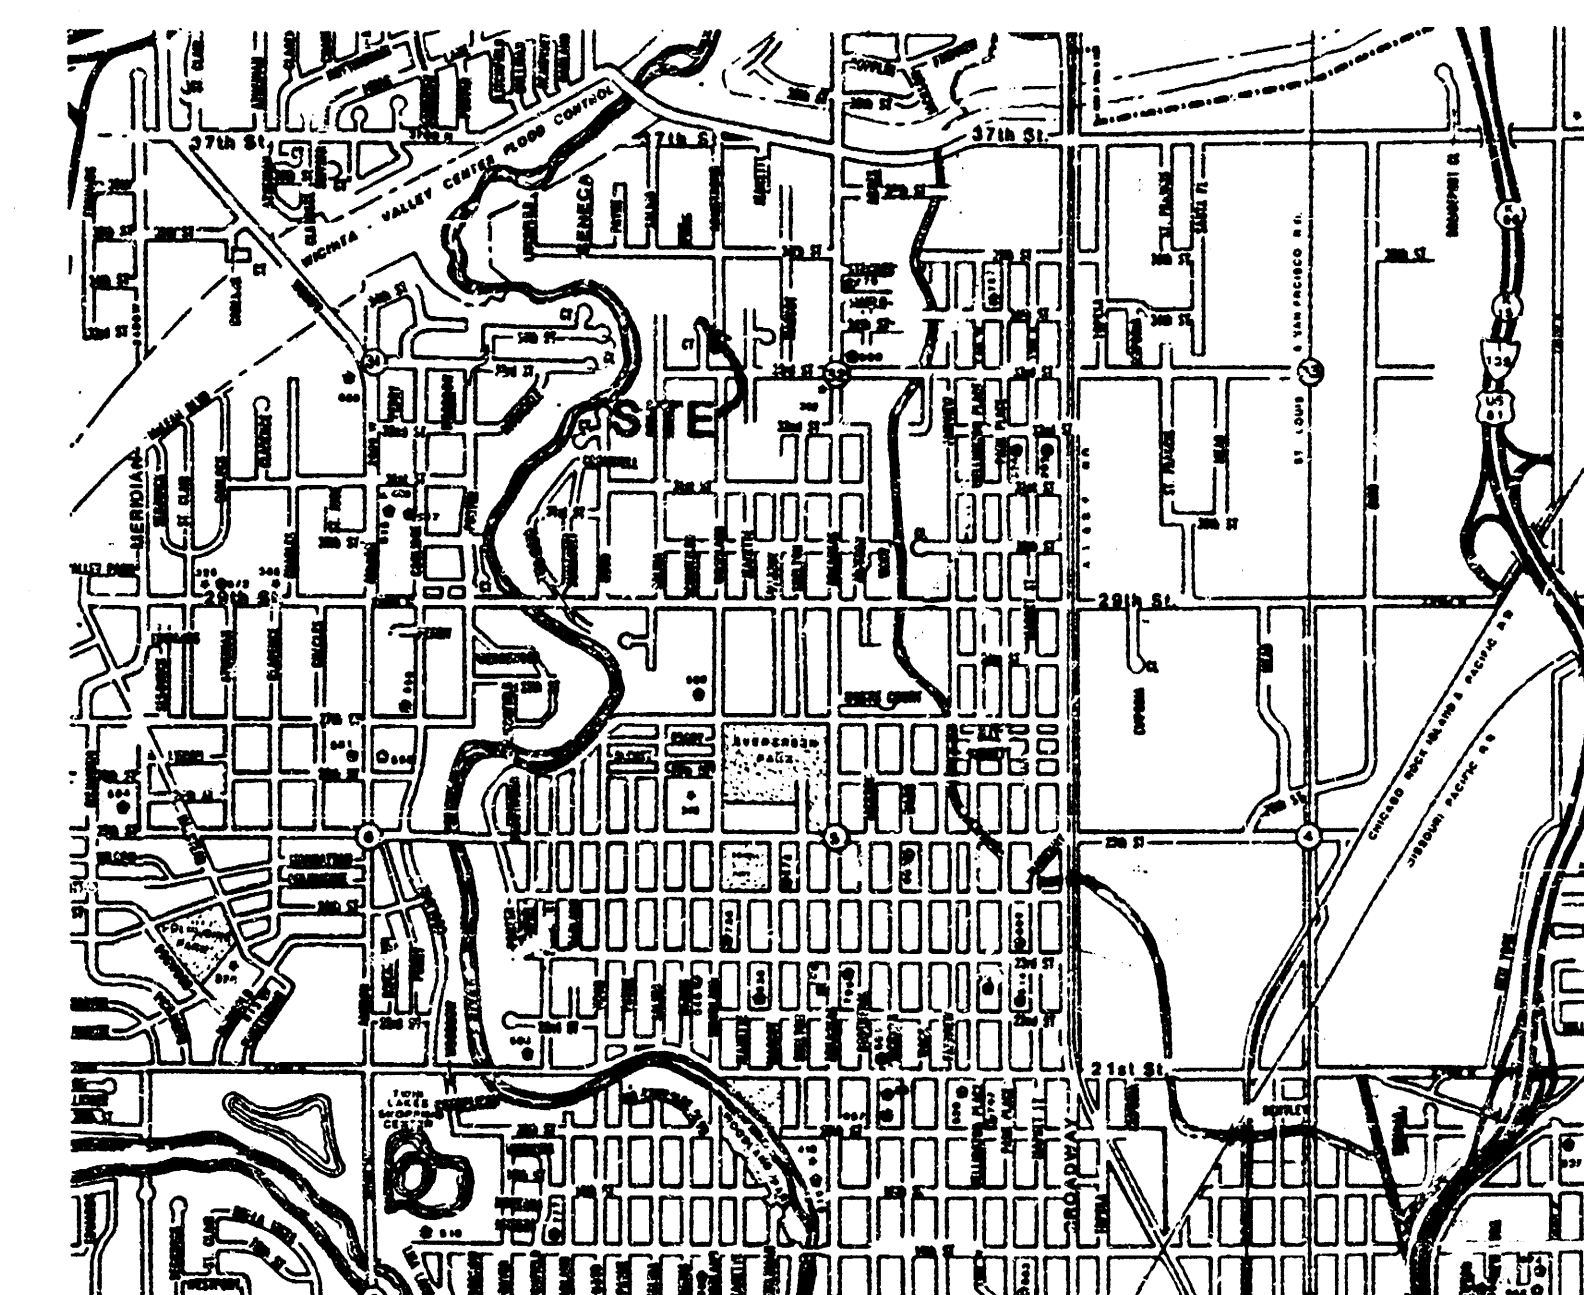
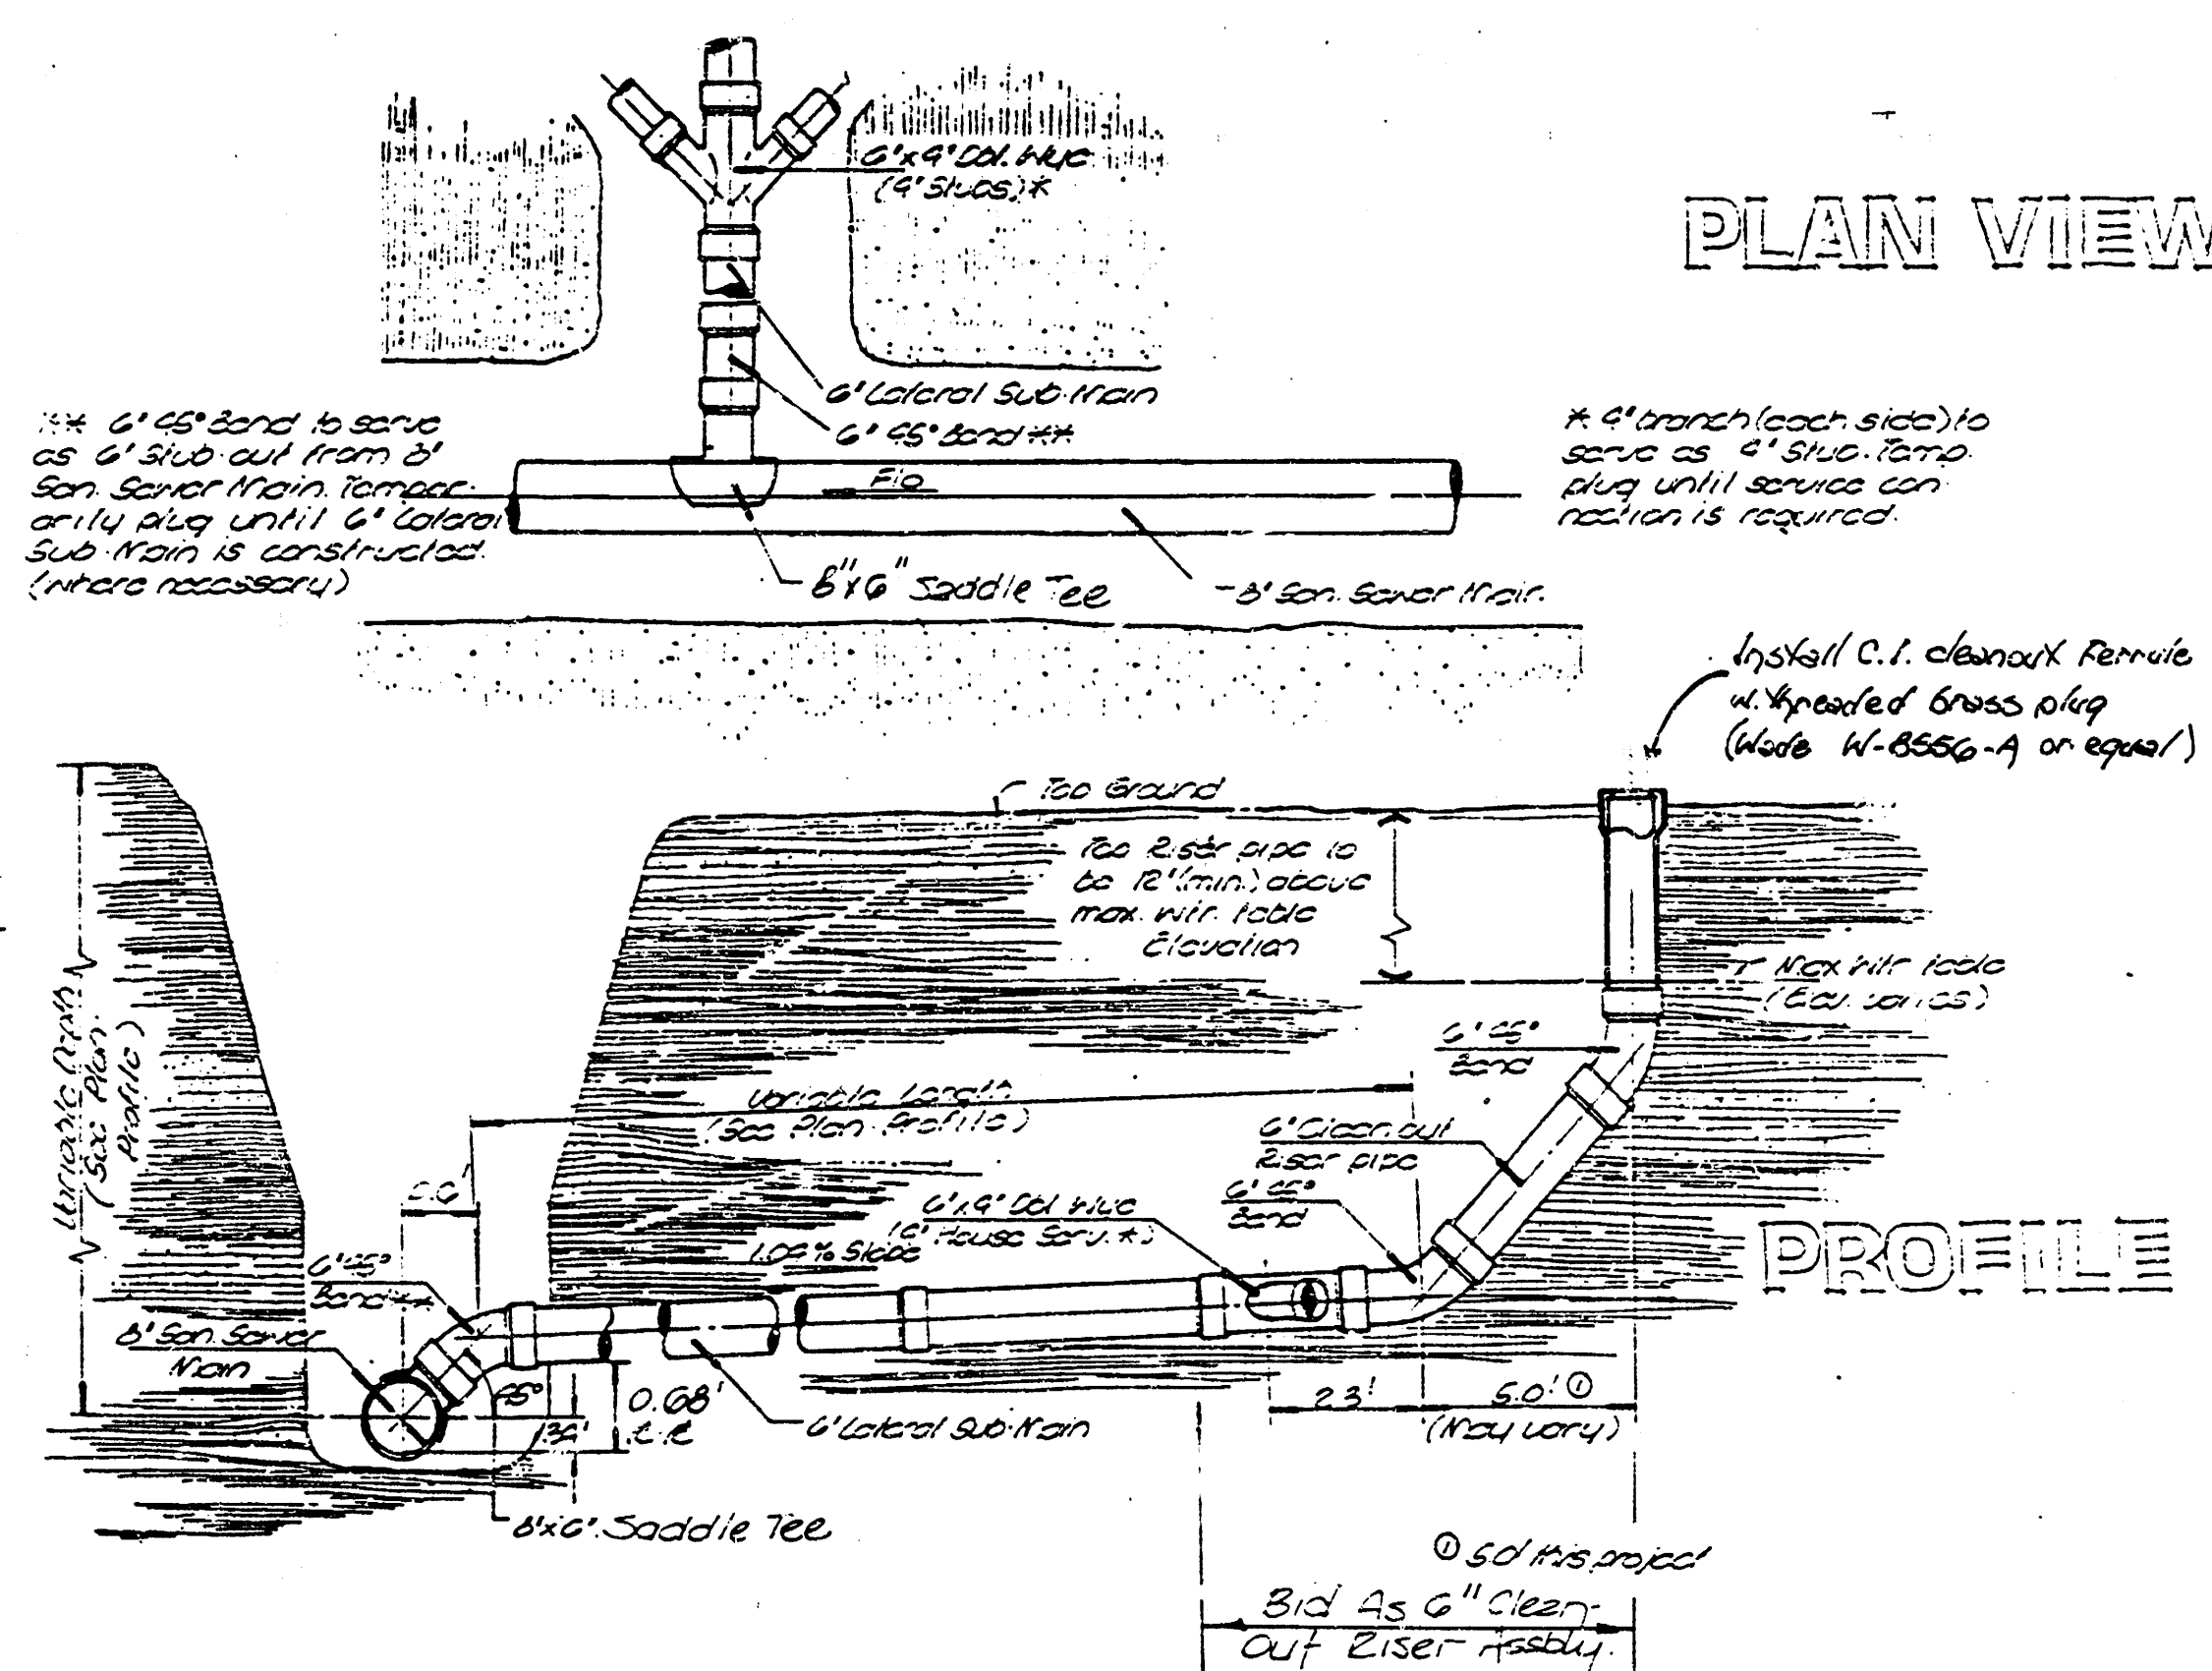


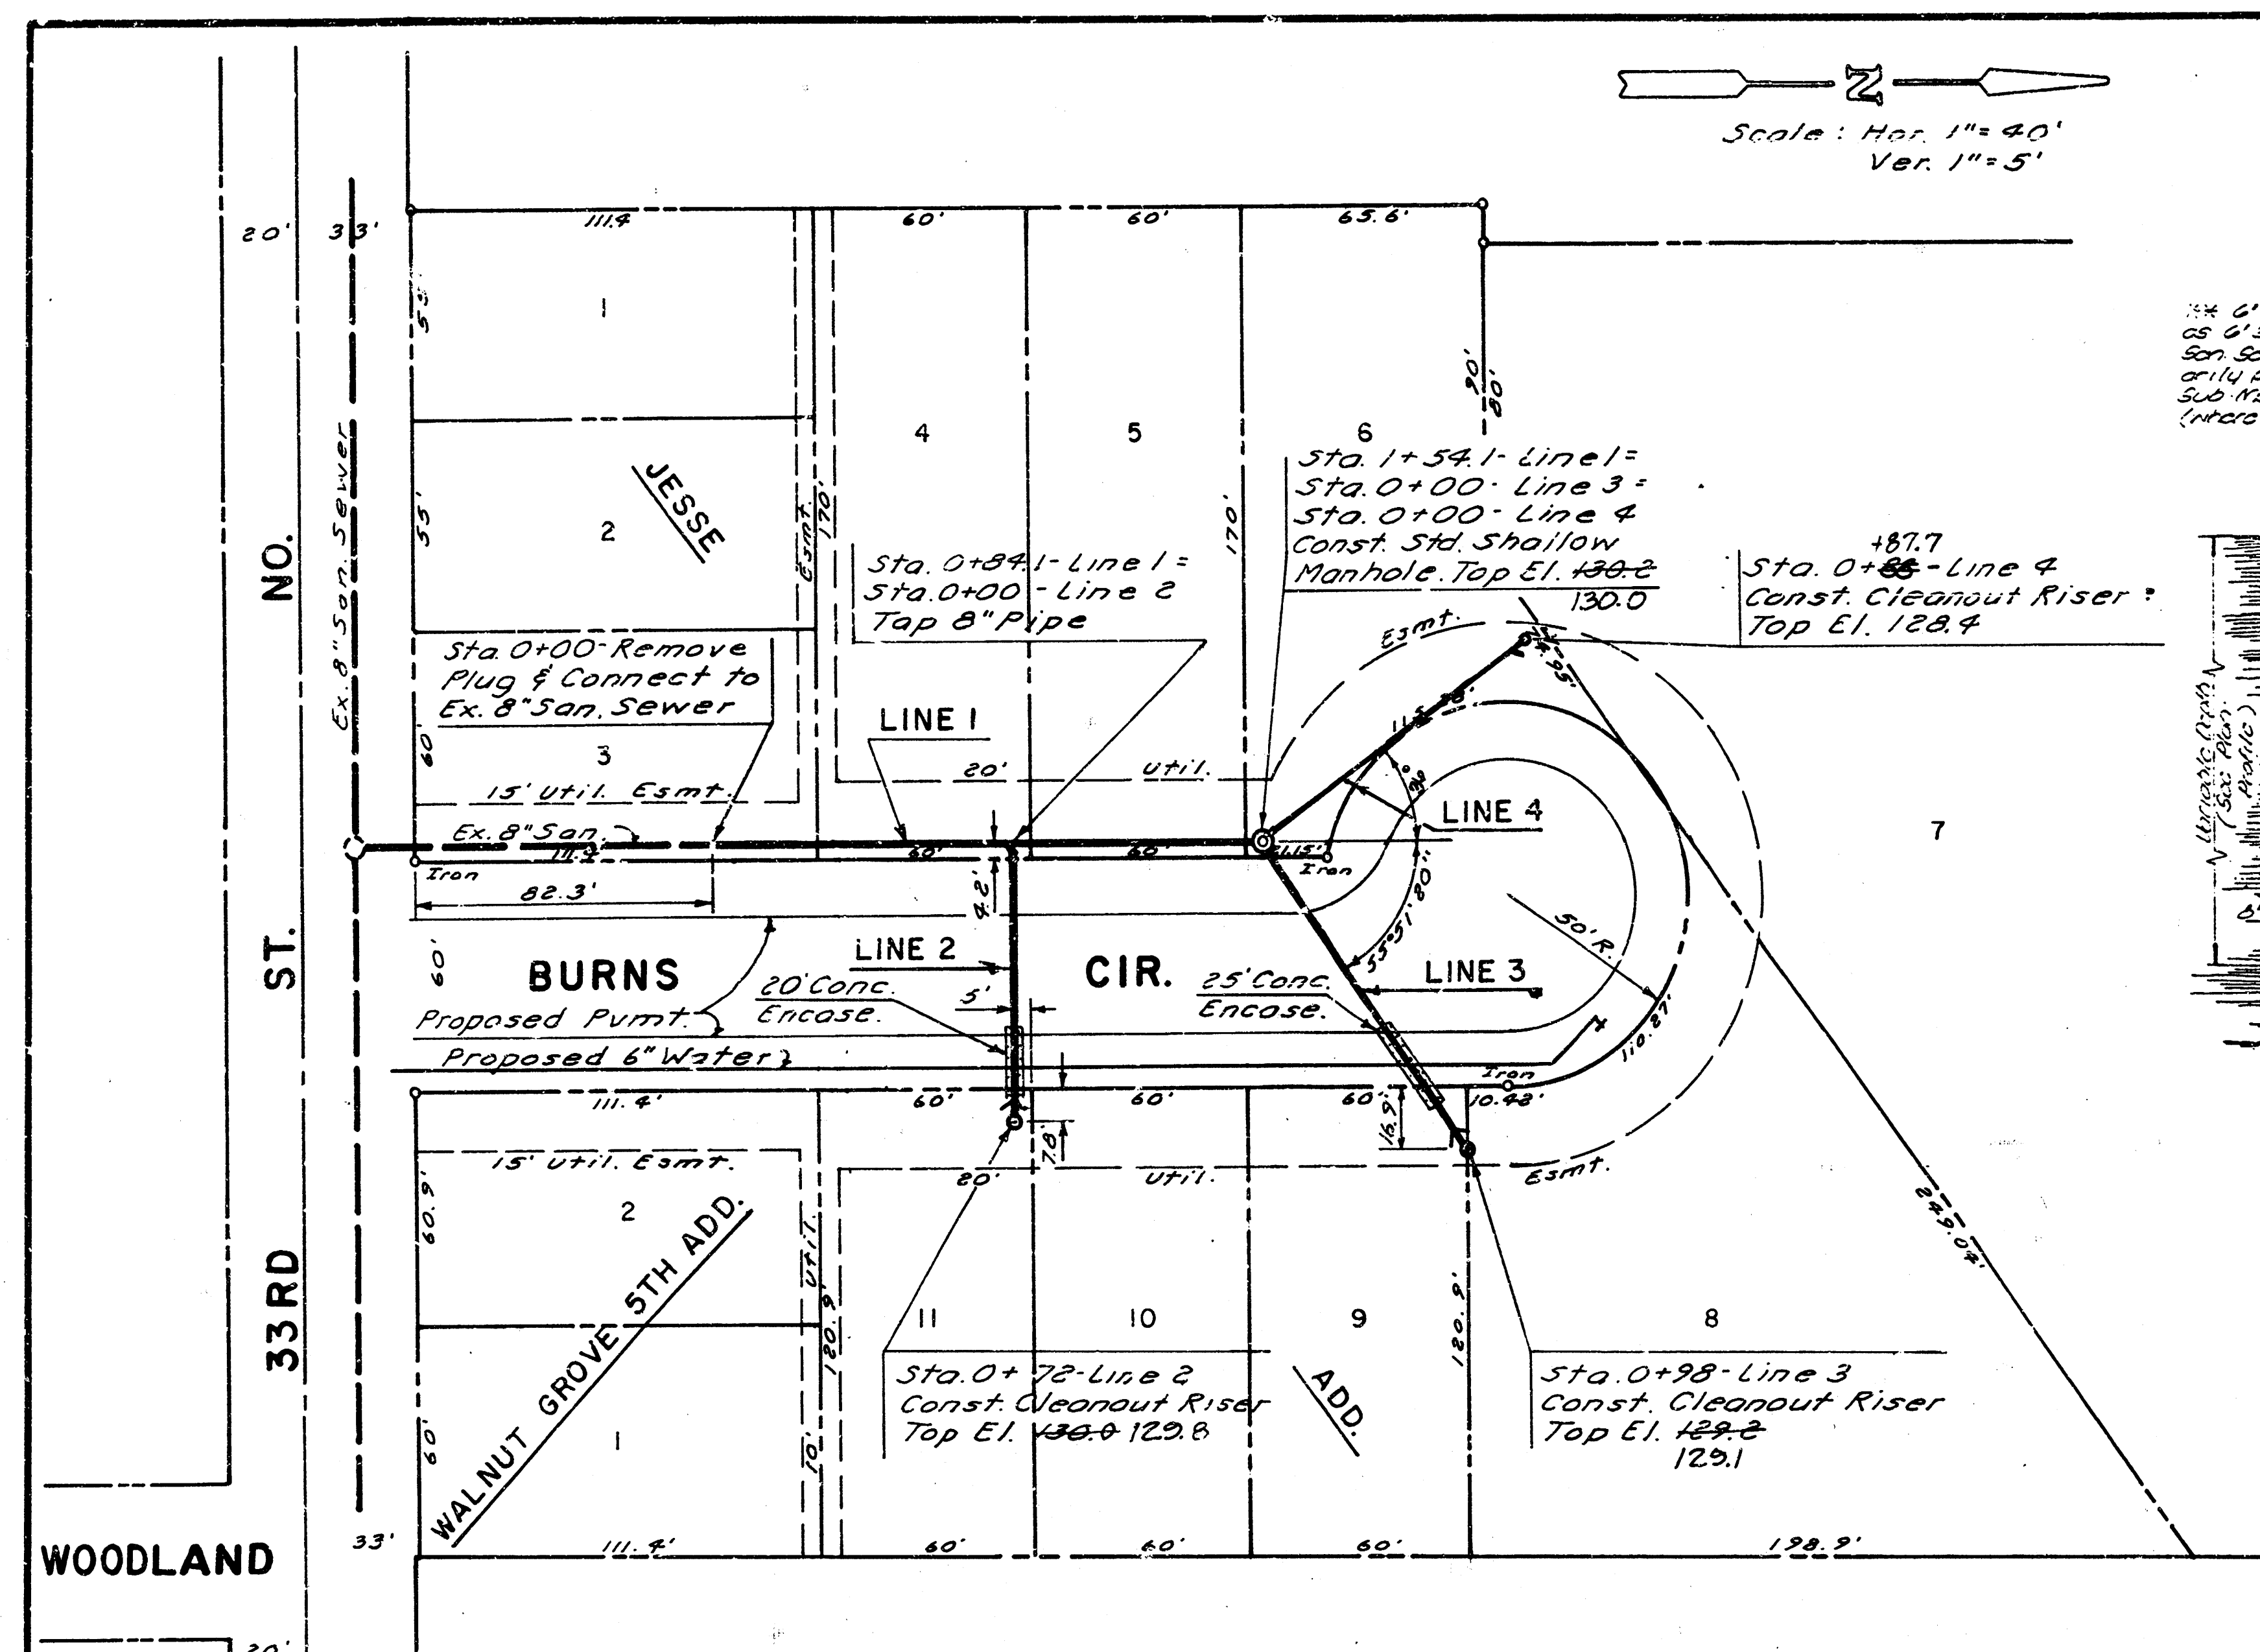

APPROVED AS NOTED
By CITY ENGINEER OF WICHITA

Sanitary Sewers VRH 12/10/92

Storm Sewers _____


Driveway Approaches _____

Water Mains _____

Paving _____

NOTE TO CONTRACTOR

INSPECTION AND TESTING FOR THIS PROJECT IS TO BE PROVIDED BY A LICENSED CONSULTING ENGINEERING FIRM UNDER CONTRACT WITH THE OWNER/DEVELOPER. SAID INSPECTION TO BE IN ACCORDANCE WITH THE CITY OF WICHITA STANDARD CONSTRUCTION ENGINEERING PRACTICES AND CERTIFIED BY A LICENSED PROFESSIONAL ENGINEER. NO WORK SHALL BE PERFORMED IN DEDICATED EASEMENTS OR PUBLIC RIGHT-OF-WAY BY THE CONTRACTOR WITHOUT SUCH INSPECTION NOR SHALL ANY WORK BE COMMENCED WITHOUT WRITTEN AUTHORIZATION BY THE CITY ENGINEER.

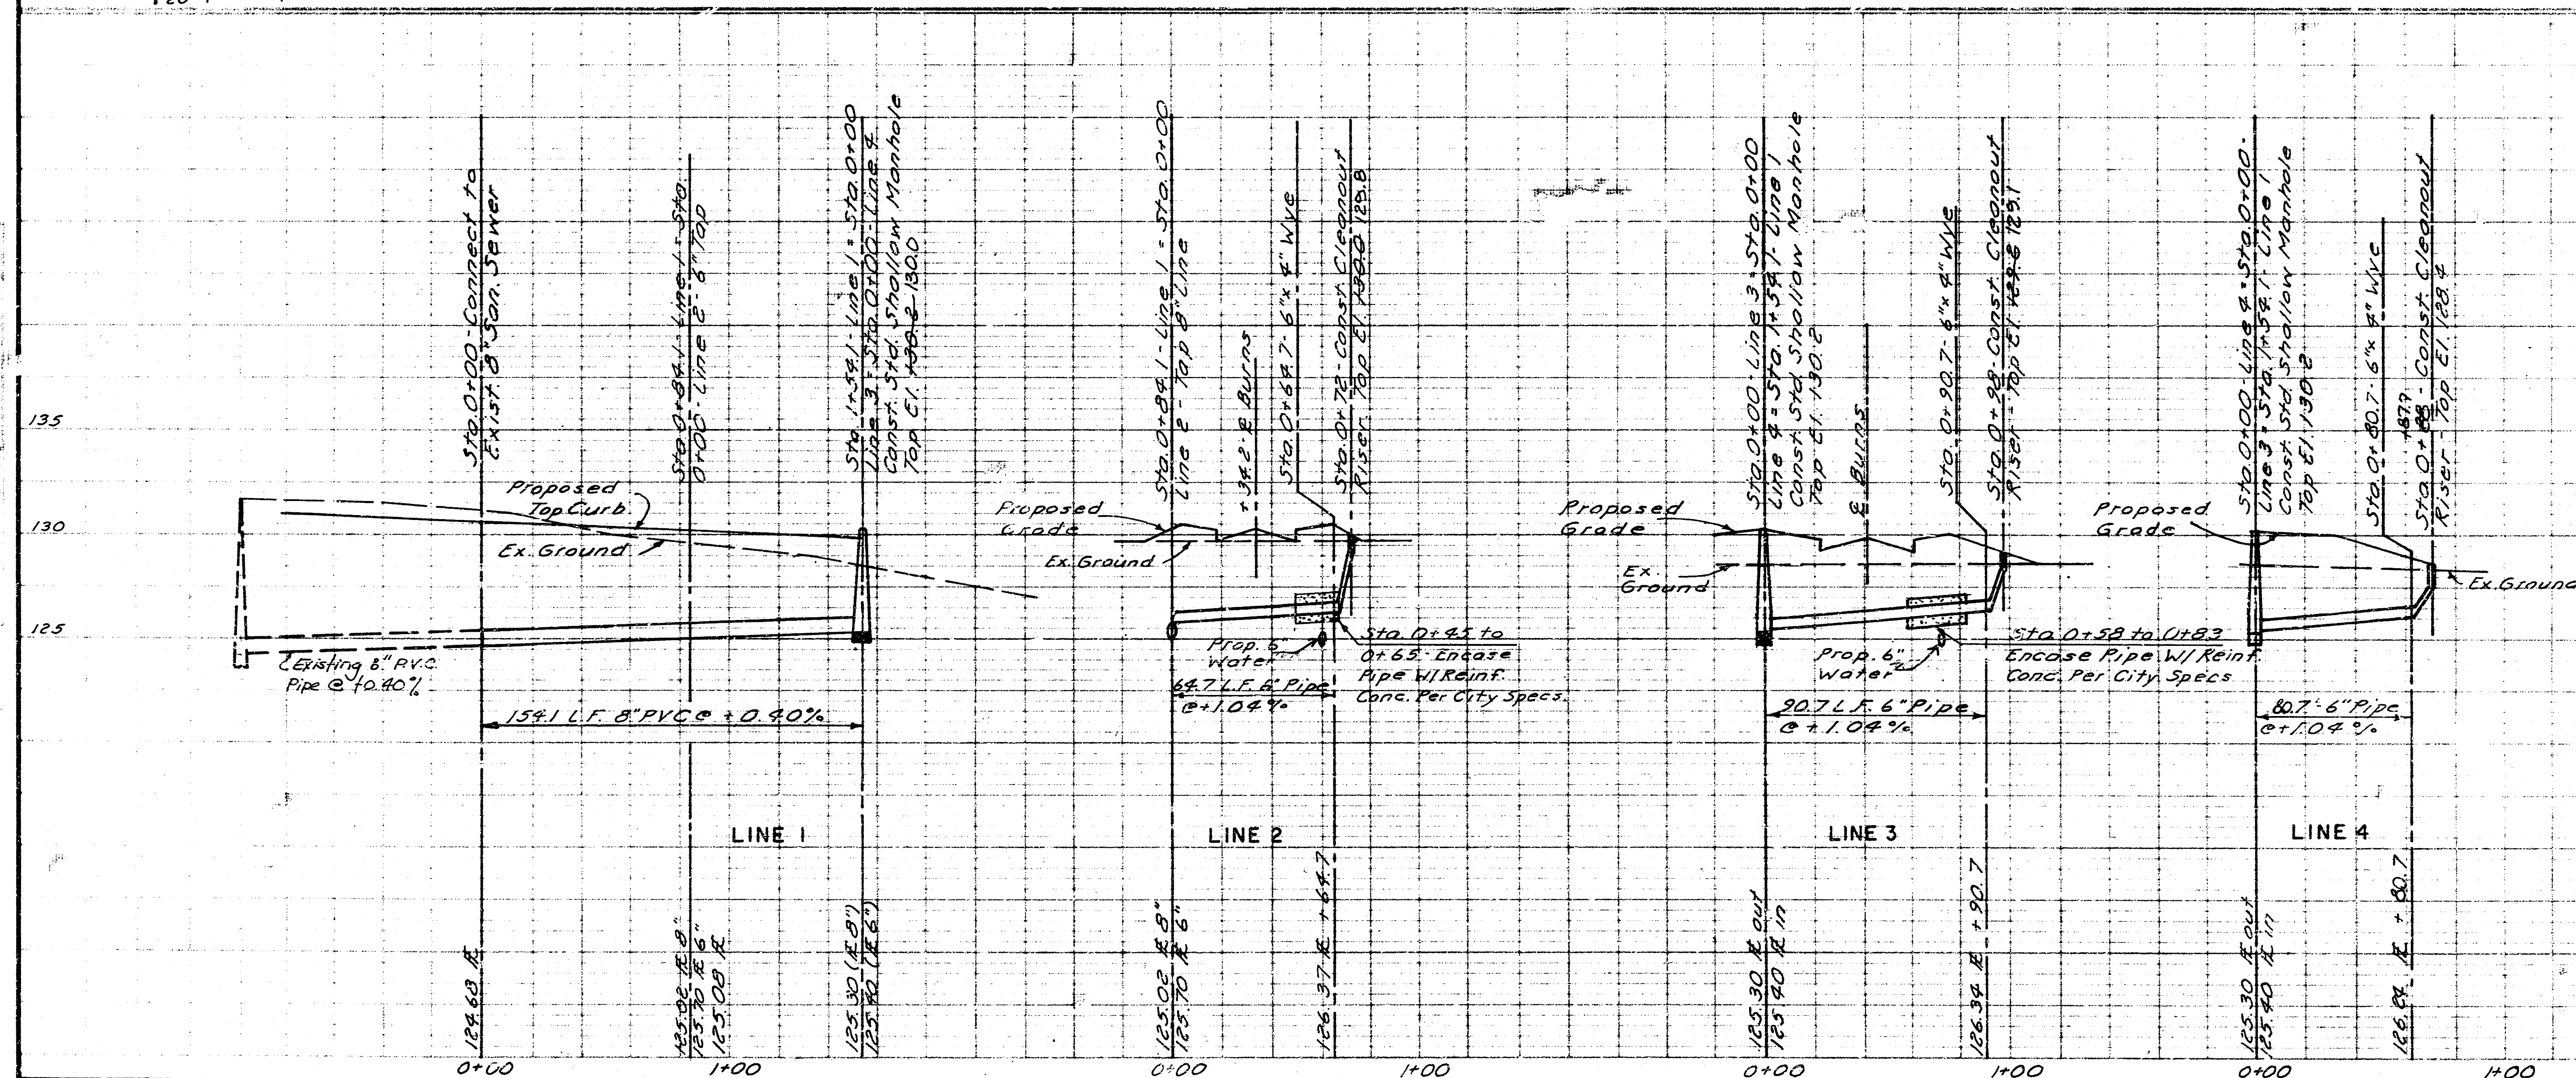

12-6-90
Rev. 11-29-90
Rev. 2-22-91 As Built TCR

PRIVATE SANITARY SEWER EXTENSION
TO SERVE JESSE ADD.

PROJ. NO. **271 PPS (607861)**

BAUGHMAN COMPANY, P.A.
SURVEYING & ENGINEERING
316/262-7271 • 315 ELLIS • WICHITA, KANSAS 67211

Design: NSW Drawn: JEL Approved: NSW Date: _____ Scale: _____

FILMED FROM THE BEST
AVAILABLE COPY...