




APPROVED AS NOTED
BY CITY ENGINEER OF WICHITA

Sanitary Sewers 1/RH 5/4/95

NOTE TO CONTRACTORS

Inspection and testing for this project is to be provided by a Licensed Consulting Engineering Firm under contract with the Owner/Developer. Said inspection to be in accordance with the City of Wichita standard construction engineering practices and certified by a Licensed Professional Engineer. No work shall be performed in dedicated easements or public right-of-way by the Contractor without such inspection nor shall any work be commenced without written authorization by the City Engineer.

6. The Contractor shall restore the site following construction to the pre-construction condition of the property, including replacement of fence, seeding, and restoration of the disturbed property to the original grade.

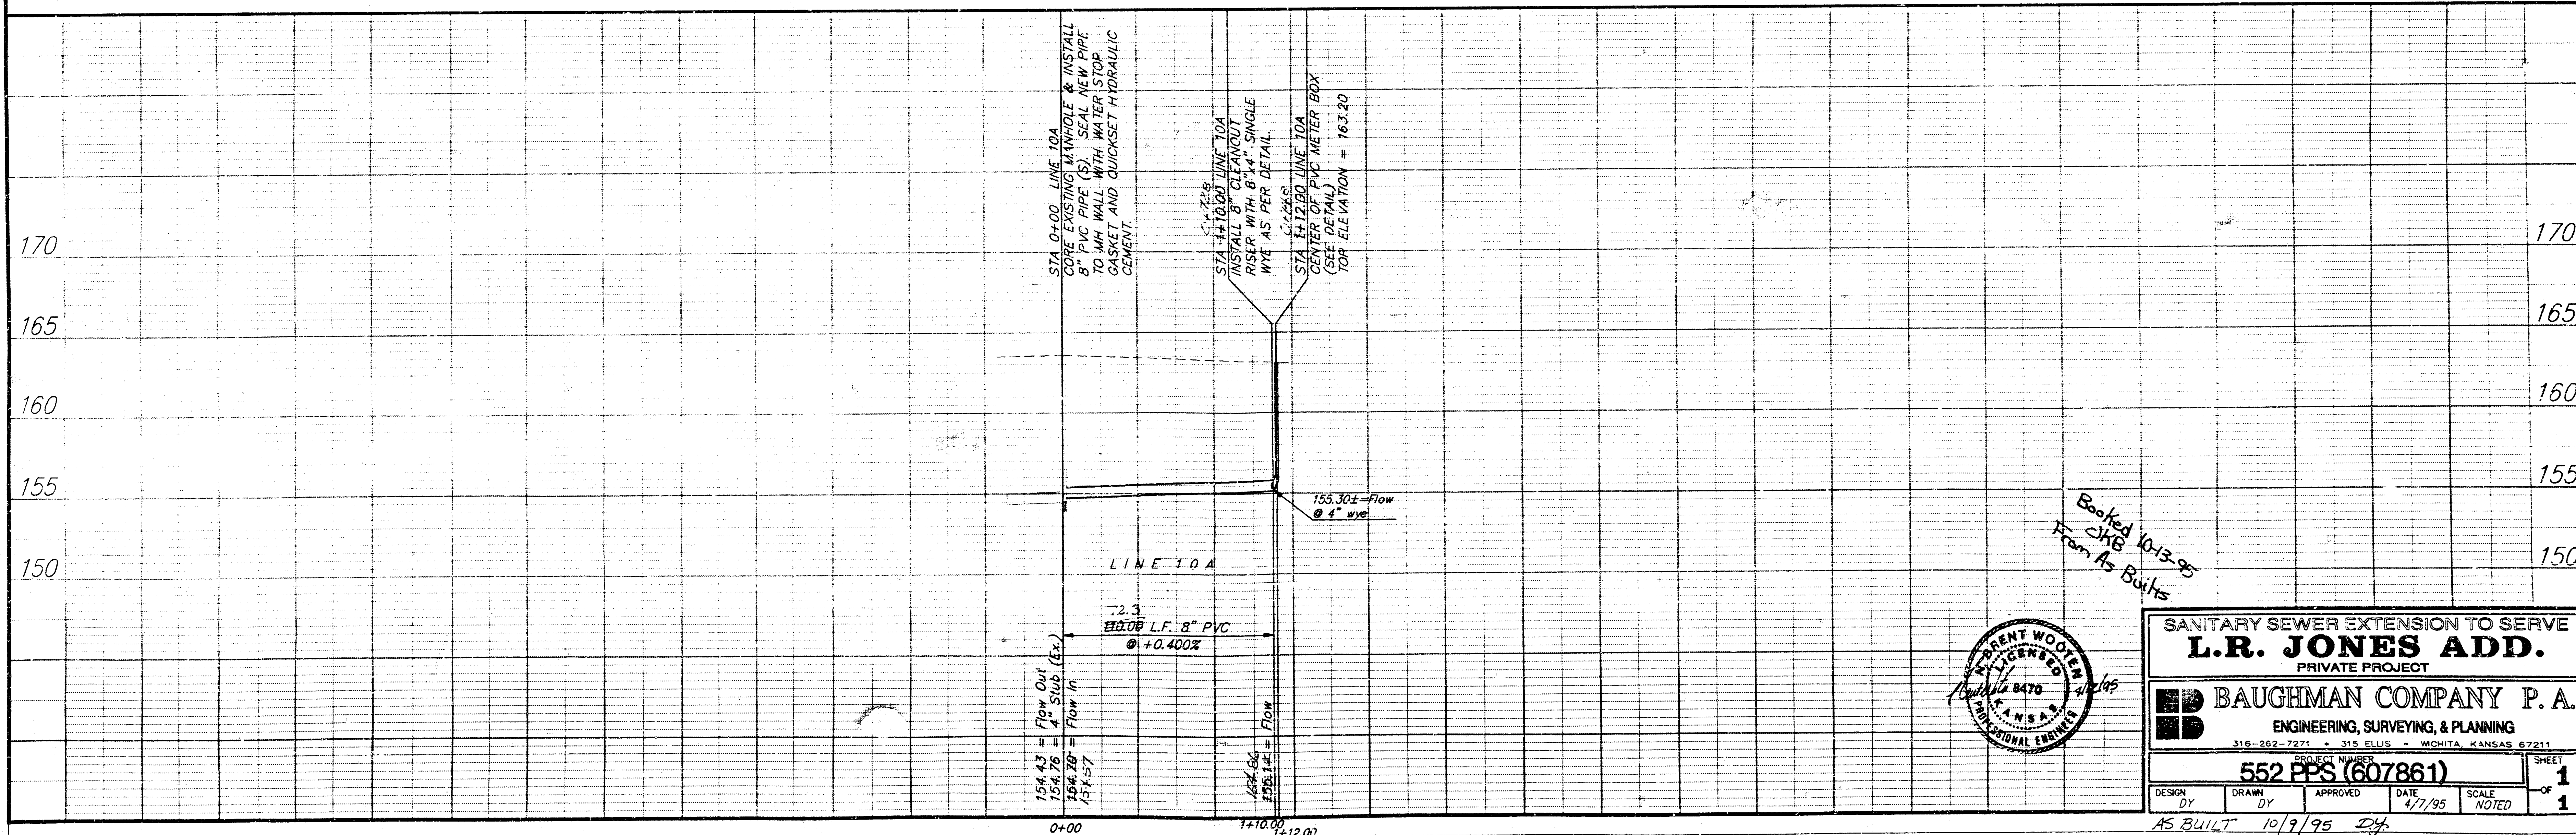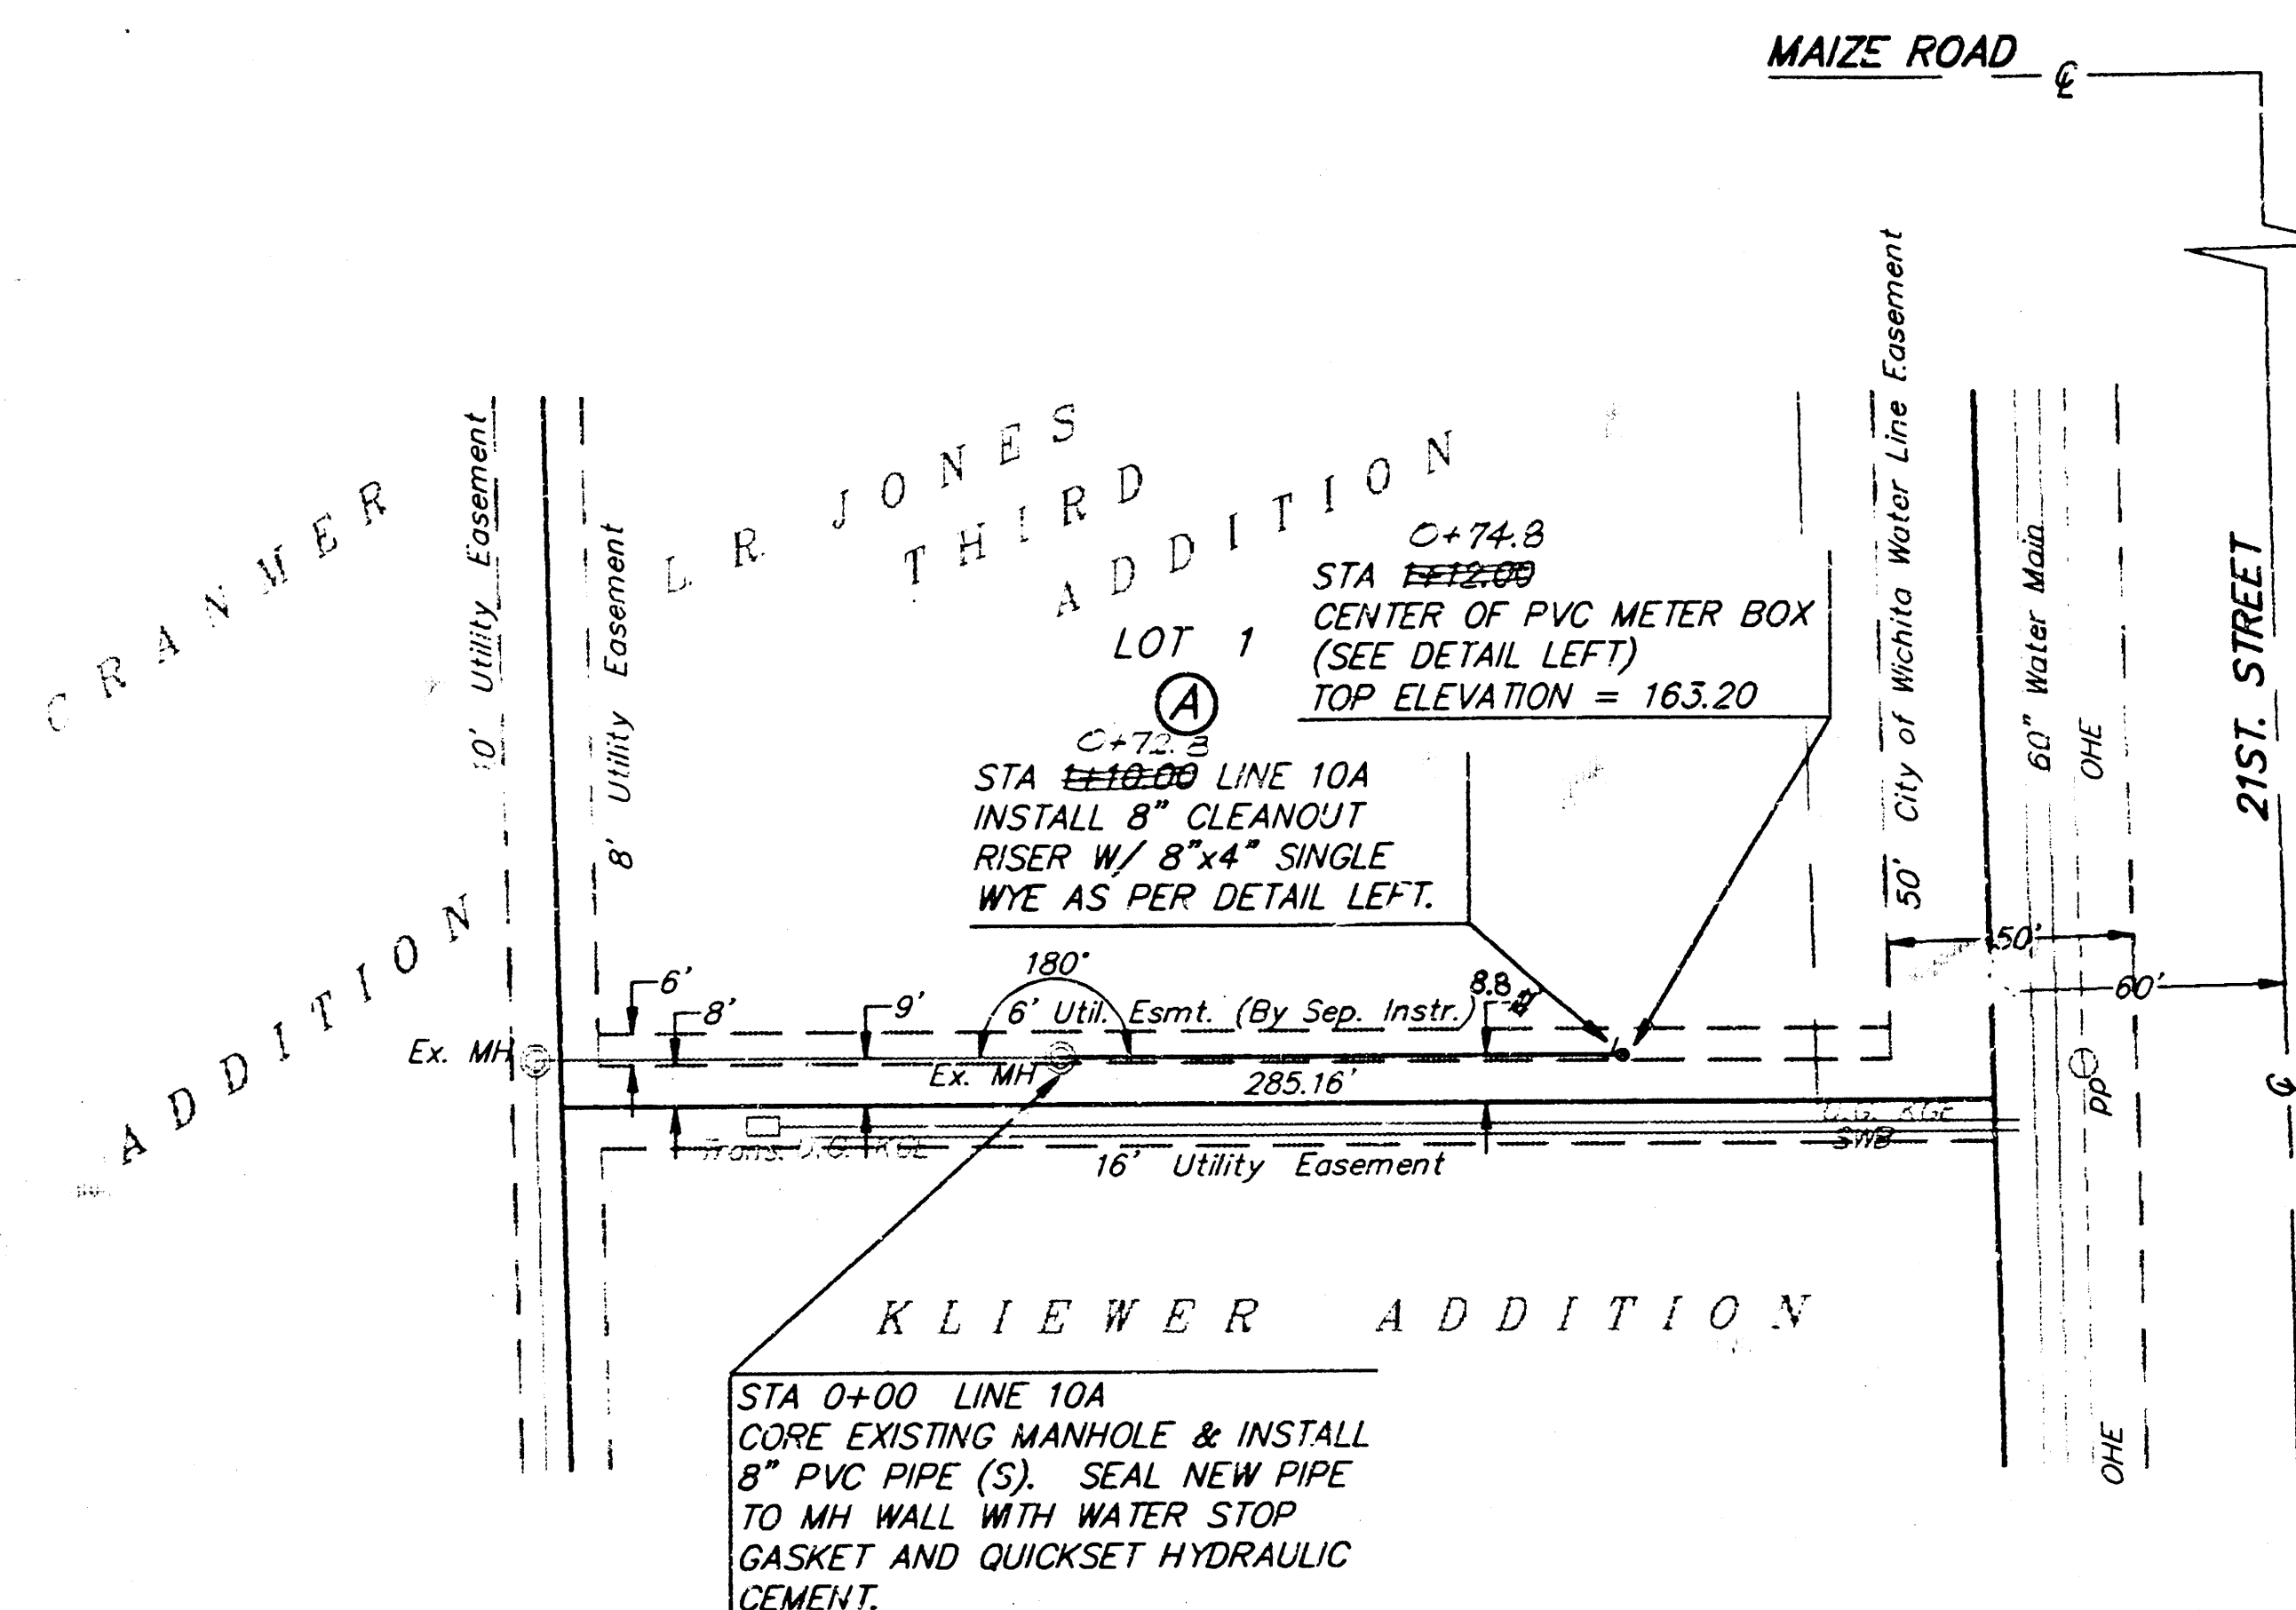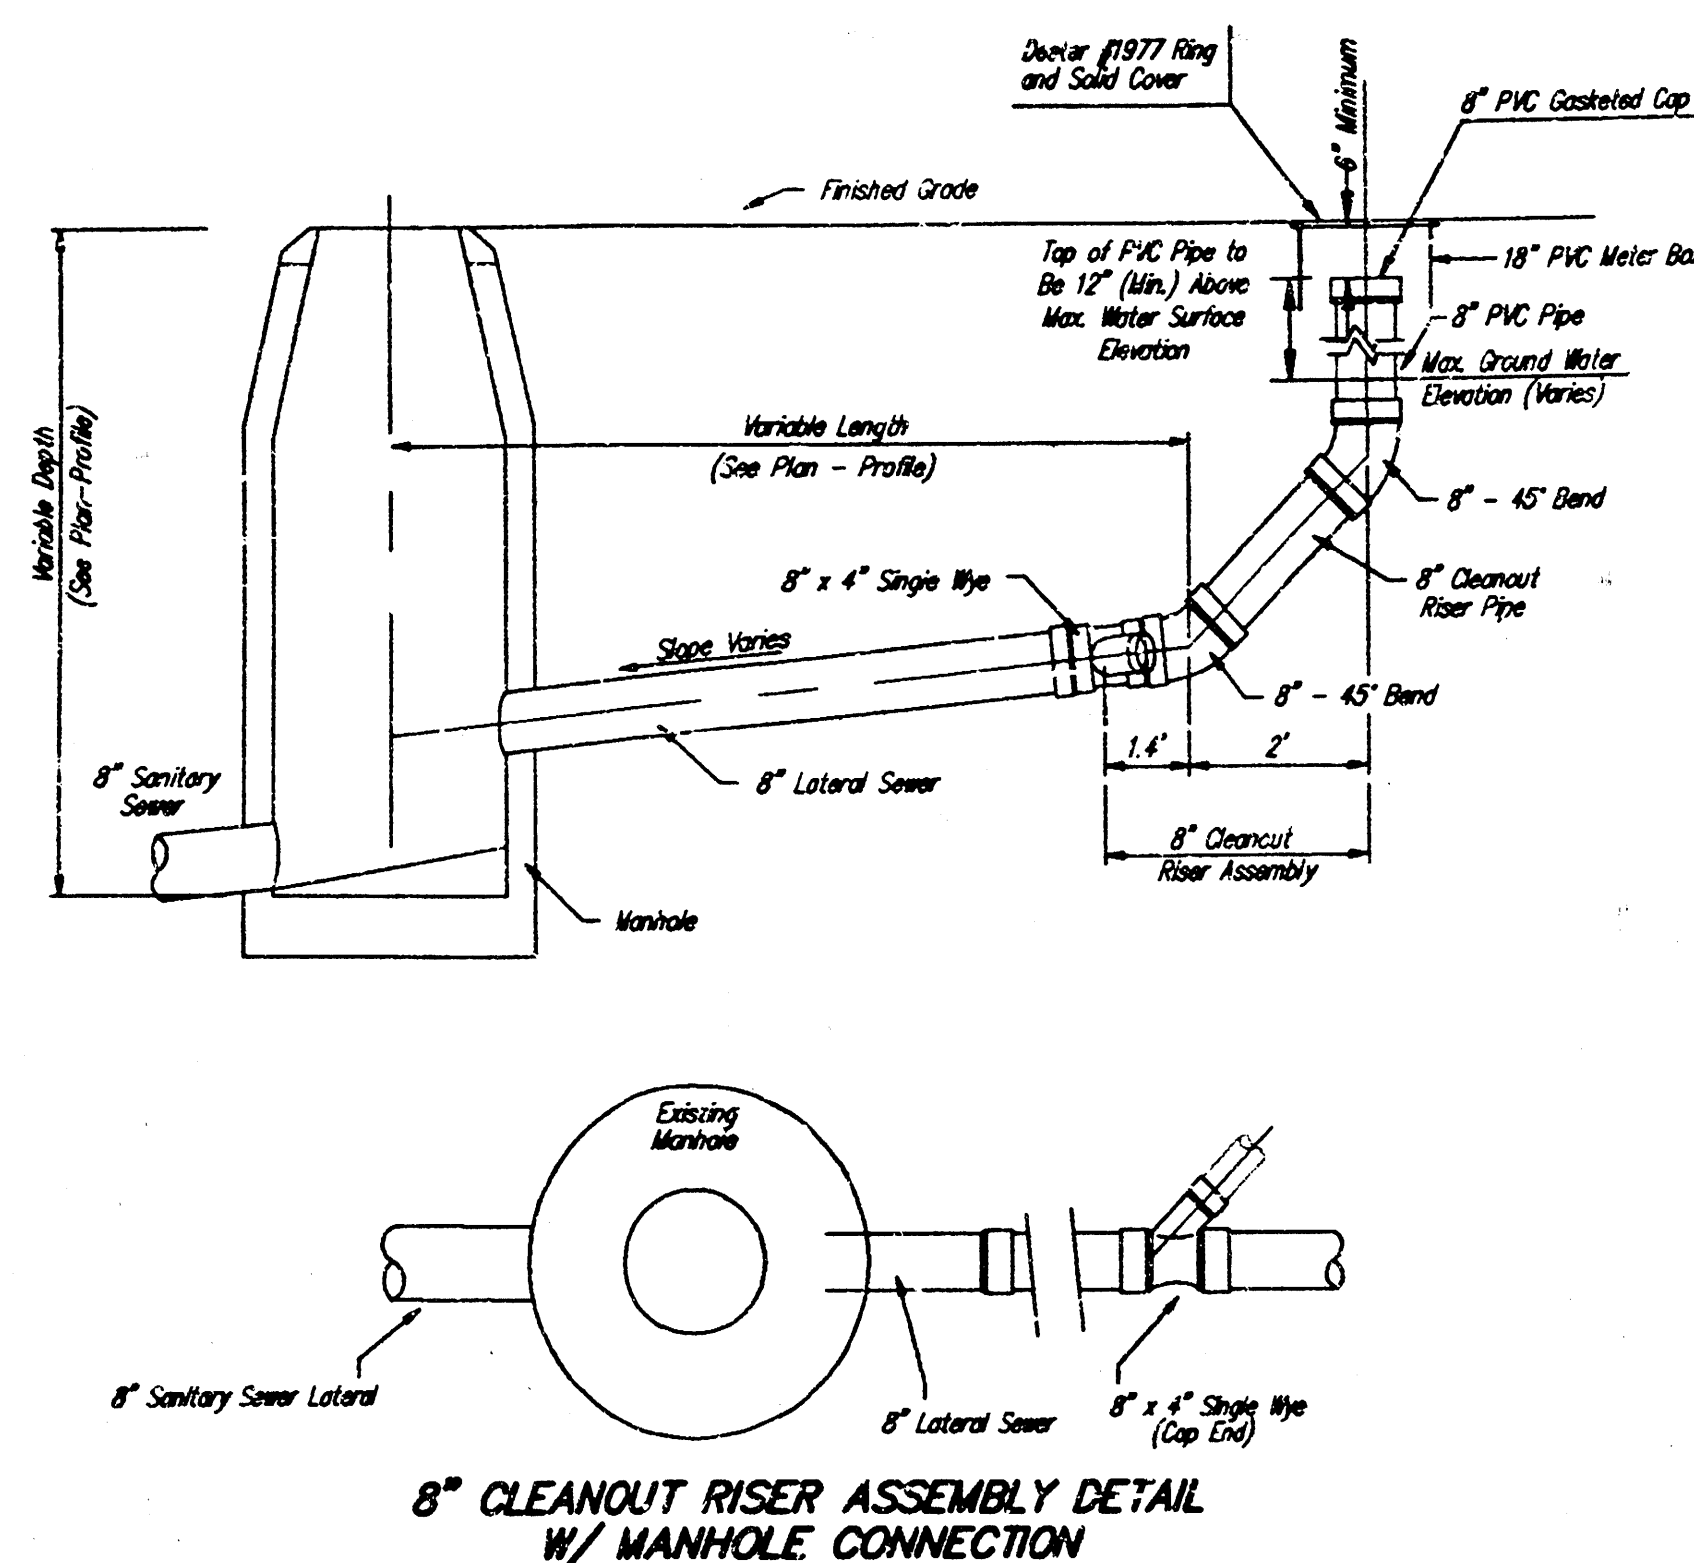

Booked 10-13-95
From AS Buhr

SANITARY SEWER EXTENSION TO SERVE L.R. JONES ADD. PRIVATE PROJECT			
 BAUGHMAN COMPANY P.A. ENGINEERING, SURVEYING, & PLANNING 316-262-7271 • 315 ELLIS • WICHITA, KANSAS 67211			
PROJECT NUMBER 552 PPS (607861)			SHEET OF 1
DESIGN DY	DRAWN DY	APPROVED DATE 4/7/95	SCALE NOTED

AS BUILT 10/9/95 DY