



AS BUILT
PLANS

PLAN SCALE 1"=40'
PROFILE SCALE 1"=4' HOR, 1"=12' VERT

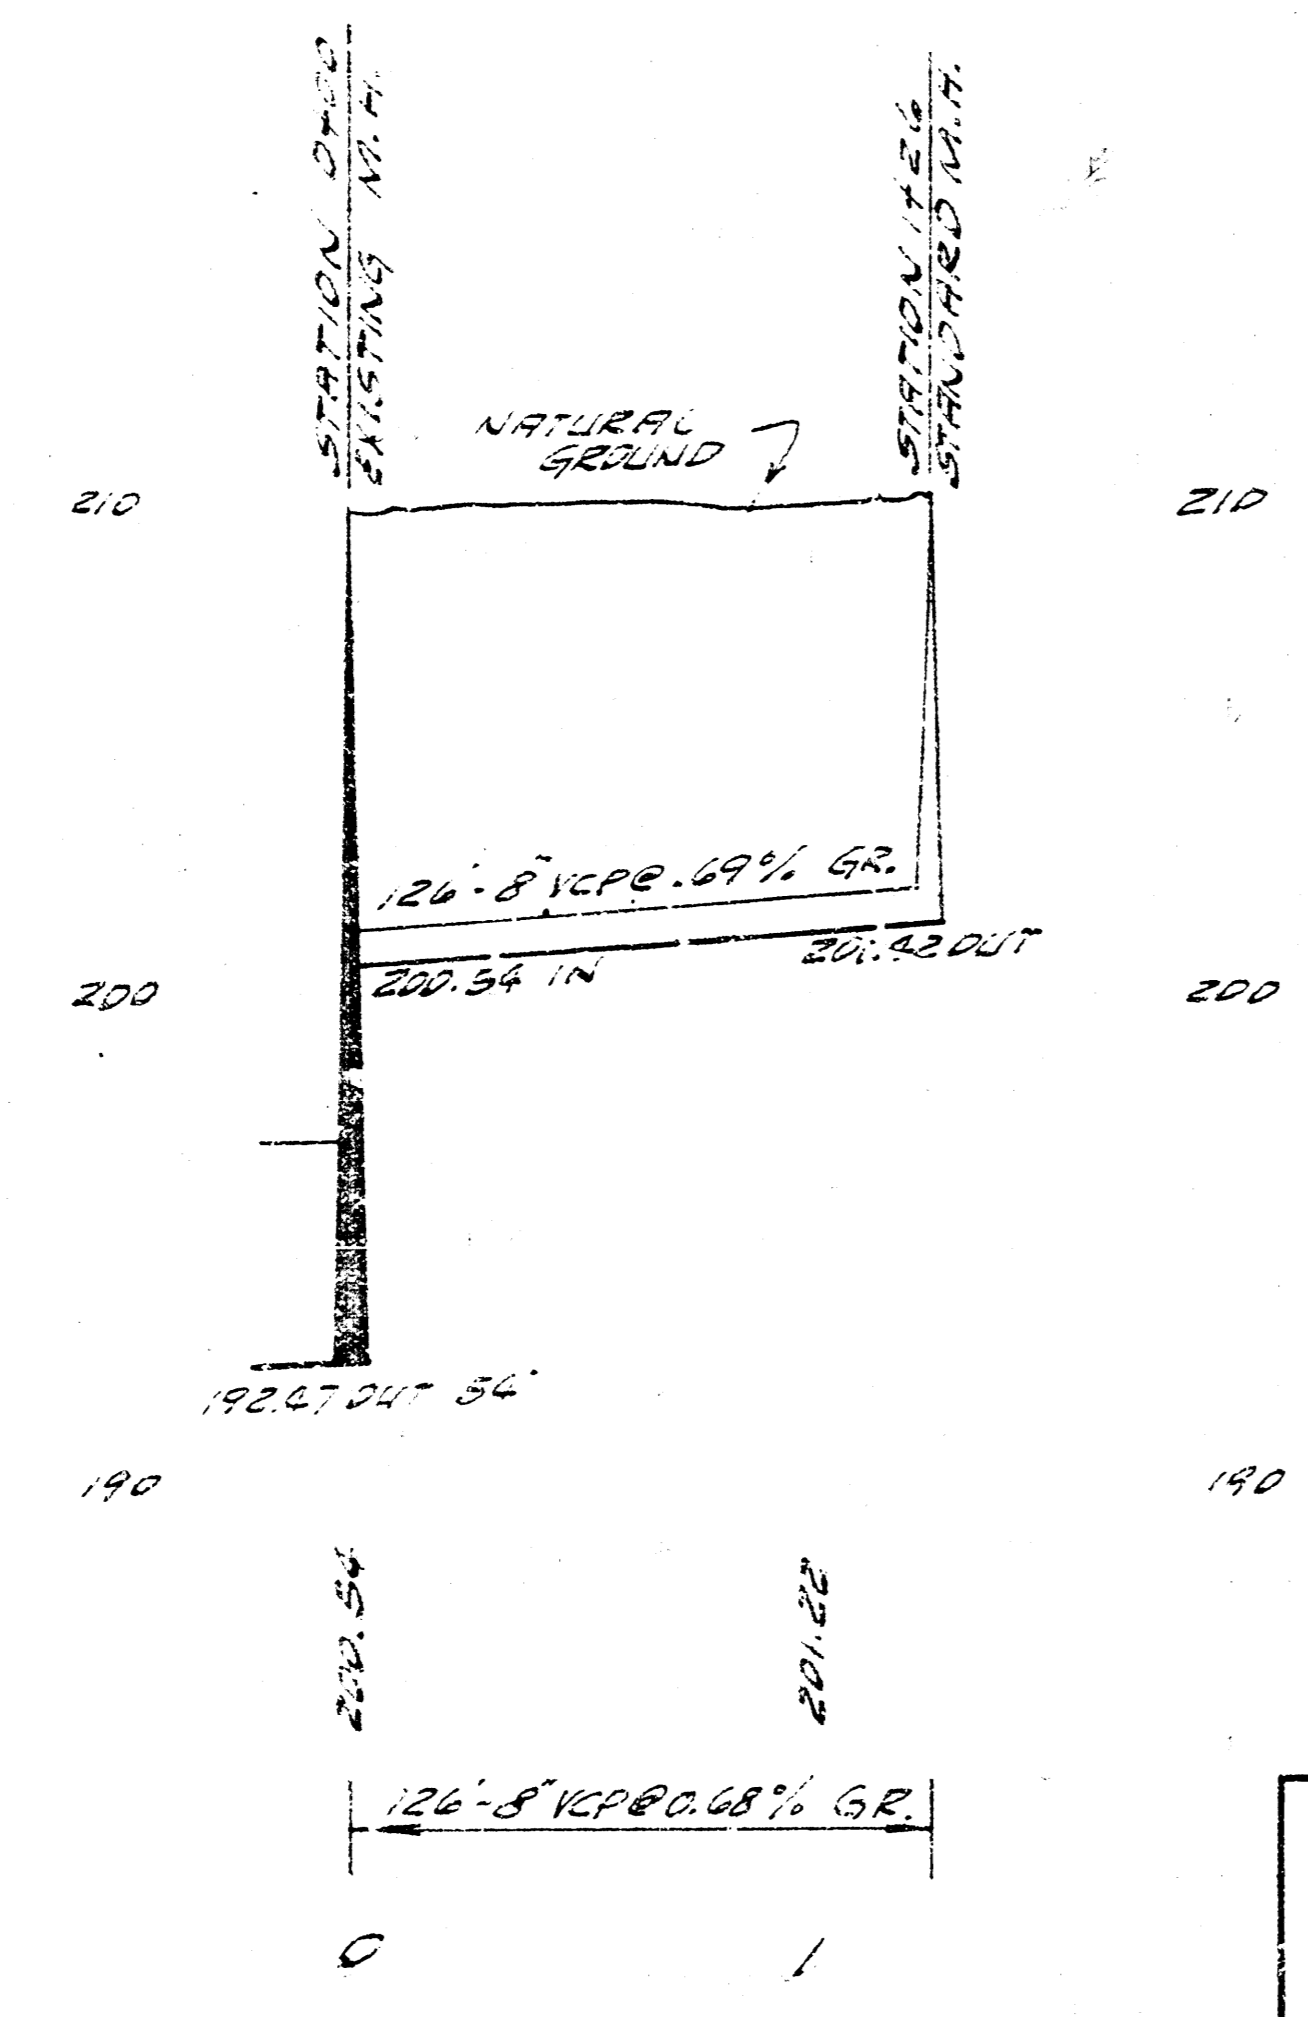


AS BUILT
PLANS

PRIVATE SAN. SEWER FOR
EAST HIGH SCHOOL
CITY OF WICHITA KANSAS
B.E. SMITH CITY ENGINEER
PRIVATE JOB. NOV. 1960

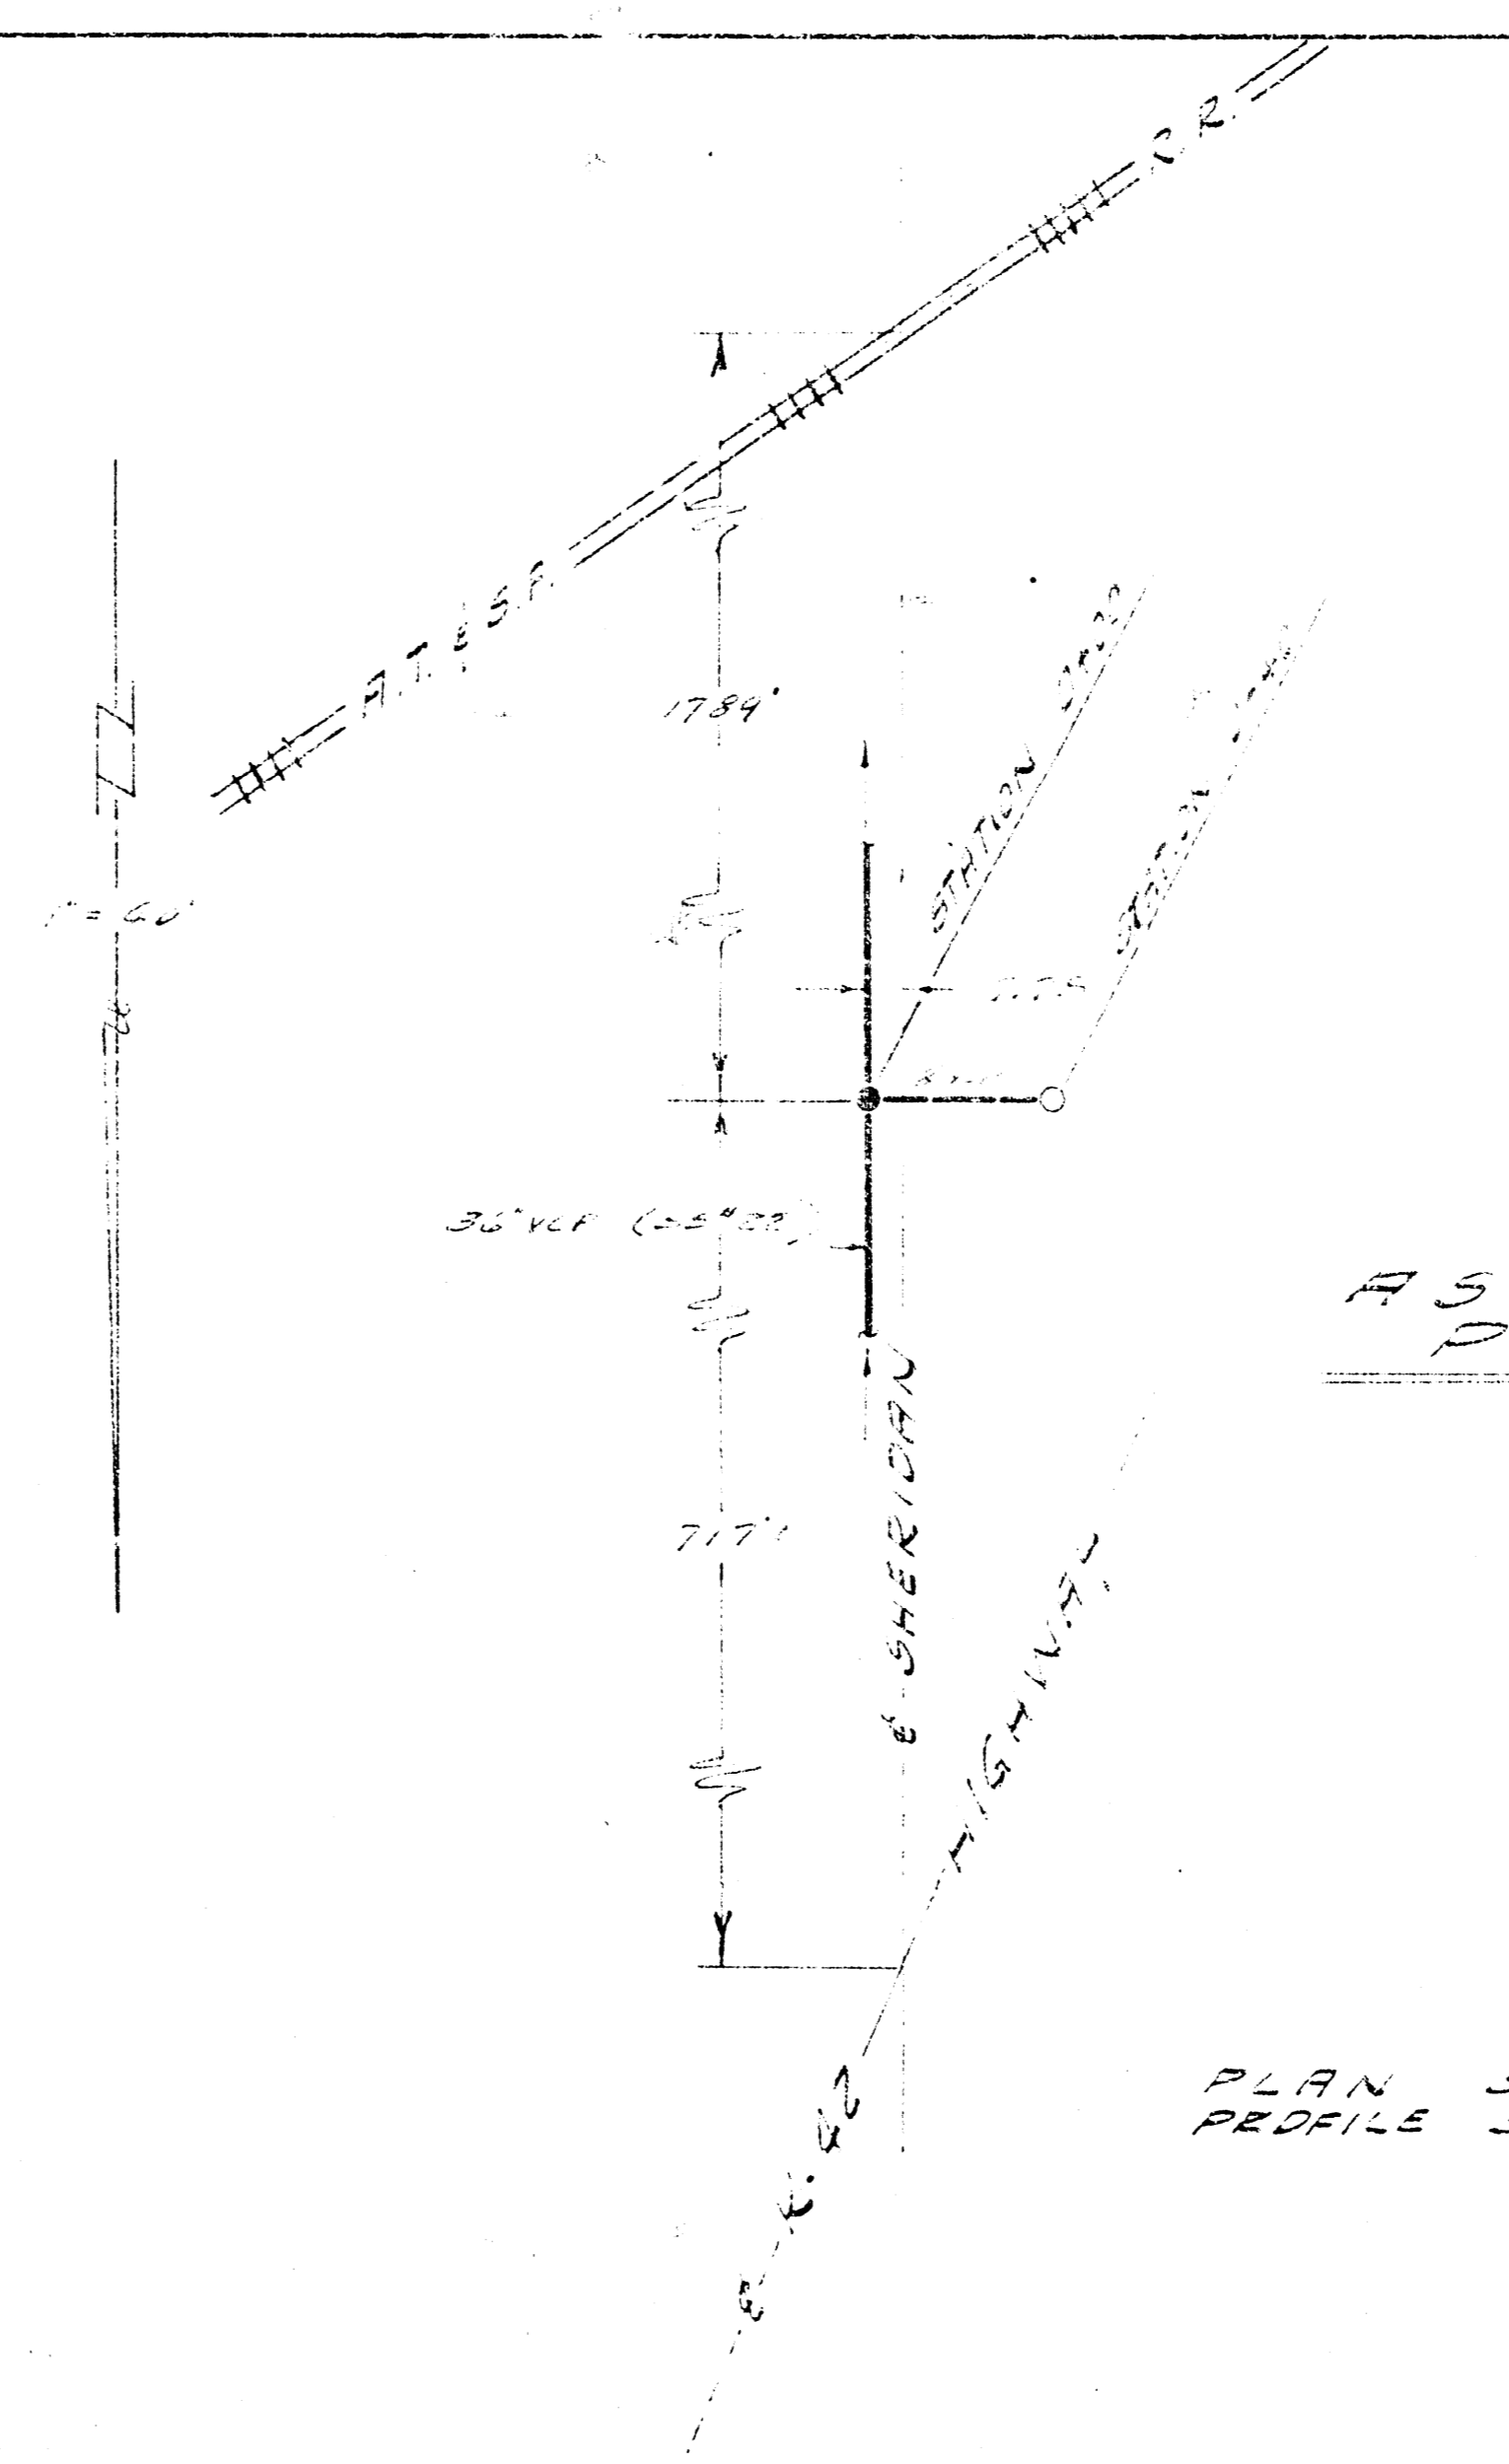

AS BUILT
PLANS

PLAN SCALE 1"=40'
PROFILE SCALE 1"=4' HOR, 1"=12' VERT

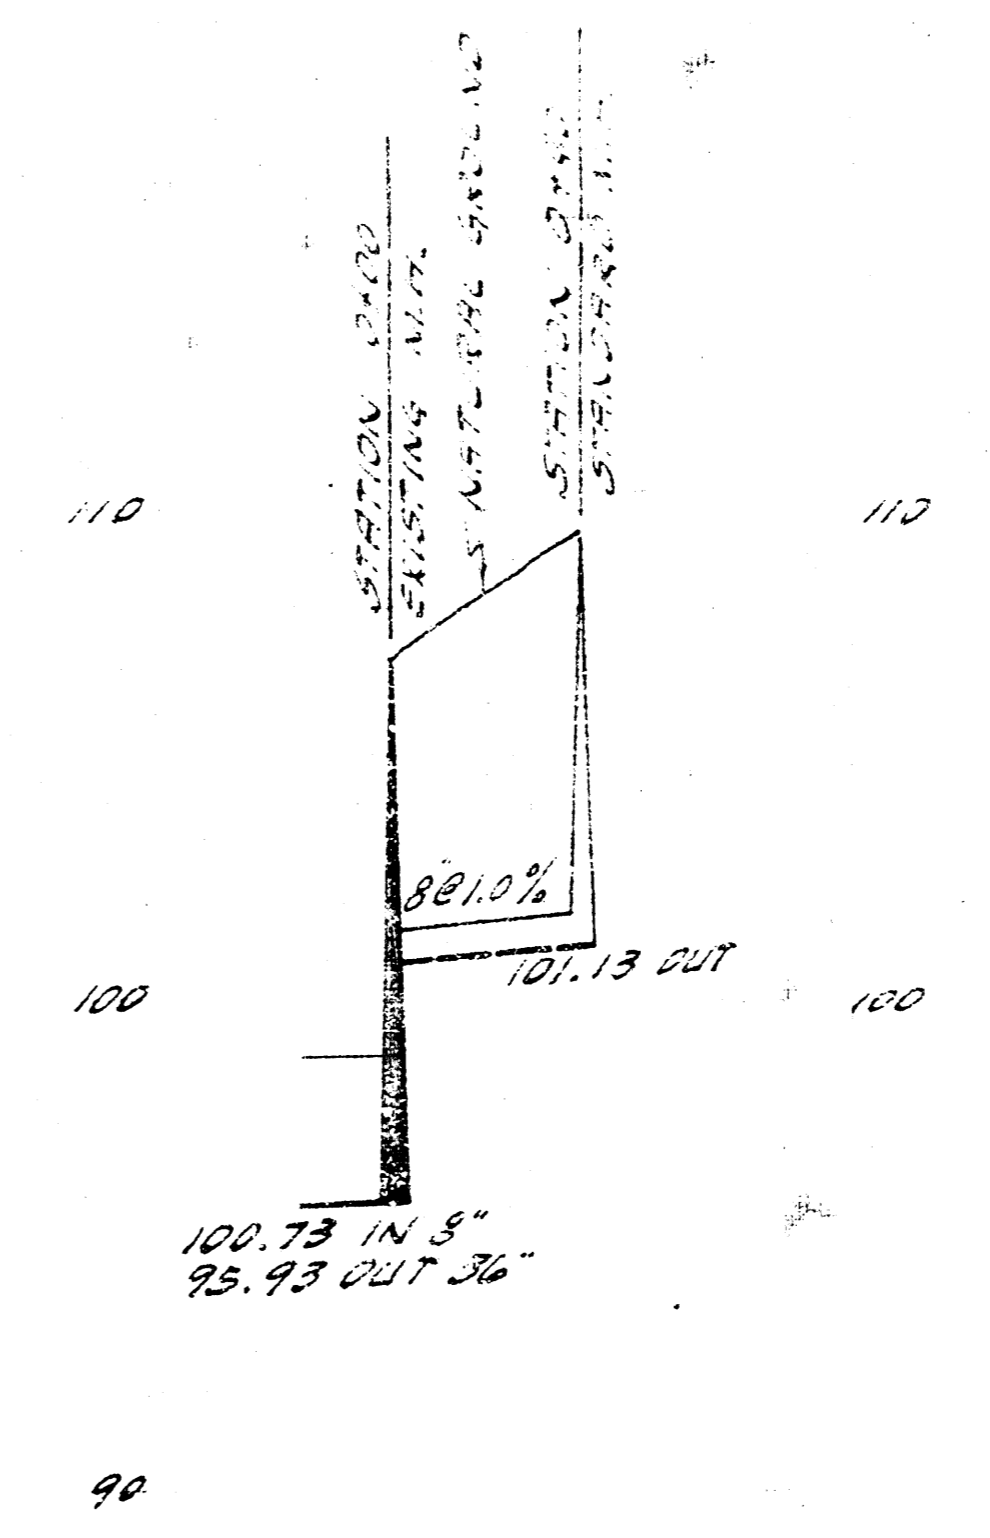

AS BUILT
PLANS

PRIVATE SAN. SEWER AT
SW. COR. K-92 & SHERIDAN
CITY OF WICHITA KANSAS
B.E. SMITH CITY ENGINEER
PRIVATE JOB NOV. 1960.