


Scale
HORIZ 1"=20'
VERT 1"=5'

PLAN
REVISION
DATE
BY
CHECKED
DATE
BY
NOTED
DATE
BY
APPROVED
DATE
BY

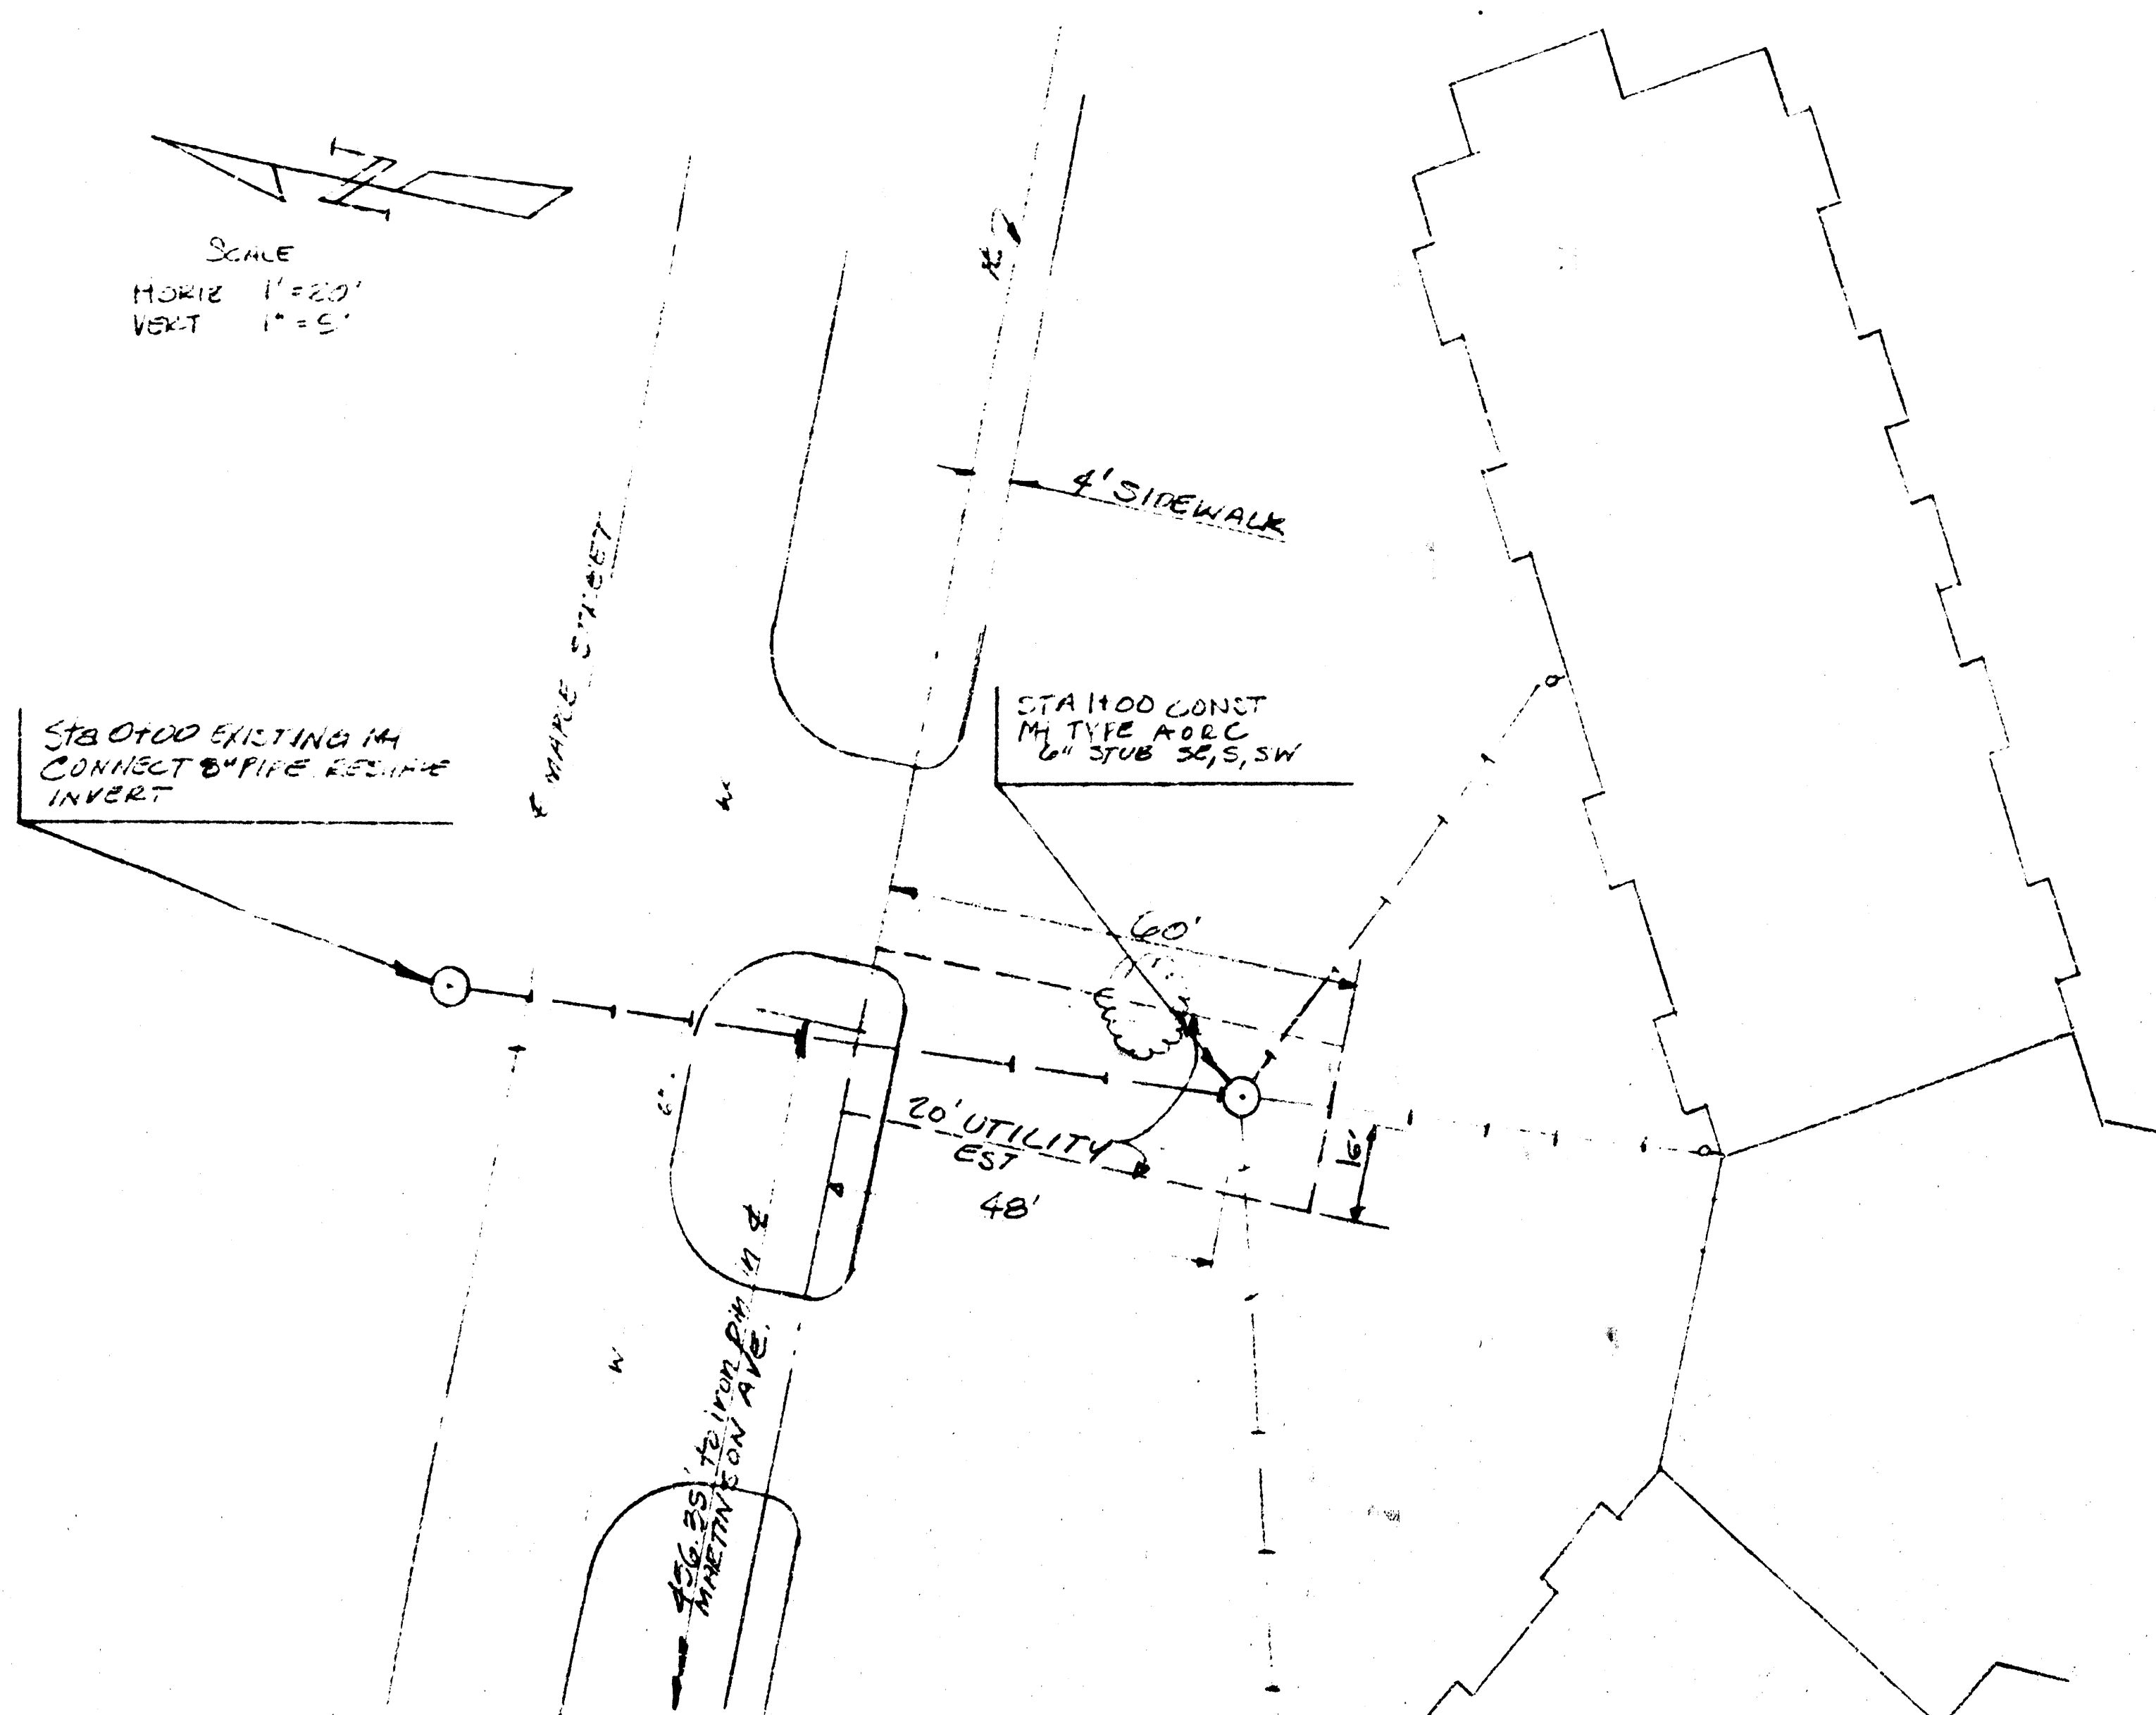

BM: FINISH FLOOR ELEV. 113.00
CITY DATUM

MARK JOHNSON JOB FOREMAN
267-7310

NOTE TO CONTRACTOR
This project will be constructed under the supervision of the CITY ENGINEER and conforming to the SPECIFICATIONS of the CITY OF WICHITA. The CONTRACTOR will reimburse the City of Wichita for all cost of inspection.

4-21-80

APPROVED AS NOTED
By CITY ENGINEER OF WICHITA
Sanitary Sewers
Storm Sewers
Driveway Approaches



UTILITY CONTRACTORS, INC.
838 NORTH MARKET - P.O. BOX 2670
WICHITA, KANSAS 67203 - (316) 265-9000
KENDALL INC.
SANITARY SEWER EXTENSION
KANSAS MASONIC HOME
1211 WEST MAPLE STREET
JOB # U-1997 BY S. RAMSEY
DATE: APRIL, 1980 SHEET 1 of 1

PROFILE
REVISION
DATE
BY
CHECKED
DATE
BY
NOTED
DATE
BY
APPROVED
DATE
BY

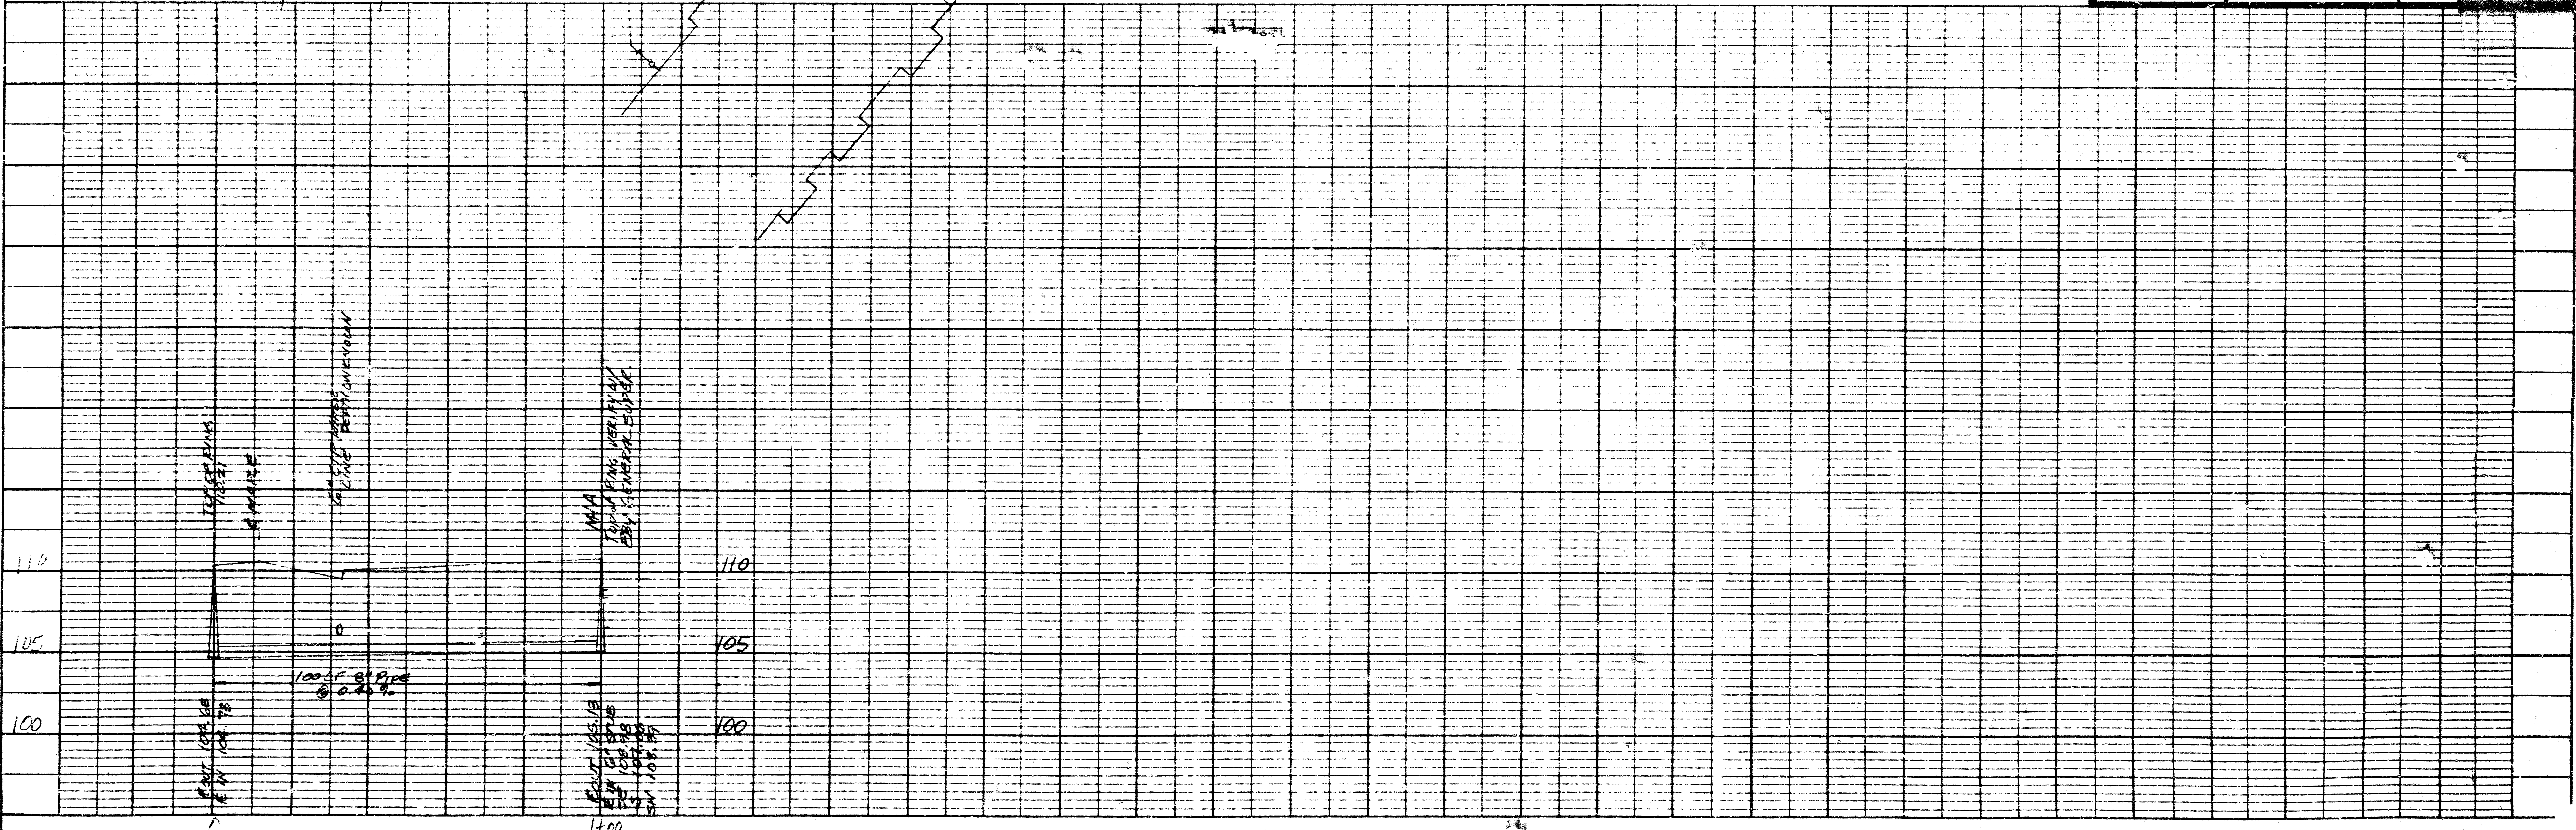


PLATE 1 PLAN, PROFILE & A
CLEARPRINT LITHO CO. INC.
NO. 1000-1

468-76-245-80000-000-008

12 10 S