

PLANS

FOR

SANITARY SEWER SYSTEM

FOR

LAMPLIGHTER MOBILE HOME PARK

WICHITA, SEDGWICK COUNTY, KANSAS

CITY OF WICHITA PRIVATE PROJECT NO. 468-76-245-80001-000-000-055

1986

APPROVED AS NOTED
By CITY ENGINEER OF WICHITA
Sanitary Sewers *OK 4/2/86*
Storm Sewers _____
Driveway Approaches _____
Water Mains _____
Paving _____

NOTE TO CONTRACTOR
This project will be constructed under the supervision of the CITY ENGINEER and conforming to the SPECIFICATIONS of the CITY OF WICHITA. The CONTRACTOR will pay the City of Wichita for all costs of plan review, inspection and booking per contract.


INDEX OF SHEETS

SHEET 1	TITLE SHEET
SHEET 2	LAYOUT MAP
SHEET 3	UTILITY MAP
SHEET 4	MAIN I
SHEET 5	LATERAL A
SHEET 6	LATERAL B
SHEET 7	LATERALS C, C-1, D, & E
SHEET 8	LATERALS F, G, H, I, & J
SHEET 9	TYPE "A" & "B" MANHOLES & CONCRETE ENCASEMENT
SHEET 10	SHALLOW MANHOLES, TYPE "A" & "B"
SHEET 11	MANHOLE ADJUSTMENT DETAILS
SHEET 12	RISER DETAILS
SHEET 13	MANHOLE DETAIL, TYPE "C"


BM:
RAILROAD SPIKE IN POWER POLE AT THE
SW COR. OF THE PLAT.
ELEV. 85.23
CITY OF WICHITA DATUM

*AS BUILT
PHASE I
3-15-88
ROL*




NOTE:
CONTRACTOR HAS THE OPTION OF
USING THE TYPE "C" MANHOLE WITH
APPROVAL OF THE ENGINEER

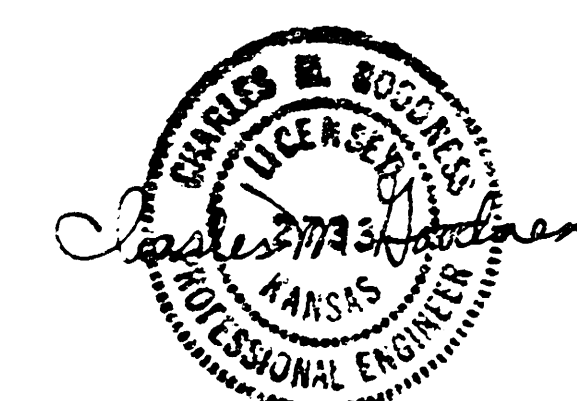

REISS & GOODNESS ENGINEERS
2160 WEST 21ST STREET
WICHITA, KANSAS 67203
(316) 832-0223

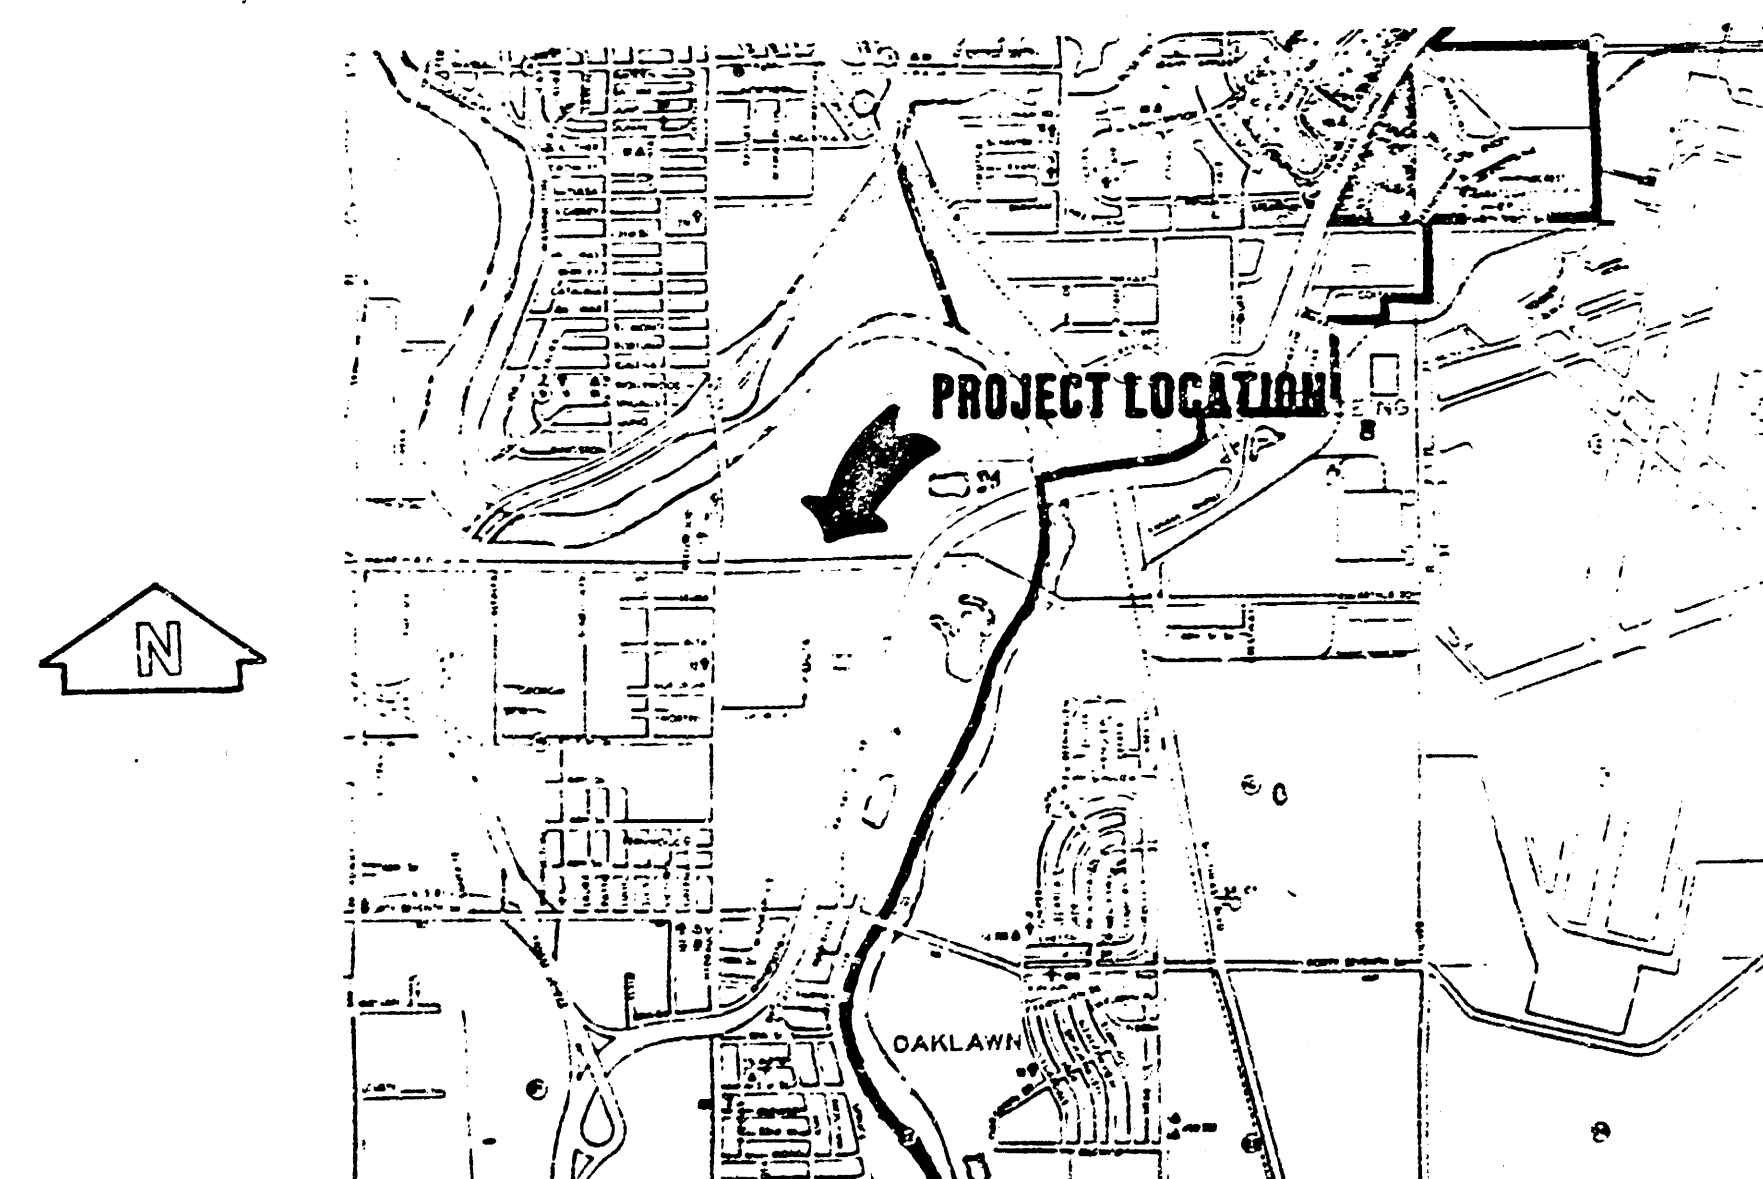

REVISION	DRAWN BY	CHECKED BY	DESIGNED BY	PROJECT	CUSTOMER	SCALE	PROJECT NO.
						DATE	SHEET 1 OF 13

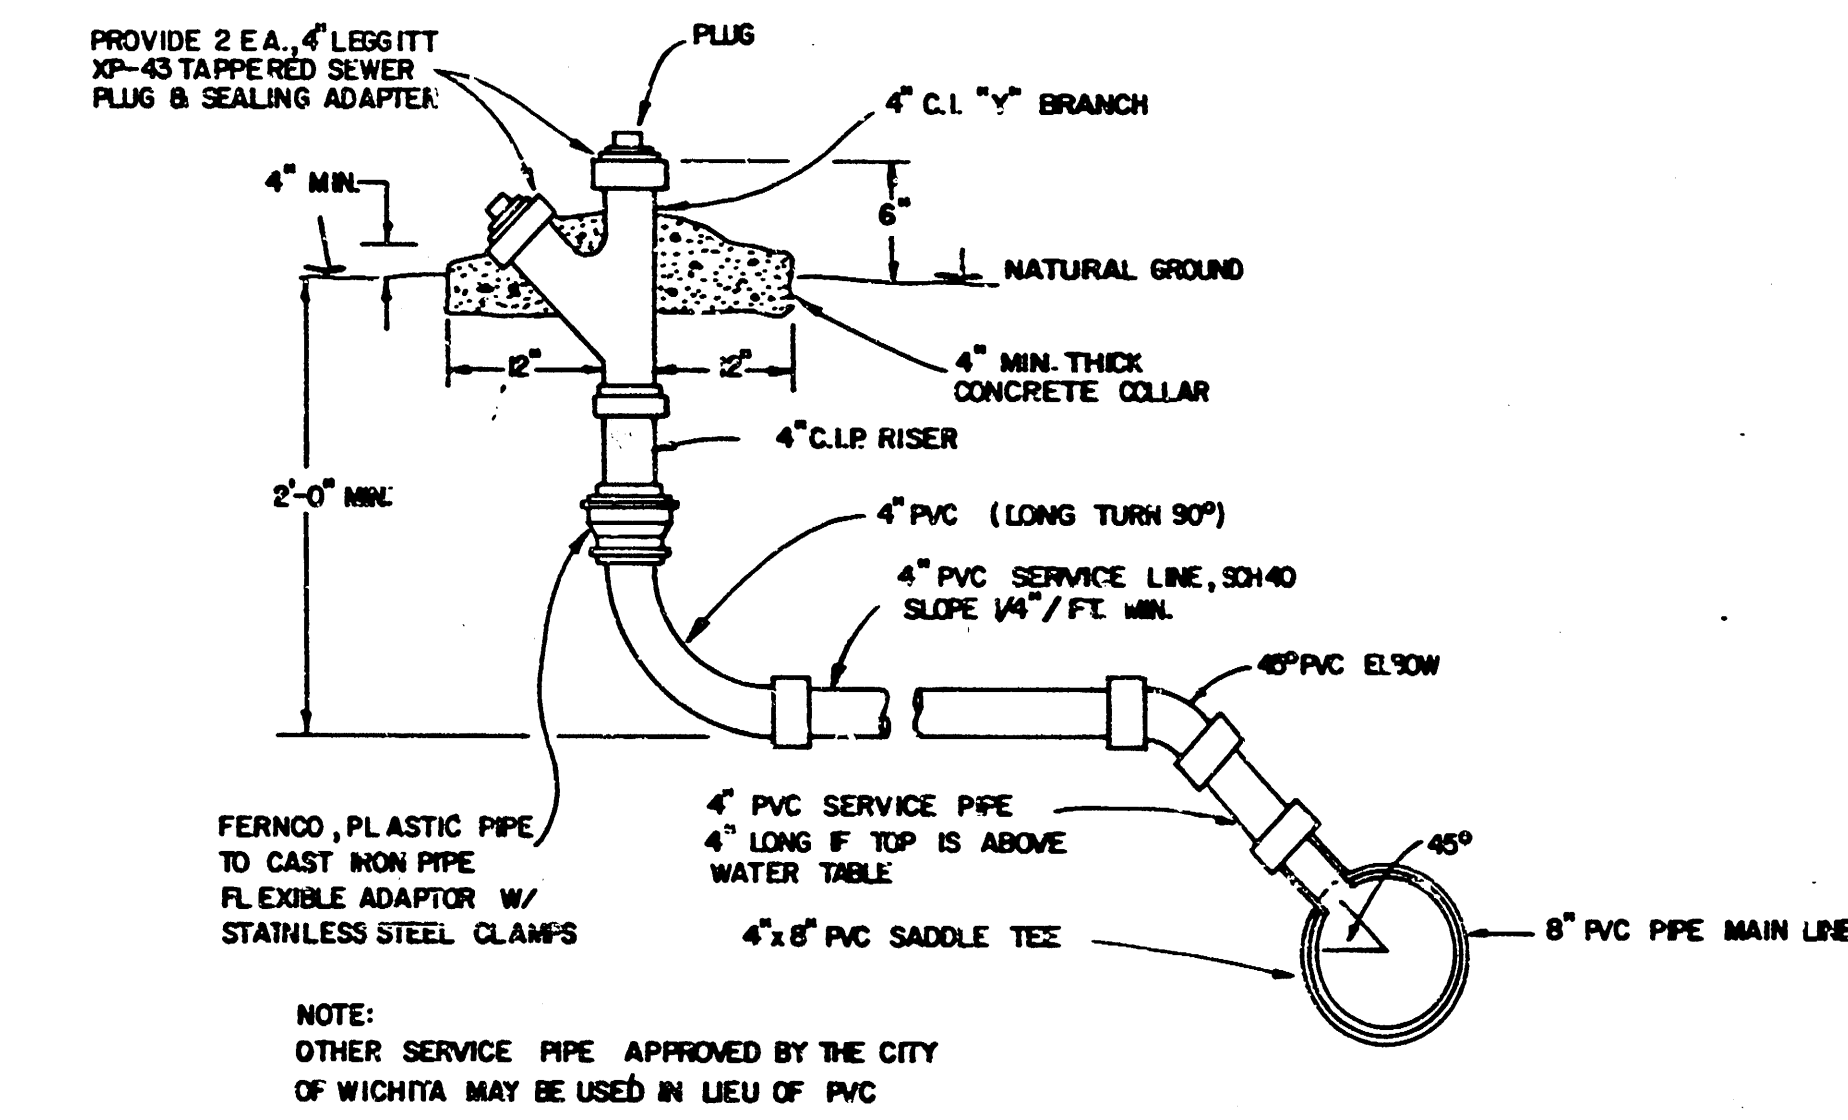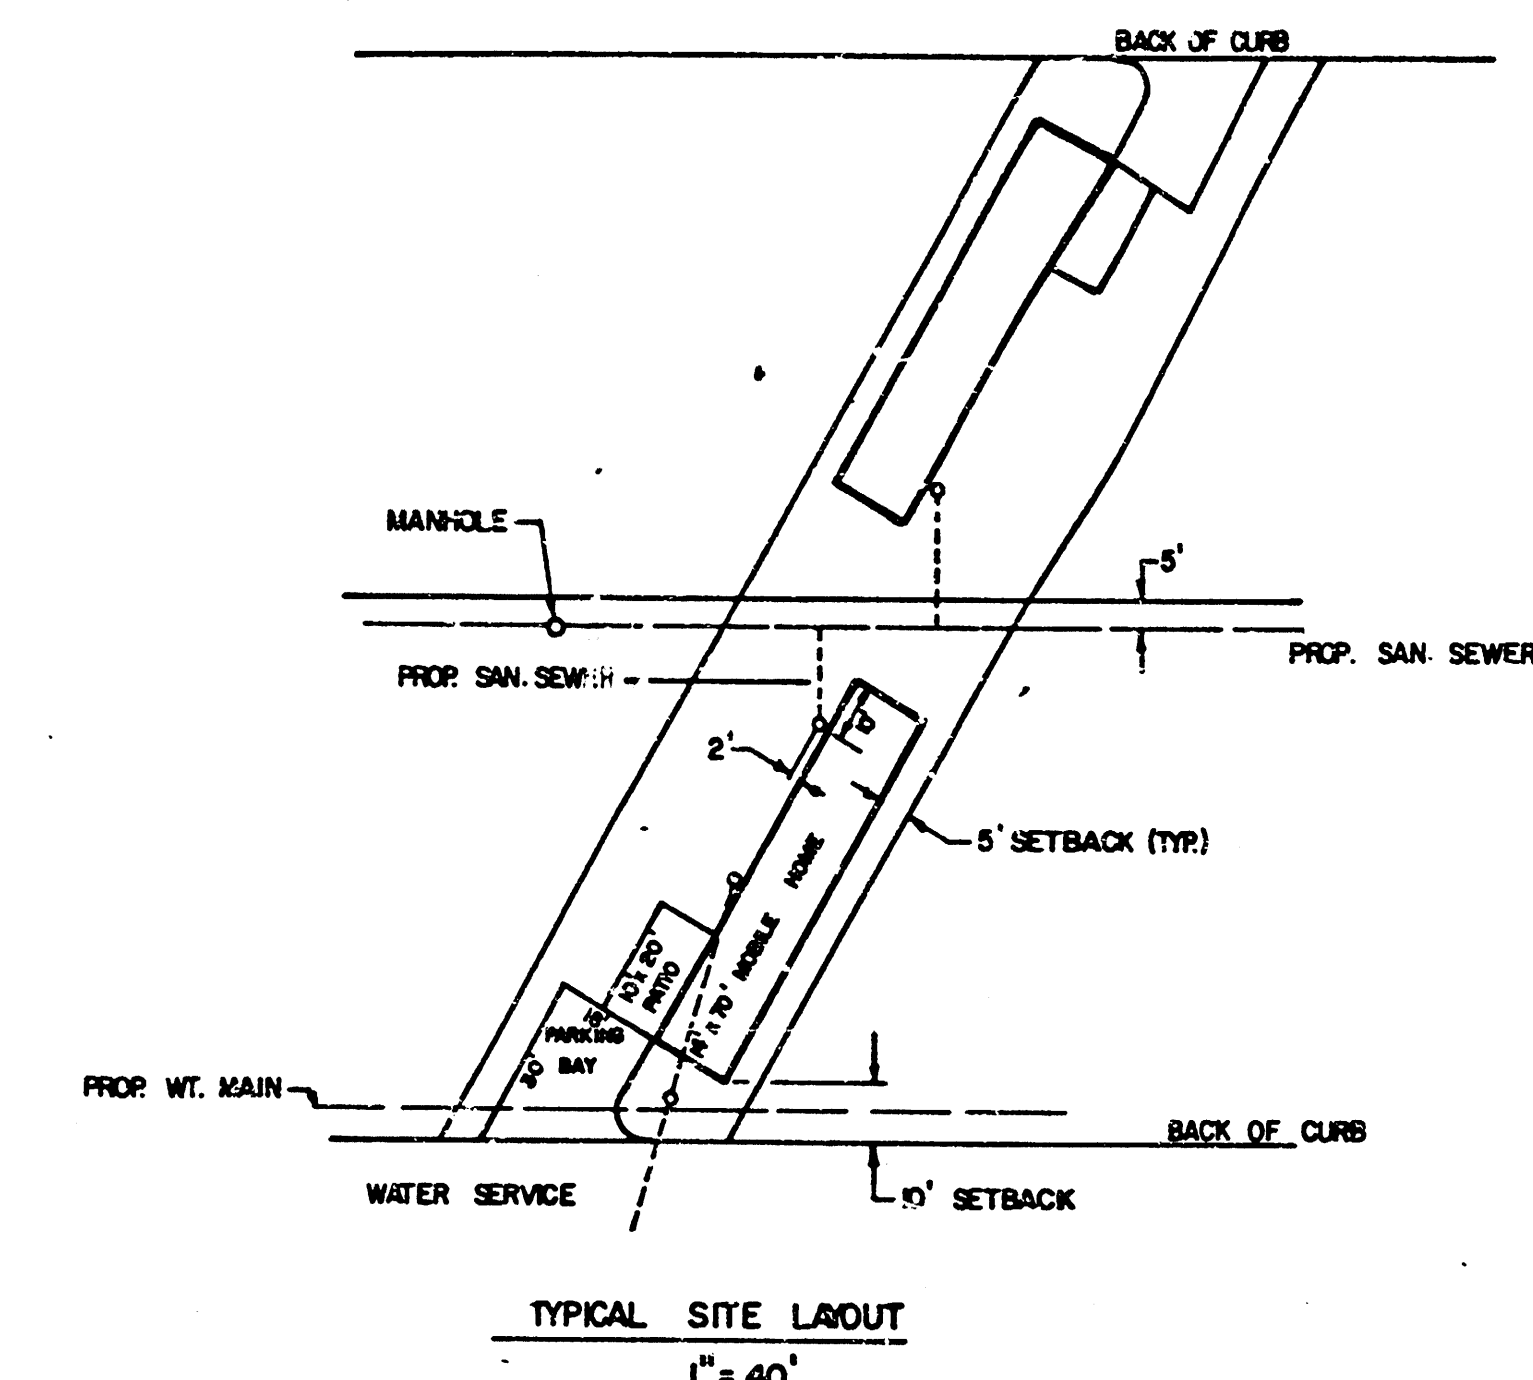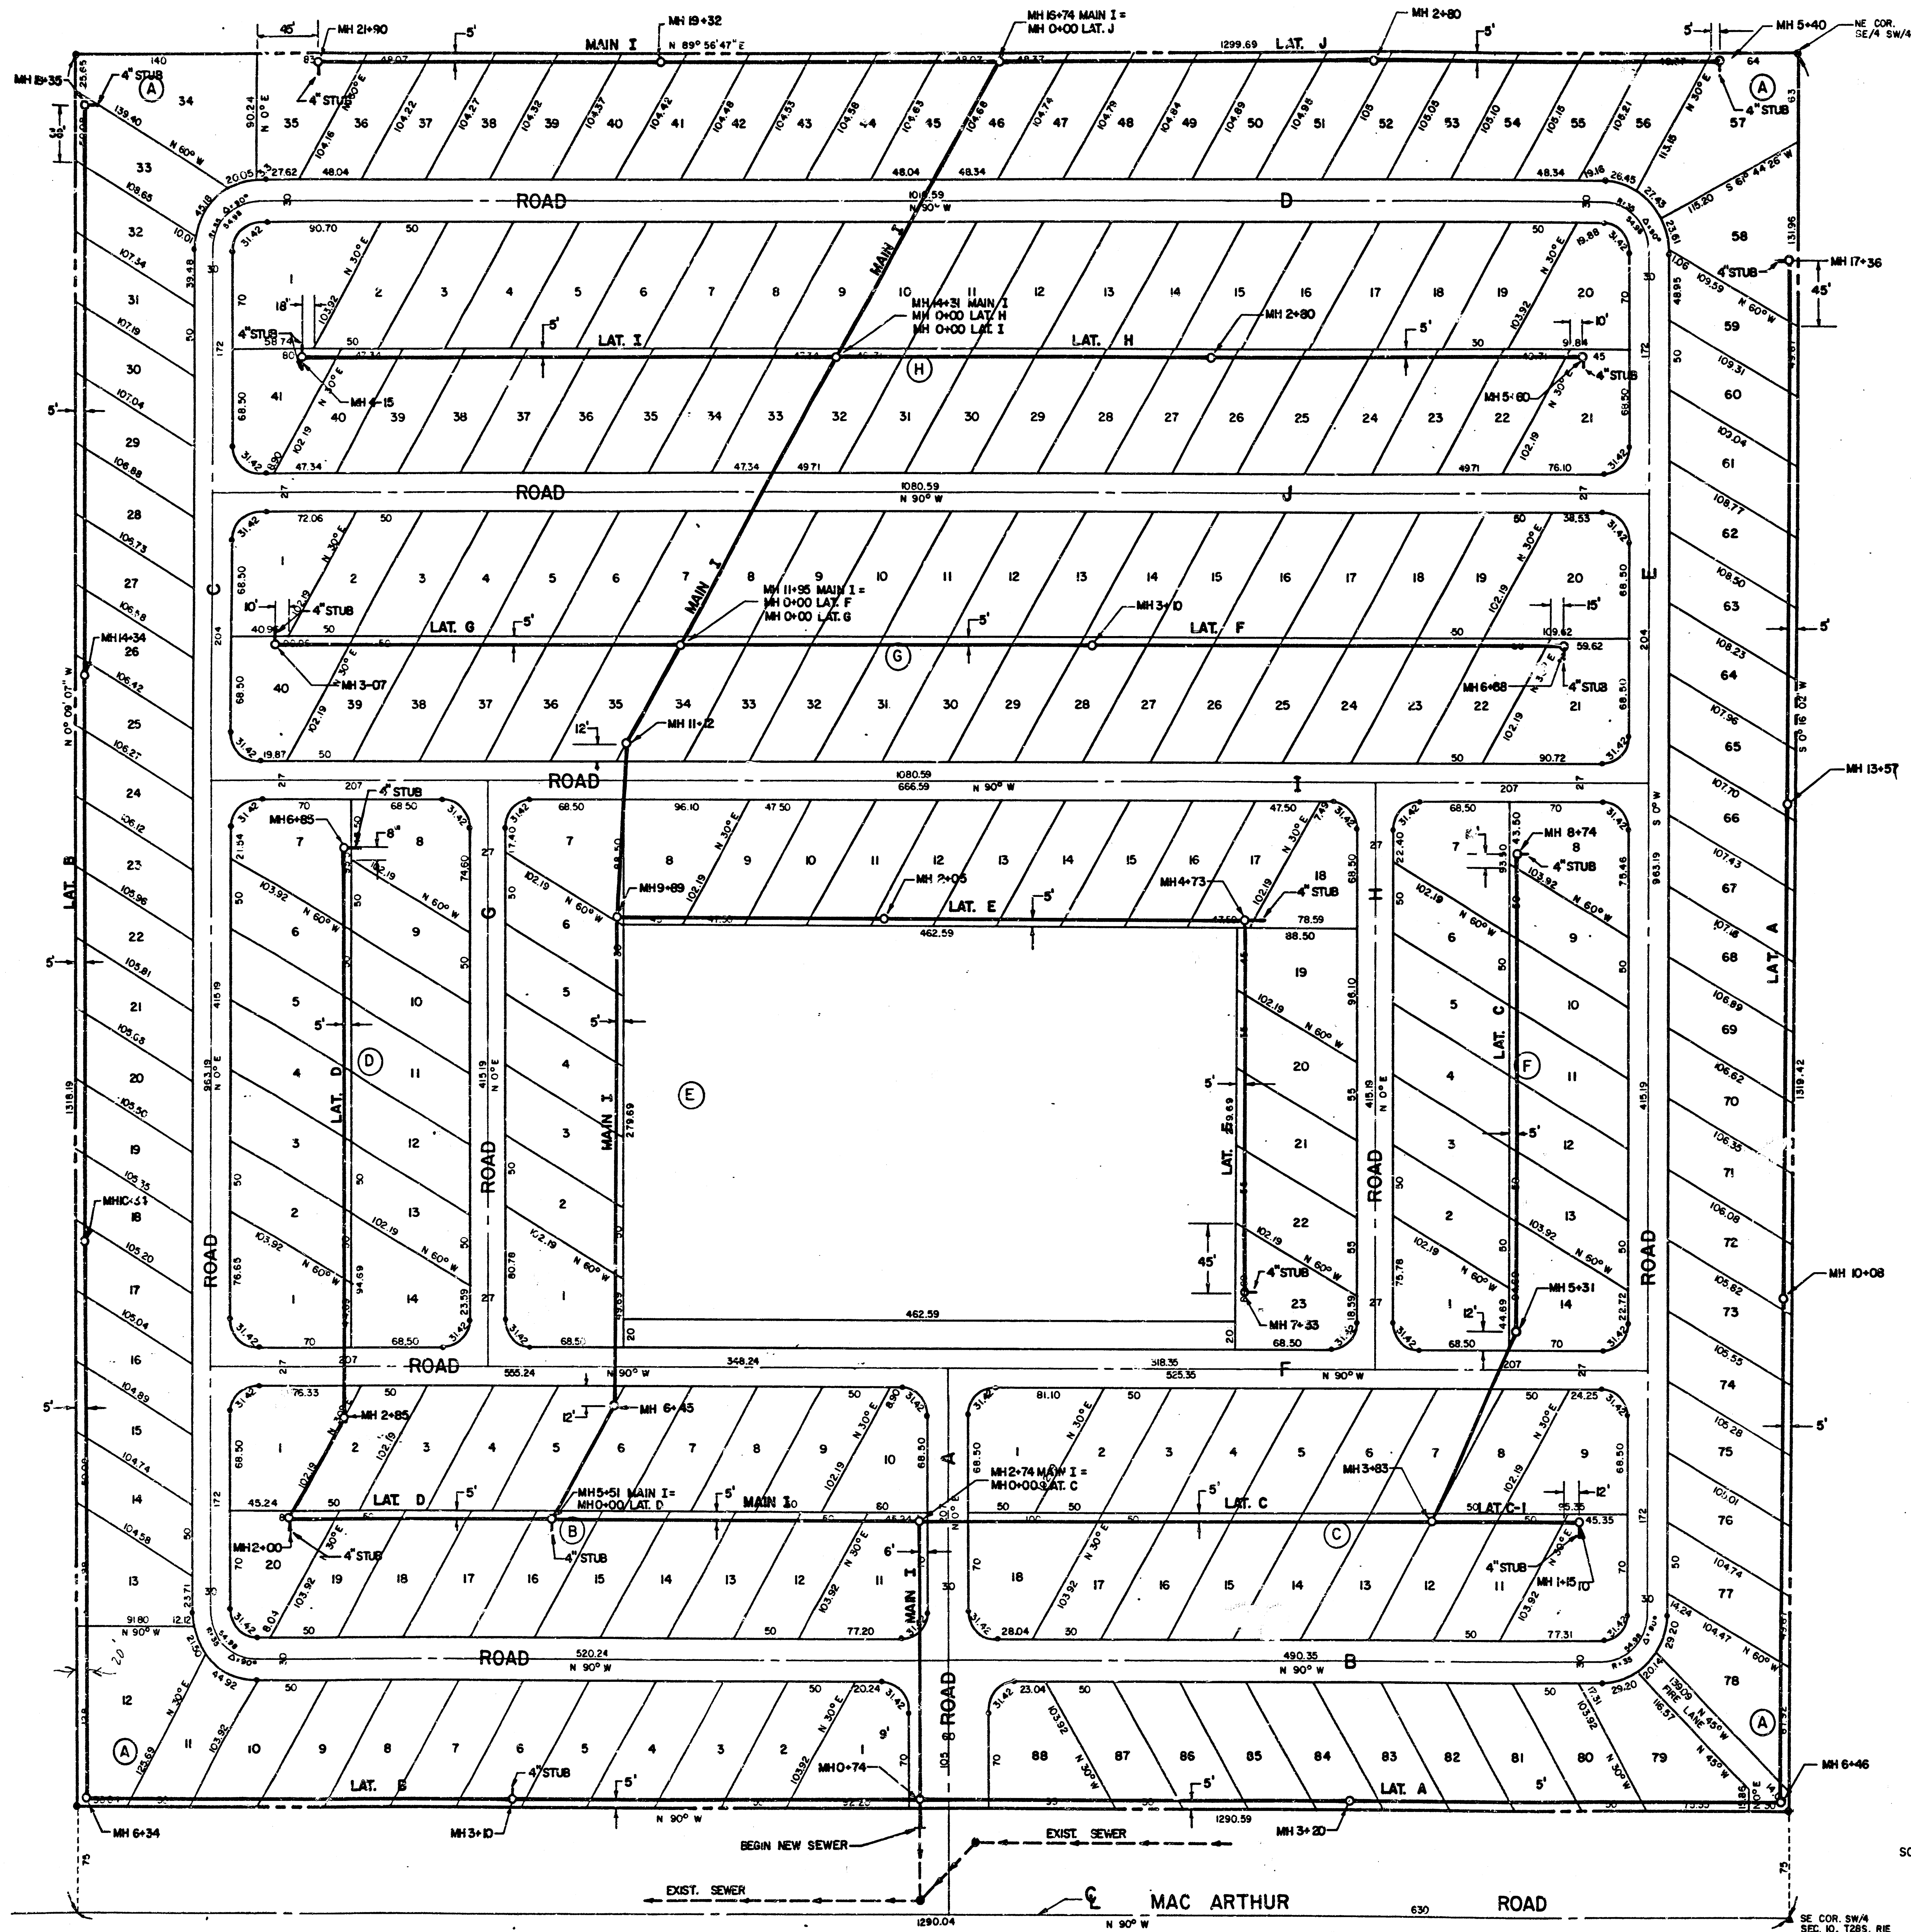

TYPICAL SEWER CONNECTION


FOR SERVICE LOCATIONS-SEE UTILITY MAP

SEWER SYSTEM LAMPLIGHTER MOBILE HOME PARK

WICHITA, SEDGWICK COUNTY, KANSAS

REISS & GOODNESS ENGINEERS
2100 WEST 21ST STREET
WICHITA, KANSAS 67203
(316) 832-0213

SCALE: 1" = 60'

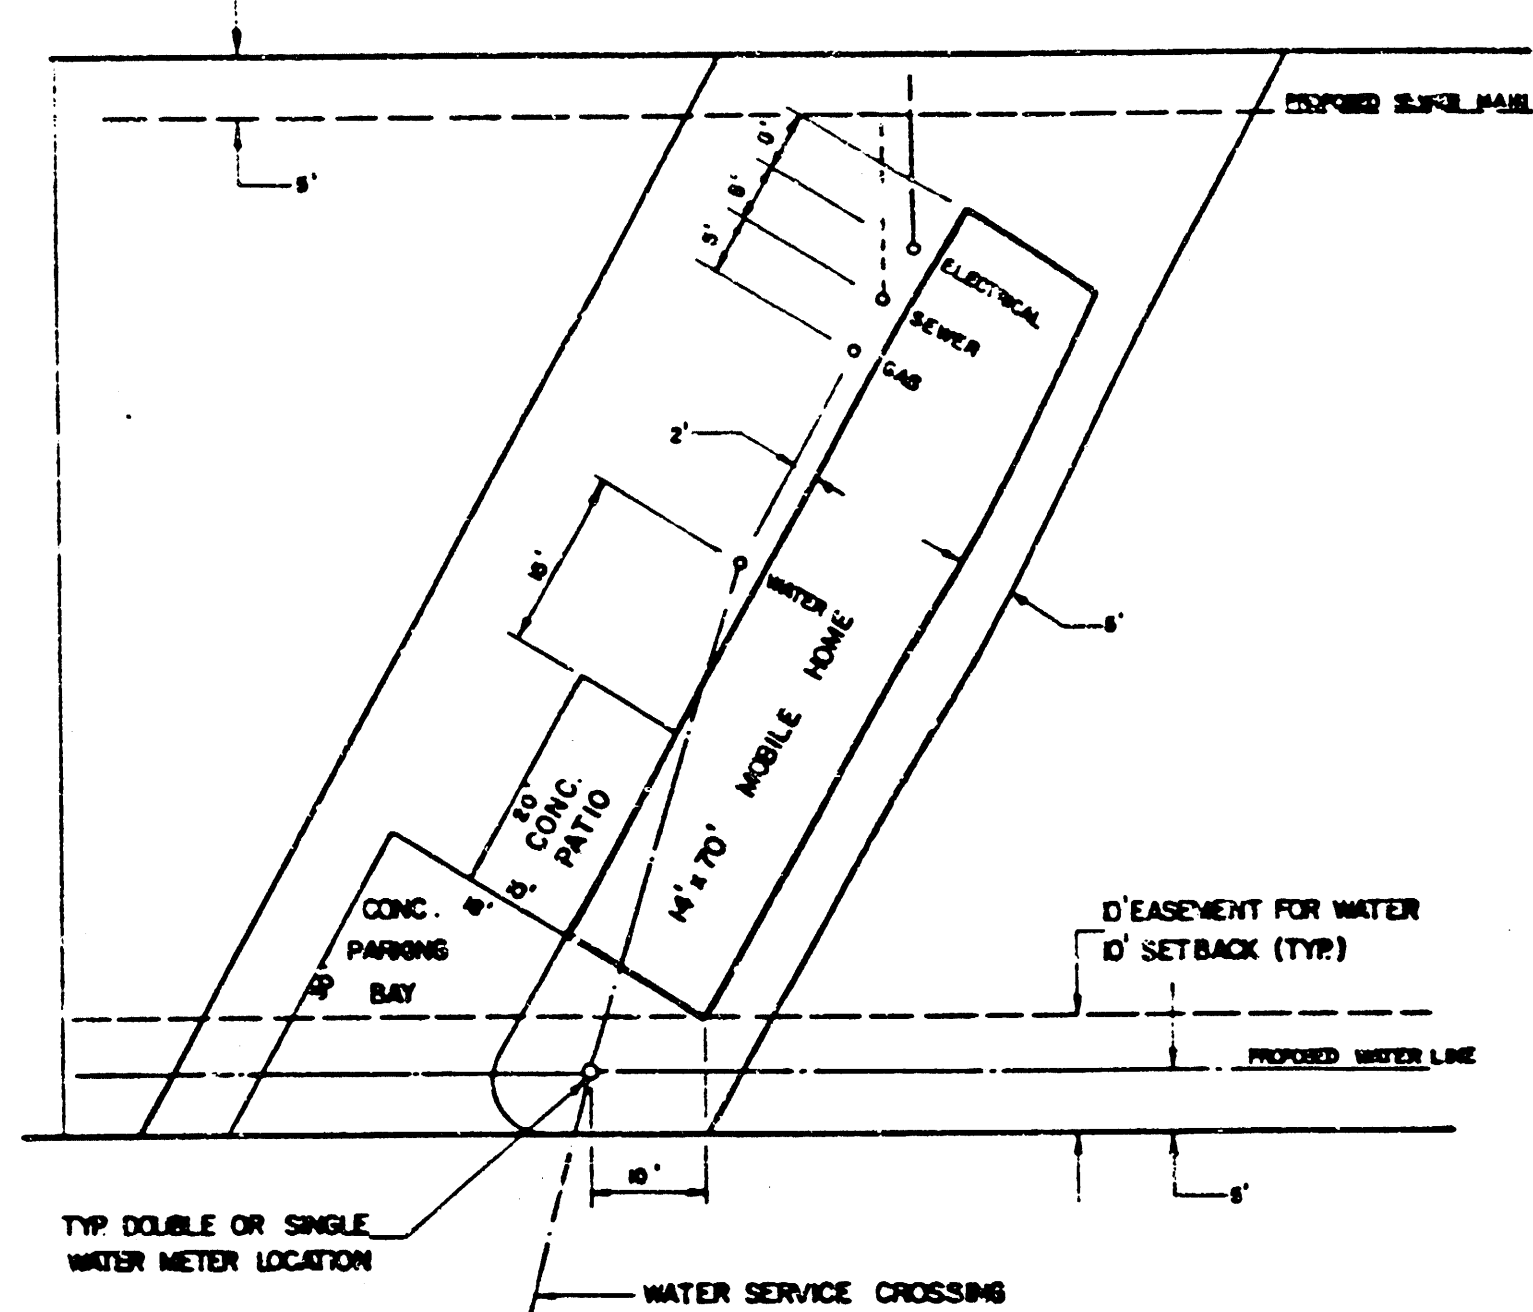

TYPICAL LOT LAYOUT
1" = 20'


— SANITARY SEWER
— WATER

UTILITY MAP LAMPLIGHTER MOBILE HOME PARK

WICHITA, SEDGWICK COUNTY, KANSAS

N
SCALE: 1" = 60'

DEISS & GOODNESS ENGINEERS
2100 WEST 21ST STREET
WICHITA, KANSAS 67204
(316) 528-0229

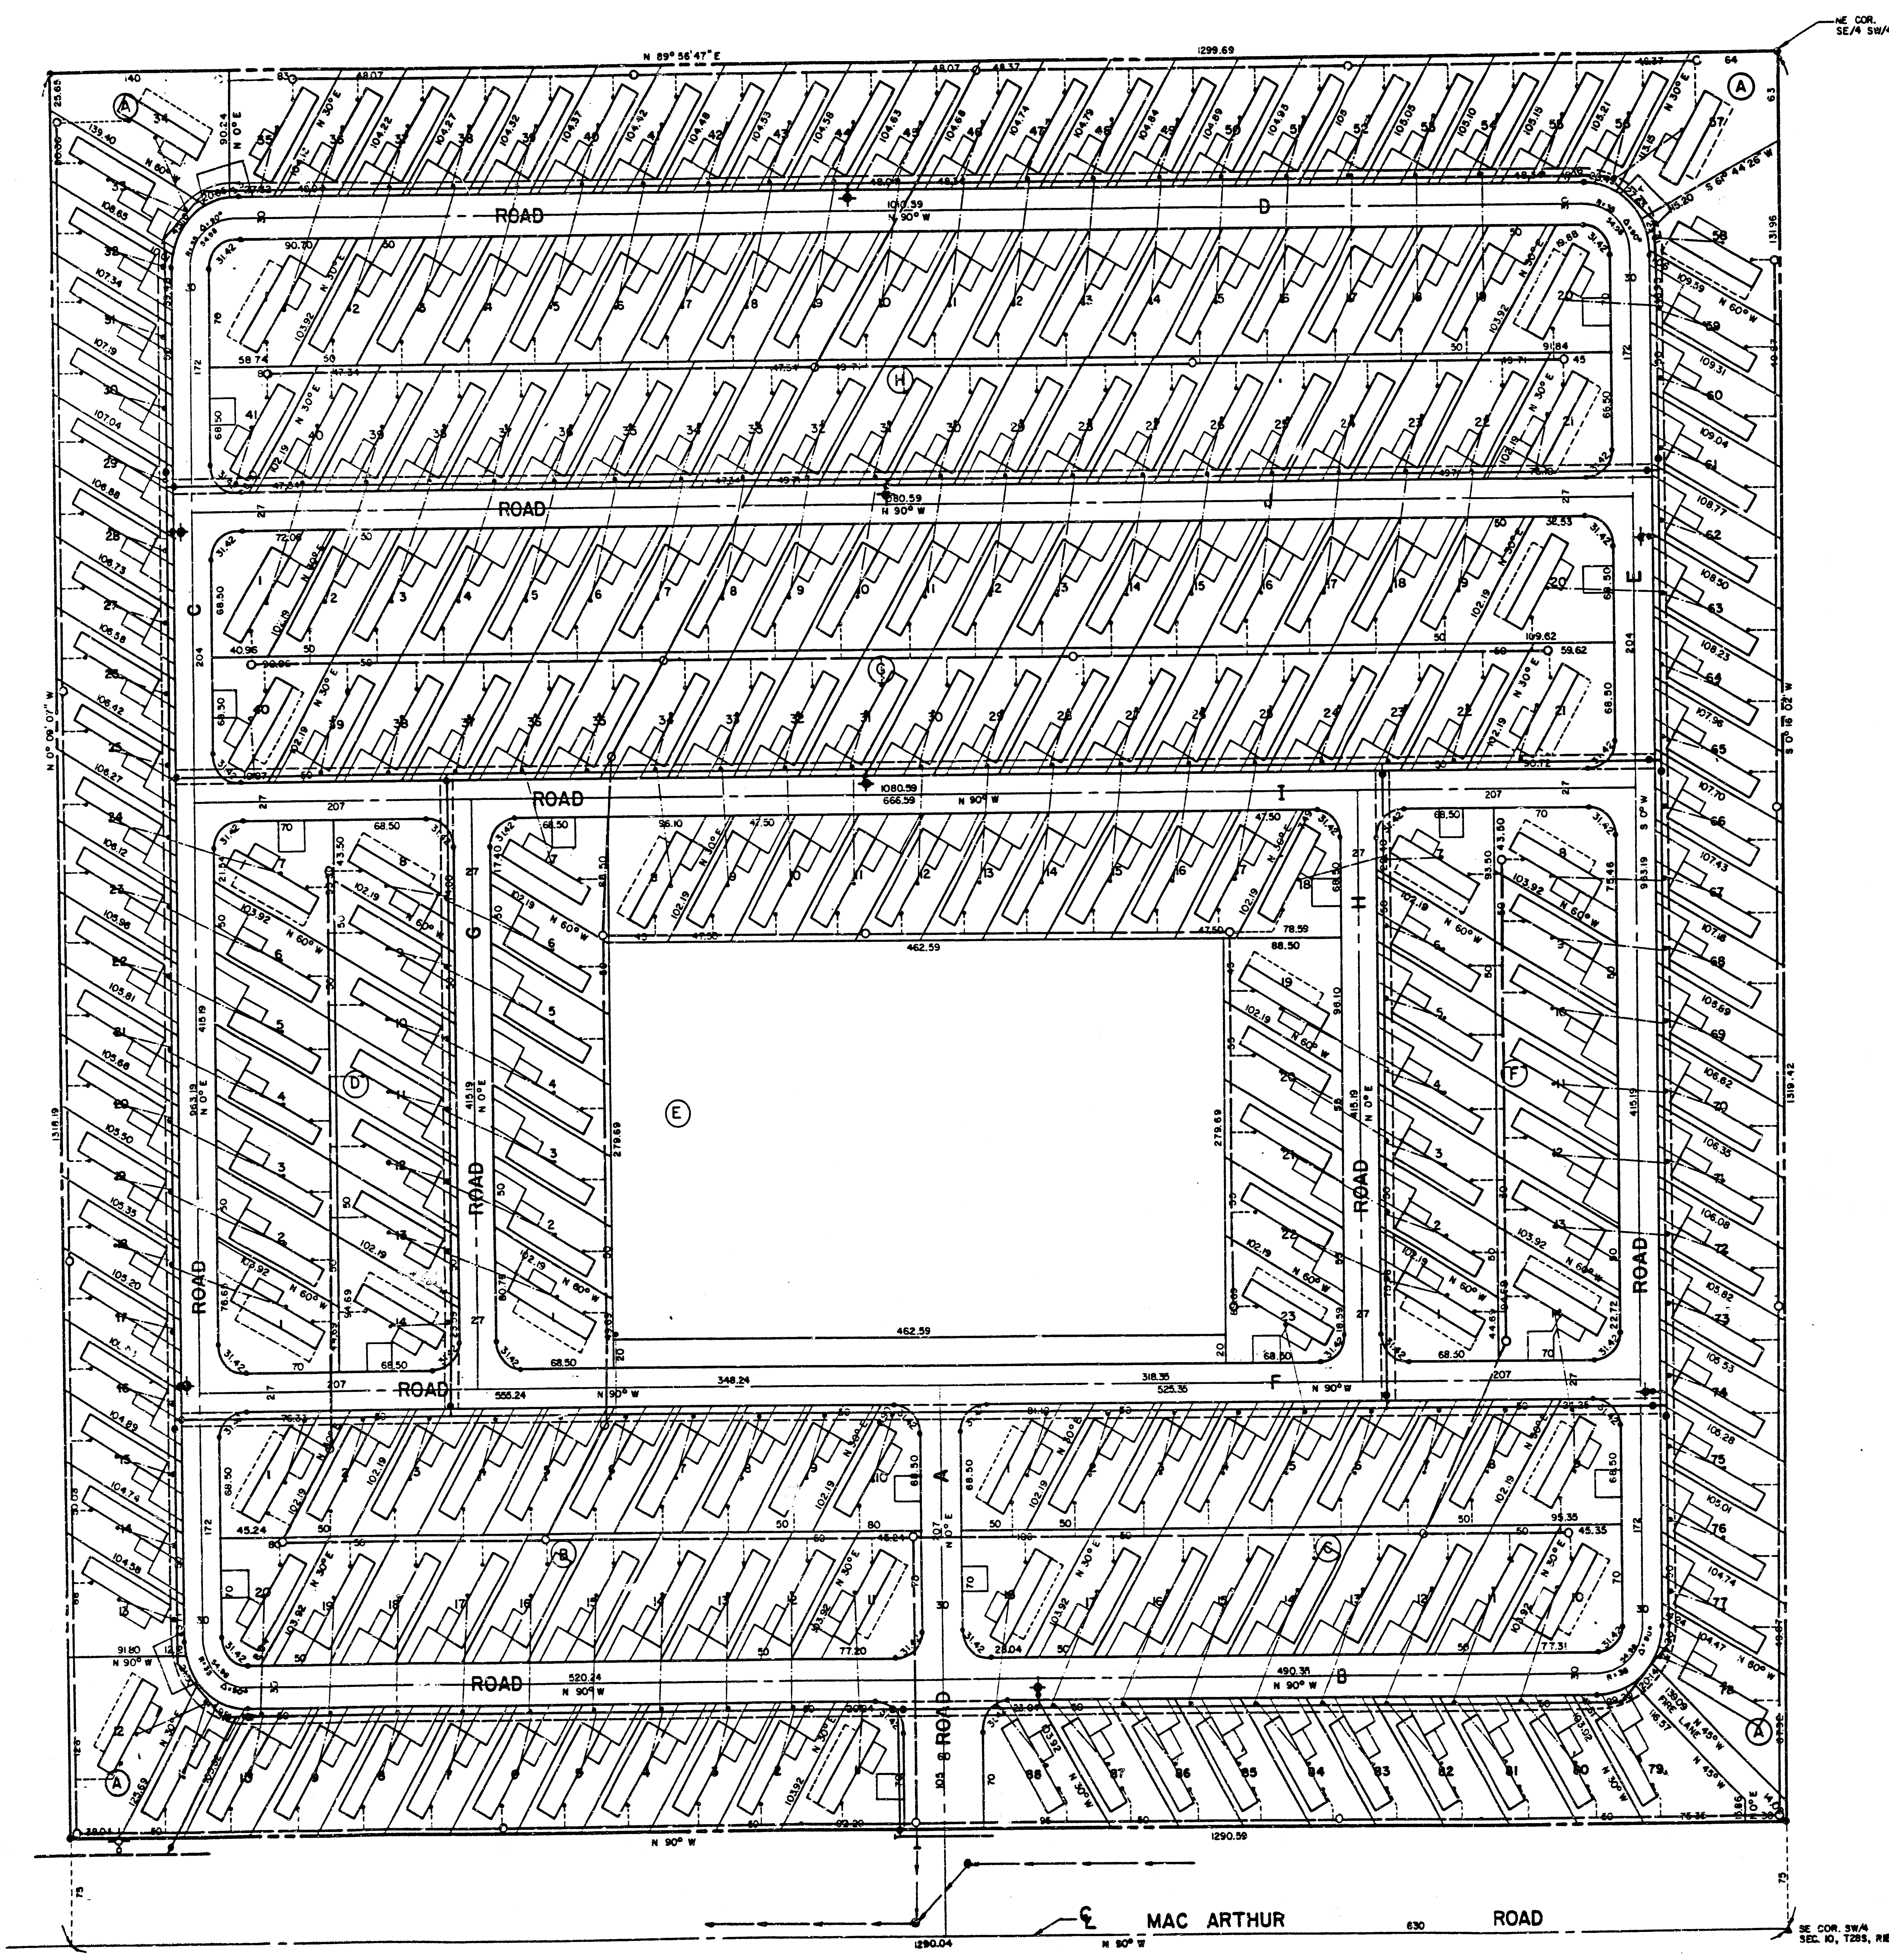

NOTE:
CONTRACTOR SHALL PROVIDE 24" MIN. COVER
OVER PIPE

★ NO SEWER JOINT WITHIN 10' OF
WATER LINE, OR USE SOLVENT
WELD PIPE, OR 20" CONCRETE
ENCASEMENT.

STA. 0+74, MAIN I, END 10"
CLAY TILE SEWER.
BEGIN 8" PVC SEWER



STA. 0+59, MAIN I, END EXIST.
10" CLAY TILE STUB.
BEGIN NEW 10" CLAY TILE SEWER.

STA. 0+00 MAIN I, EXIST. M.H.
F.L. NORTH 74.89
F.L. SOUTH 75.14
F.L. WEST 74.85
F.L. N.E. 75.19



NOTE:
0+74 - END PUBLIC SEWER
BEGIN PRIVATE SEWER

MAIN LINE TRAP DETAIL (3 req'd.)

INSTALL 4-45° ELBOWS & ENCASE
IN 6" THICK CONCRETE AS SHOWN

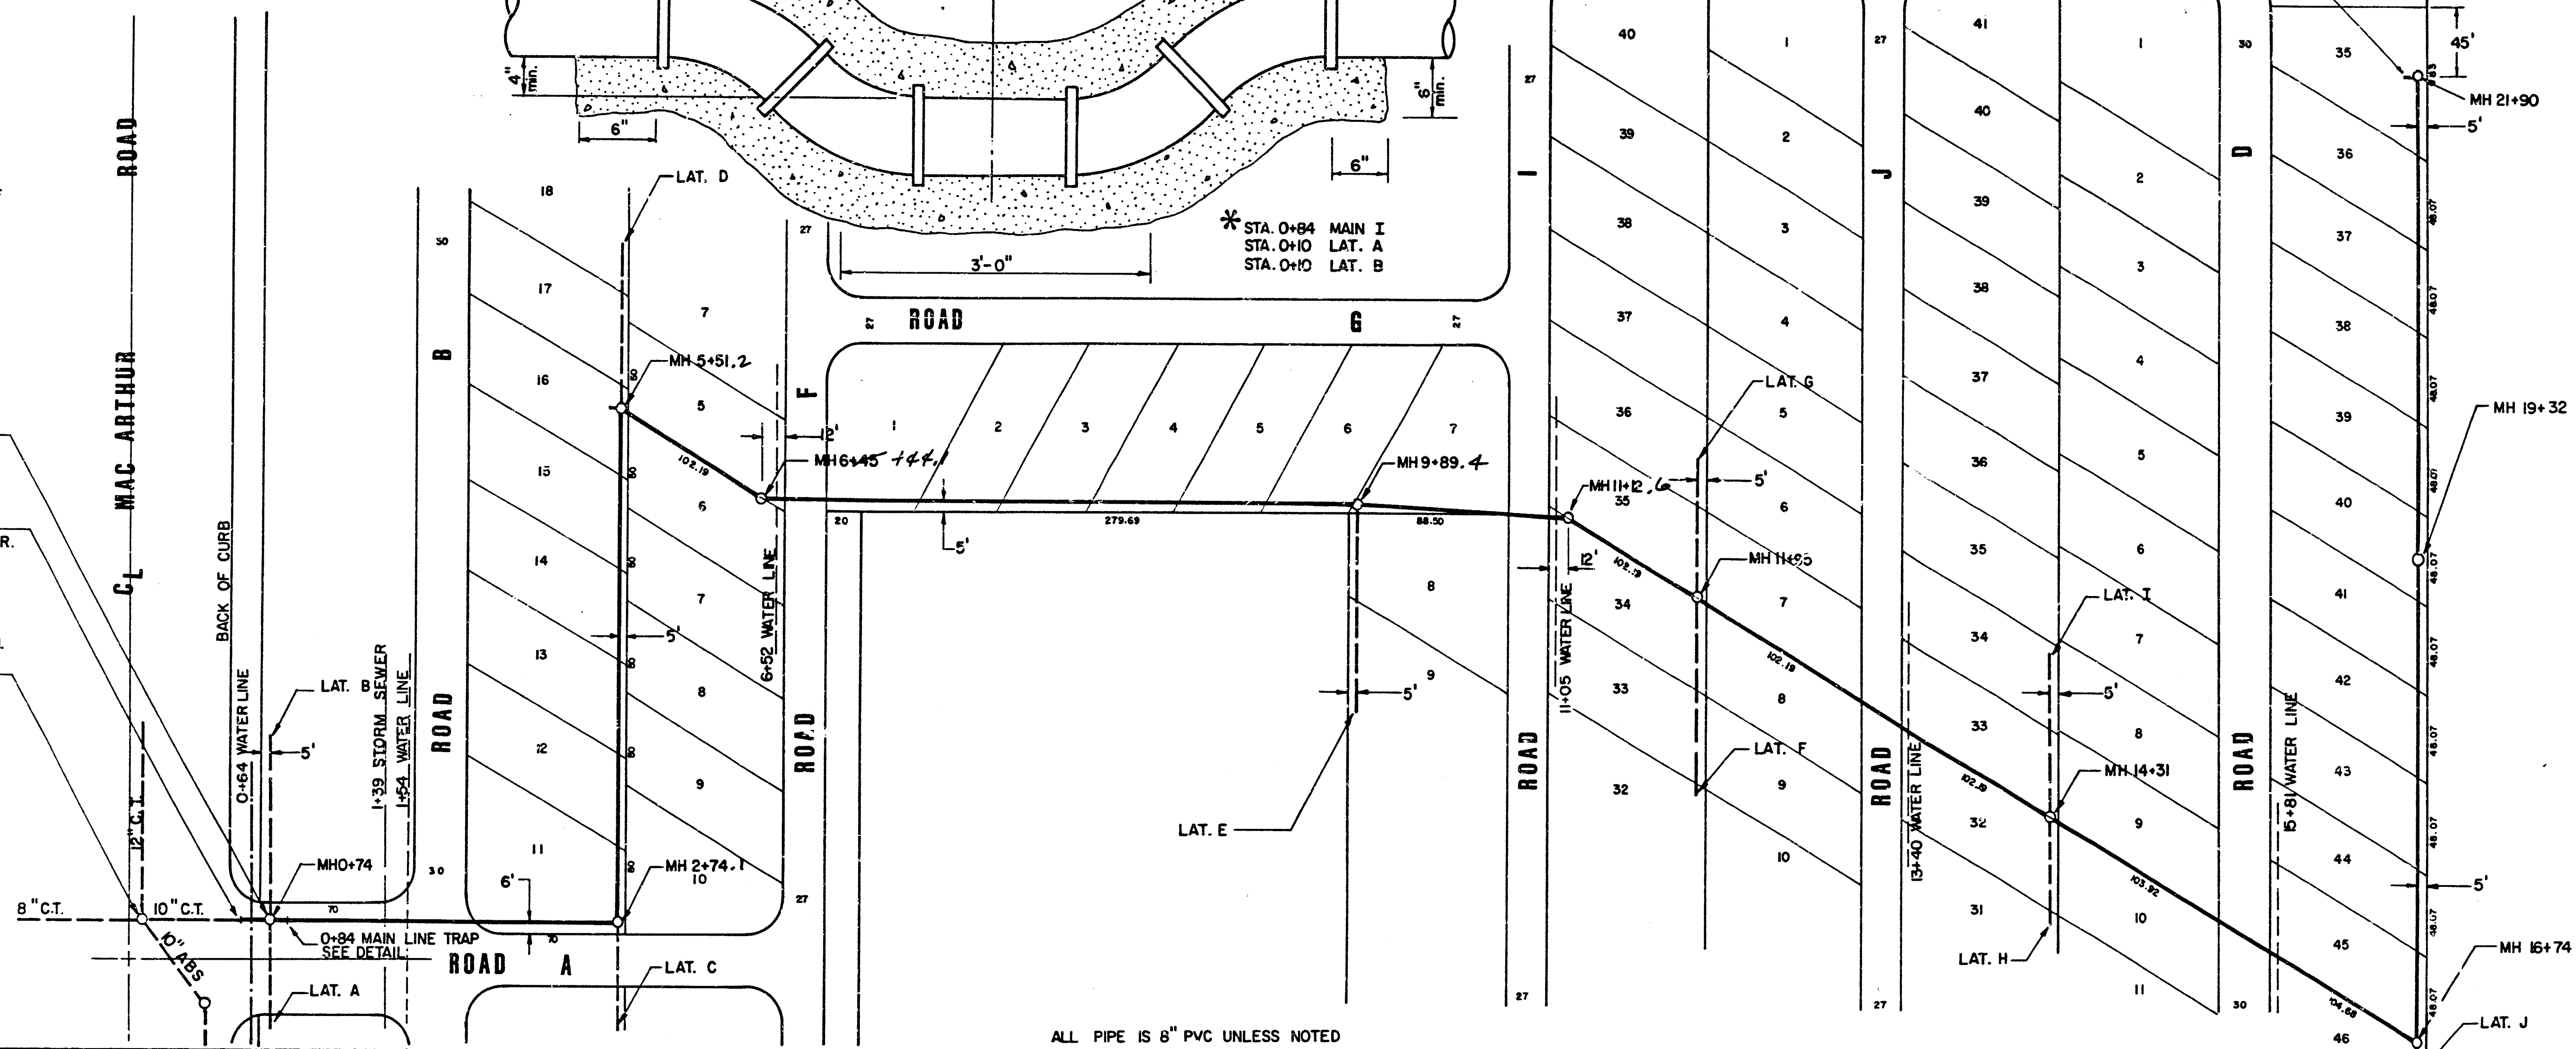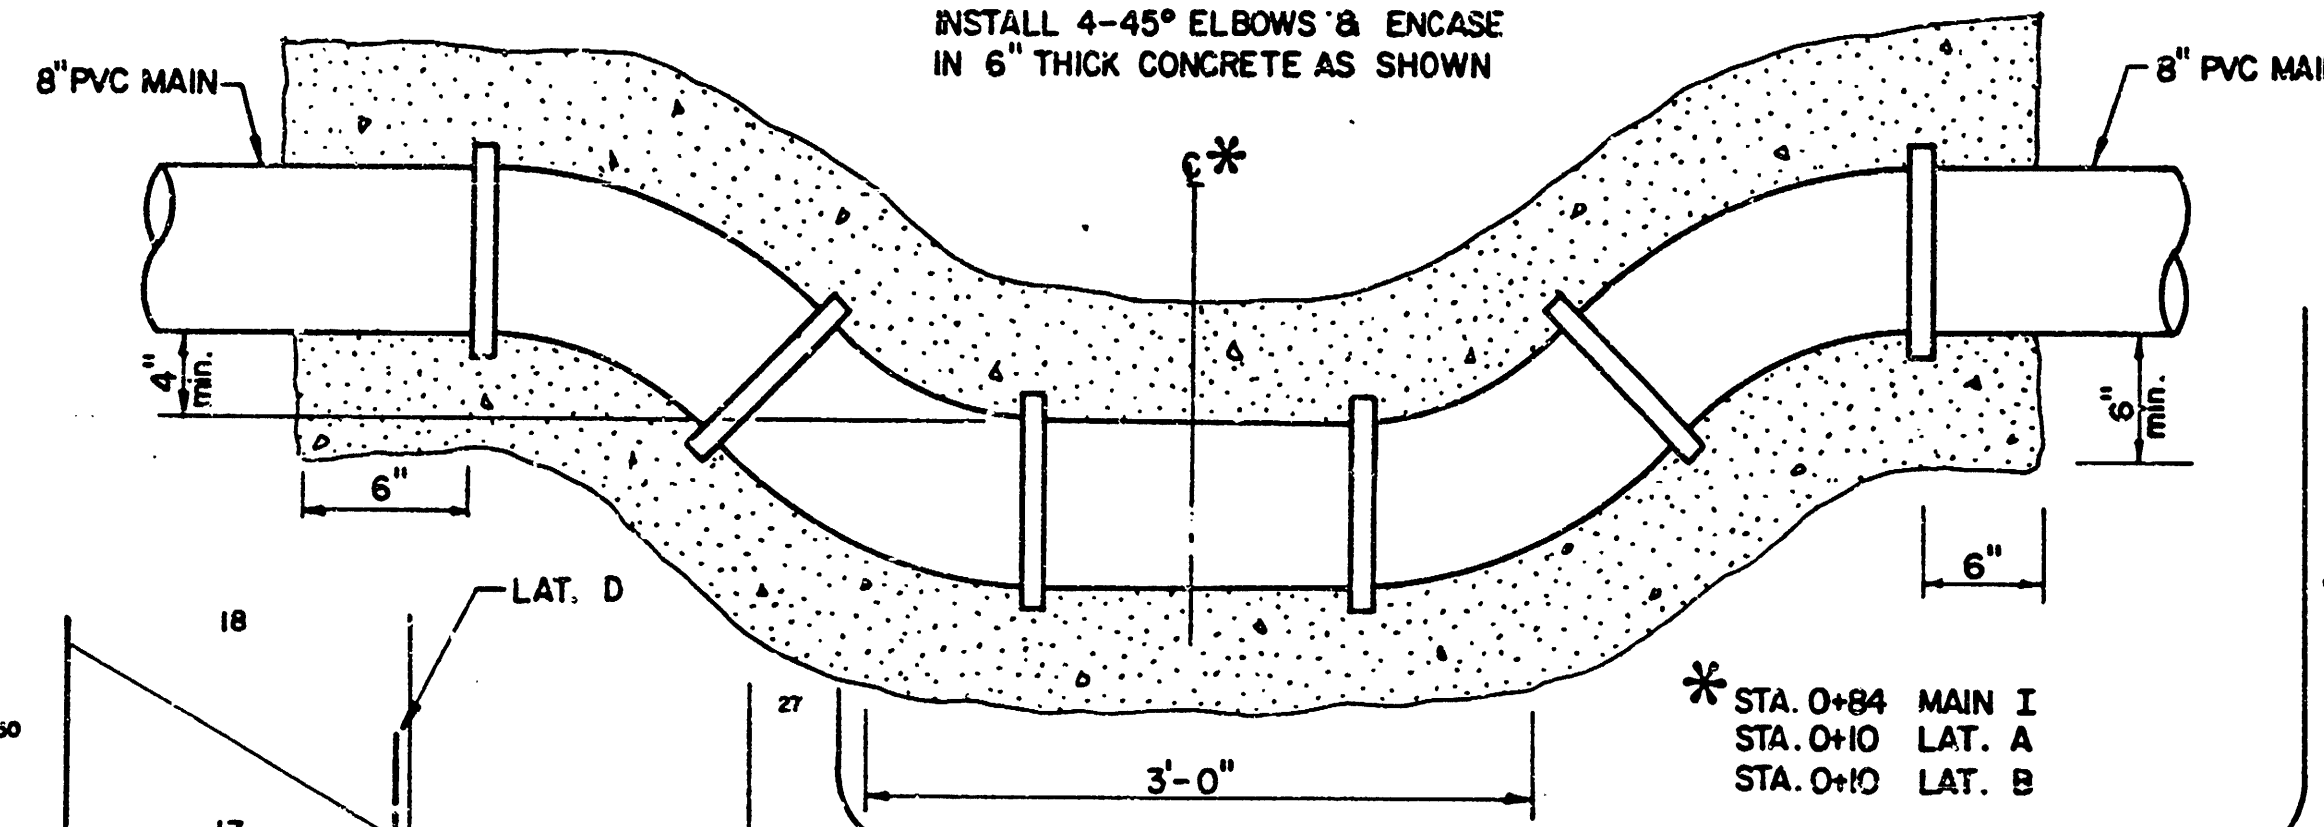

SCALE
PLAN 1"=60'
PROFILE
HORIZ. 1"=50'
VERT. 1"=5'

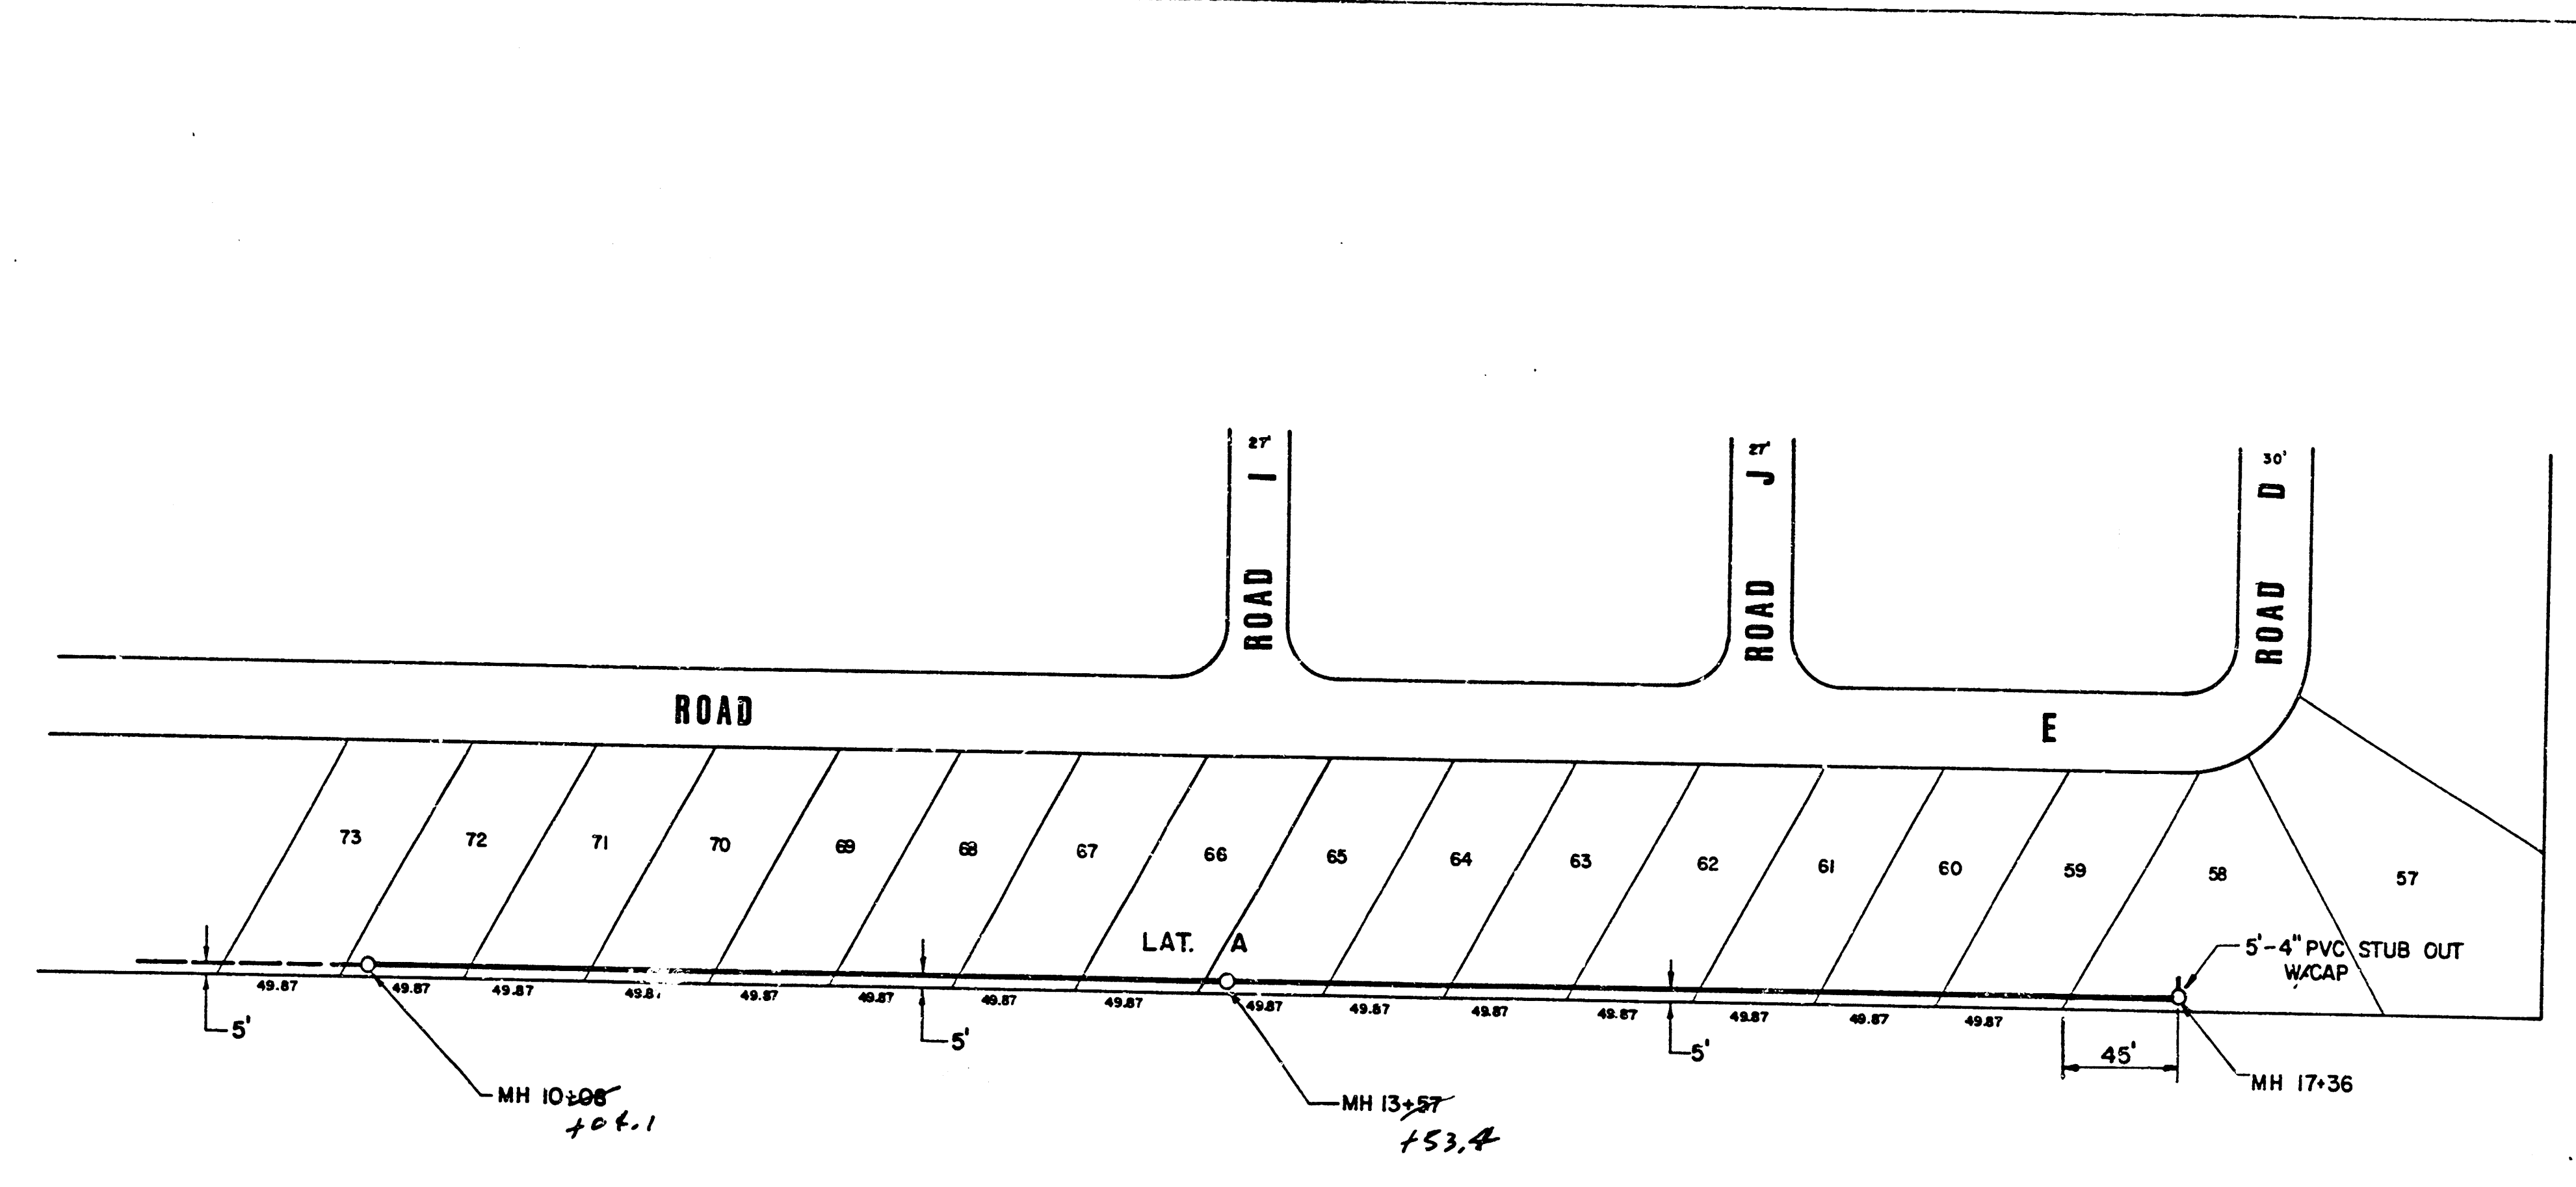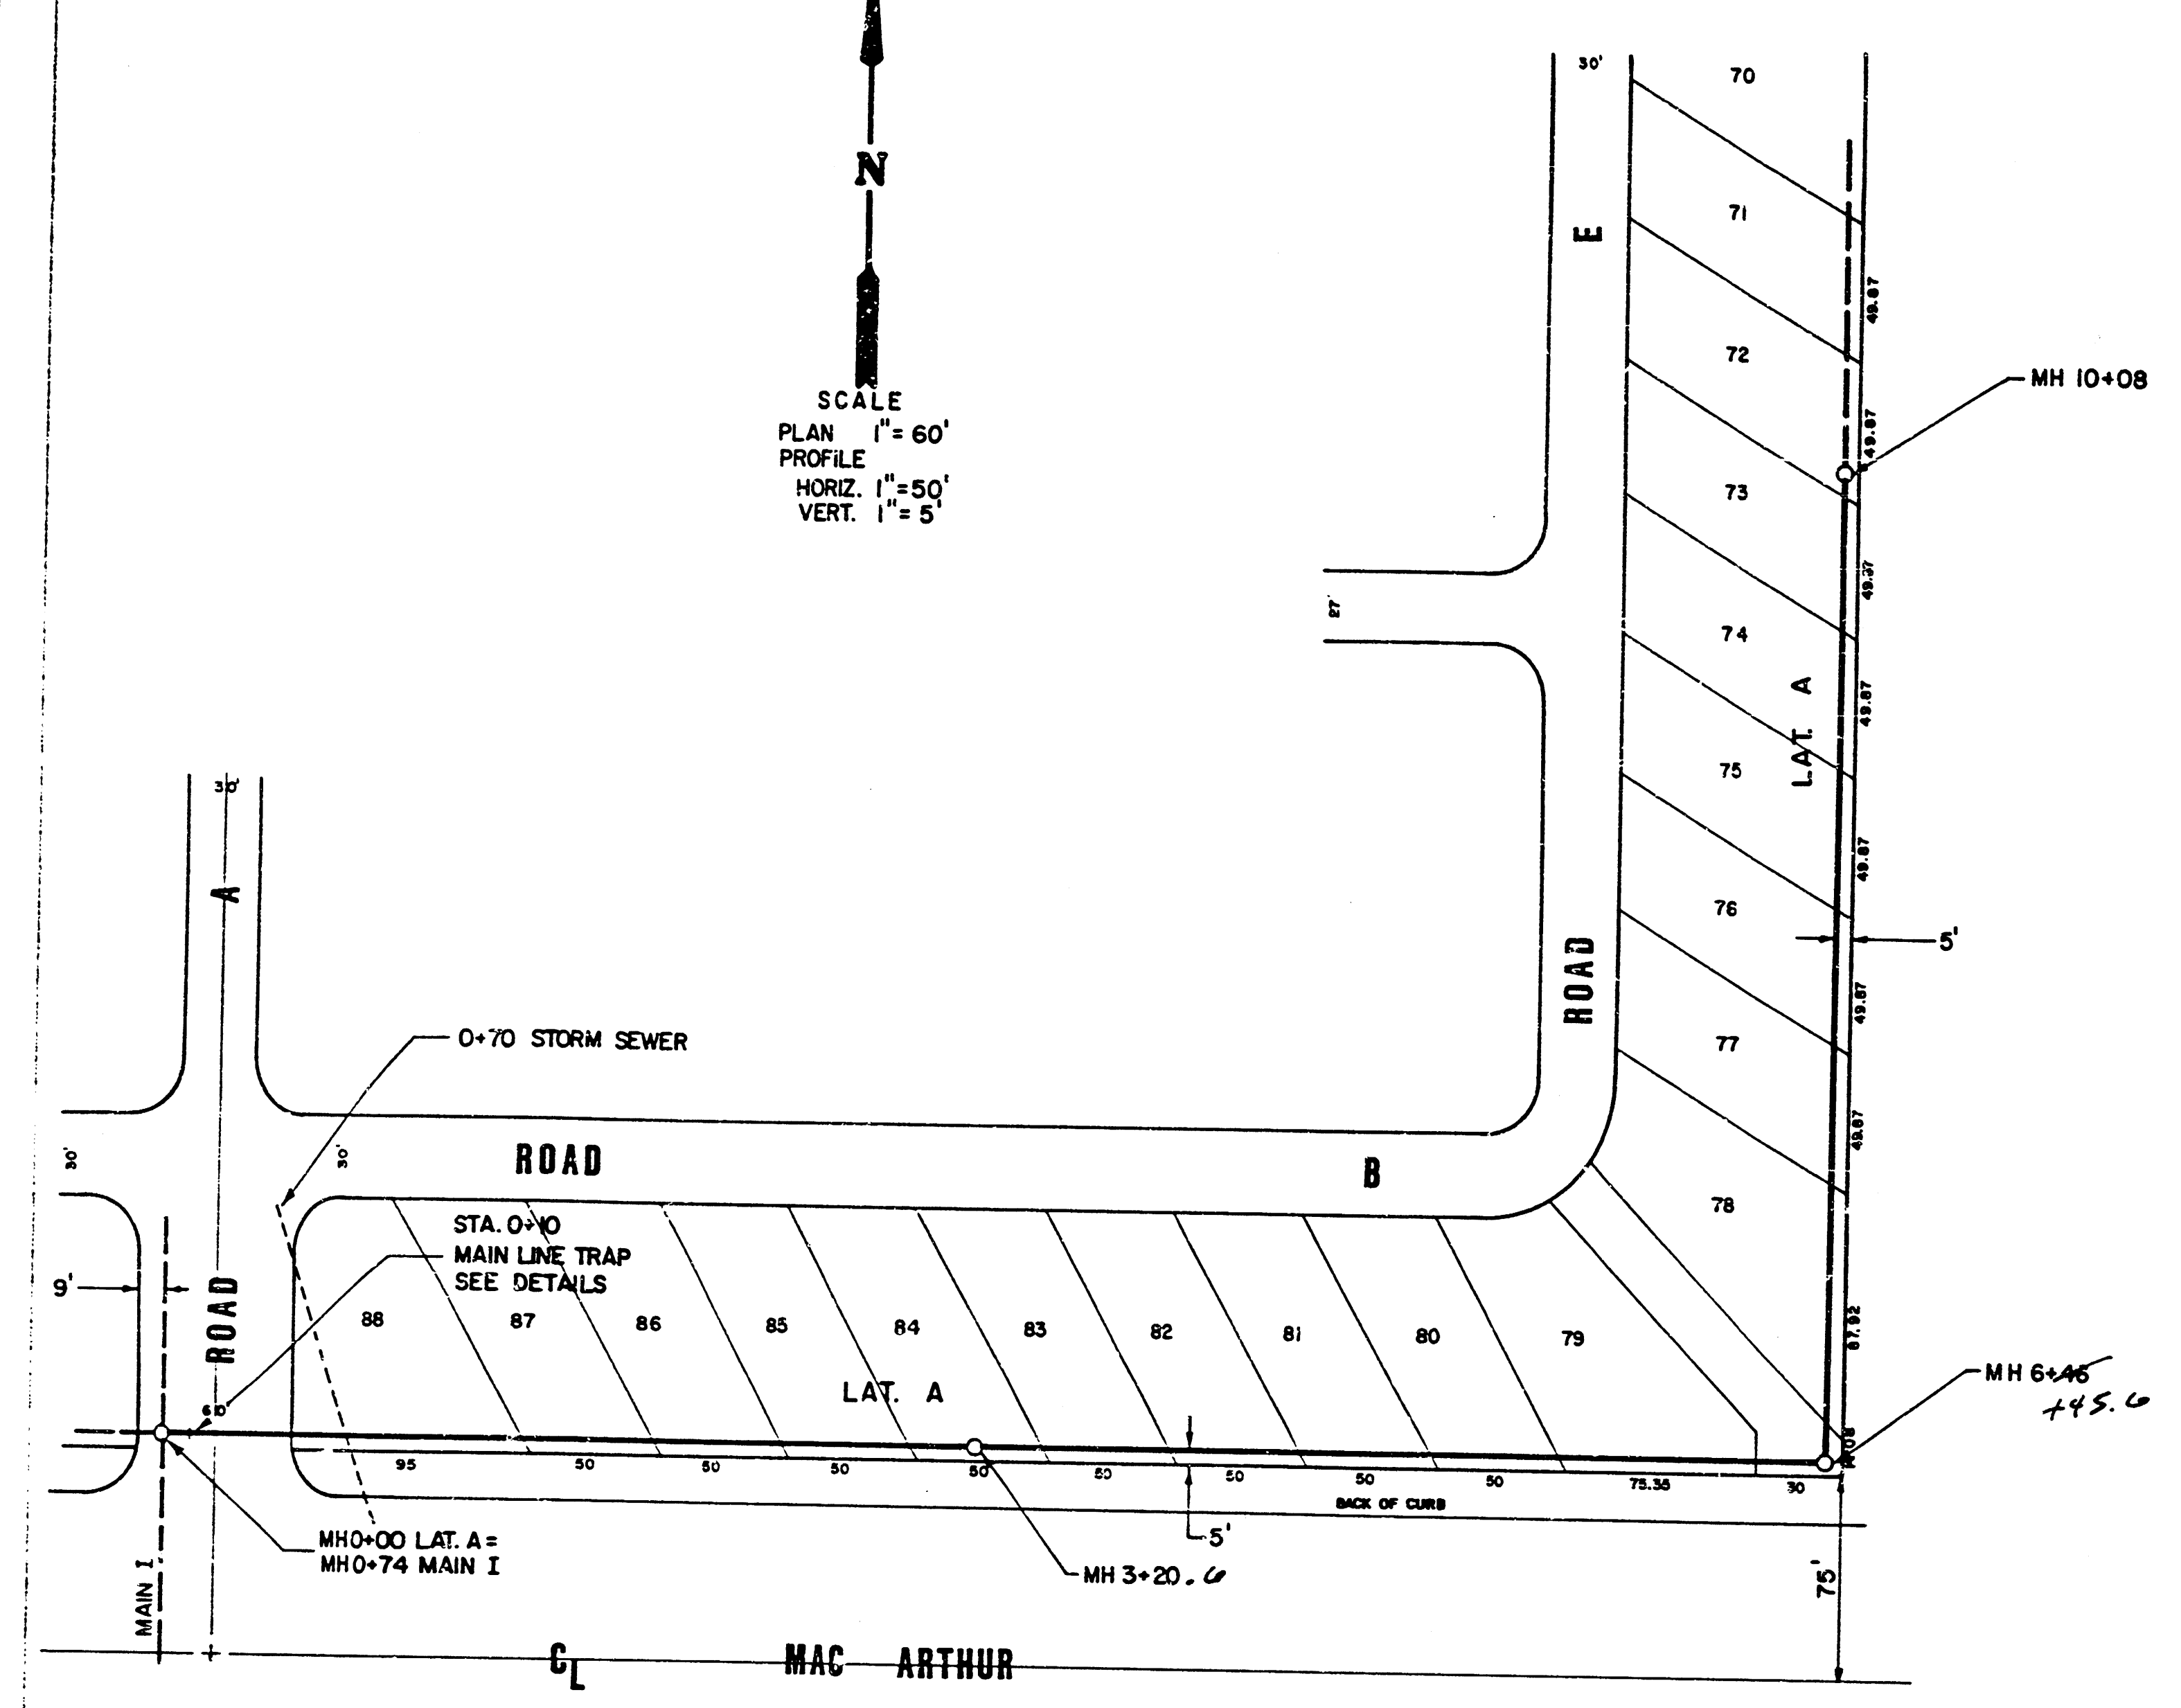


ALL MANHOLES SHALL BE TYPE "A", SHALLOW TYPE "A",
OR SPECIAL SHALLOW TYPE "A".
UNLESS NOTED:-
CONTRACTOR SHALL PROVIDE 24" MIN. COVER OVER PIPE

SCALE
PLAN 1"=60'
PROFILE
HORIZ. 1"=50'
VERT. 1"=5'

BM
R.R. SPIKE IN P.P. AT THE SW COR. OF THE PLAT.
ELEV. 85.23
CITY OF WICHITA DATUM

ALL PIPE IS 8" PVC UNLESS NOTED

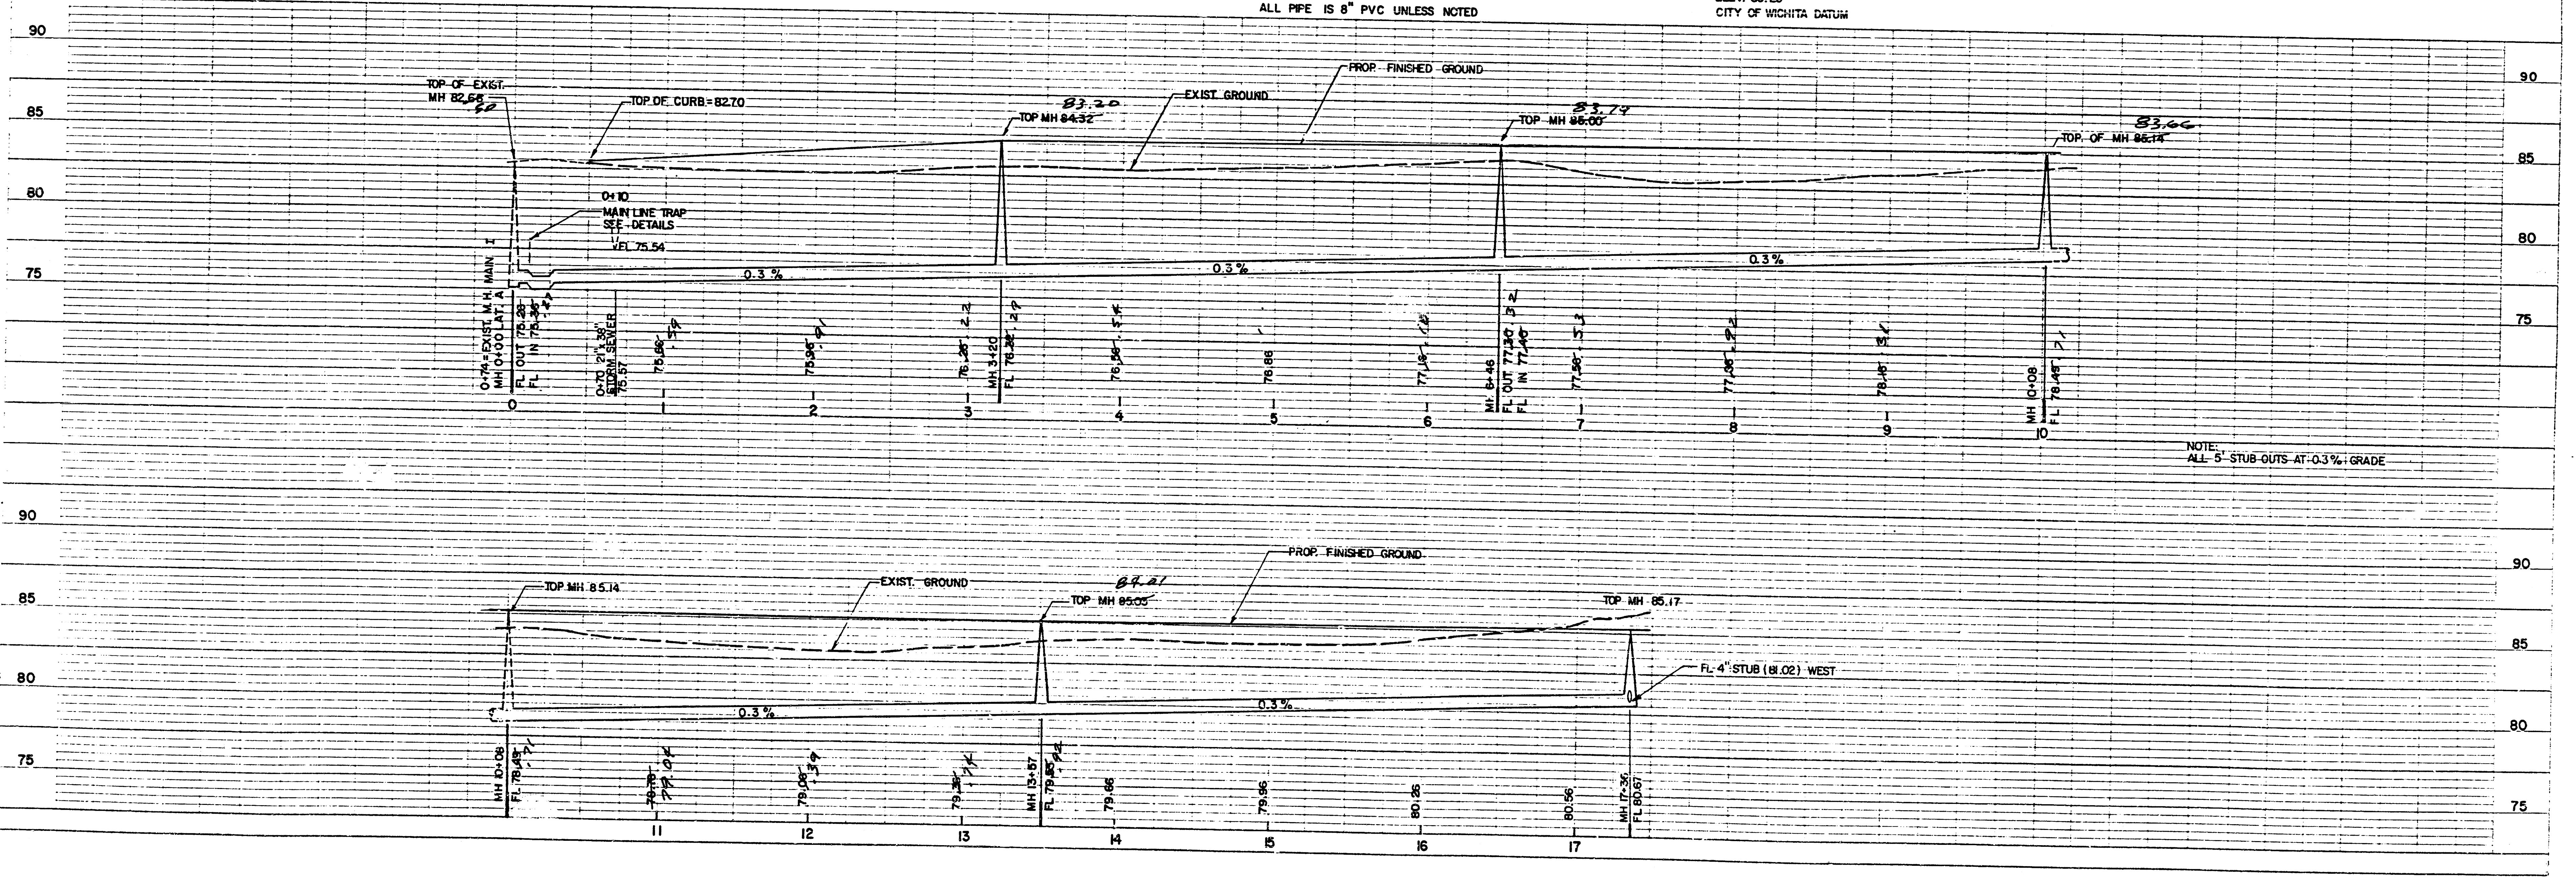

NOTE:
ALL 5" STUB-OUTS AT 0.3% GRADE

REVISION	DRAWN BY	CHECKED BY	DESIGNED BY	PROJECT



SANITARY SEWER EXTENSIONS LAT. A

CUSTOMER

LAMPLIGHTER MOBIL HOME PARK

REISS & GOODNESS ENGINEERS
2100 WEST 21ST STREET
WICHITA, KANSAS 67203
(316) 832-0225

SCALE NOTED	PROJECT NO.
DATE 4/1/86	151284
SHEET 5 OF 13	

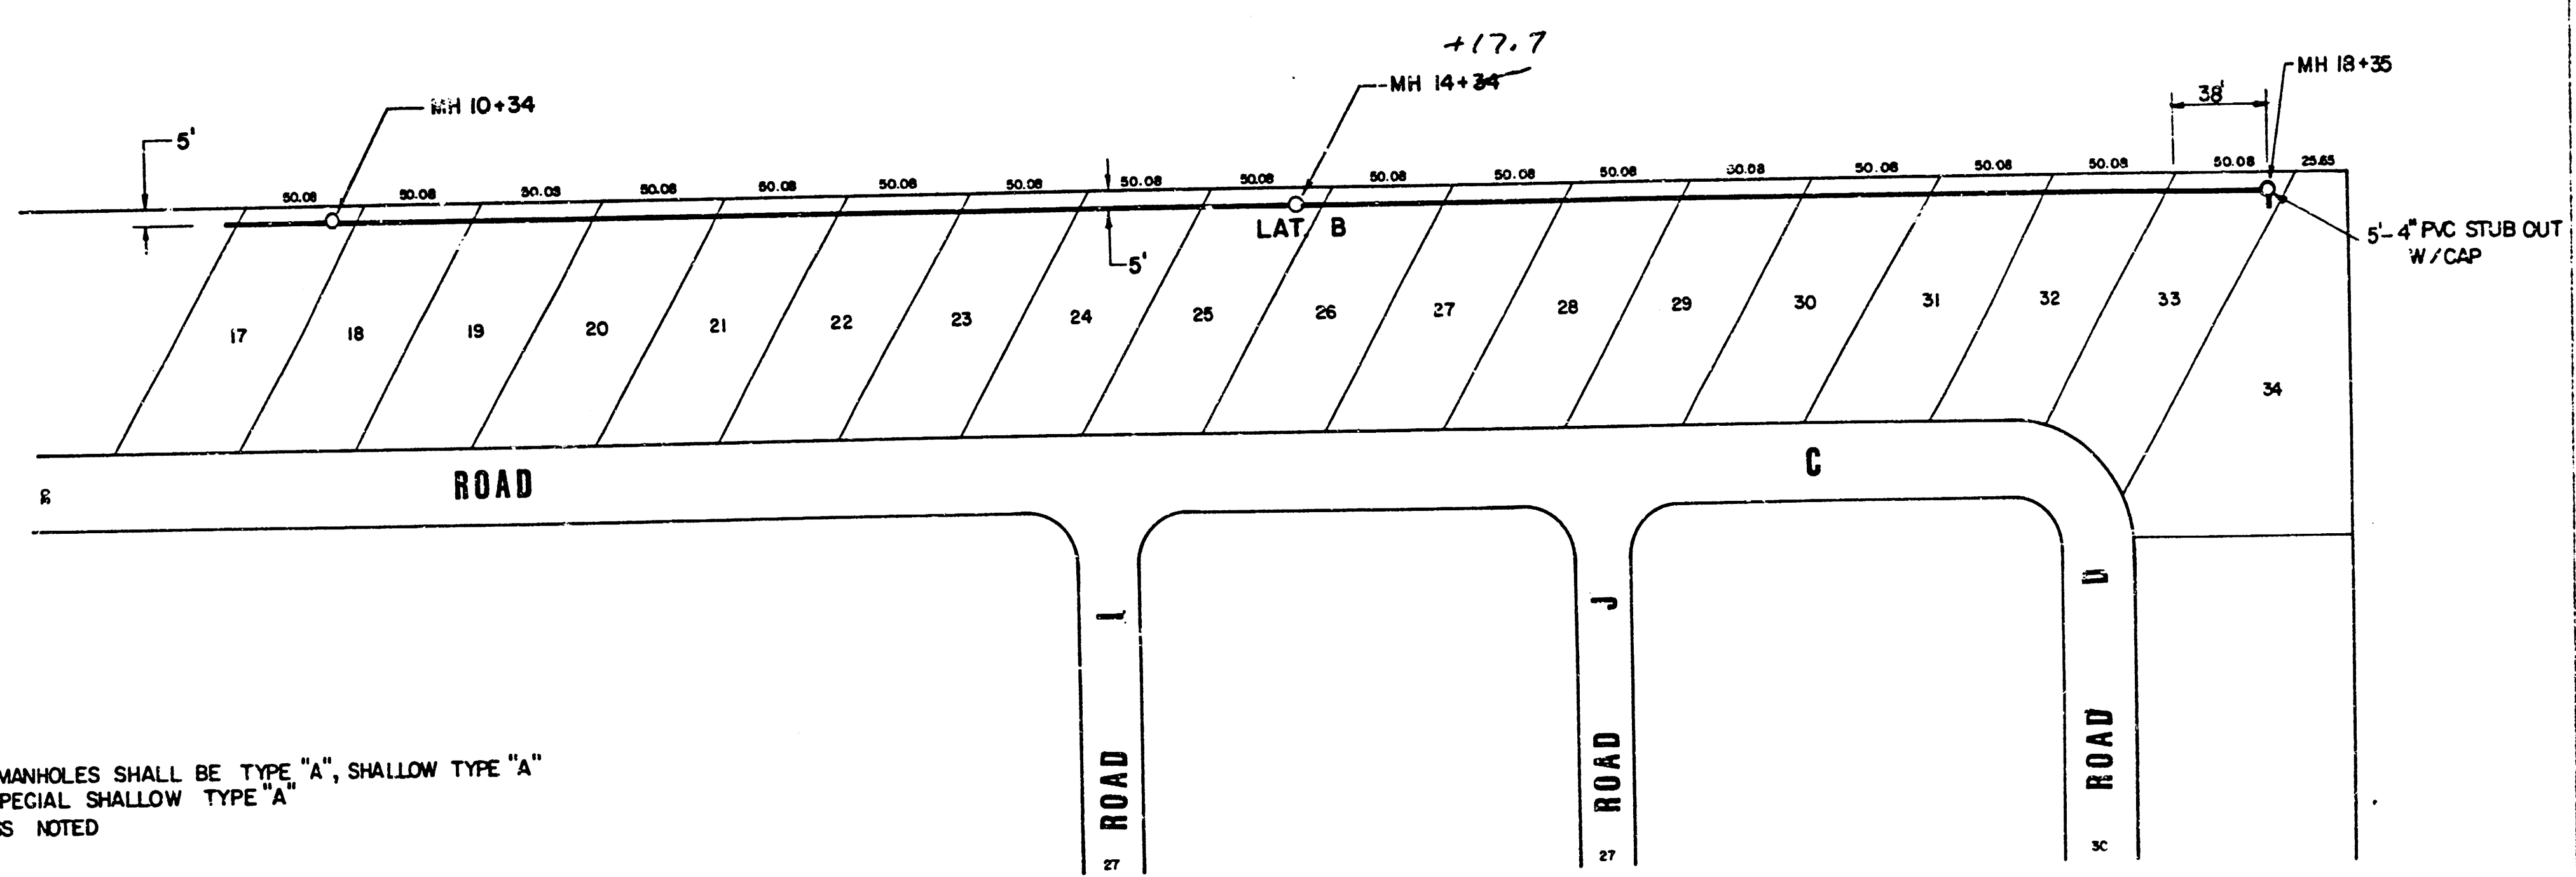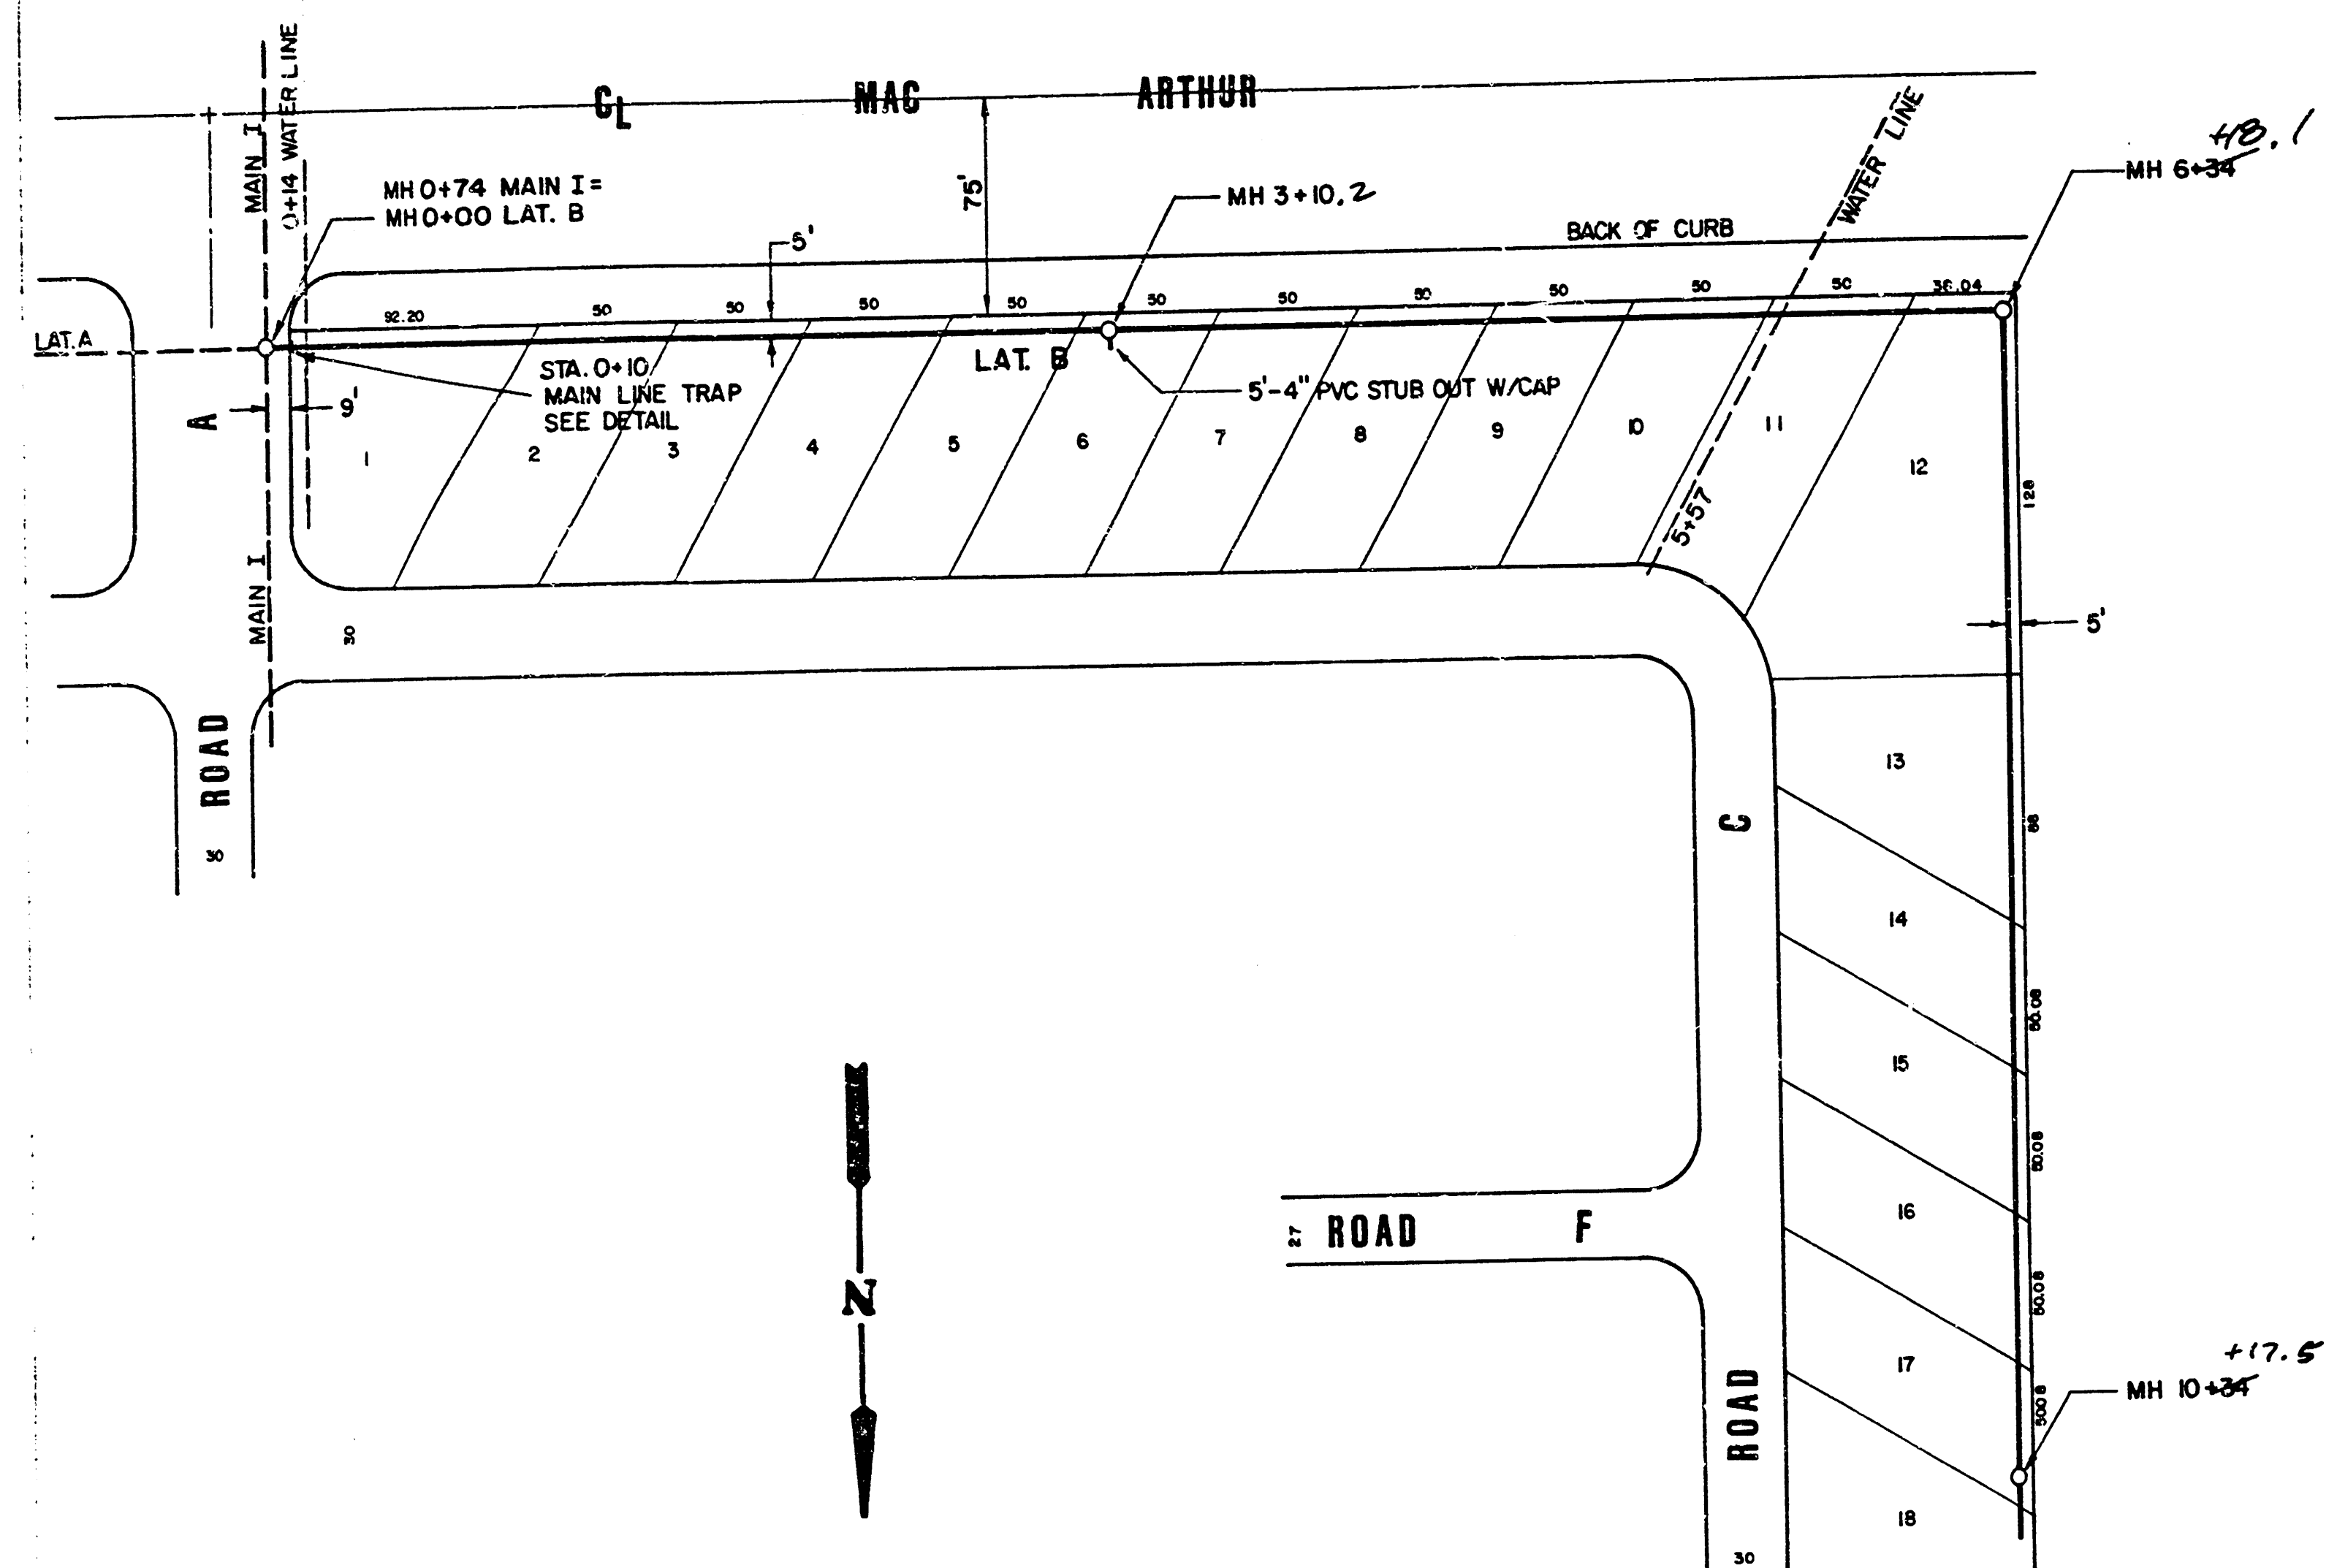


ALL MANHOLES SHALL BE TYPE "A", SHALLOW TYPE "A" OR SPECIAL SHALLOW TYPE "A" UNLESS NOTED

SCALE
PLAN 1" = 60'
PROFILE 1" = 50'
HORIZ. 1" = 50'
VERT. 1" = 5'

BM
R.R. SPIKE IN P.P. AT THE SW/C OF PLAT
ELEV. 85.23 CITY OF WICHITA DATUM

CONTRACTOR SHALL PROVIDE 24" MIN. COVER OVER PIPE

ALL PIPE IS 8" PVC UNLESS NOTED

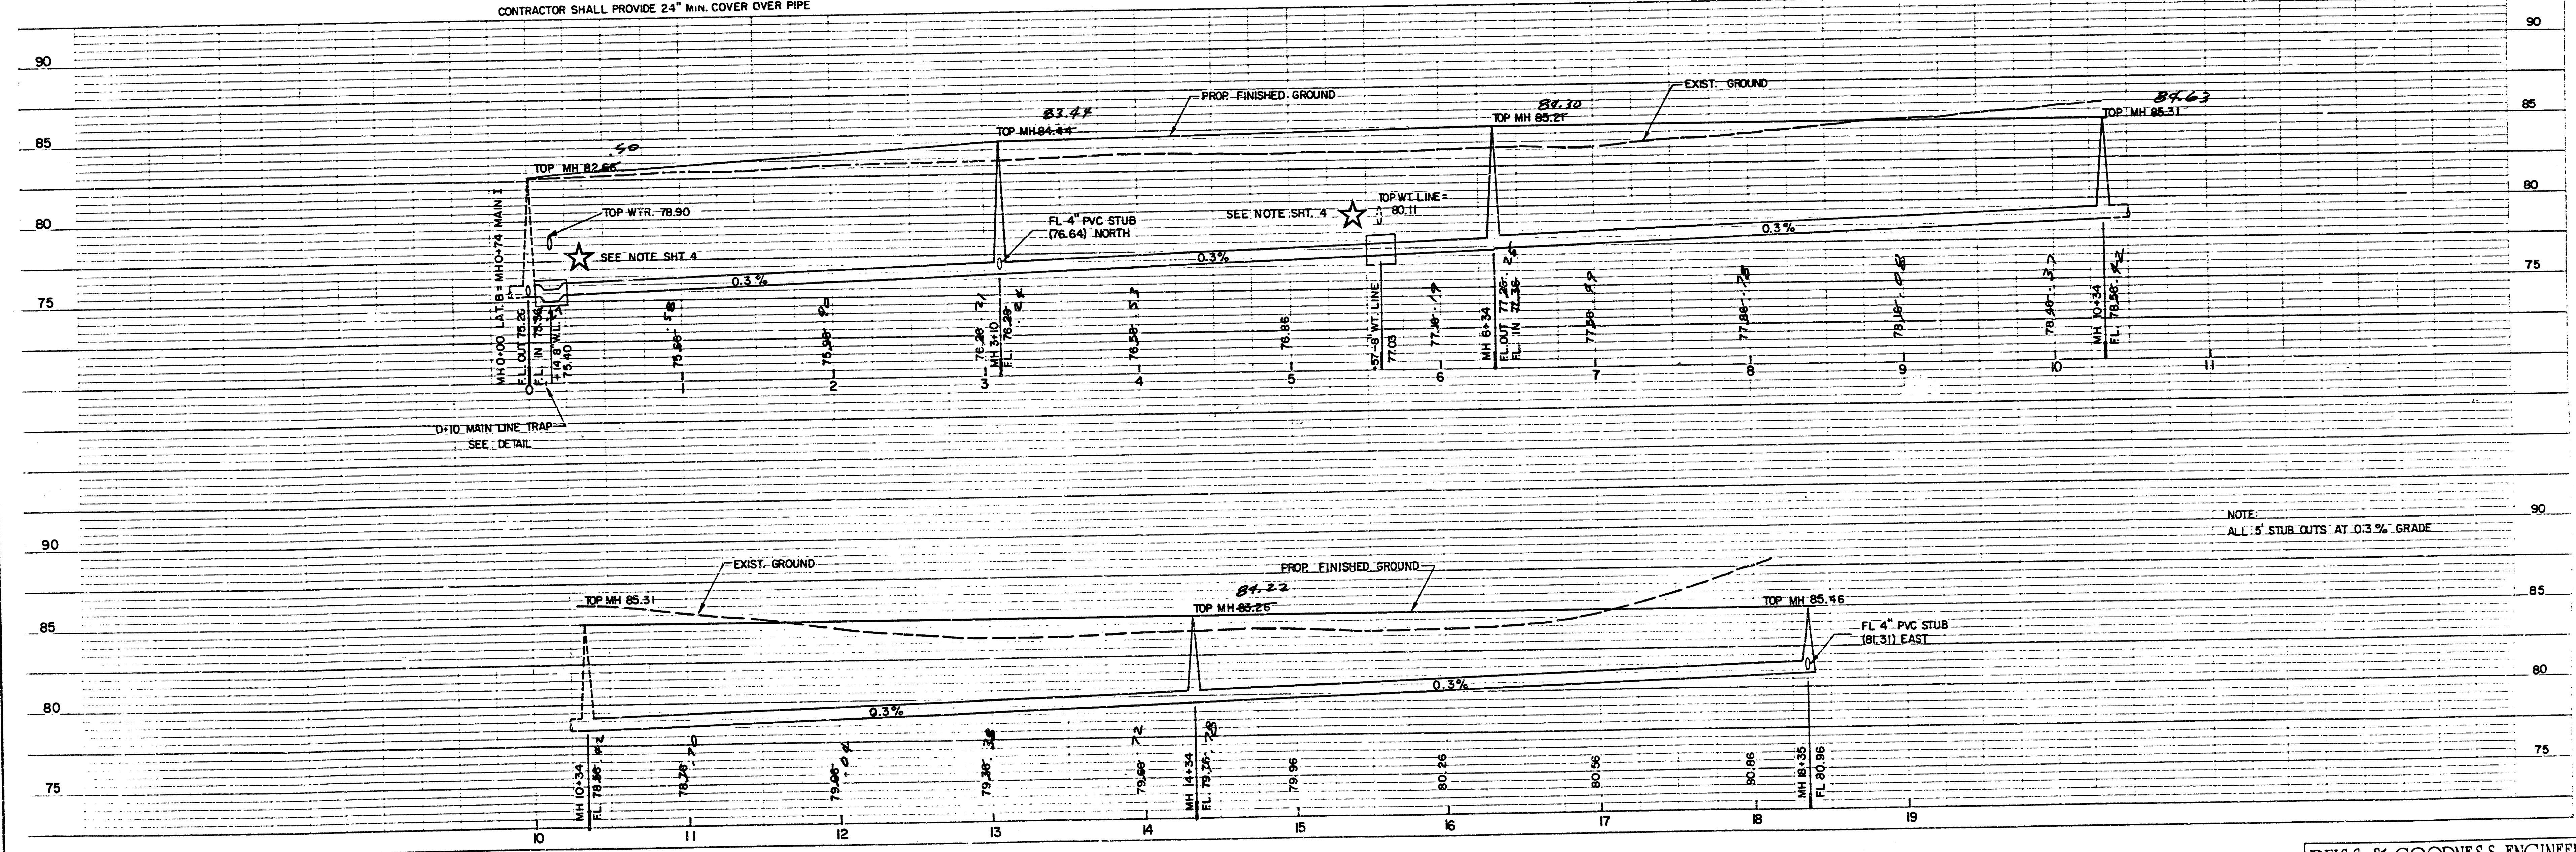



REVISION	DRAWN BY	CHECKED BY	DESIGNED BY	PROJECT


SANITARY SEWER EXTENSIONS LAT. B

CUSTOMER
LAMPLIGHTER MOBILE HOME PARK

REISS & GOODNESS ENGINEERS
2100 WEST 21ST STREET
WICHITA, KANSAS 67203
(316) 822-0213

SCALE NOTED
DATE 4/1/86
PROJECT NO. MS 1225
SHEET 6 OF 13

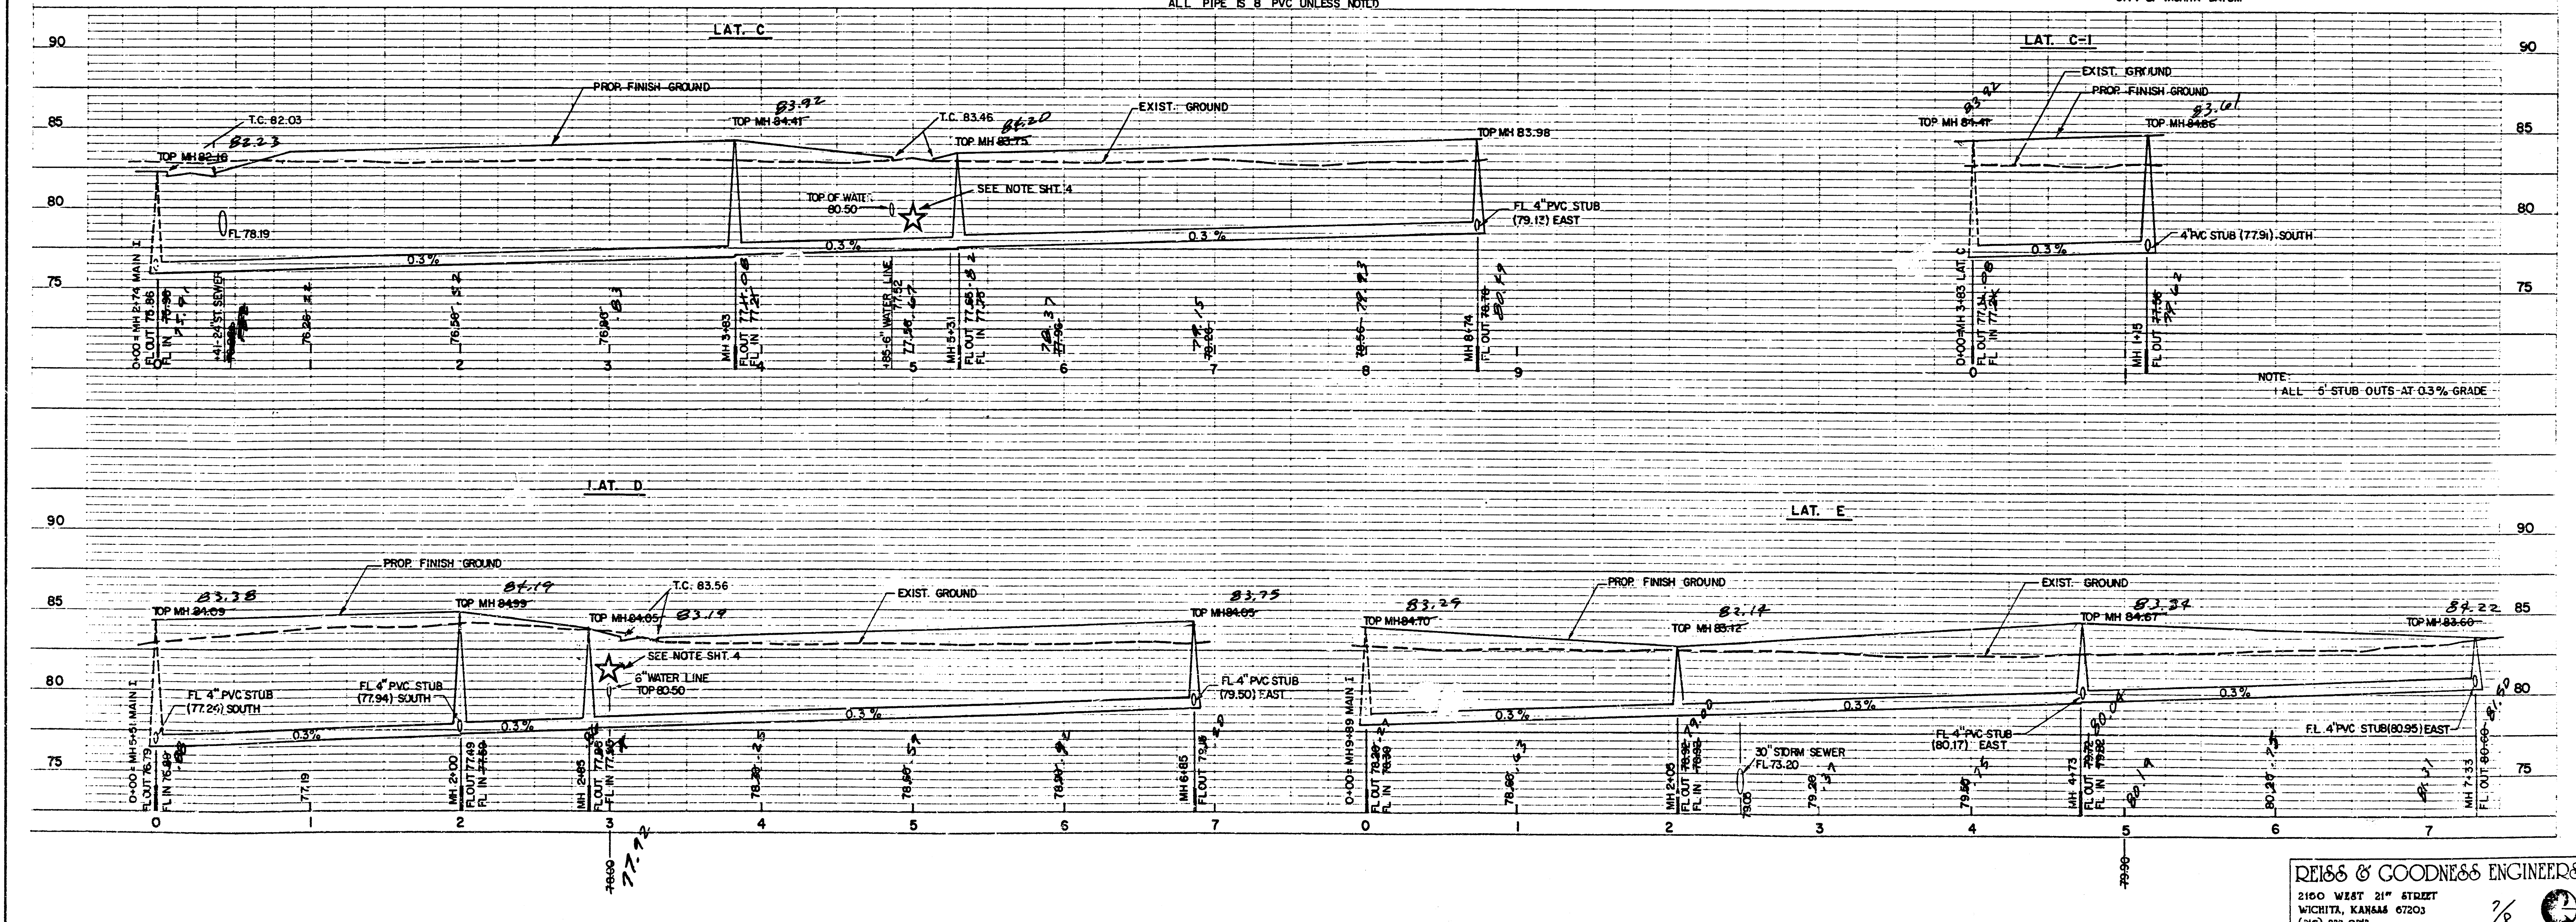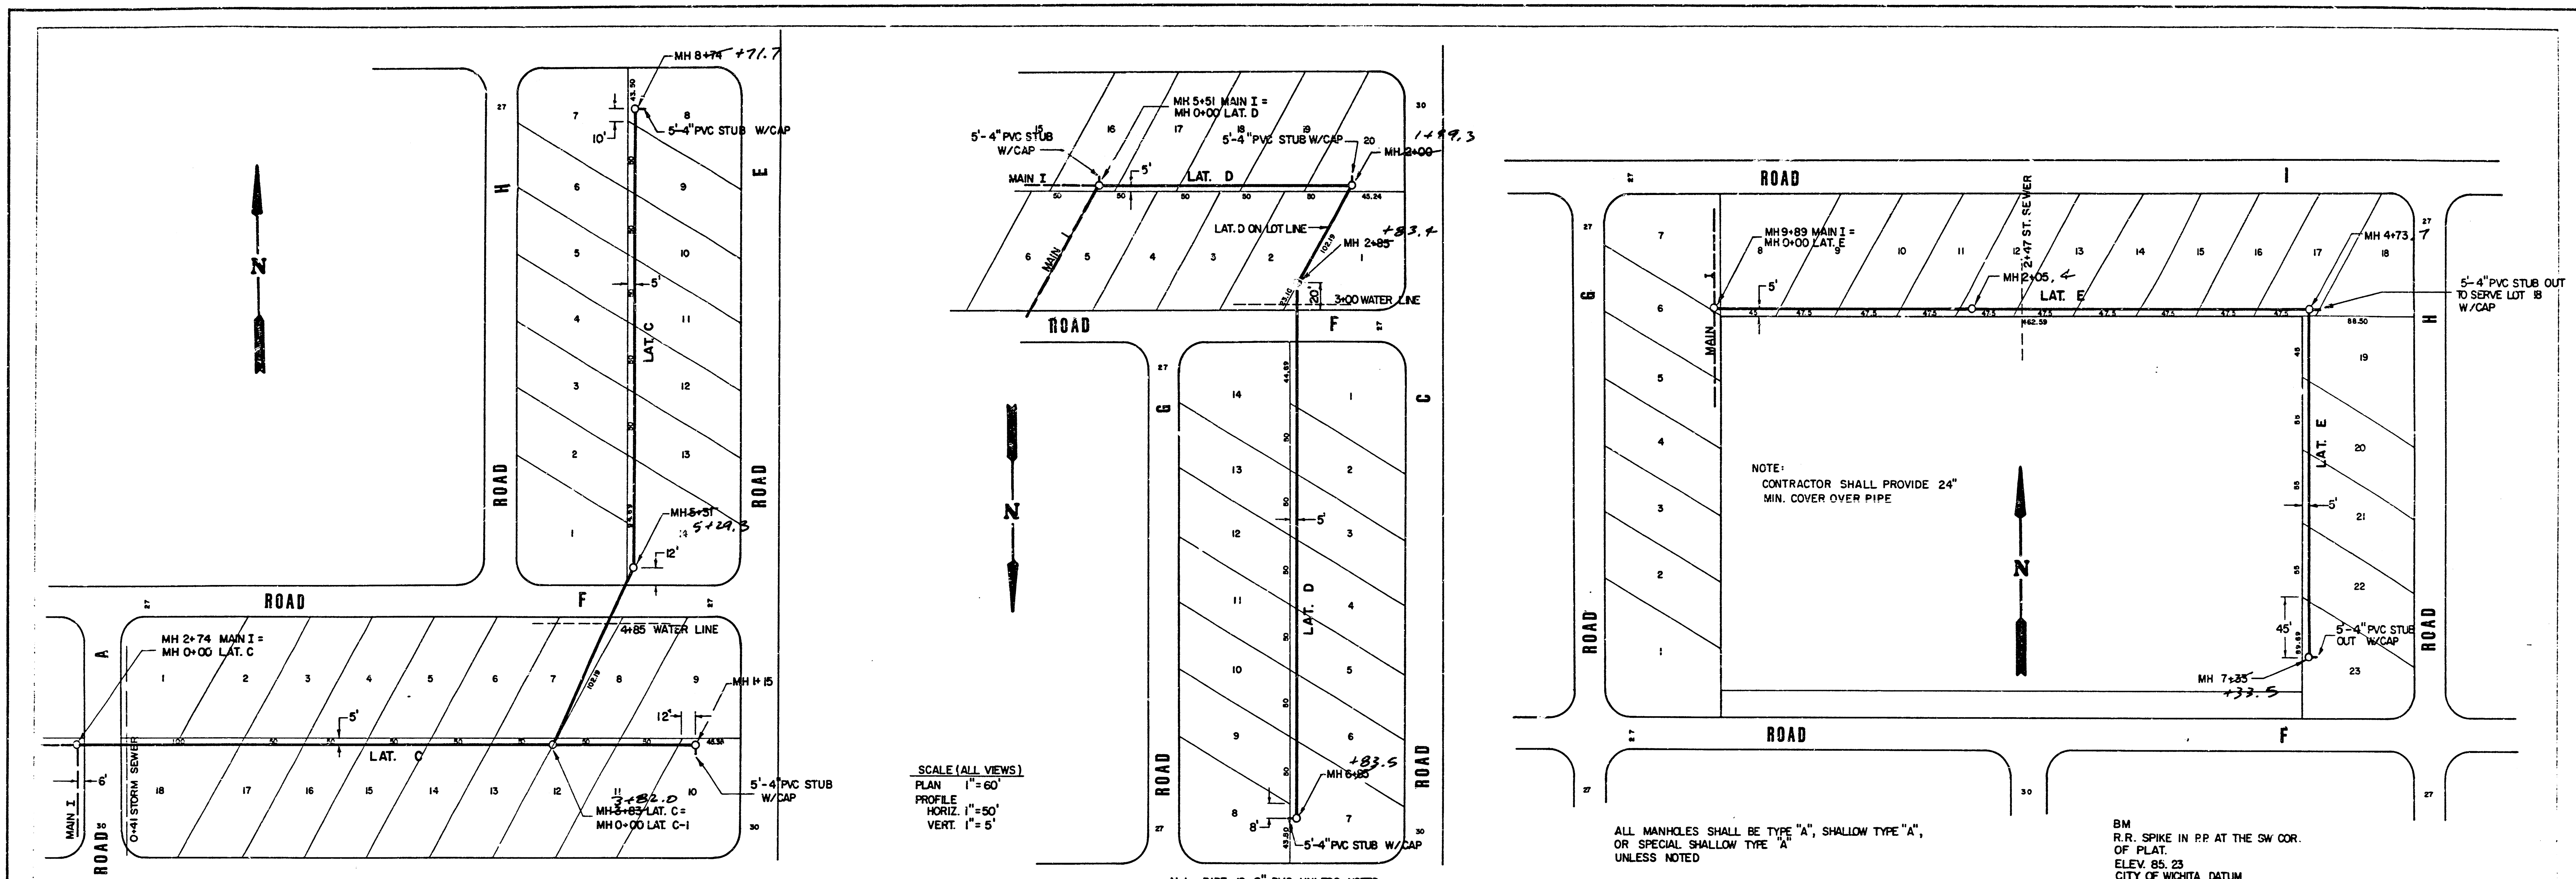

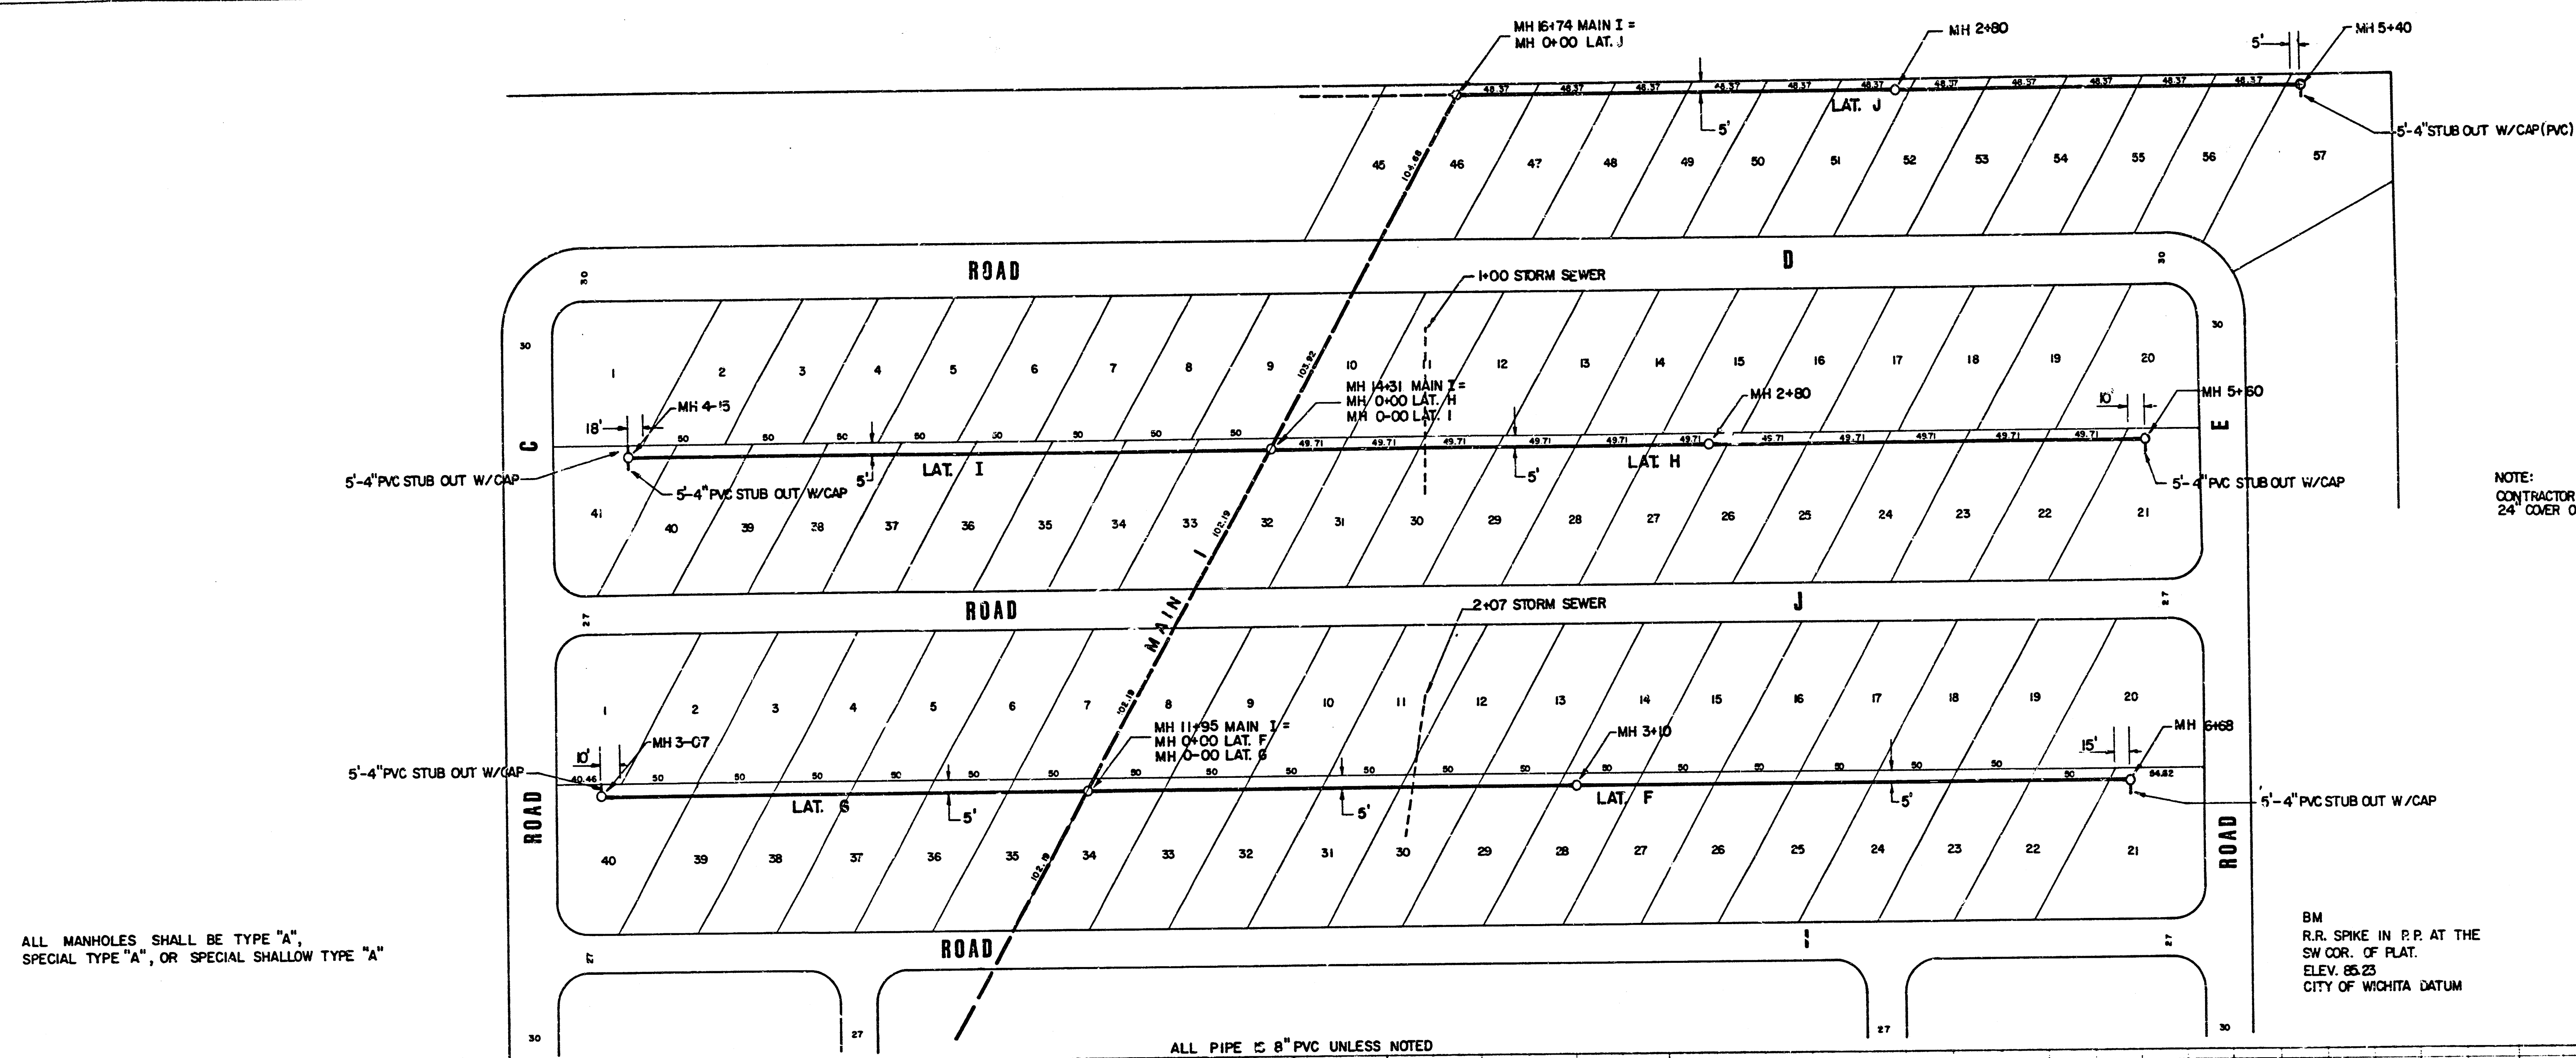


NOTE:
CONTRACTOR SHALL PROVIDE A MIN. OF
24" COVER OVER PIPE



SCALE
PLAN 1" = 60'
PROFILE
HORIZ. 1" = 50'
VERT. 1" = 5'

BM
R.R. SPIKE IN P.P. AT THE
SW COR. OF PLAT.
ELEV. 85.23
CITY OF WICHITA DATUM

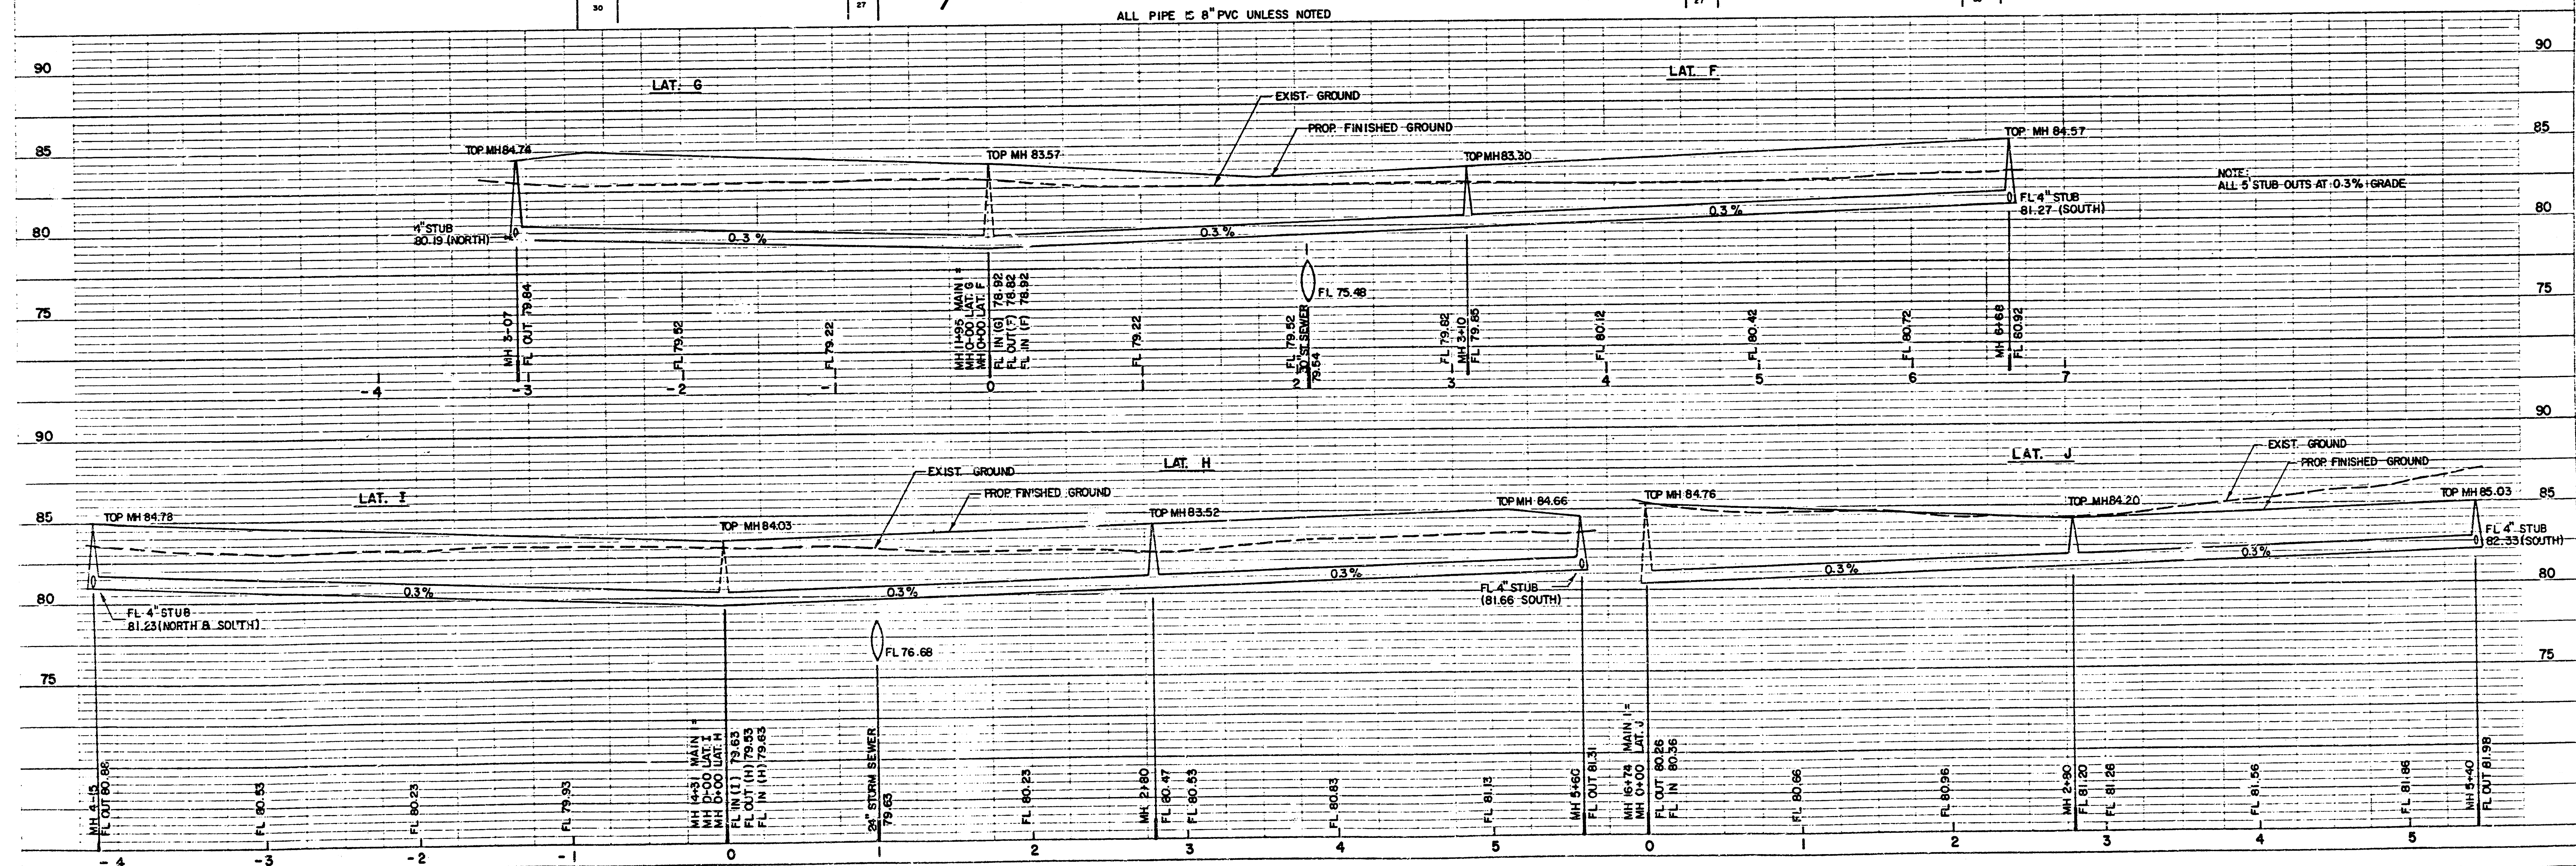

REISS & GOODNESS ENGINEERS
2160 WEST 21ST STREET
WICHITA, KANSAS 67203
(316) 832-0213

REVISION		DRAWN BY		CHECKED BY		DESIGNED BY		PROJECT

CUSTOMER

SCALE NOTED	PROJECT NO. MS 1285
DATE 4/1/85	SHEET 8 OF 13