


455115

**INDEX CODE: 607861**

1. The Contractor will be required to provide a minimum notice of twenty-four (24) hours to utility companies prior to starting any excavation as follows:  

Kansas One-Call                      687-2470
2. The special shallow manholes may be constructed using a precast section at Contractor's option.

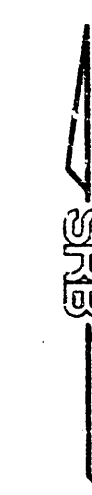

Scale 1" = 150'

1. TITLE SHEET
2. PLAN/PROFILE
3. SHALLOW MANHOLE DETAILS

APPROVED AS NOTED  
BY CITY ENGINEER OF MICHITA

Sanitary Sewers \_\_\_\_\_ H 4/11/94

Storm Sewers \_\_\_\_\_

Driveway Approaches \_\_\_\_\_

Water Mains \_\_\_\_\_

Paving \_\_\_\_\_


**NOTE TO CONTRACTORS**

*Inspection and testing for this project are to be provided by a Licensed Consulting Engineering Firm under contract with the Owner/Developer. Said inspection to be in accordance with the City of Wichita standard construction engineering practices and certified by a Licensed Professional Engineer. No work shall be performed in dedicated easements or public right-of-way by the Contractor without such inspection, nor shall any work be commenced without written authorization by the City Engineer.*

**BENCH MARK:**  
R.R. SPIKE IN POWER POLE @  
SW CORNER LAMPLIGHTER MOBILE  
HOME PARK; ELEV. 85.23

*CITY OF WICHITA, KANSAS*  
*MICHAEL E. LINDEBAK - CITY ENGINEER*

Booked 7-19-94  
From MS As Boites


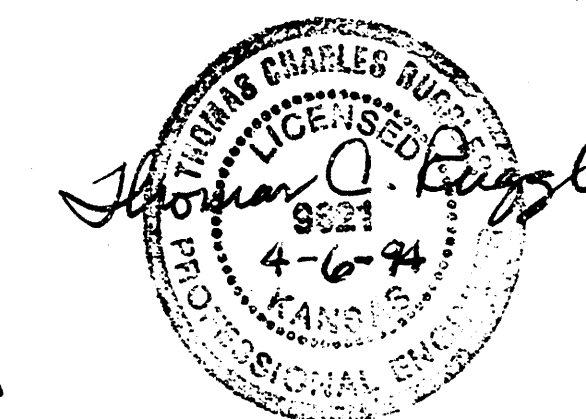


REVISÉD AS BUILT 6-3-94

140P

**SRB** 924 NORTH MAIN 316-264-8008  
WICHITA, KANSAS 67203 FAX 264-4621

**SAVOY, RUGGLES & BOHM, P. A.**  
ENGINEERING & SURVEYING

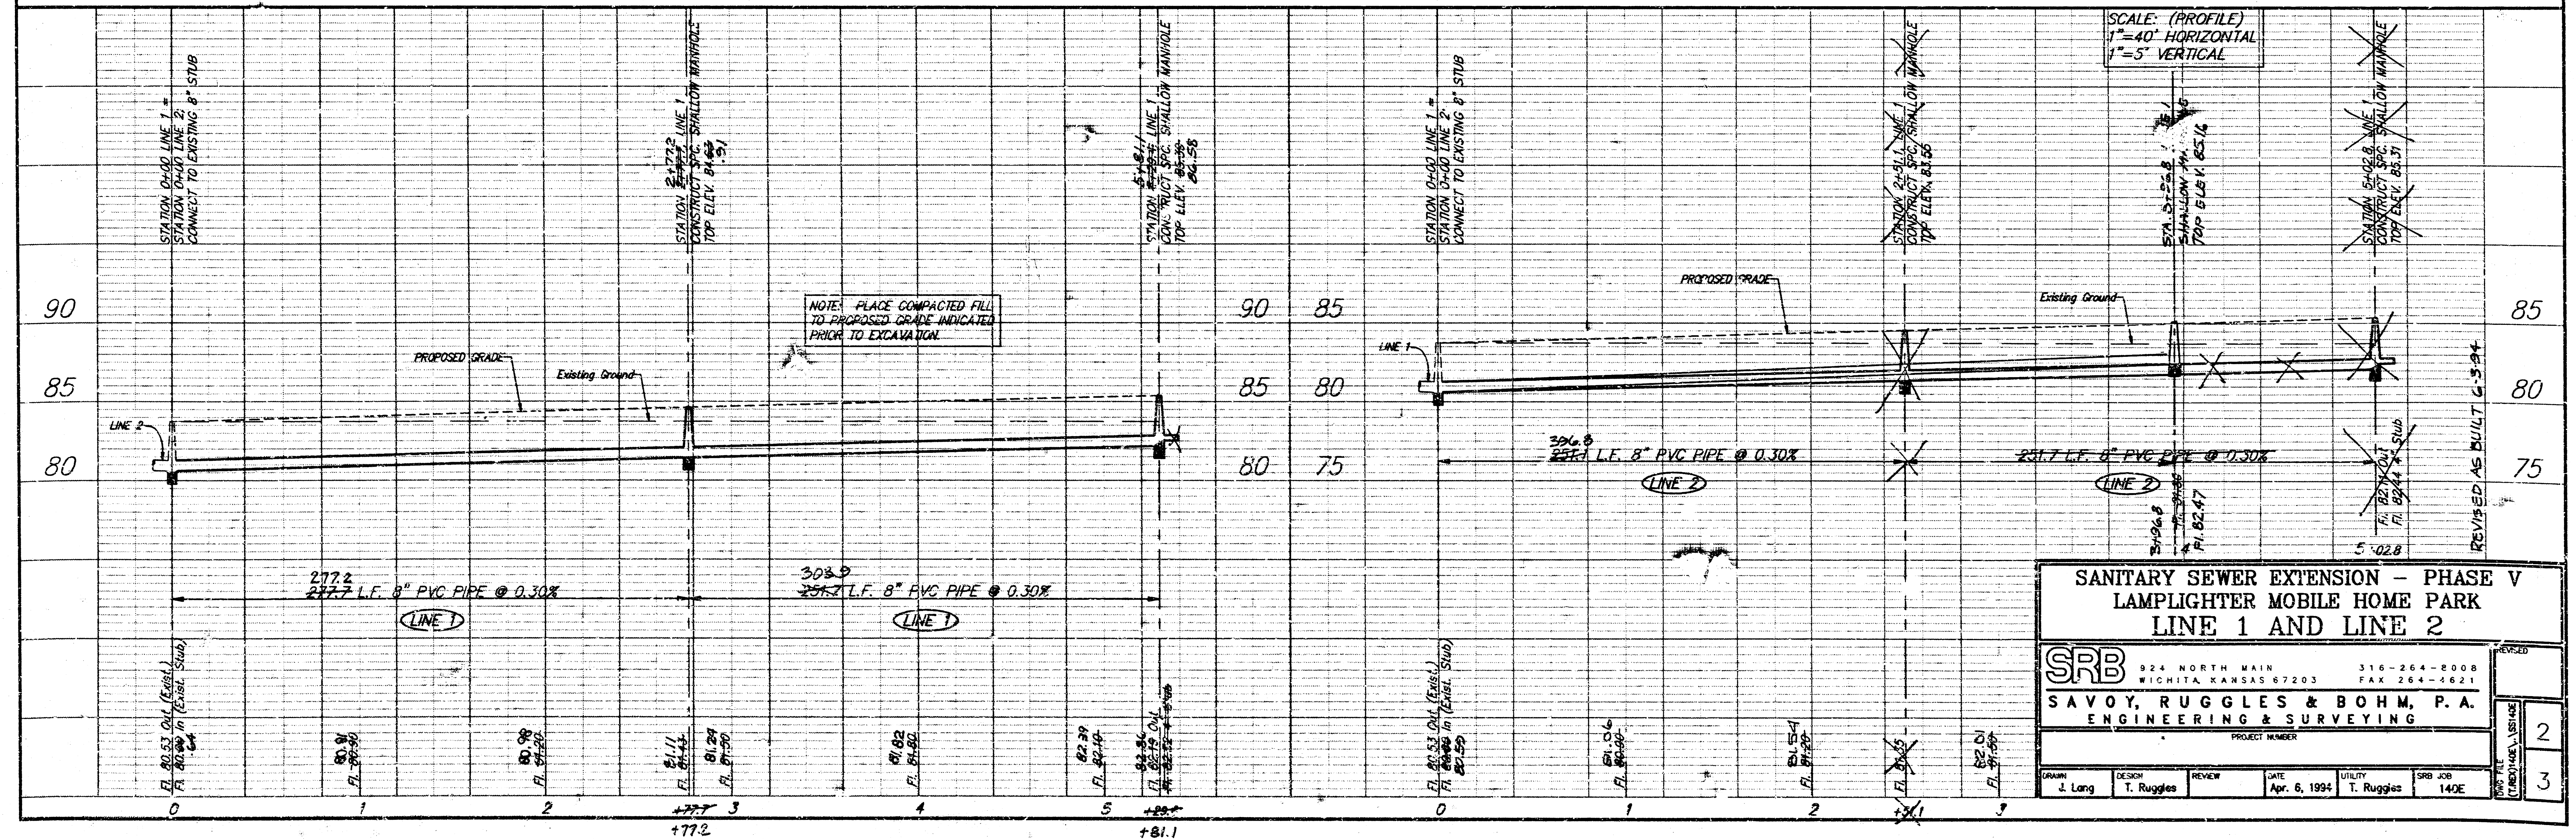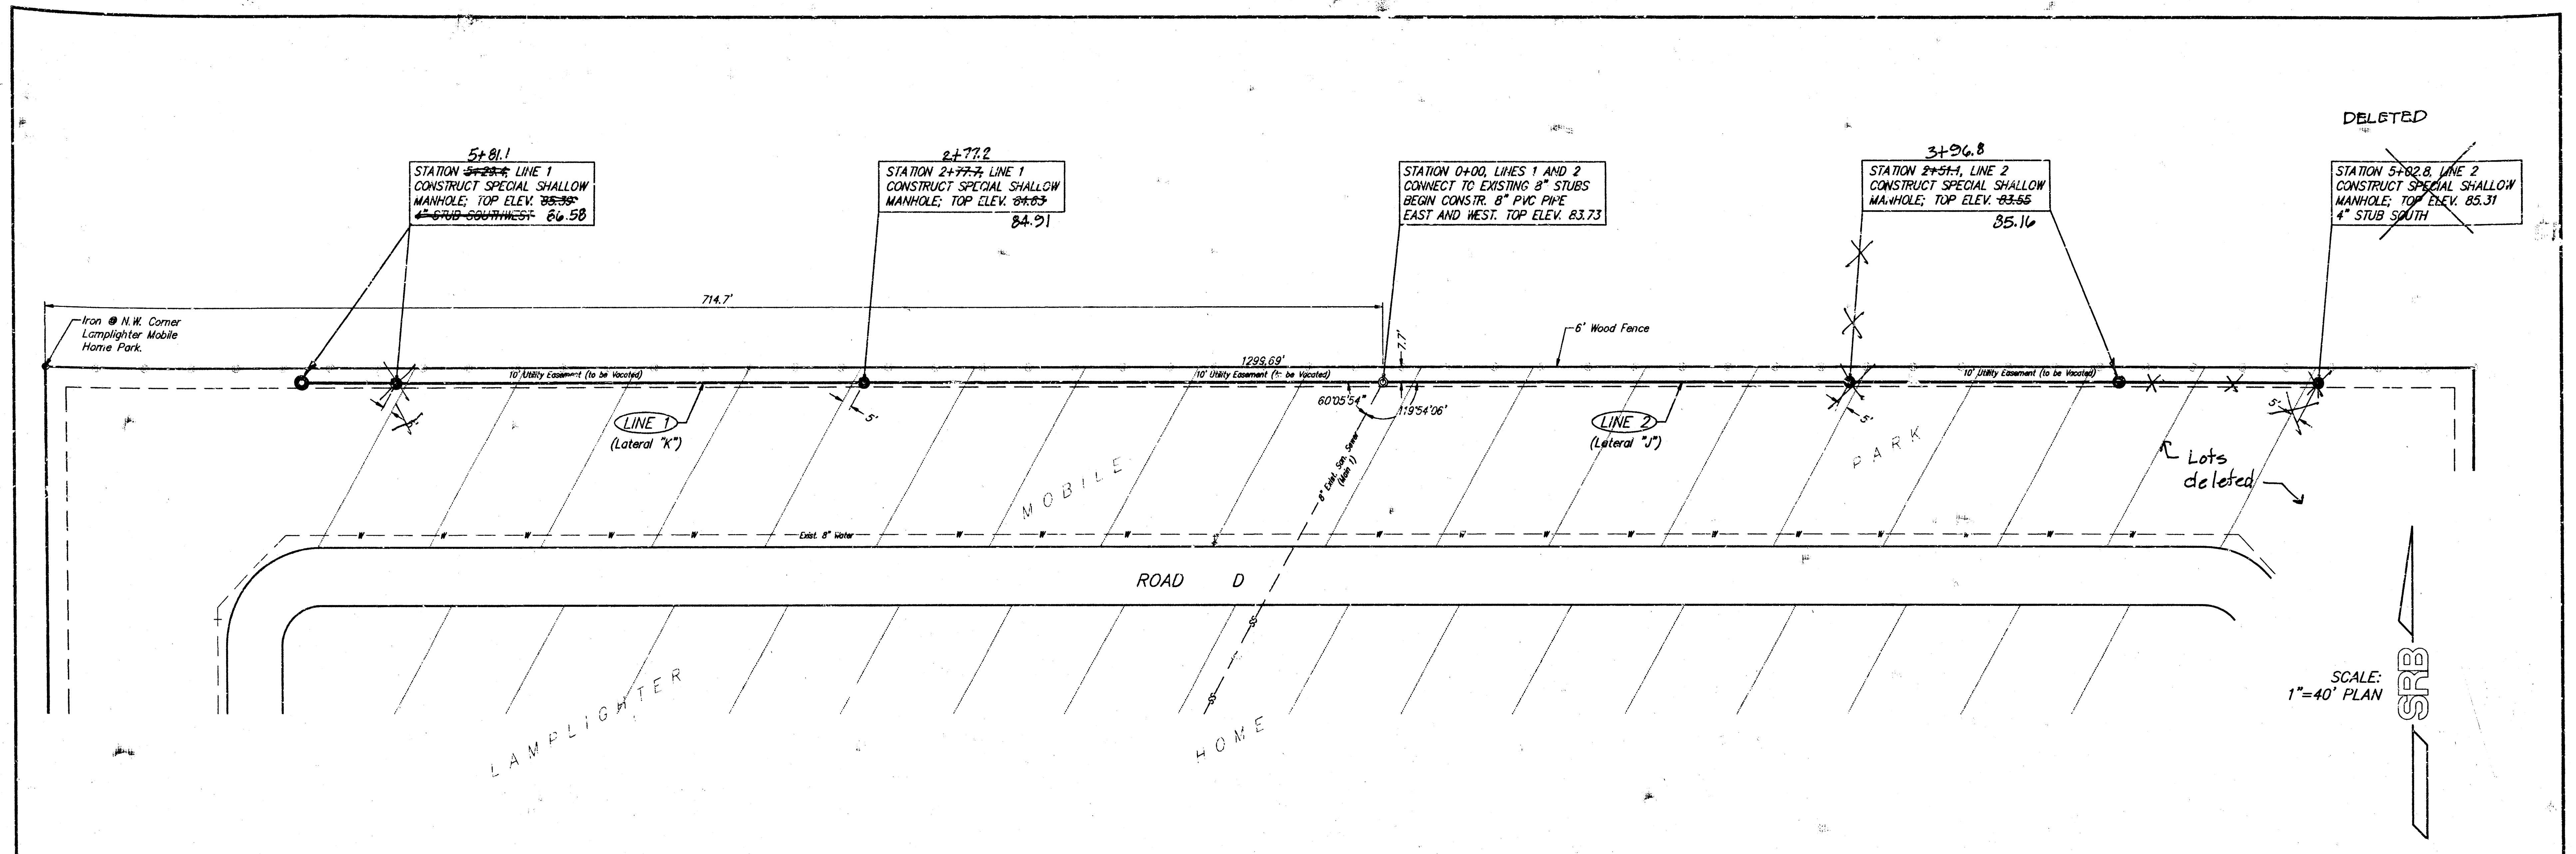

**SANITARY SEWER EXTENSION - PHASE V**  
**LAMPLIGHTER MOBILE HOME PARK**  
**LINE 1 AND LINE 2**


**SRB** 324 NORTH MAIN WICHITA, KANSAS 67203 316-264-2008 FAX 264-2621

**SAVOY, RUGGLES & BOHM, P.A.**  
 ENGINEERING & SURVEYING


PROJECT NUMBER: 140E

|                |                    |                    |                    |                     |               |
|----------------|--------------------|--------------------|--------------------|---------------------|---------------|
| DRAWN: J. Long | DESIGN: T. Ruggles | REVIEW: T. Ruggles | DATE: Apr. 6, 1994 | UTILITY: T. Ruggles | SRB JOB: 140E |
|----------------|--------------------|--------------------|--------------------|---------------------|---------------|


REVISIONS: 2, 3

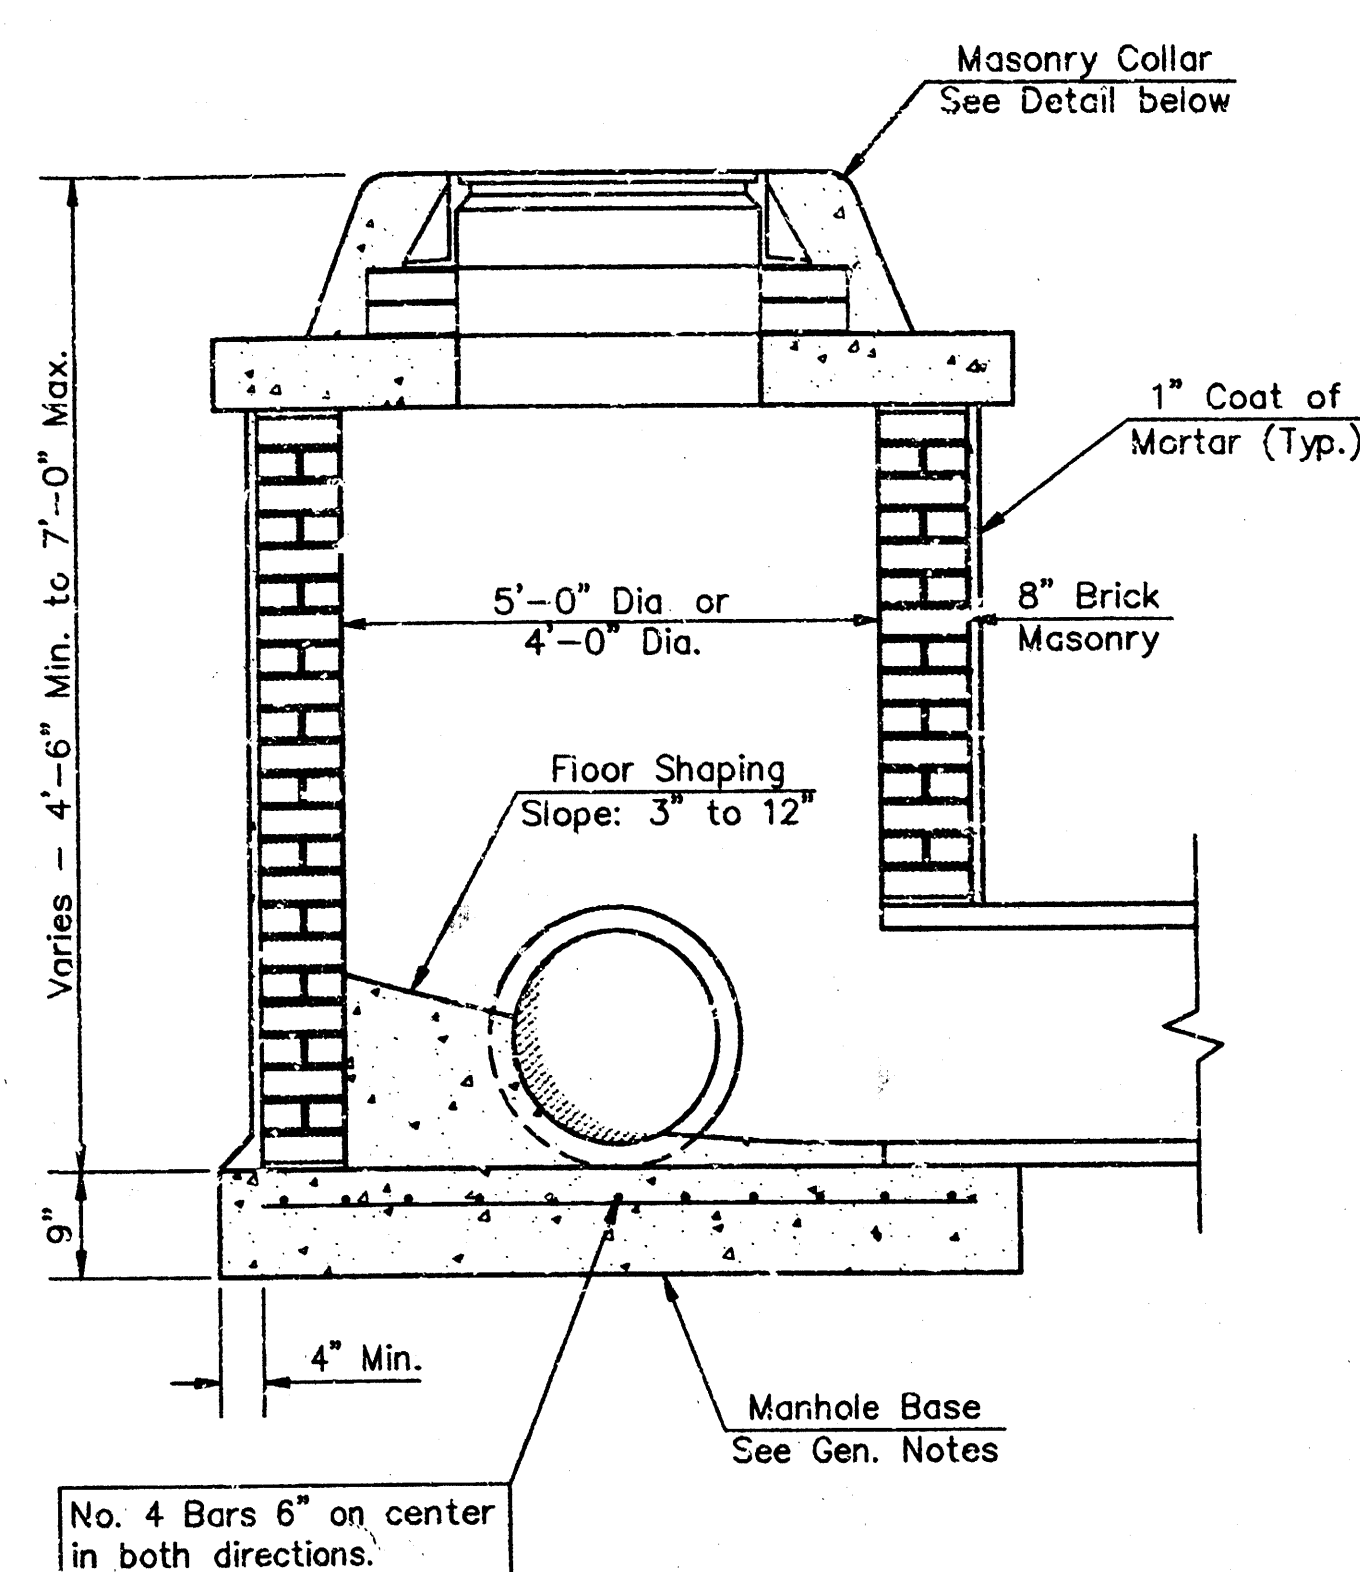


SHALLOW TYPE "A" MANHOLE

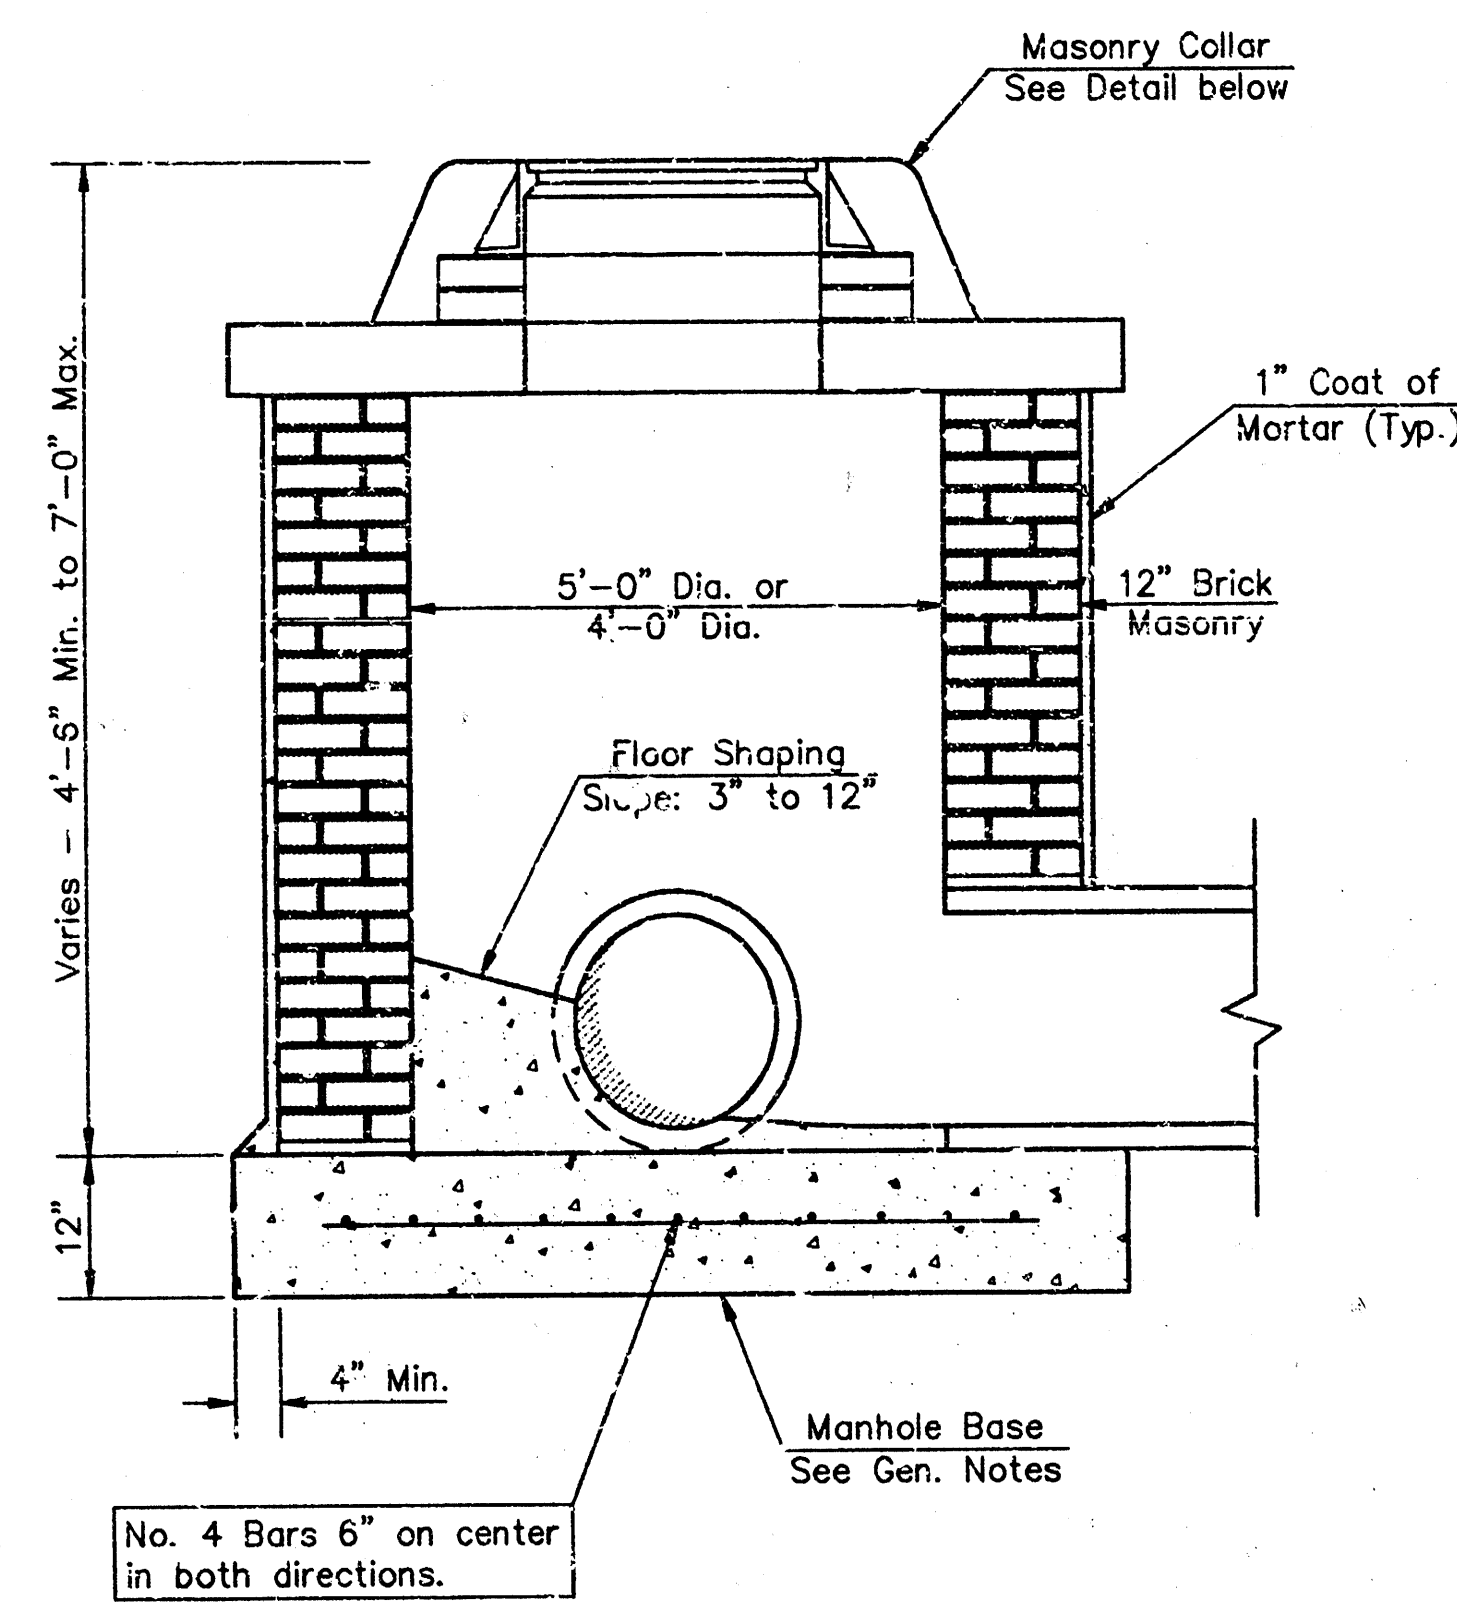


SHALLOW TYPE "B" MANHOLE

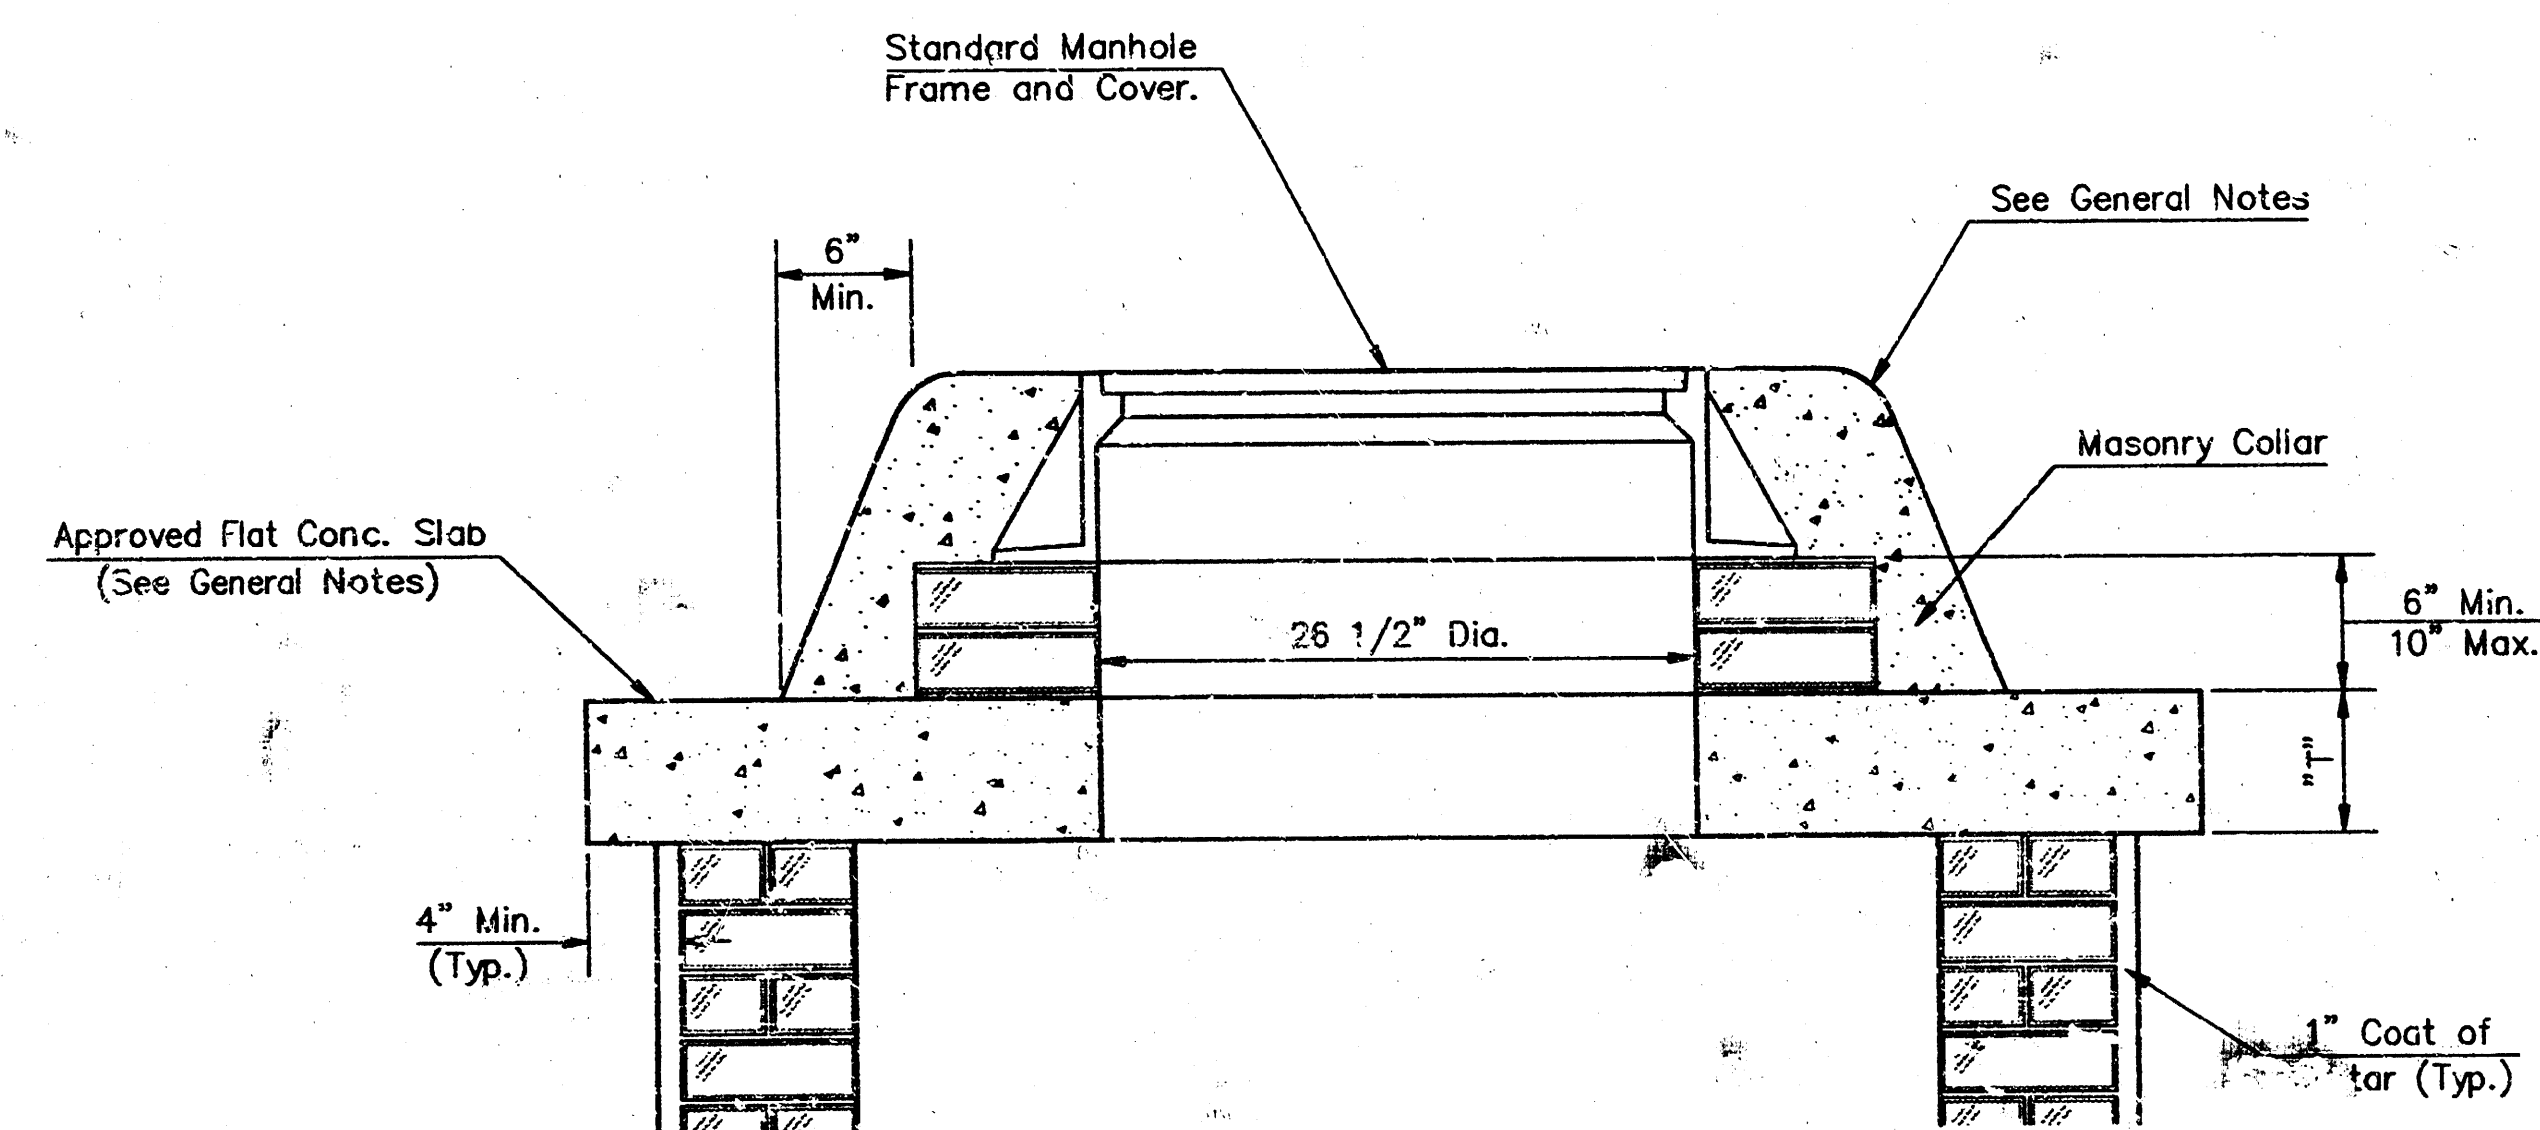

MASONRY COLLAR DETAIL

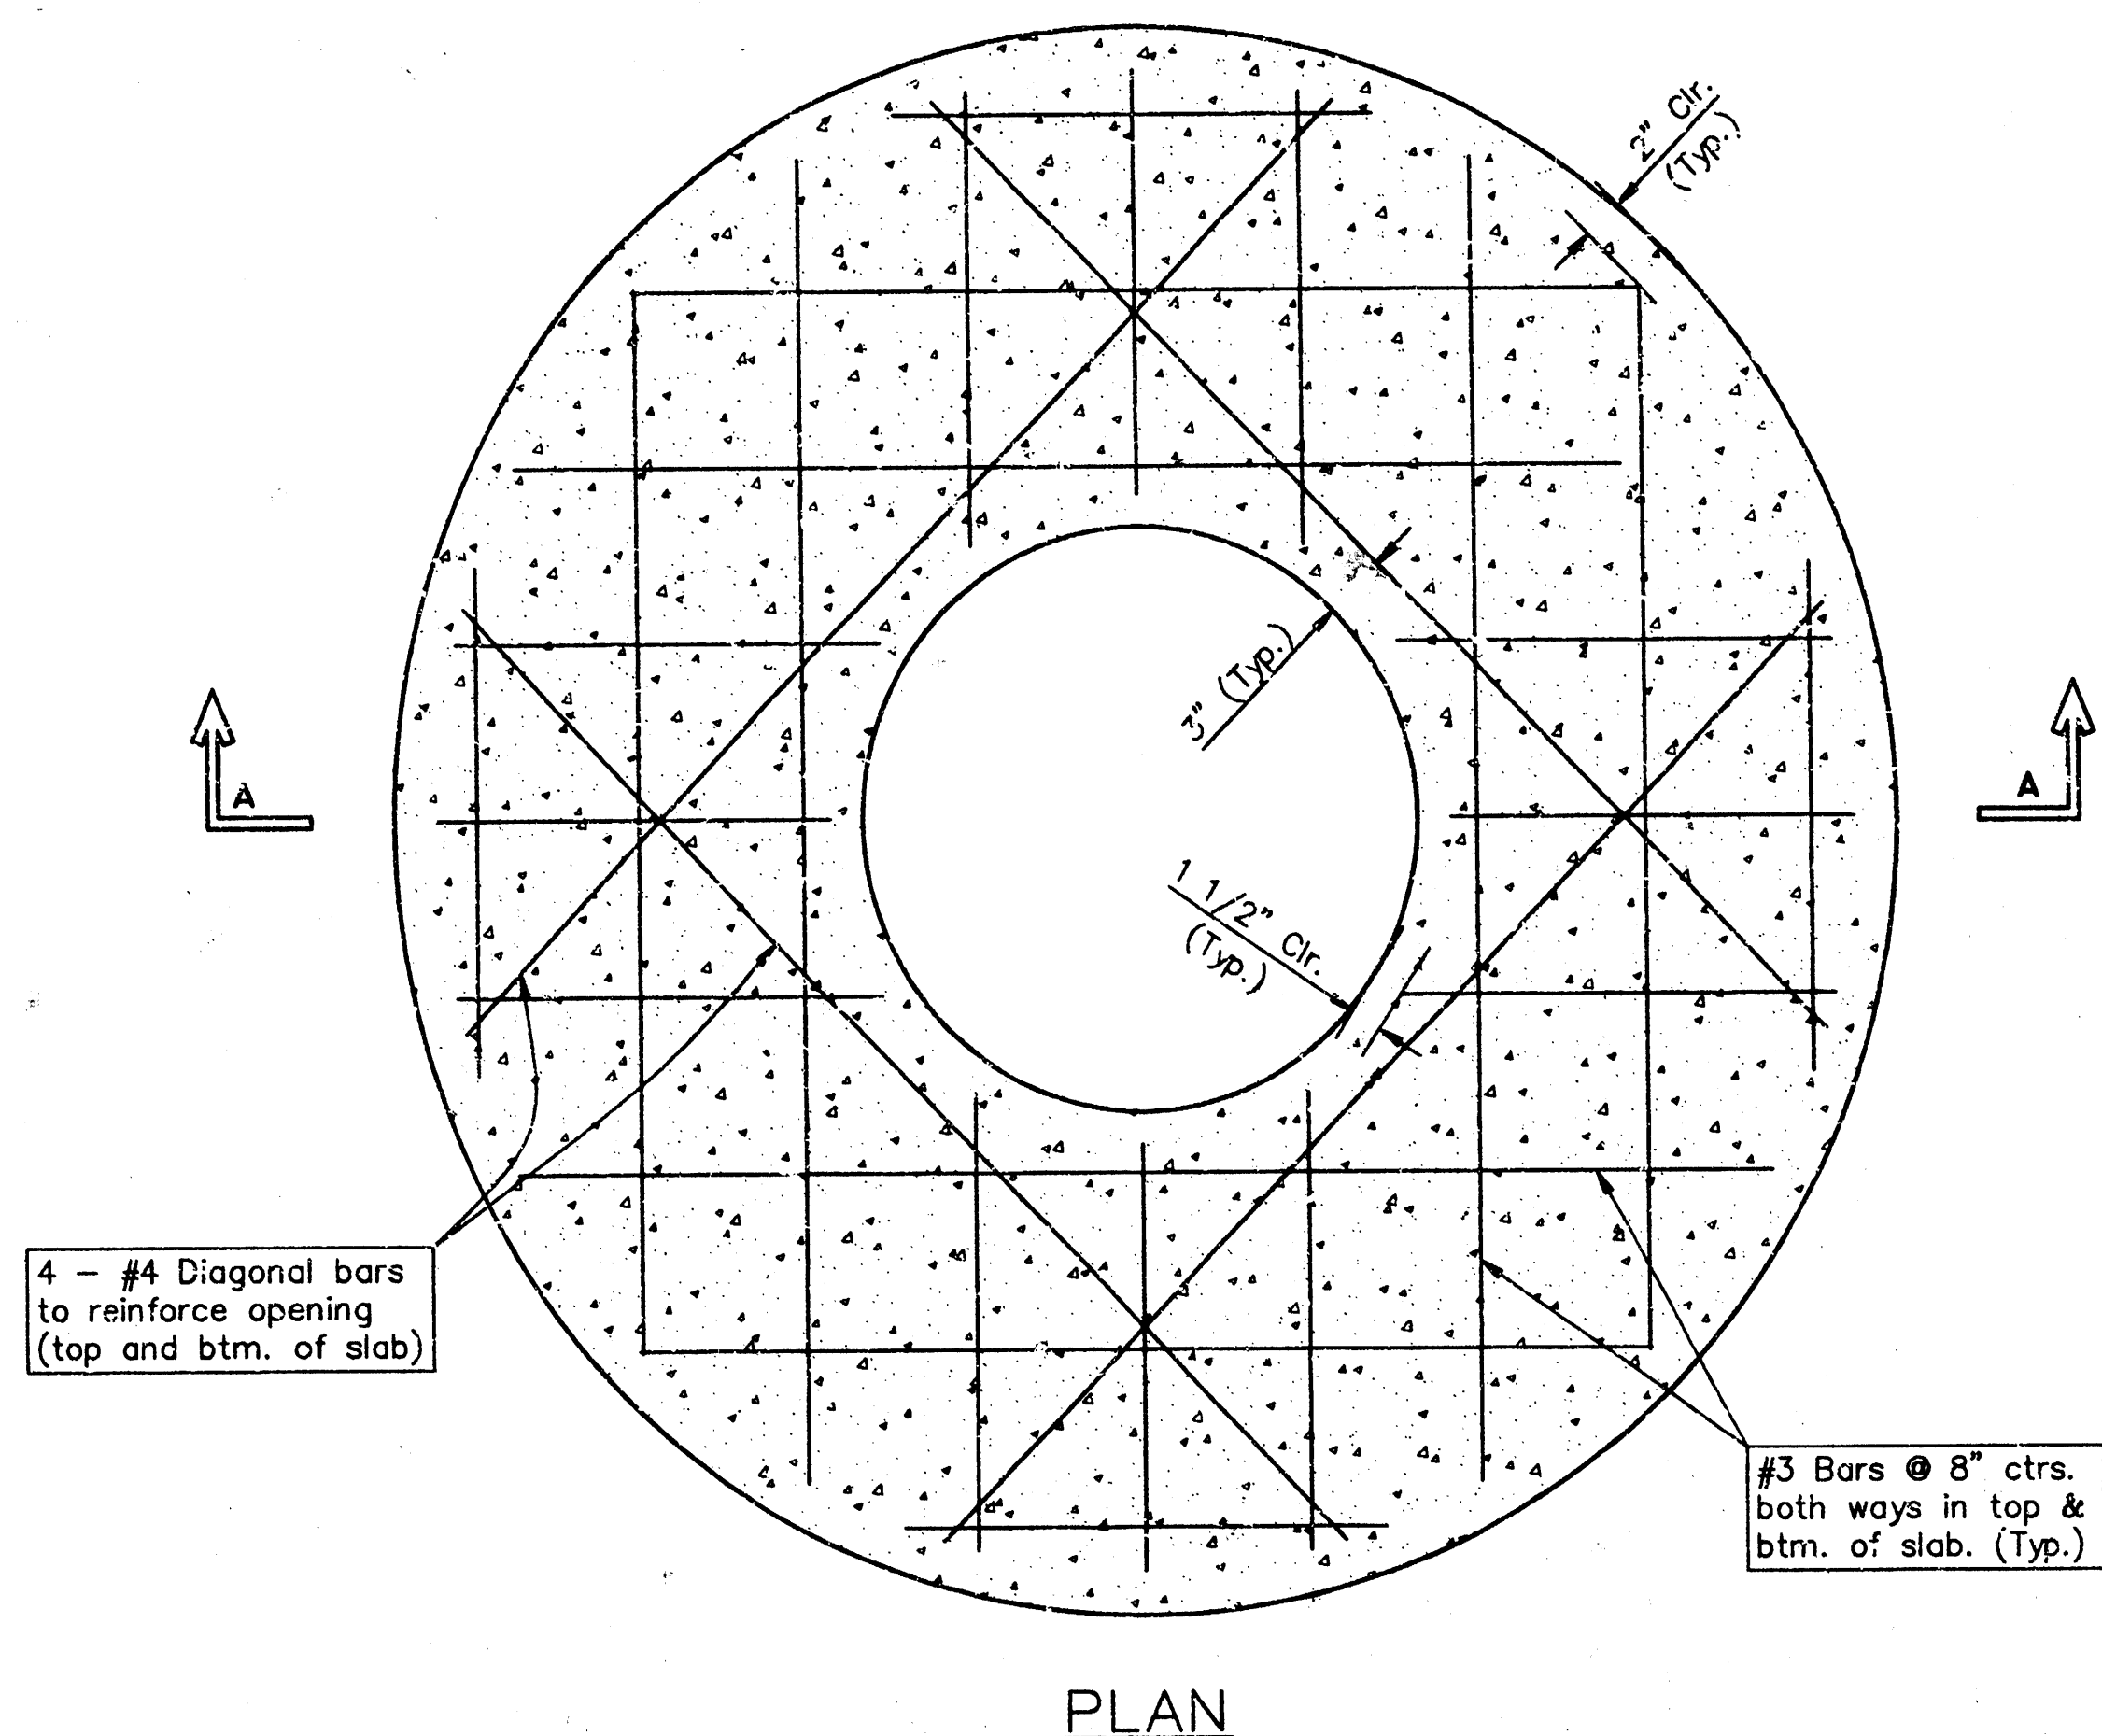


PLAN

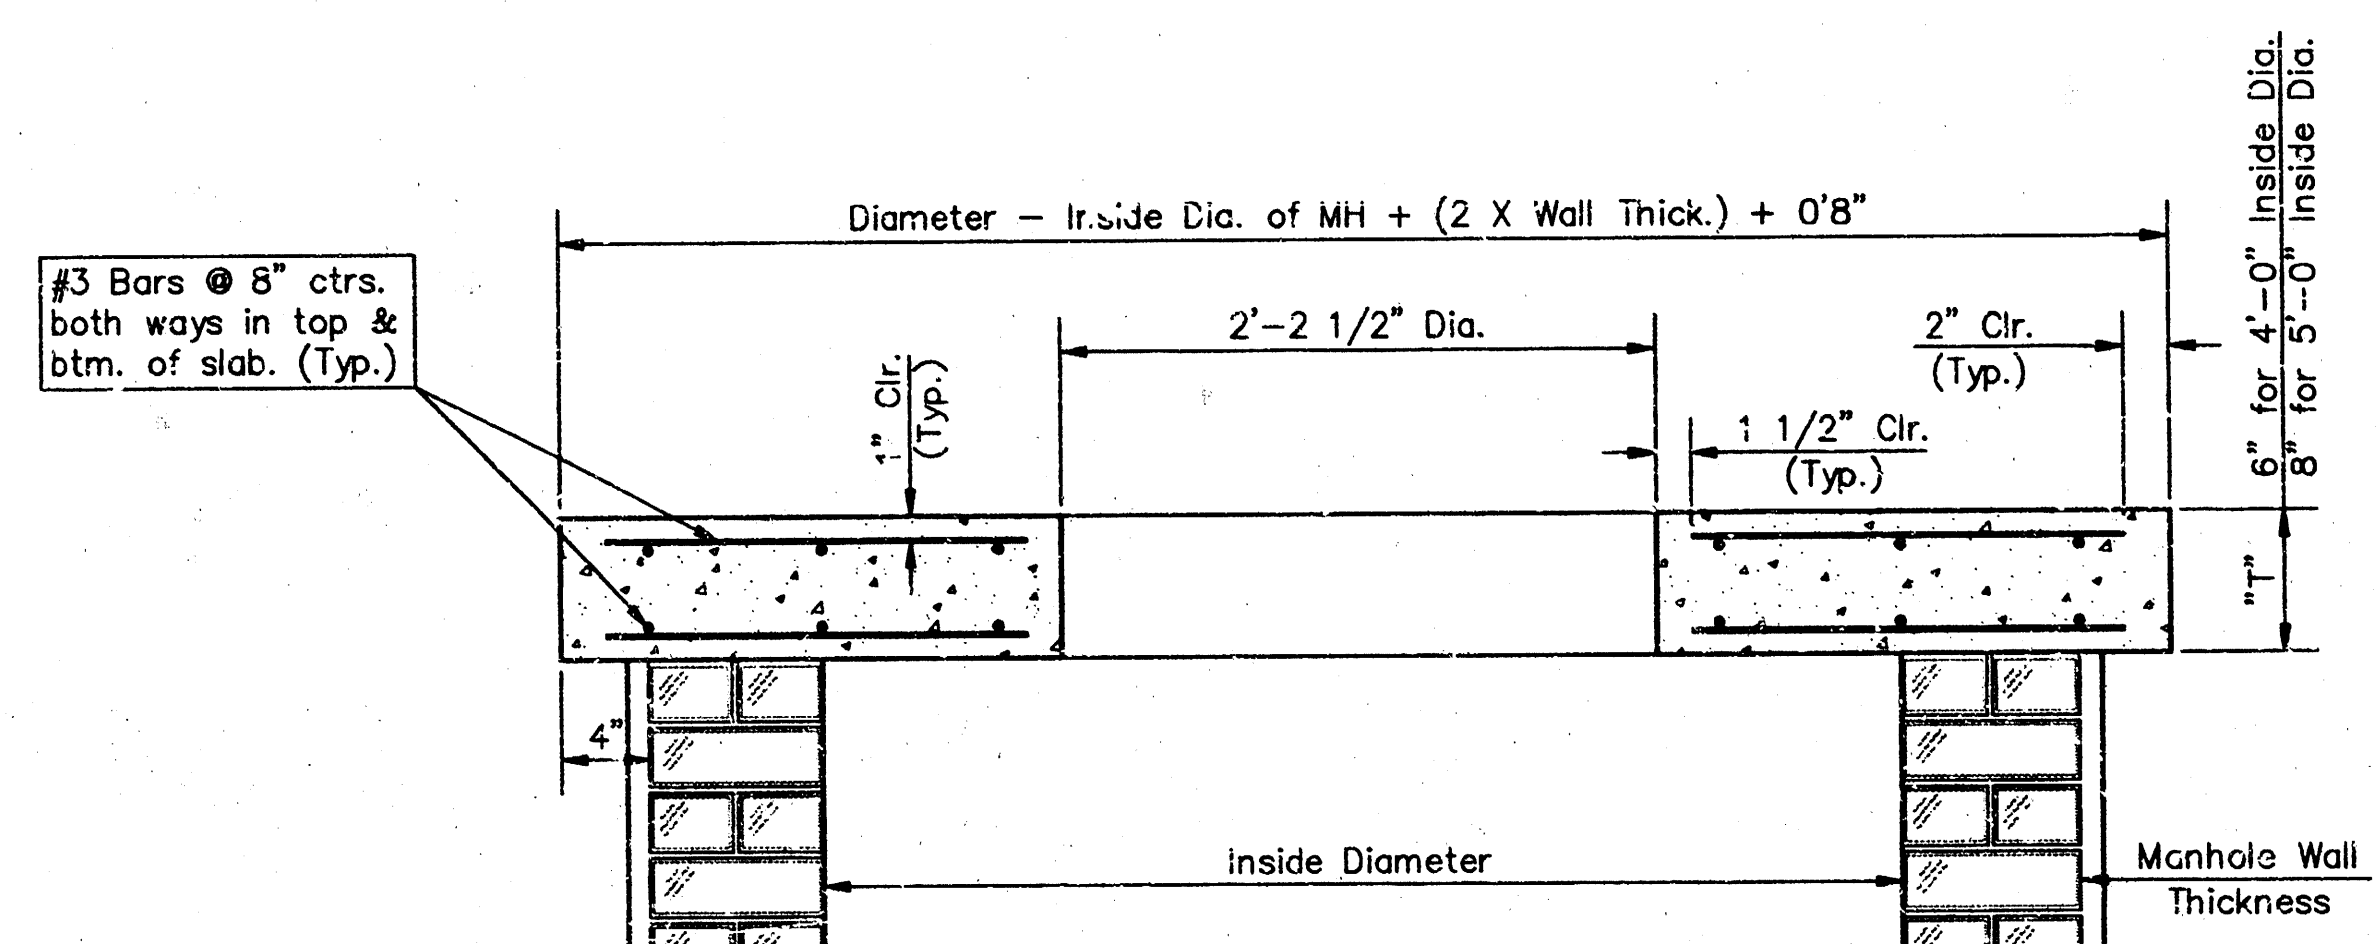


SECTION A-A

FLAT CONCRETE SLAB DETAILS

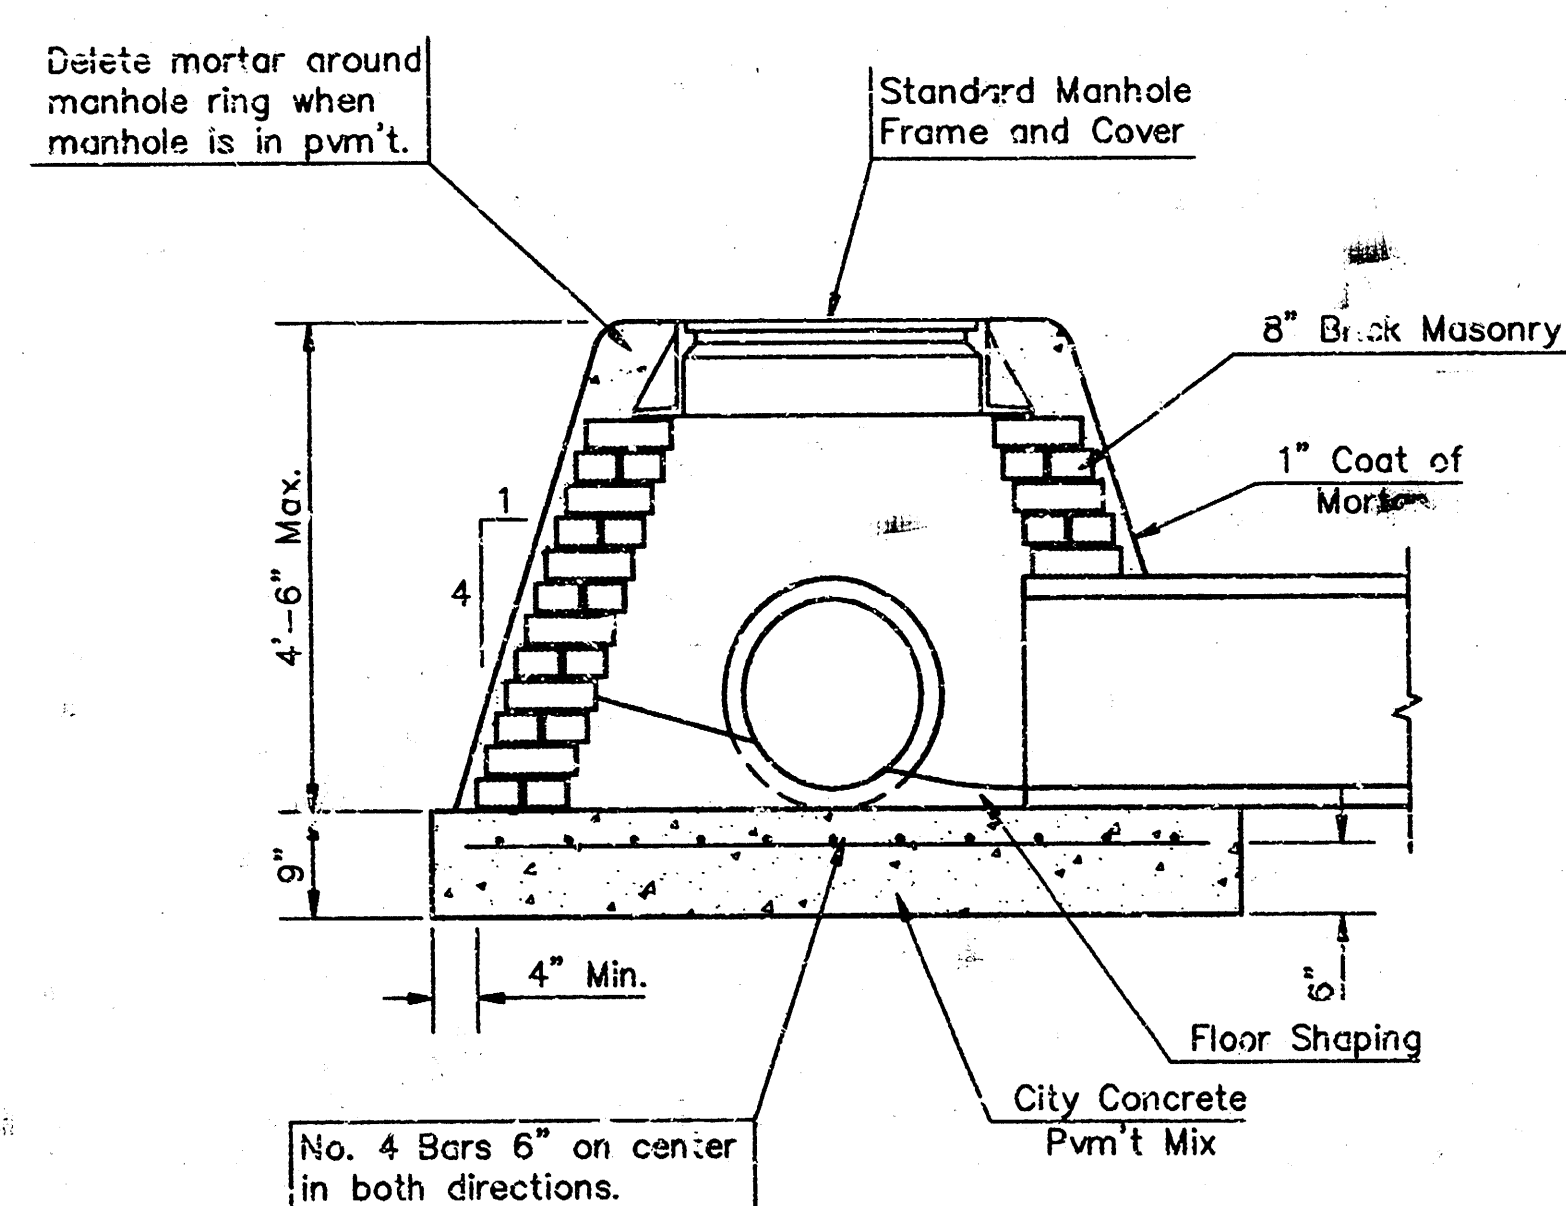

SPECIAL SHALLOW TYPE "A" MANHOLE

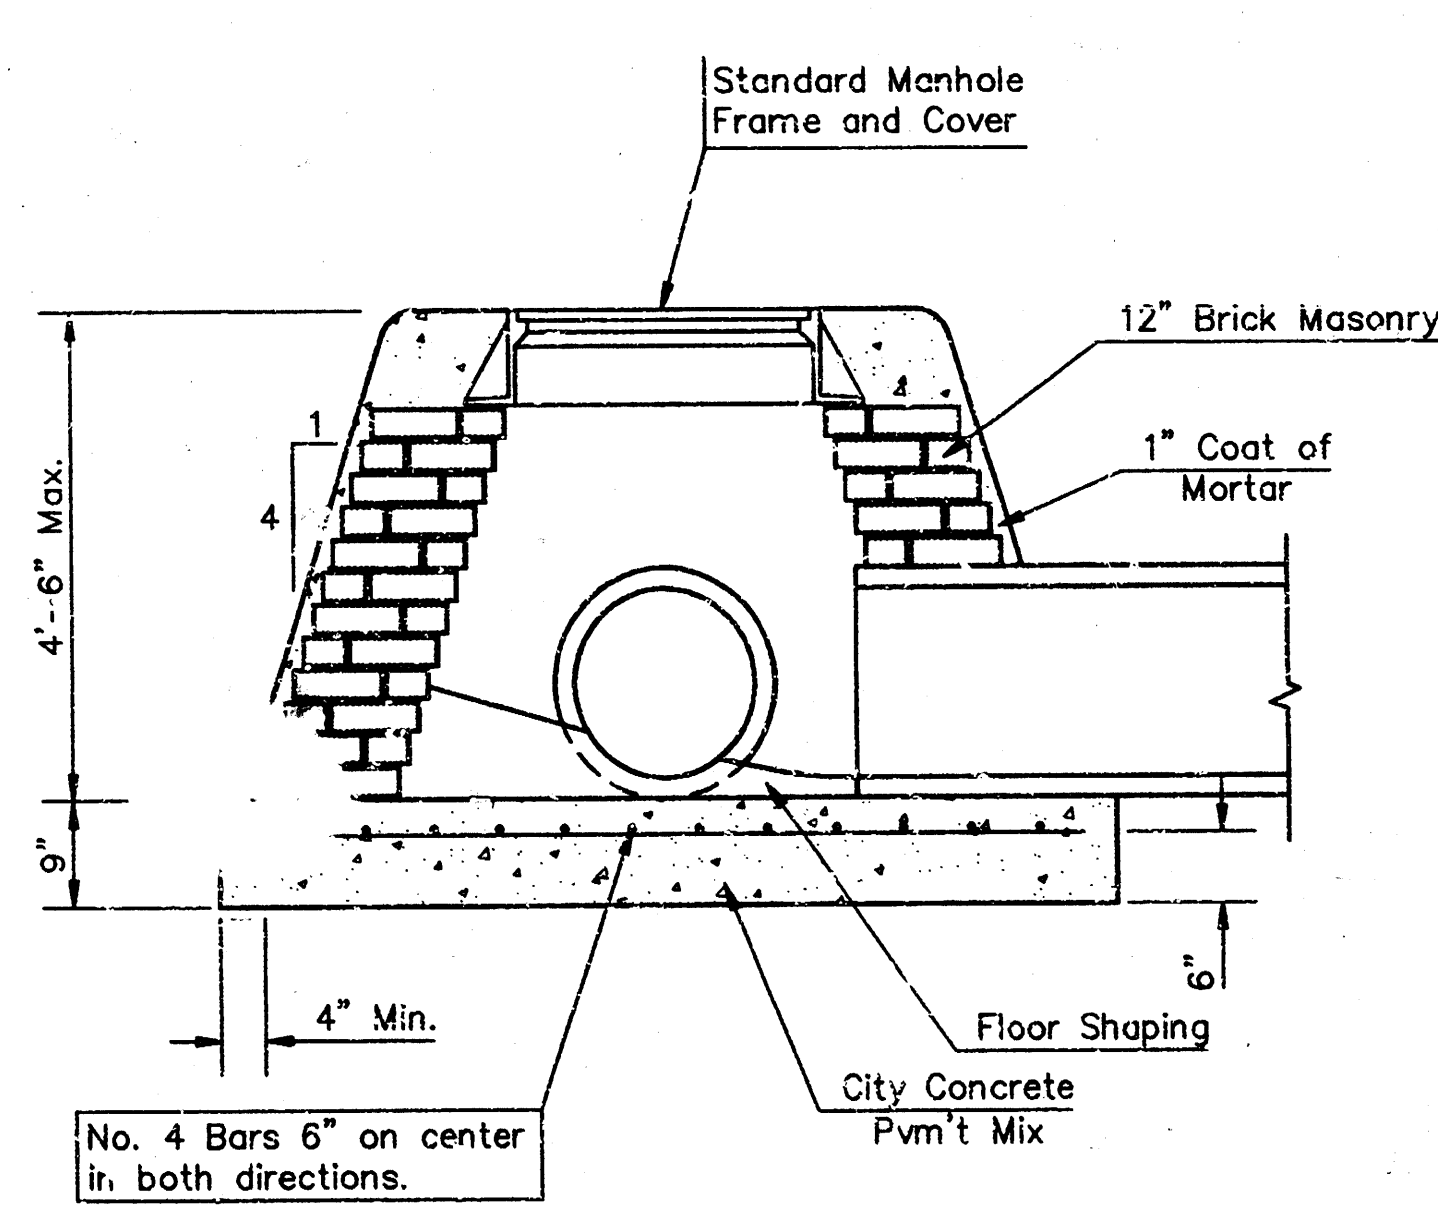

SPECIAL SHALLOW TYPE "B" MANHOLE

# GENERAL NOTES

- Mortar used in masonry construction shall contain 8 sacks of cement per cubic yard. Concrete used in manhole bases shall conform to the requirements of concrete for concrete pavement construction as specified in the city standard paving specifications using city concrete cement mix without air entraining admixture. Mortar shall be placed around the manhole ring as shown on the drawings when manholes are constructed in unpaved areas. Type "A" shallow manholes can be used on sewers when the manhole is not located within public street pavement. Manholes constructed where pipe sizes are smaller than 24" shall have an inside diameter of 4". Manholes constructed where pipe sizes are 24" or larger shall have an inside diameter of 5". Completed manhole shall be without leaks and water tight.
- Reinforcing steel shall be installed in the manhole bases and shall consist of no. 4 bars placed on 6" centers in both directions. The manhole base reinforcement shall be placed 6" above the bottom of the manhole base. All costs for furnishing and installing reinforcing steel shall be included in the unit price bid for the manhole.
- The floors of all manholes shall be shaped with flow channels such that the manholes will be self cleaning and free of areas where solids could be deposited as sewage flows through the manhole from all inlet pipes to the outlet pipe. Flow channels shall be formed to match the bottom halves of the inflowing pipes and the outflowing pipe as shown by the drawings. Manhole floors shall have slopes of 3 inches per foot in the areas outside of the flow channels sloped toward the flow channels. Pipes laid through manholes shall have the top half removed to neat lines for the full inside diameter of the manhole. Manhole floors shall then be shaped around the bottom half of the pipe which forms the flow channel.
- Pipes installed within the excavation made for the manhole shall be cradled with concrete to the limits of the manhole excavation. When clay pipe is used, the cradle shall extend to the first joint outside the manhole. The cradle shall be terminated at the clay pipe joint in a manner which will maintain the flexibility of the joint. Cost of cradle within manhole excavation or to clay pipe joints adjacent to manhole shall be included in the unit price bid for the manhole.
- Manhole cover castings and manhole frame castings shall conform to the requirements as indicated in the standard specifications and as shown in the standard detail drawings.
- The crowns of inflowing pipes shall never be set lower than the crown of the outflowing pipe.
- Standard shallow manholes type "A" and "B" shall be paid for at the unit price bid per each for the type and diameter indicated. Standard special shallow manholes type "A" and "B" shall be paid for at the unit price bid per each for the type indicated. All standard shallow manhole diameters will be 4' unless indicated otherwise.
- All brick used in manhole construction shall meet Grade SW of ASTM C652 or C62-87.

## SANITARY SEWER EXTENSION - PHASE V LAMPLIGHTER MOBILE HOME PARK SHALLOW MANHOLE DETAILS

|                                                                                       |                                |                             |
|---------------------------------------------------------------------------------------|--------------------------------|-----------------------------|
| <b>SRB</b><br>924 NORTH MAIN<br>WICHITA, KANSAS 67203<br>316-264-8008<br>FAX 264-4621 |                                | PROJECT NUMBER<br>3         |
| <b>SAVOY, RUGGLES &amp; BOHM, P.A.</b><br>ENGINEERING & SURVEYING                     |                                | DATE<br>Apr. 4, 1994        |
| DRAWN<br>C.O.W.                                                                       | REVIEW<br>DATE<br>Apr. 4, 1994 | UTILITY<br>SRB JMS<br>1:50E |