





Langland Addn.

7-15-76
 APPROVED AS NOTED
 By CITY ENGINEER OF WICHITA
 Sanitary Sewers _____
 Storm Sewers D.E.S.
 Driveway Approaches _____

INCORPORATED
 KANSAS TURNPIKE AUTHORITY

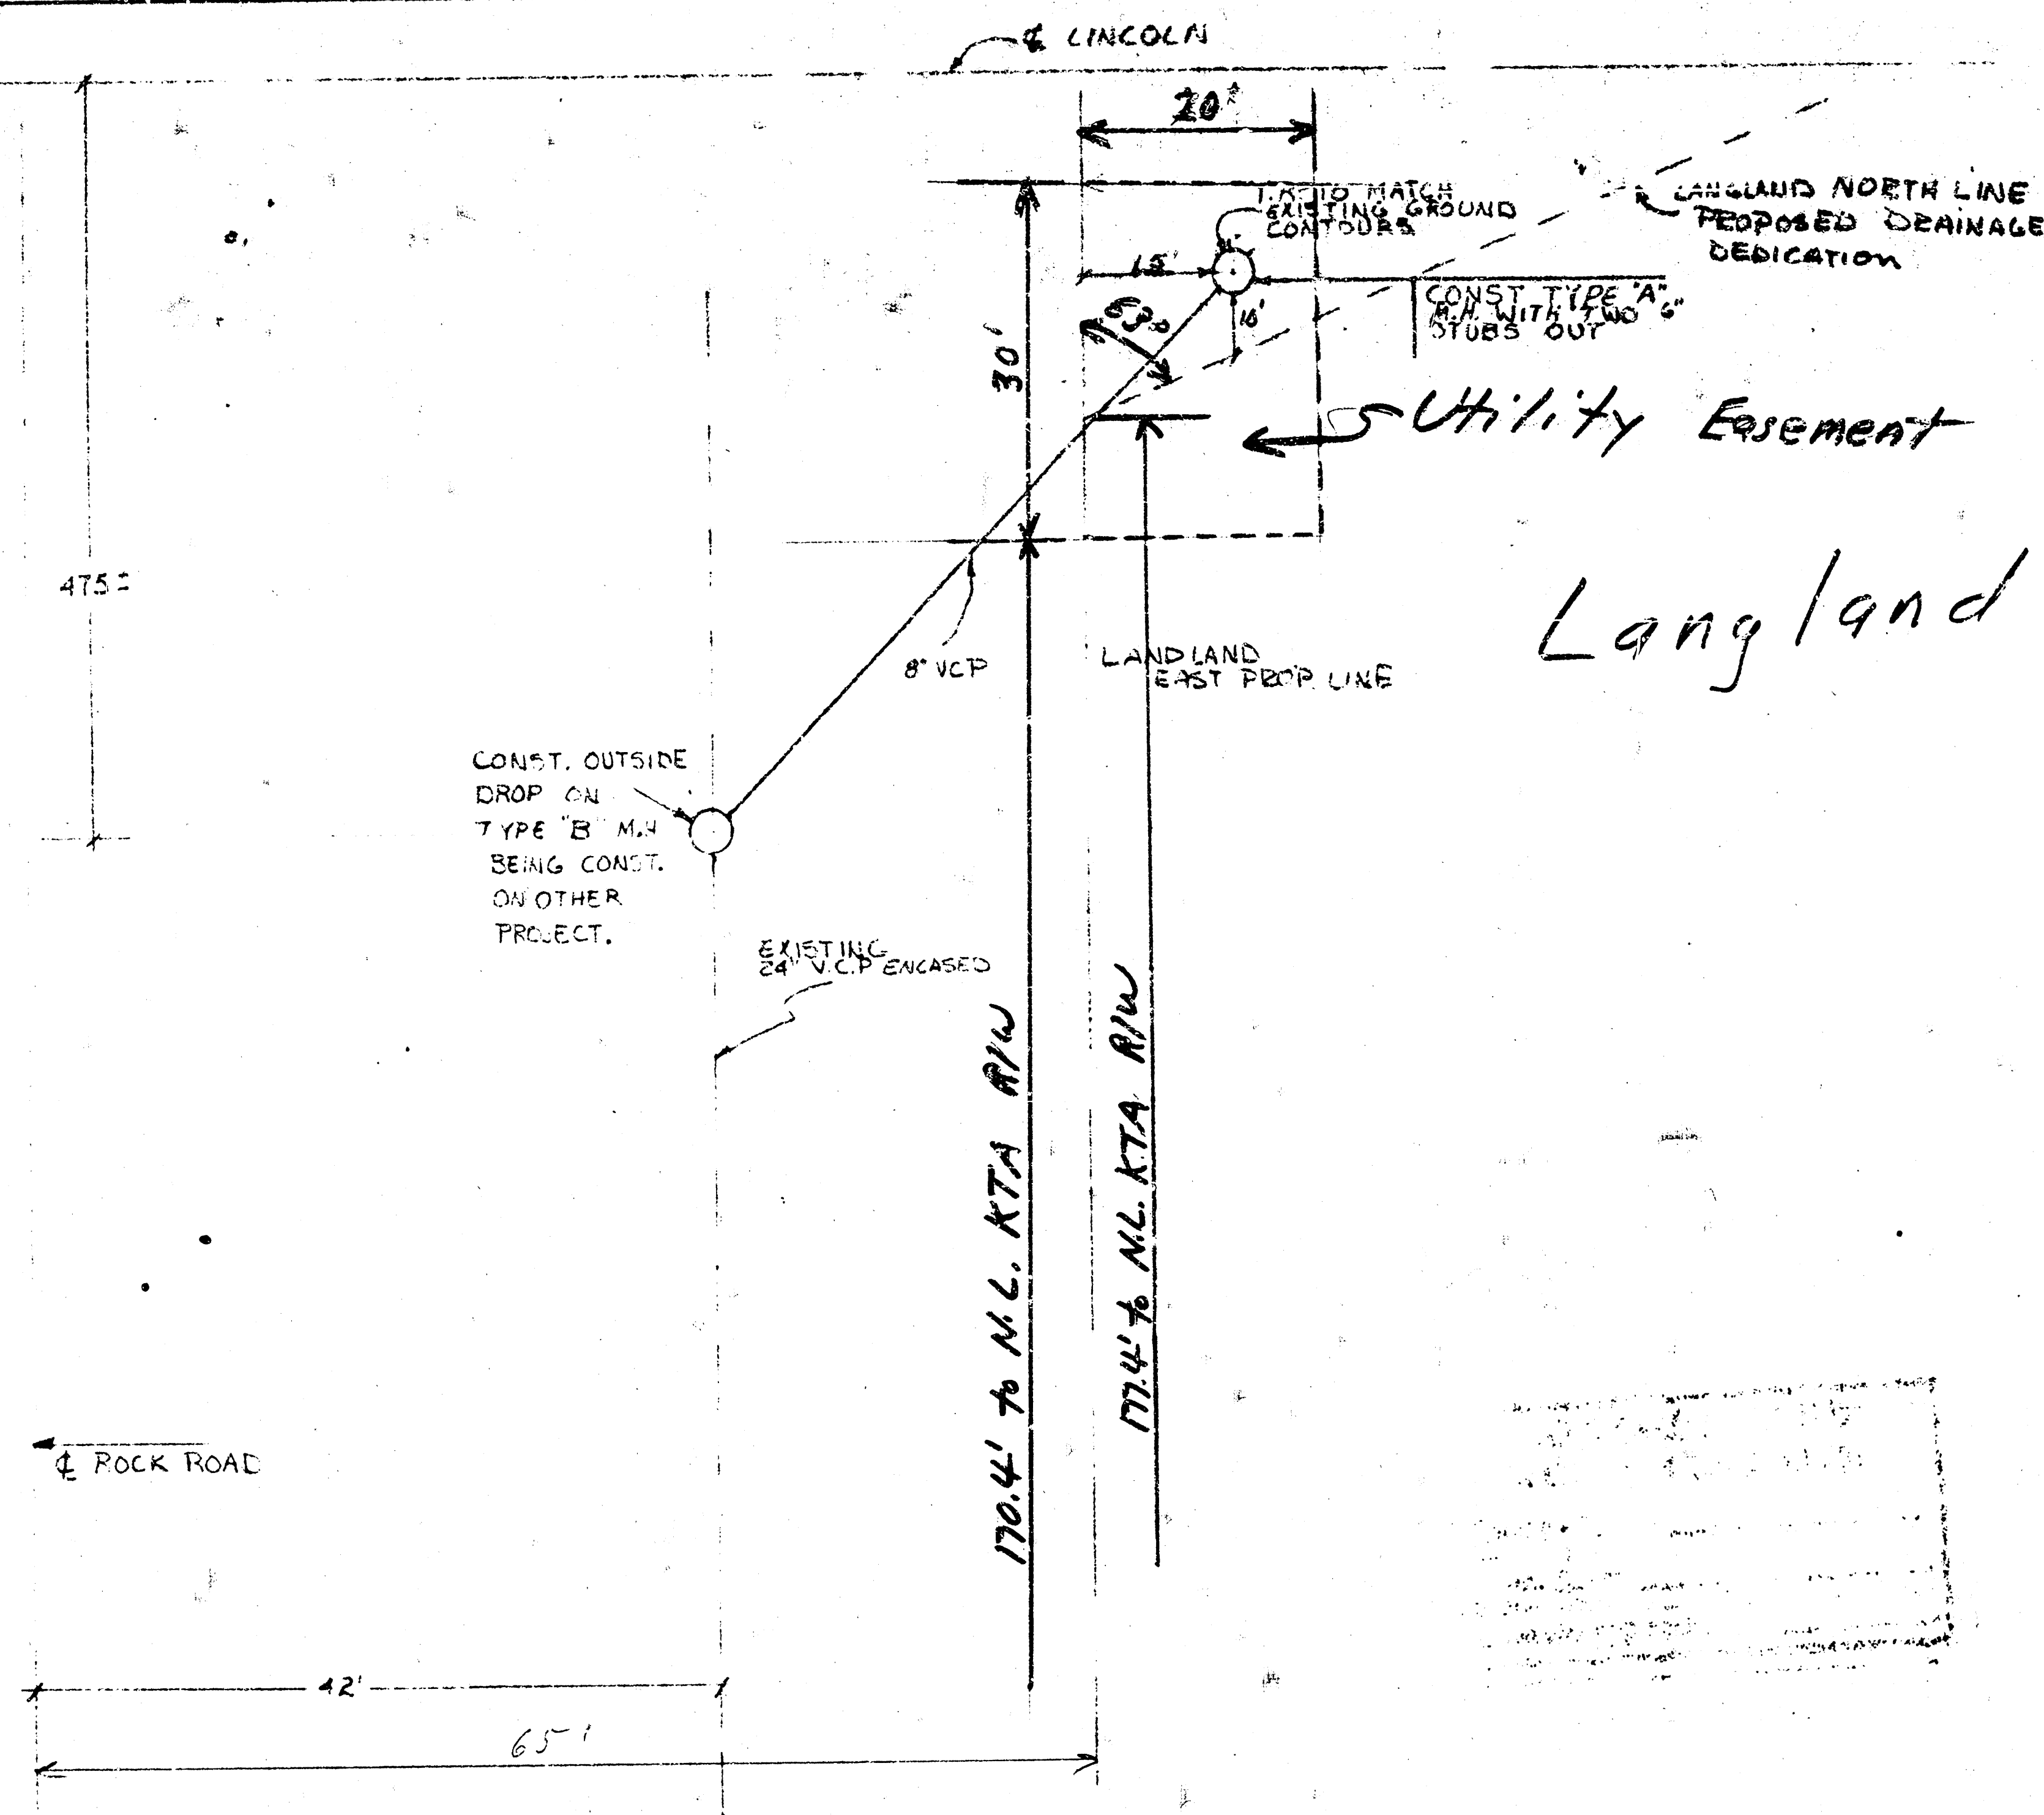

SCALE 1"=10'

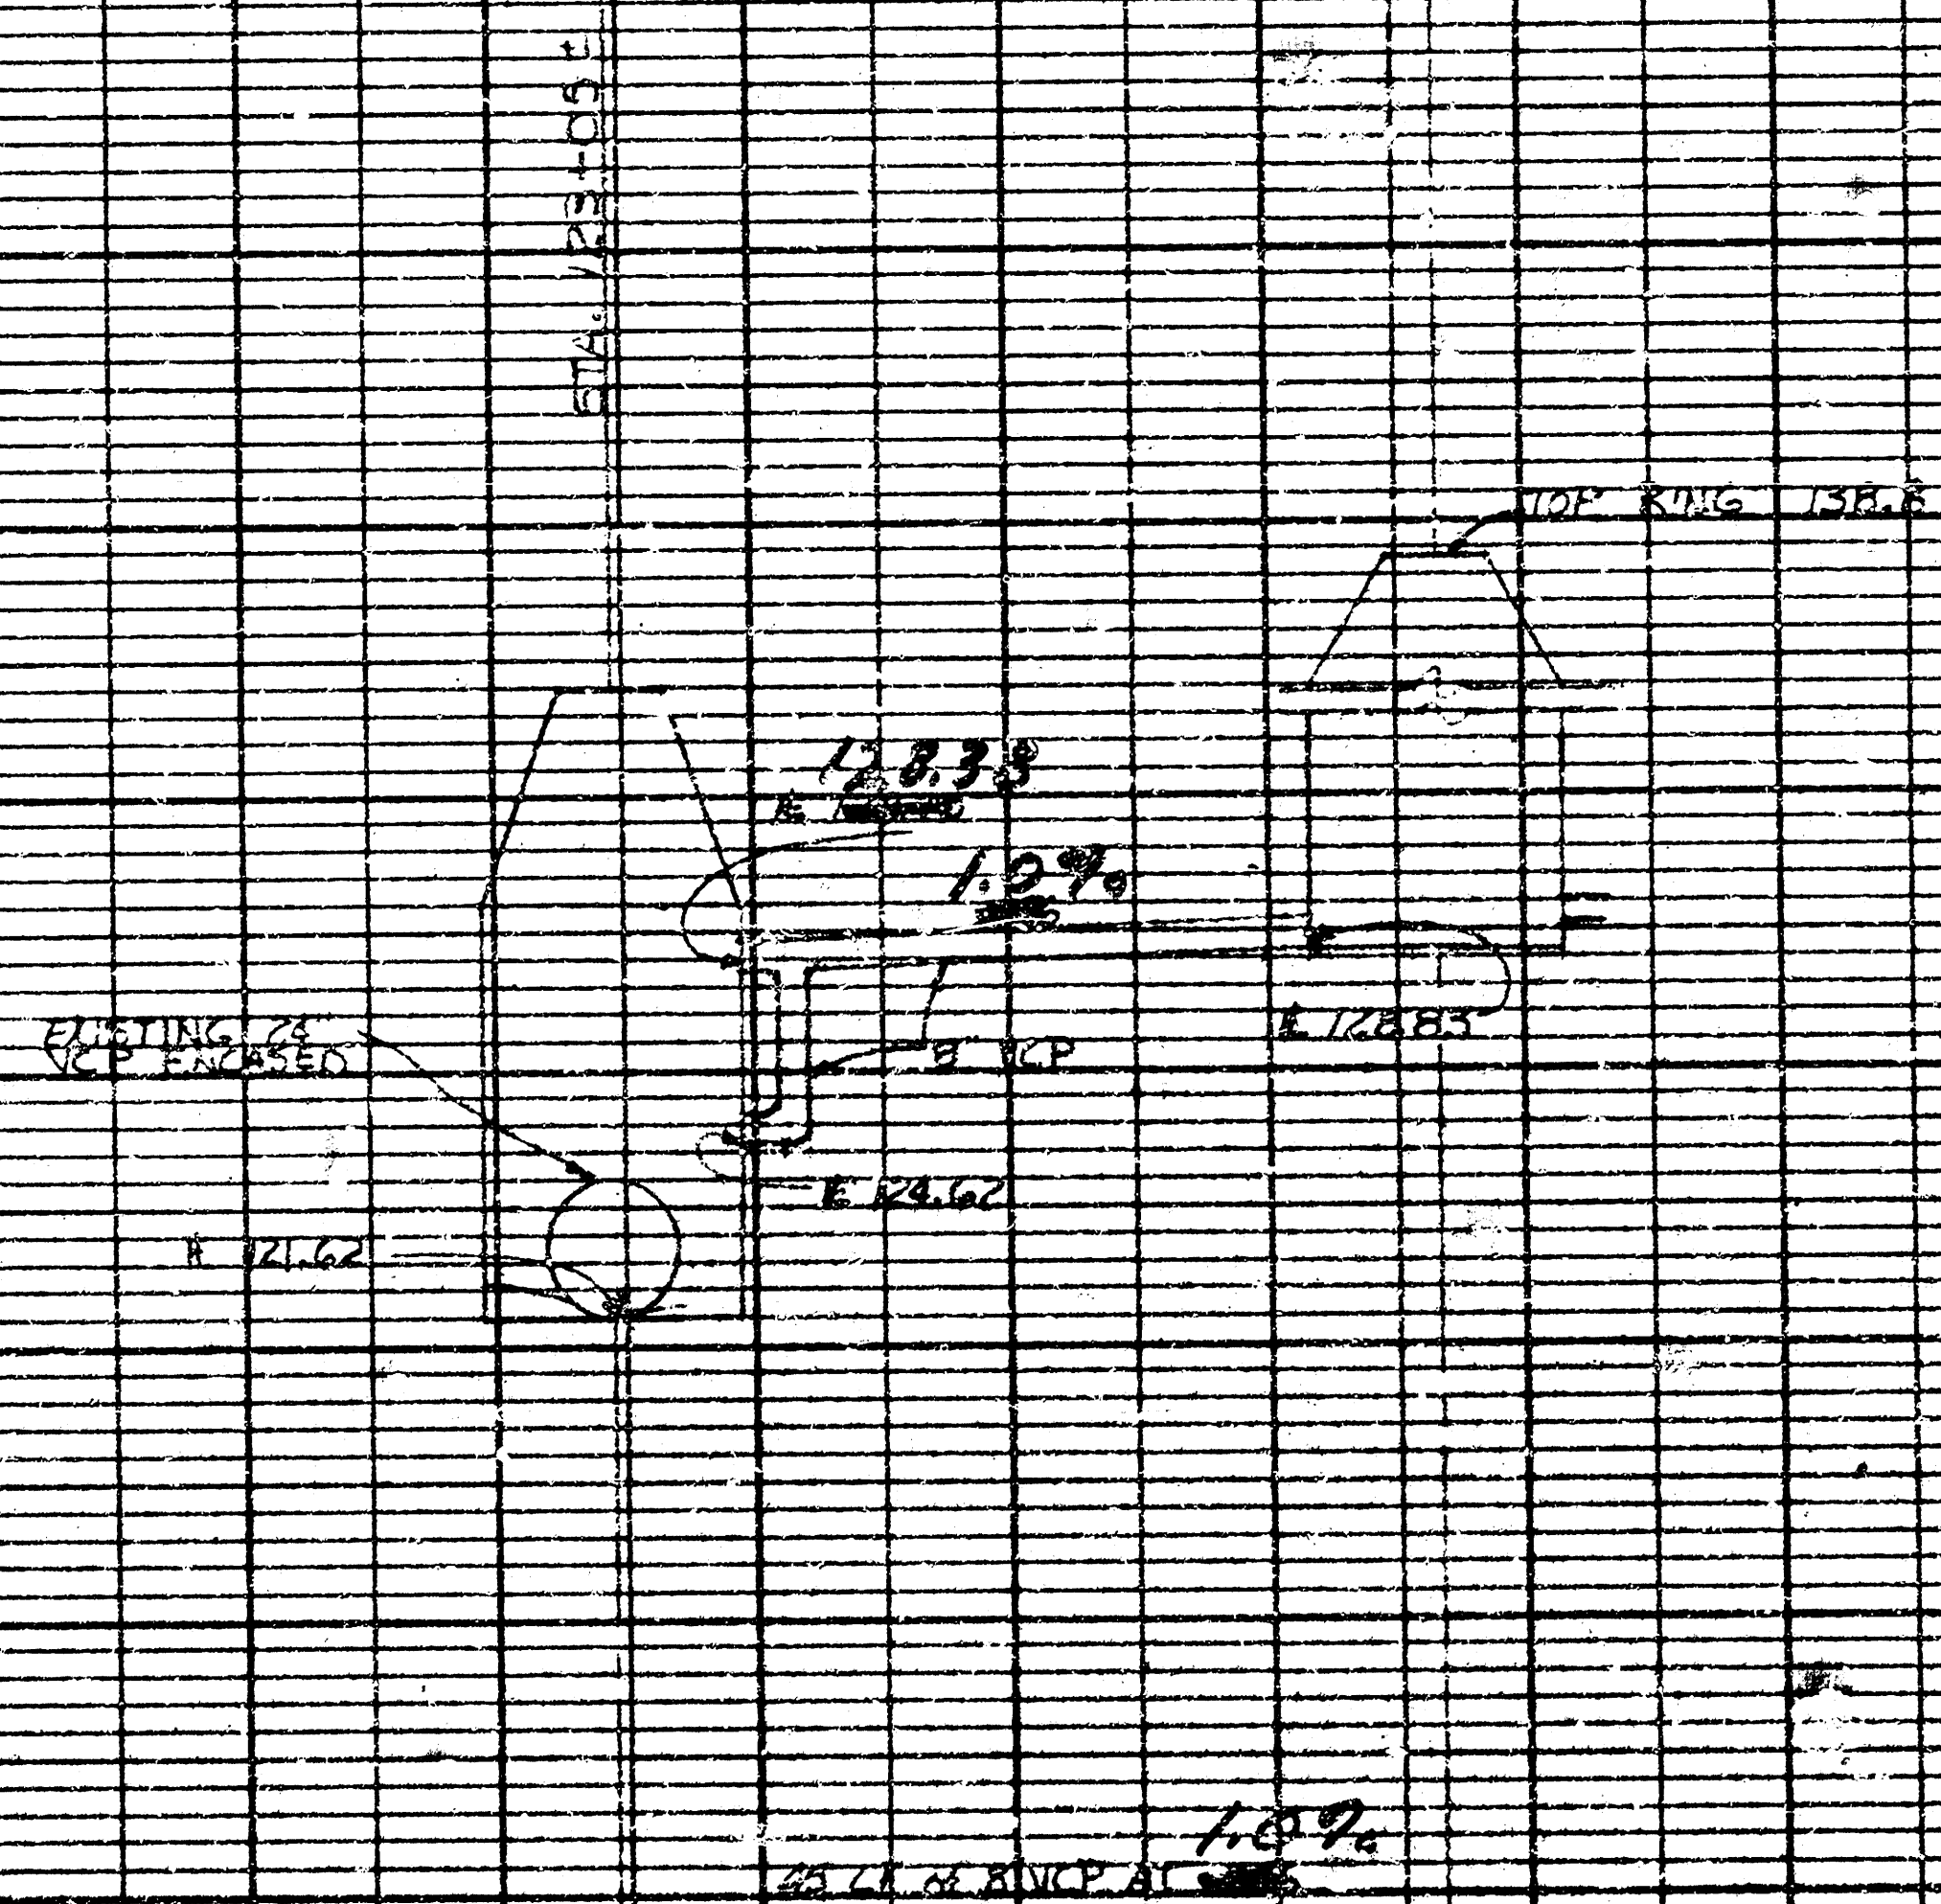

Langland Addn. San. Sewer

FLOYD LANGLAND

SANITARY SEWER

24\"/>

UTILITY CONTRACTORS

07/51

07/51

PROJ. NO. DSKW706142