


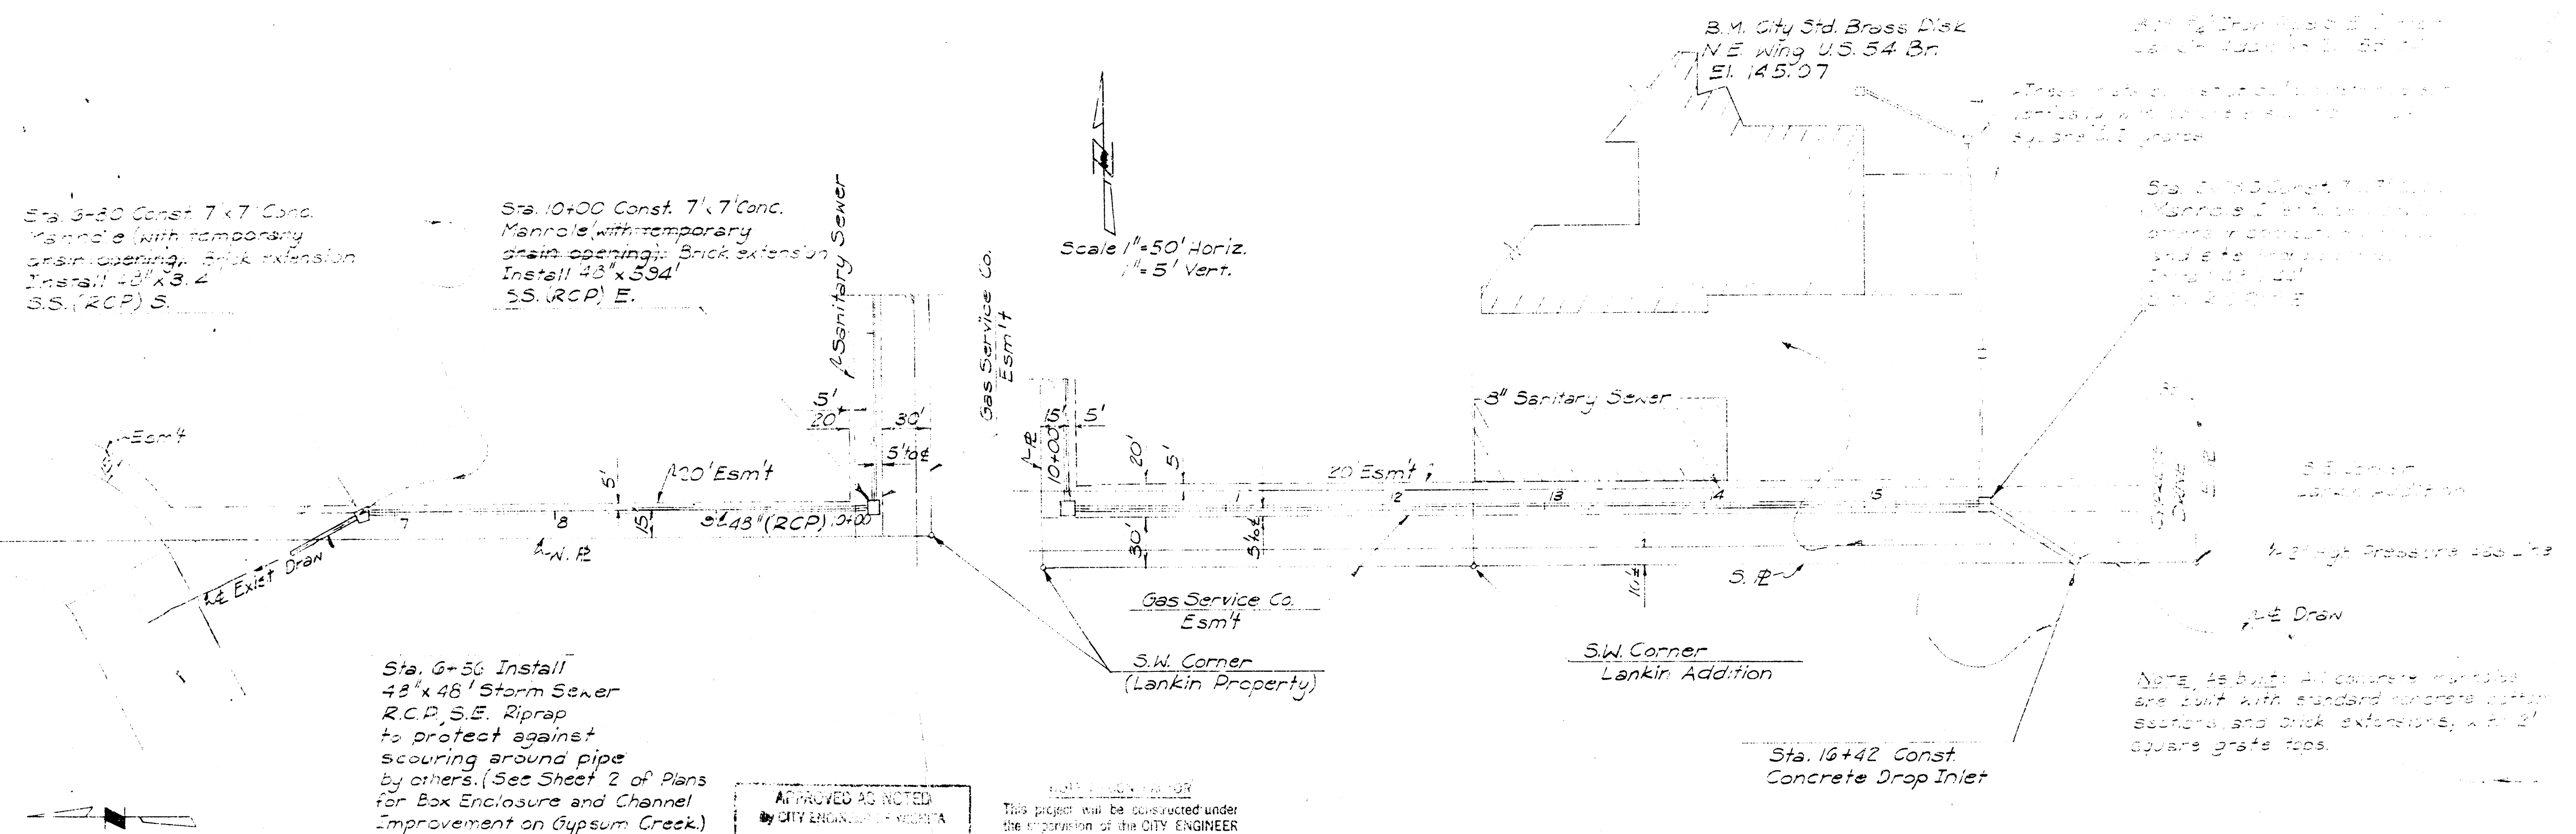


APPROVED AS NOTED
 CITY ENGINEER
 SANITARY SEWER
 6/14/69

NOTICE TO THE PUBLIC
 This project was constructed under the supervision of the CITY ENGINEER and in accordance with the SPECIFICATIONS for the City of Wichita, Kansas.

NOTE: Construction to be in accordance with City of Wichita current standard specifications for sewer construction. See Sheet 2 for Standard Manhole Details. See Sheet 3 for details of Special Inlet and temporary openings.

48" STORM SEWER LAYOUT
 LANKIN ADDITION
 May, 1969
 R.S. DELAMATER
 CONSULTING ENGINEER
 WICHITA, KANSAS

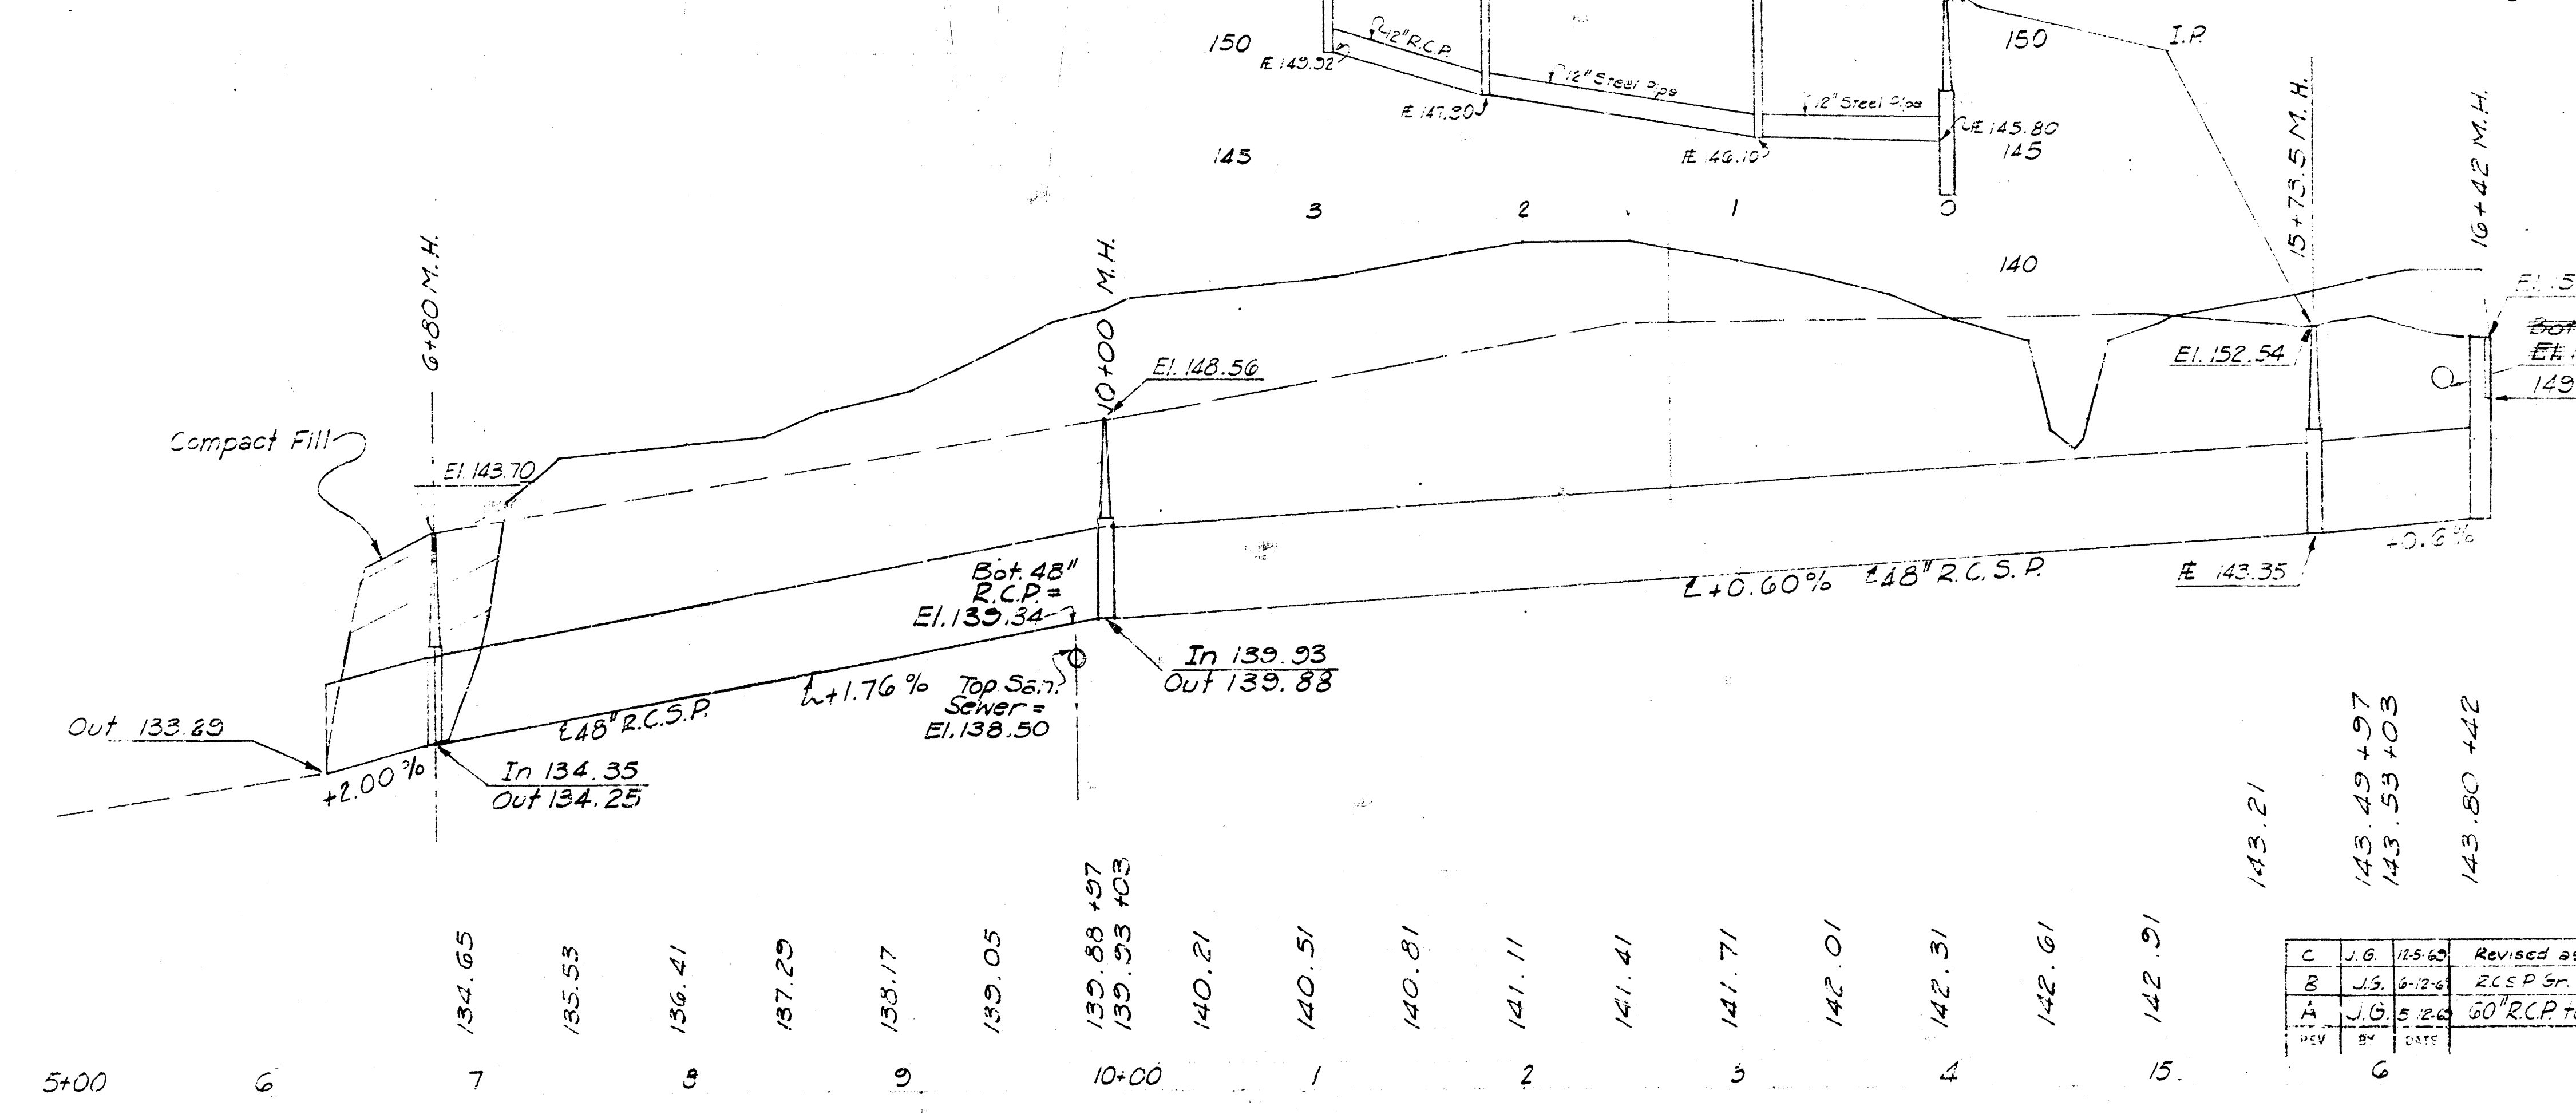

NOTE: As built revisions 12-5-69 are to show changes in the field by others, and do not reflect changes in the plans by the consultant.

REV	DATE	DESCRIPTION
1	6/14/69	Revised as Built
2	6/14/69	20' RCP to 48" Add Inlet
3	6/14/69	60" RCP to 48" Add Inlet



231-A-108

